

LIST OF MINIATURE PLAN OF LUCKNOW DIVISION, NORTHERN RAILWAY, LUCKNOW

SL.No.	STATION NAME	PAGE No.
1	INDEX	1-7
2	ACHALGANJ	8
3	ACHARYA NARENDRA DEV NAGAR MINI PLAN	9
4	ADHINPUR	10
5	AJGAIN	11
6	AKBARGANJ	12
7	AKBARPUR	13
8	ALAMNAGAR	14
9	AMAUSI	15
10	AMETHI	16
11	ANTU	17
12	ANUPGANJ	18
13	ARKHA	19
14	ATRAMPUR	20
15	AYODHYA	21
16	BABA BHAGWAN	22
17	BABATPUR	23
18	BACHRAWAN	24
19	BADSHAHPUR	25
20	BAHAI HALT	26
21	BAISWARA FLAG	27
22	BAKHSHA	28
23	BAKKAS	29
24	BANDHUA KALAN	30
25	BANI	31
26	BARABANKI	32

27	BARAGAON	33
28	BARARABUZURG HALT	34
29	BARSETHI	35
30	BARYARAM	36
31	BHADAIYAN	37
32	BHADOHI	38
33	BHADRI	39
34	BHANAUR	40
35	BHARATKUND	41
36	BHUPIAMAU	42
37	BIGHAPUR	43
38	BILHARGHAT	44
39	BILWAI	45
40	BIRAPATTI	46
41	BISHNATHGANJ	47
42	BLOCKHUT 'A'	48
43	BUND HAMIRPUR	49
44	CHAUBISI	50
45	CHAUKHANDI	51
46	CHAUREBAZAR	52
47	CHHANDRAULI	53
48	CHILBILA	54
49	DALMAU	55
50	DANDUPUR	56
51	DARSHAN NAGAR	57
52	DARYABAD	58
53	DARYAPUR	59
54	DEORAKOT	60

55	DHIRGANJ	61
56	DILKUSHA CABIN	62
57	DWARKAGANJ	63
58	FAIZABAD	64
59	FURSATGANJ	65
60	GANGAGANJ	66
61	GARHI MANIKPUR	67
62	GAURA	68
63	GAURIGANJ	69
64	GAURIYAMAU	70
65	GOSHAINGANJ	71
66	HAIDERGARH	72
67	HARAUNI	73
68	HARCHANDPUR	74
69	HARPAL GANJ	75
70	INDAMAU HALT	76
71	ISHWARDASPUR	77
72	JAFARGANJ	78
73	JAGESHAR GANJ	79
74	JAIS	80
75	JAITIPUR	81
76	JALALGANJ	82
77	JALALPUR DHAI	83
78	JANGHAI	84
79	JARAUNA	85
80	JAUNPUR CITY	86
81	JAUNPUR	87
82	JUGAUR	88

83	KAJGAON	89
84	KANKAHA	90
85	KANPUR BRIDGE LEFT BANK	91
86	KAPSETHI MINI ESP	92
87	KASHI	93
88	KASIMPUR HALT	94
89	KATAHARI	95
90	KHAJURHAT	96
91	KHALISPUR	97
92	KHETA SARAI	98
93	KOHNDAUR	99
94	KOIRIPUR	100
95	KORARI	101
96	KULHA HALT	102
97	KUNDA HARNAMGANJ	103
98	KUNDAN GANJ	104
99	KUREBHAR	105
100	KUSUMBHI	106
101	LACHHMANPUR	107
102	LAL GOPALGANJ	108
103	LALGANJ	109
104	LAMBHUA	110
105	LOHTA	111
106	LUCKNOW	112
107	MAGARWARA	113
108	MAHARANI PACHHIM	114
109	MAHGAWAH	115
110	MALETHUKANAK	116

111	MALHAUR	117
112	MALIPUR	118
113	MANAK NAGAR	119
114	MANIKALAN	120
115	MANJHLEPUR	121
116	MARIAUH	122
117	MASODHA	123
118	MAUAIMMA	124
119	MIHRAWAN	125
120	MISARAULI	126
121	MOHAN LAL GANJ	127
122	MONDH	128
123	MUSAFIRKHANA	129
124	NIBHAPUR	130
125	NIGOHAN	131
126	NIHALGARH	132
127	NIHASTA HALT	133
128	PAKHRAULI STN.YARD	134
129	PARIAWAN KALA KANKAR ROAD YARD	135
130	PARSIPUR	136
131	PATRANGA	137
132	PHAPHAMAU	138
133	PHULPUR	139
134	PINDRA ROAD HALT	140
135	PIPARPUR	141
136	PIPERSAND	142
137	PIRTHIGANJ	143
138	PRATAPGARH	144

139	PRAYAG GHAT	145
140	PRAYAG	146
141	RADHA BALAMPUR	147
142	RAGHURAJ SINGH	148
143	RAHMATNAGAR	149
144	RAIBAREILY MINI ESP	150
145	RAM CHANDRAPUR	151
146	RAM CHAURA ROAD	152
147	RASAULI YARD	153
148	RAUZAGAON YARD	154
149	RUDAULI YARD	155
150	RUPAMAU MINI ESP	156
151	SAFDAR GANJ	157
152	SAFEDABAD	158
153	SAIDKHAN PUR	159
154	SALARPUR	160
155	SALKHAPUR	161
156	SARAI CHANDI	162
157	SARAI GOPAL	163
158	SARAI HARKHU	164
159	SARAI KANSARAI	165
160	SARKONI	166
161	SEWAPURI	167
162	SHAHGANJ	168
163	SHIVNAGAR	169
164	SHIVPUR	170
165	SHUDNIPUR	171
166	SINDURWA	172

167	SIWITH	173
168	SOHAWAL	174
169	SONIK	175
170	SRI KRISHNA NAGAR	176
171	SRIRAJ NAGAR	177
172	SULTANPUR	178
173	SURIYANA	179
174	SUWANSA	180
175	TAKIA	181
176	TALAKHAJURI	182
177	TANDA	183
178	THARWAI	184
179	TIKULI-RAWATPUR	185
180	TRANSPORT NAGAR	186
181	TRILOCHAN MAHADEO	187
182	TRIVEDIGANJ	188
183	TULSINAGAR	189
184	UBARNI	190
185	UGRASENPUR	191
186	ULNABHARI	192
187	UNCHAHAR	193
188	UNNAO	194
189	UTRATIA	195
190	VARANASI	196
191	VYAS NAGAR	197
192	WARIGAON	198
193	ZAFRABAD STN.YARD	199

S. No.	DESCRIPTION	REMARKS		
1	LAVATORIES	LAV.	URINAL	
		LADIES		
		GENTS		
2	NO OF WATER TAPS/ HAND PUMPS ON EACH PLATFORM	P/F No.	TAPS	H.P.
		1	-	1
	SOURCE OF WATER SUPPLY			
3	YEAR OF CONSTRUCTION OF STATION BUILDING			
4	BOOKING OFFICE NO. OF WINDOWS	ADV. RES.	CURRENT RES.	
		-1-		
5	NO. OF SEATS	P/F No.1		
		18		
6	WHETHER ENQUIRY OFFICE PROVIDED OR NOT			

S. No.	DESCRIPTION	AREA (Sq.m.)
1.	AREA OF PLATFORM SHELTER	12
2.	TOTAL AREA OF PLATFORM PLATFORM NO. 1	1672.62
3.	AREA OF WAITING ROOM I- UPPER CLASS WAITING ROOM II - AREA OF WAITING ROOM a- LADIES b- GENTS III- WAITING HALL	- - - - -
4.	CIRCULATING AREA	-

Sr. DSTE-I


REF.	FENCING	KUTCHA PUCCA	----
	ROAD	METALLED UNMETALLED	=====

Note:
 1. Land acquisition will be required for this station.
 2. Green ink showing dismantling.
 3. Red ink showing new proposal.
 4. Residential quarters needs to propose.

2/11/19
 21/11/19
 21/11/19
 ADEN/RBL

Sr. DOM
 21/11/19

Sr. DSTE/C

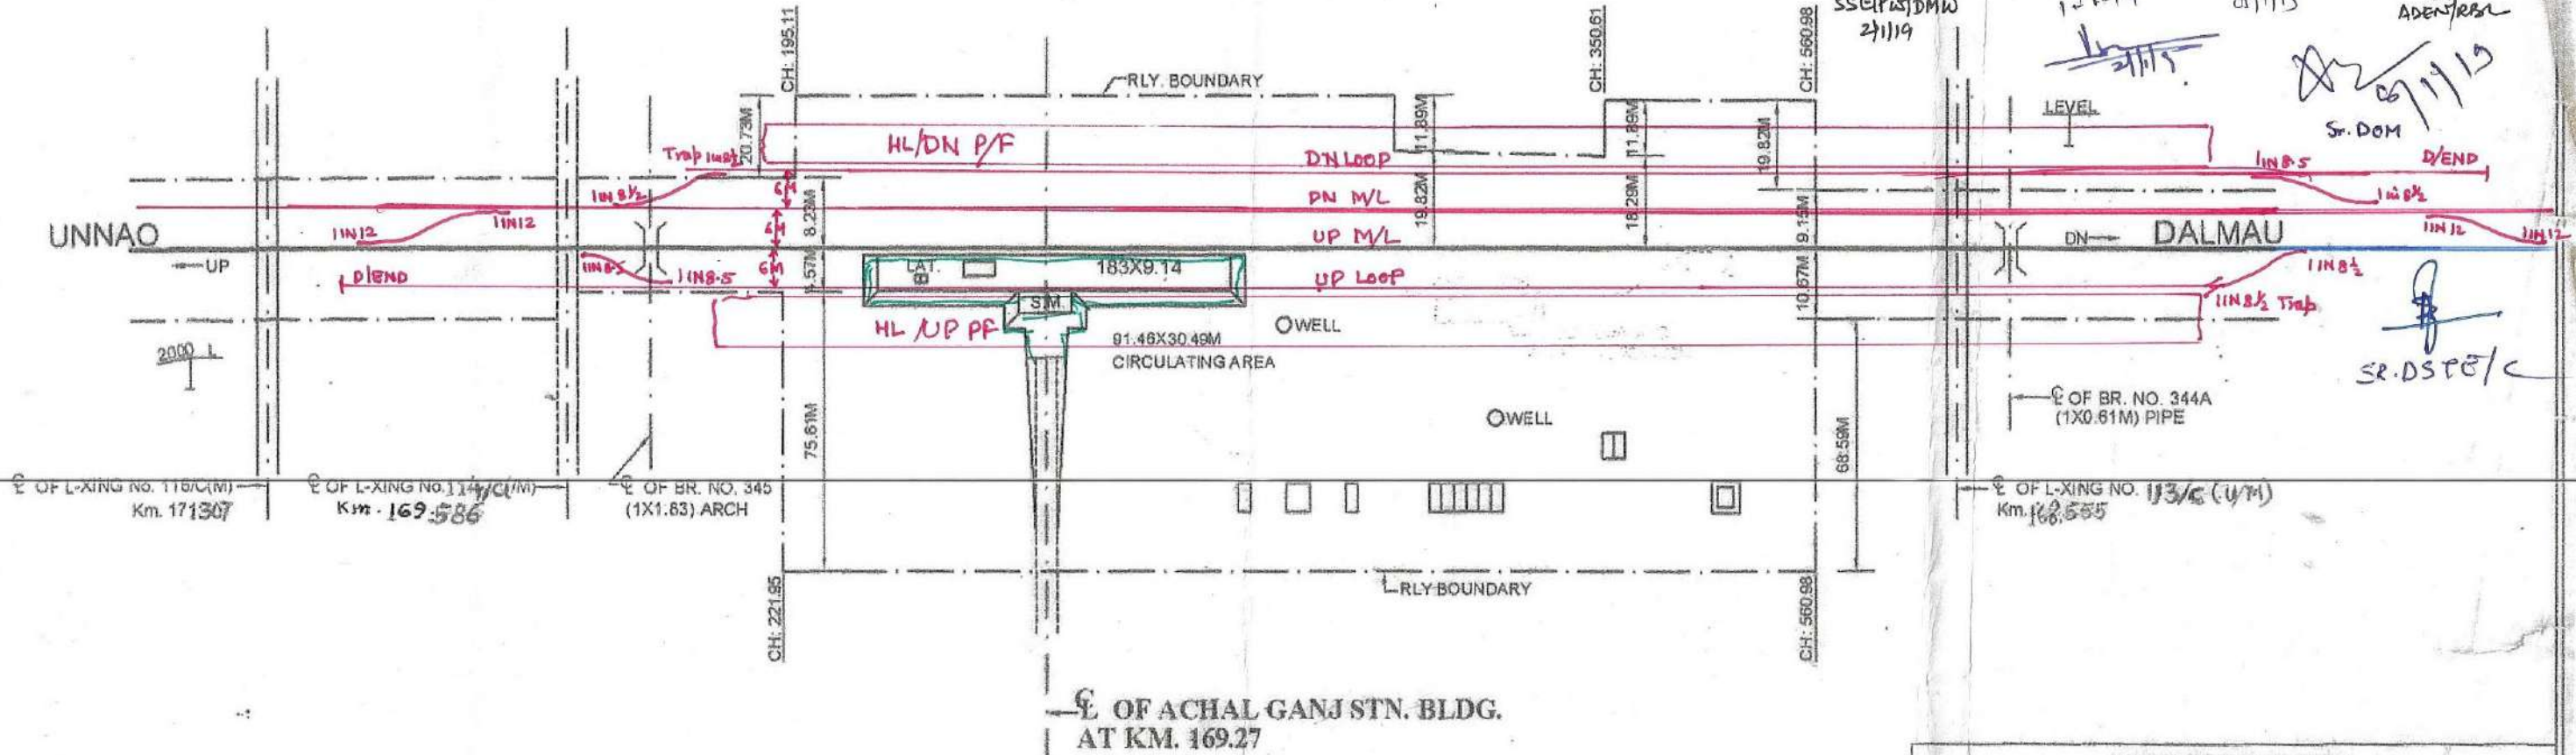



CHECKED BY	S.S.
DRAWN BY	DAKSCH
Sr. D.E.N.(II)	
ADEN/RBL	
CORRECTED UPTO	31-03-12
	31-03-13
	31-03-2014
	31-3-15
	31-3-2016
	31-03-2018


NORTHERN RAILWAY	
LUCKNOW DIVISION	
PFM-UCR-ON SECTION	
DIAGRAM OF	
ACHALGANJ STN: YARD	
R.L./M.S.L.	NOT TO SCALE
N.R. DIV L. SKETCH NO.	M-123/LKO/2012

Handwritten notes and signatures at the bottom of the page, including 'S.S.B./W/S/1 ARE', 'ADEN/RBL', and 'S.S.B./W/S/1 ARE'.

ACHARYA NARENDRA DEV NAGAR STATION YARD

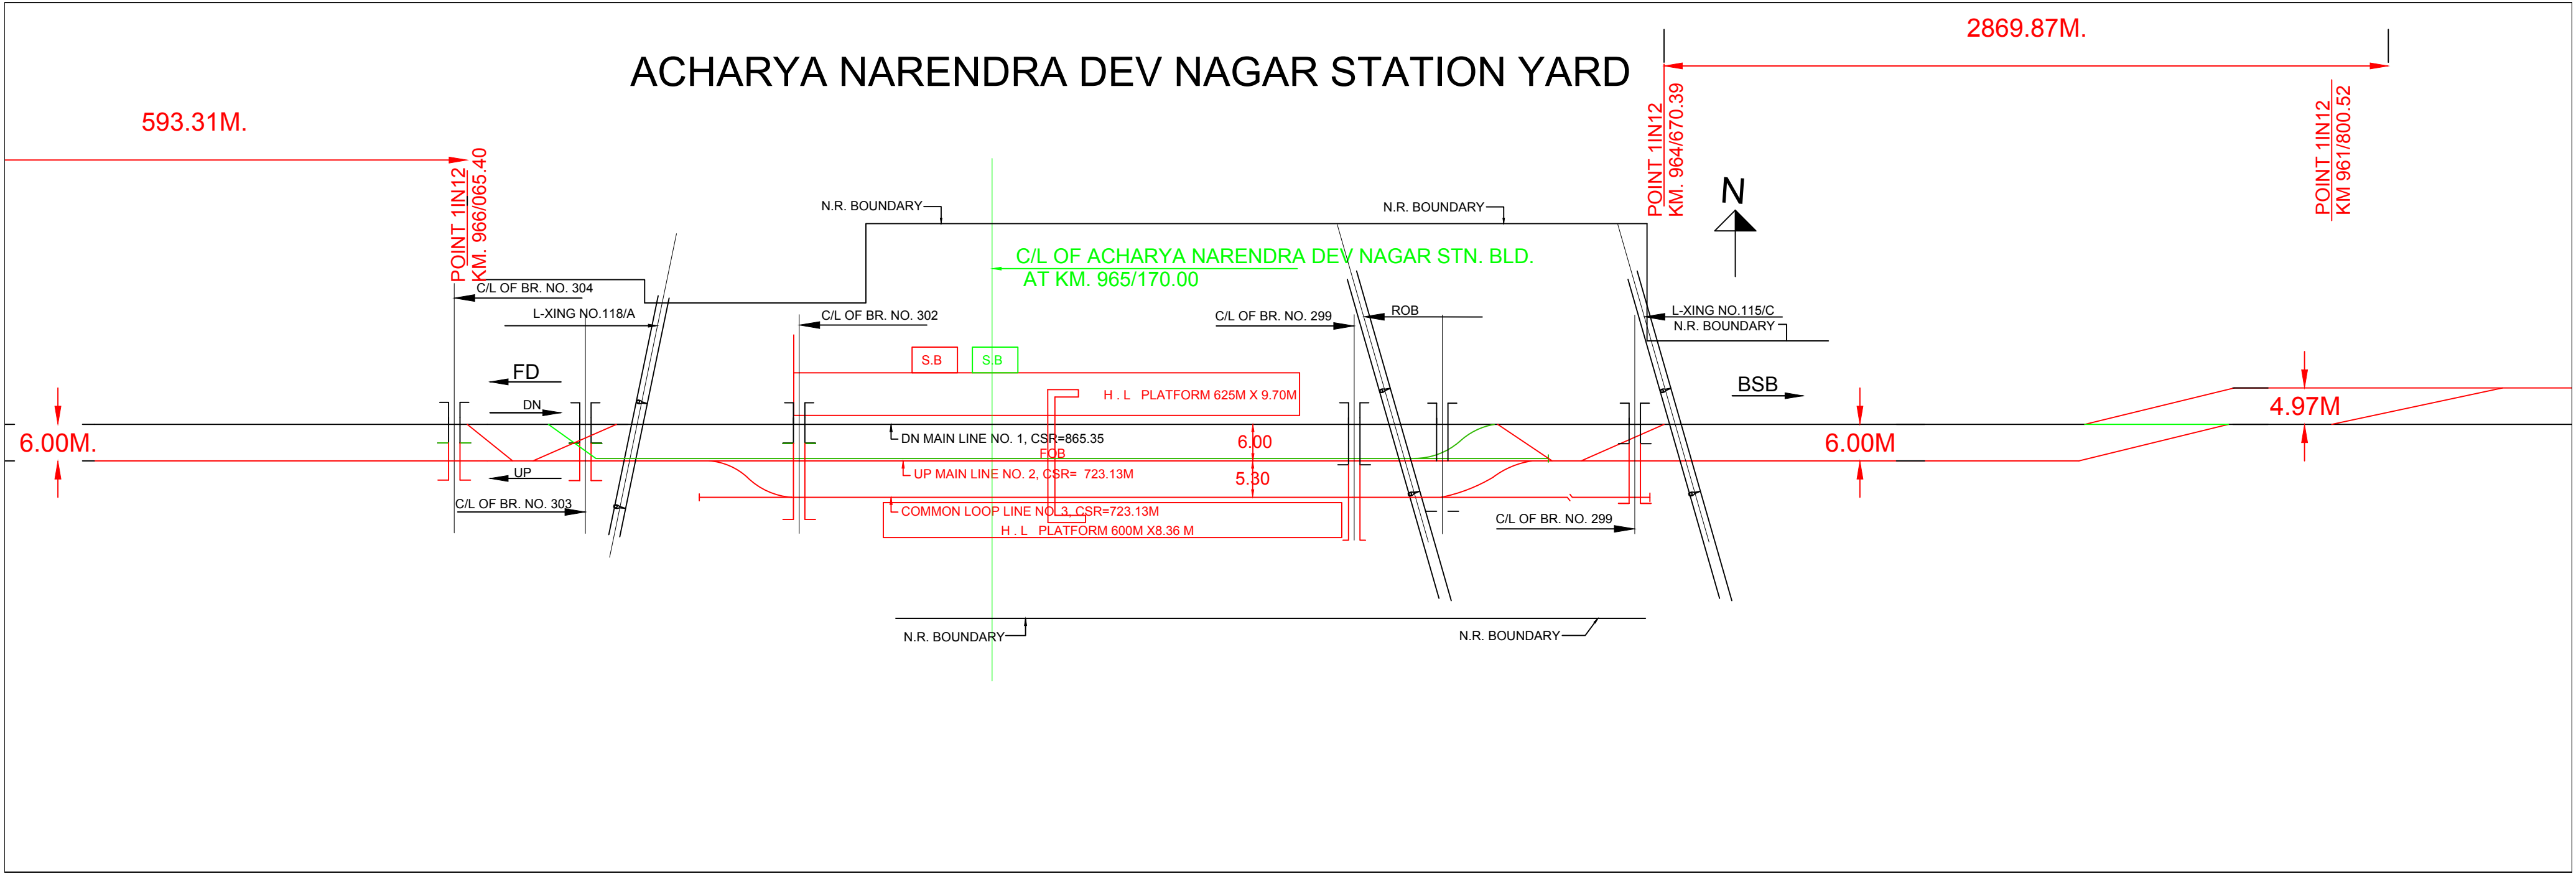

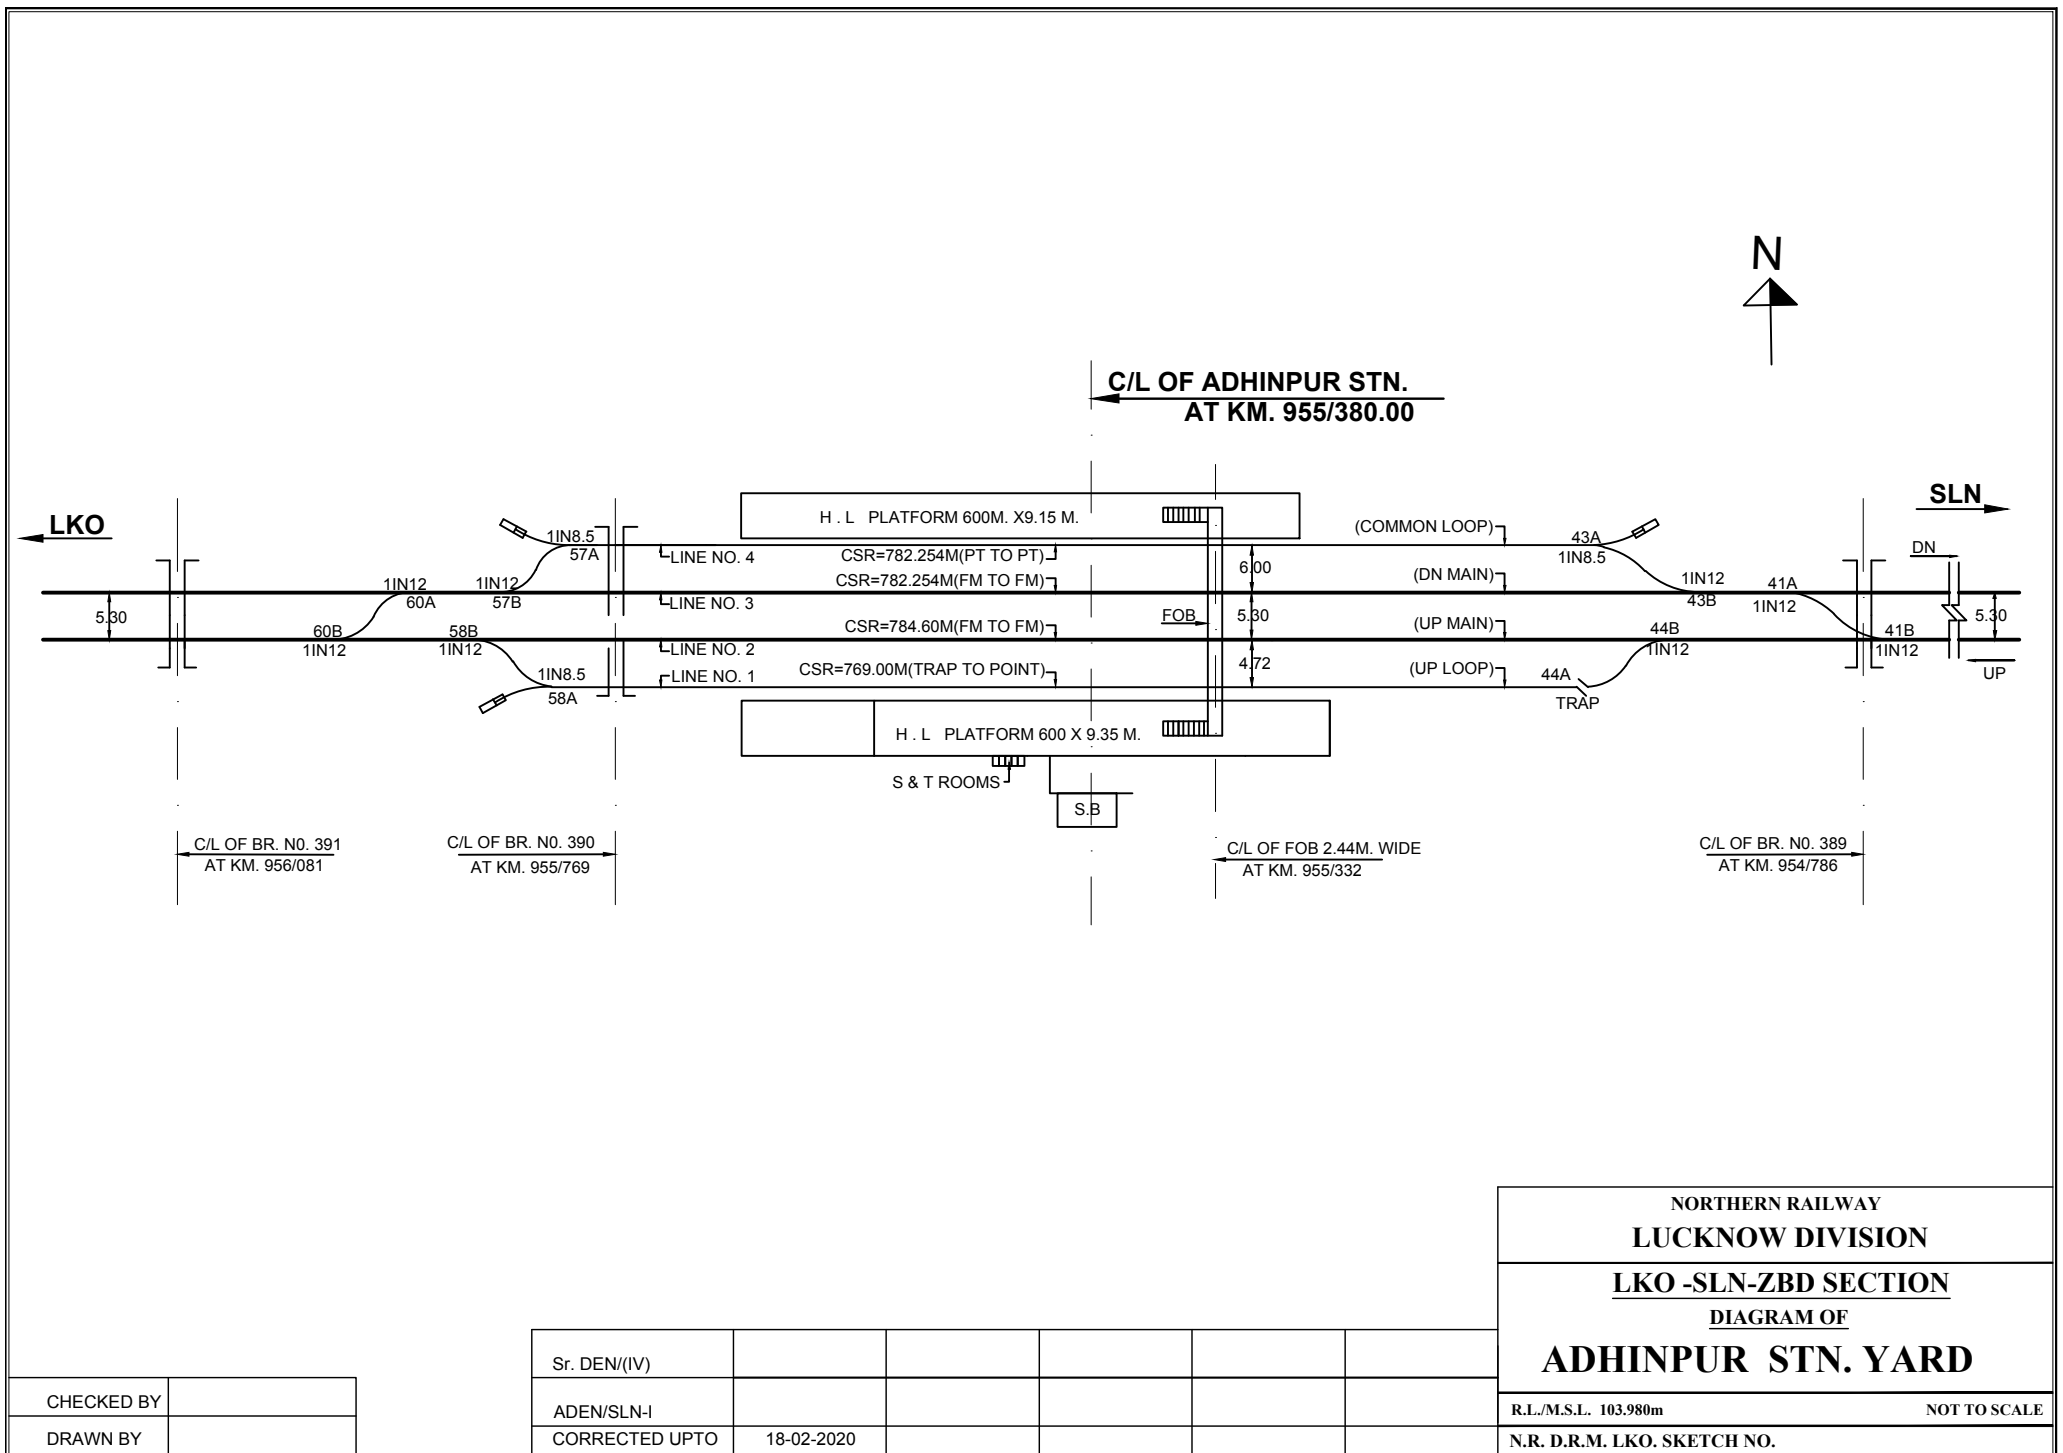

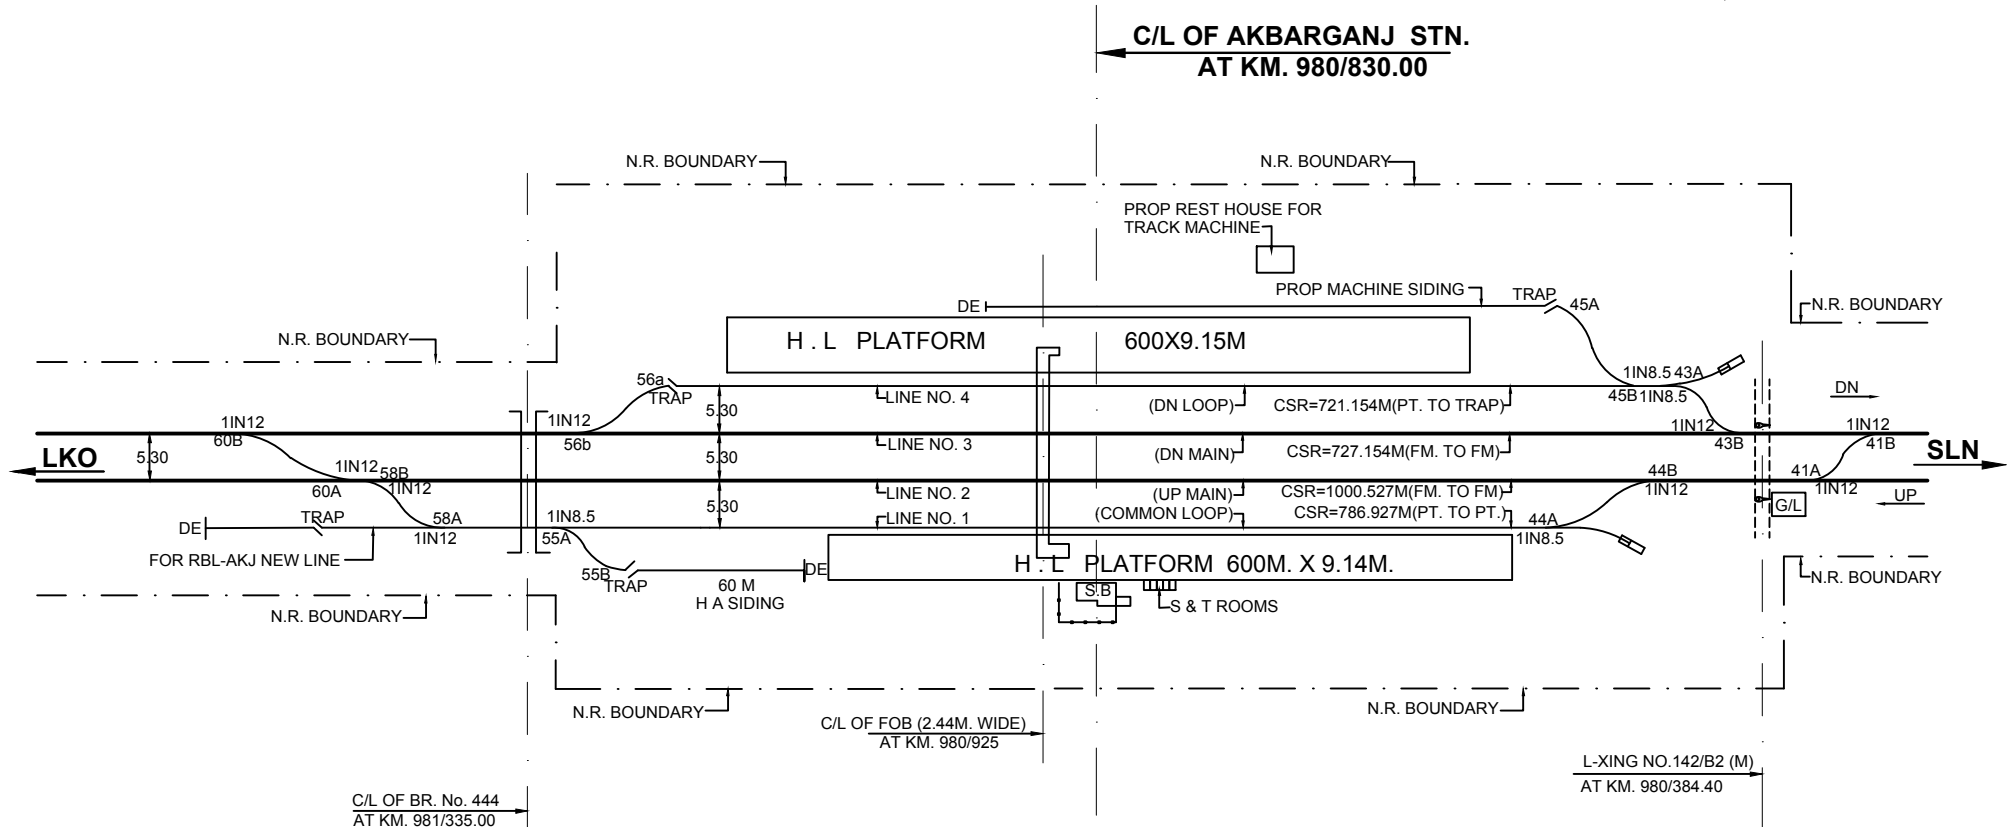



NORTHERN RAILWAY
LUCKNOW DIVISION

LKO -SLN-ZBD SECTION
DIAGRAM OF
AKBARGANJ STN. YARD

R.L./M.S.L. 110.867m NOT TO SCALE
N.R. D.R.M. LKO. SKETCH NO. 279 - 06

CHECKED BY		Sr. DEN(IV)					
DRAWN BY		ADEN/SLN-I					
		CORRECTED UPTO	18-02-2020				

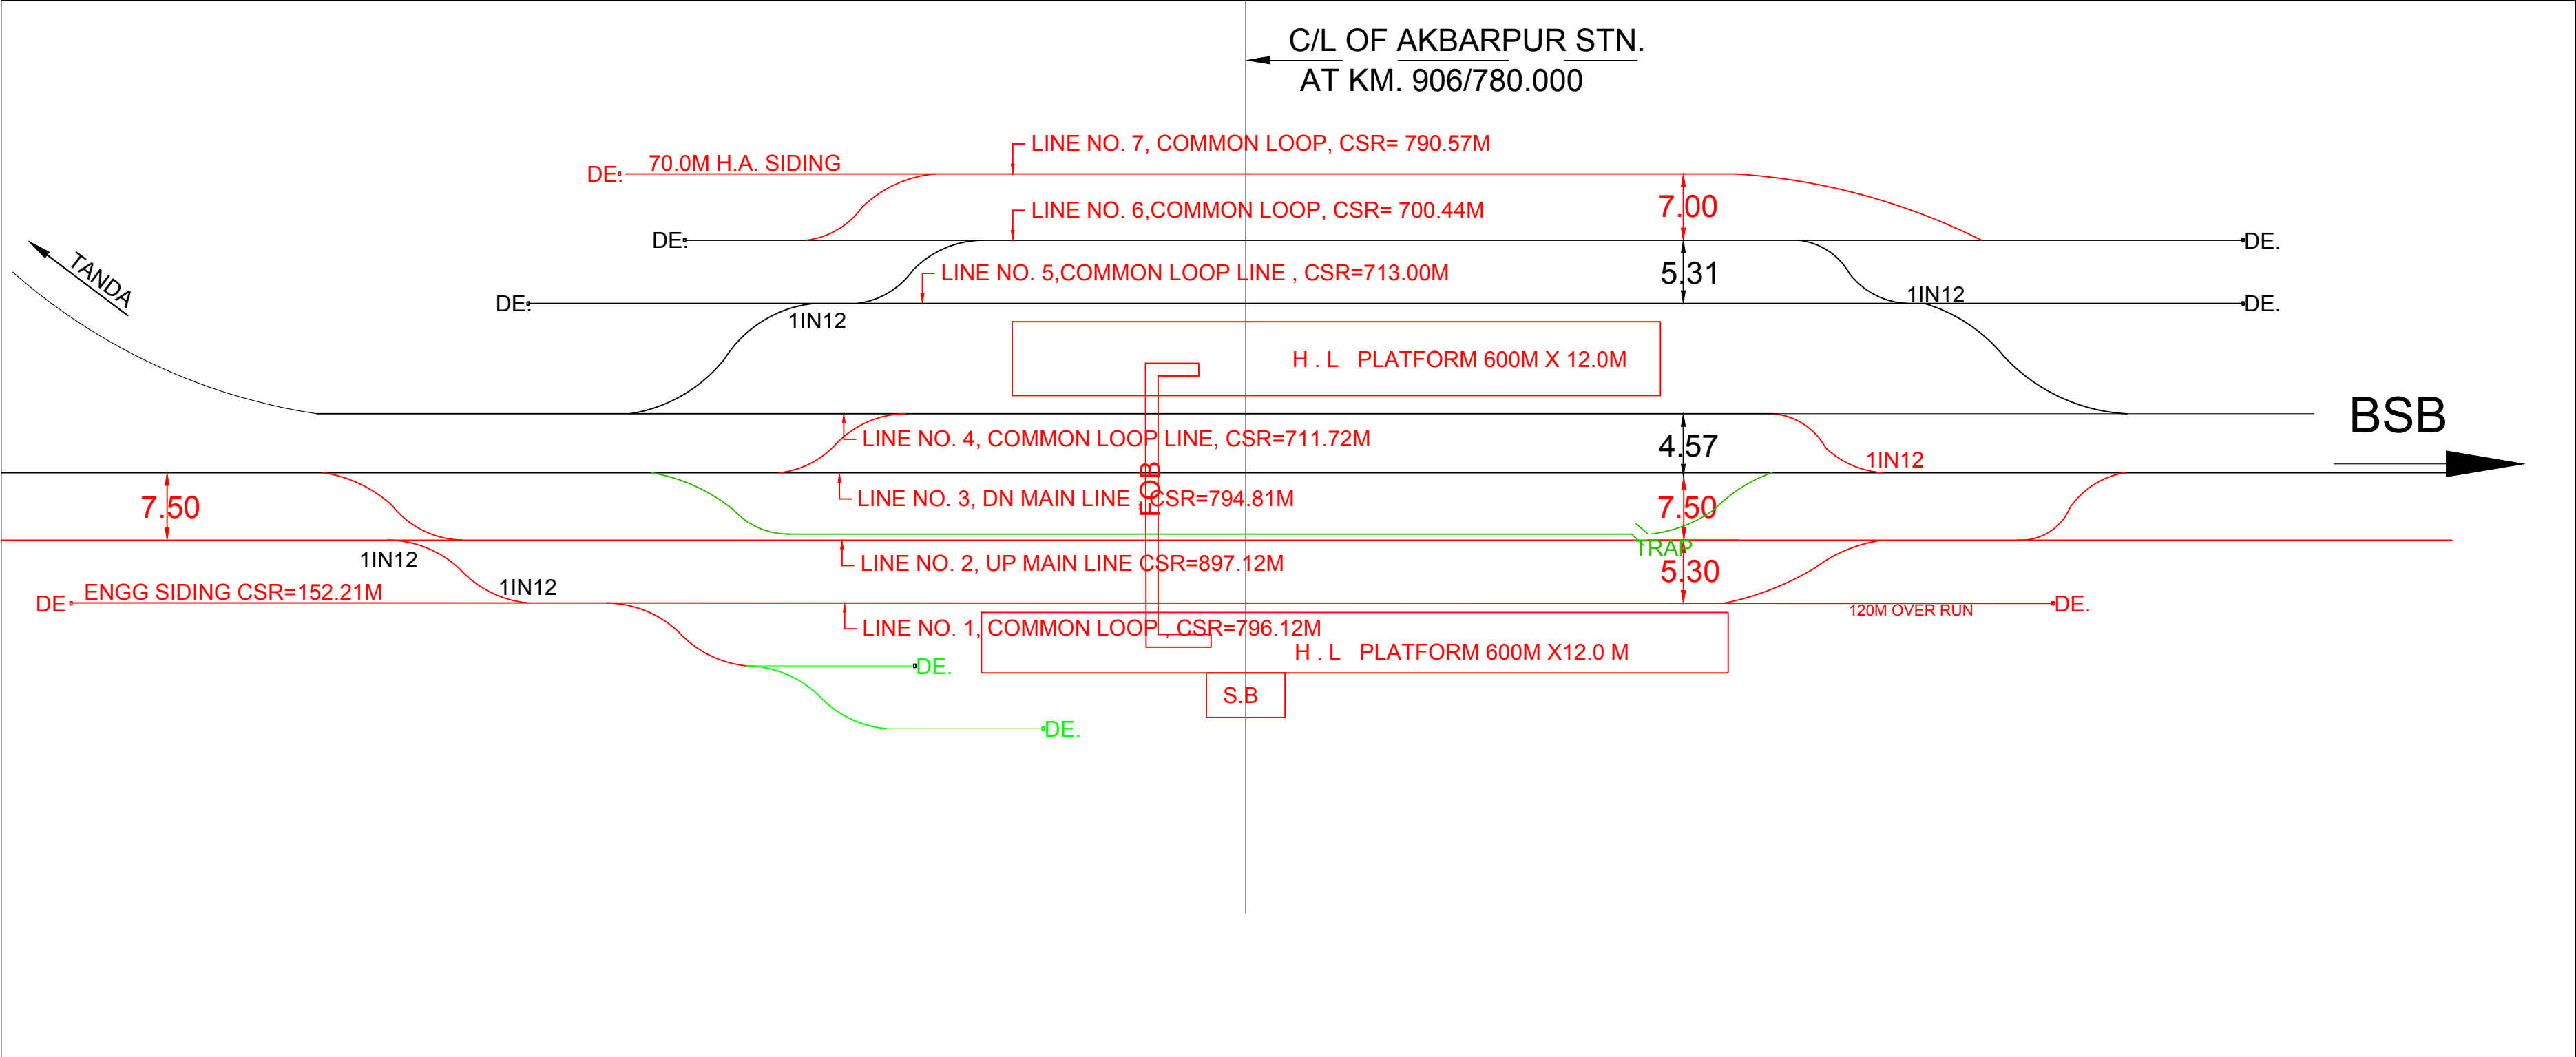

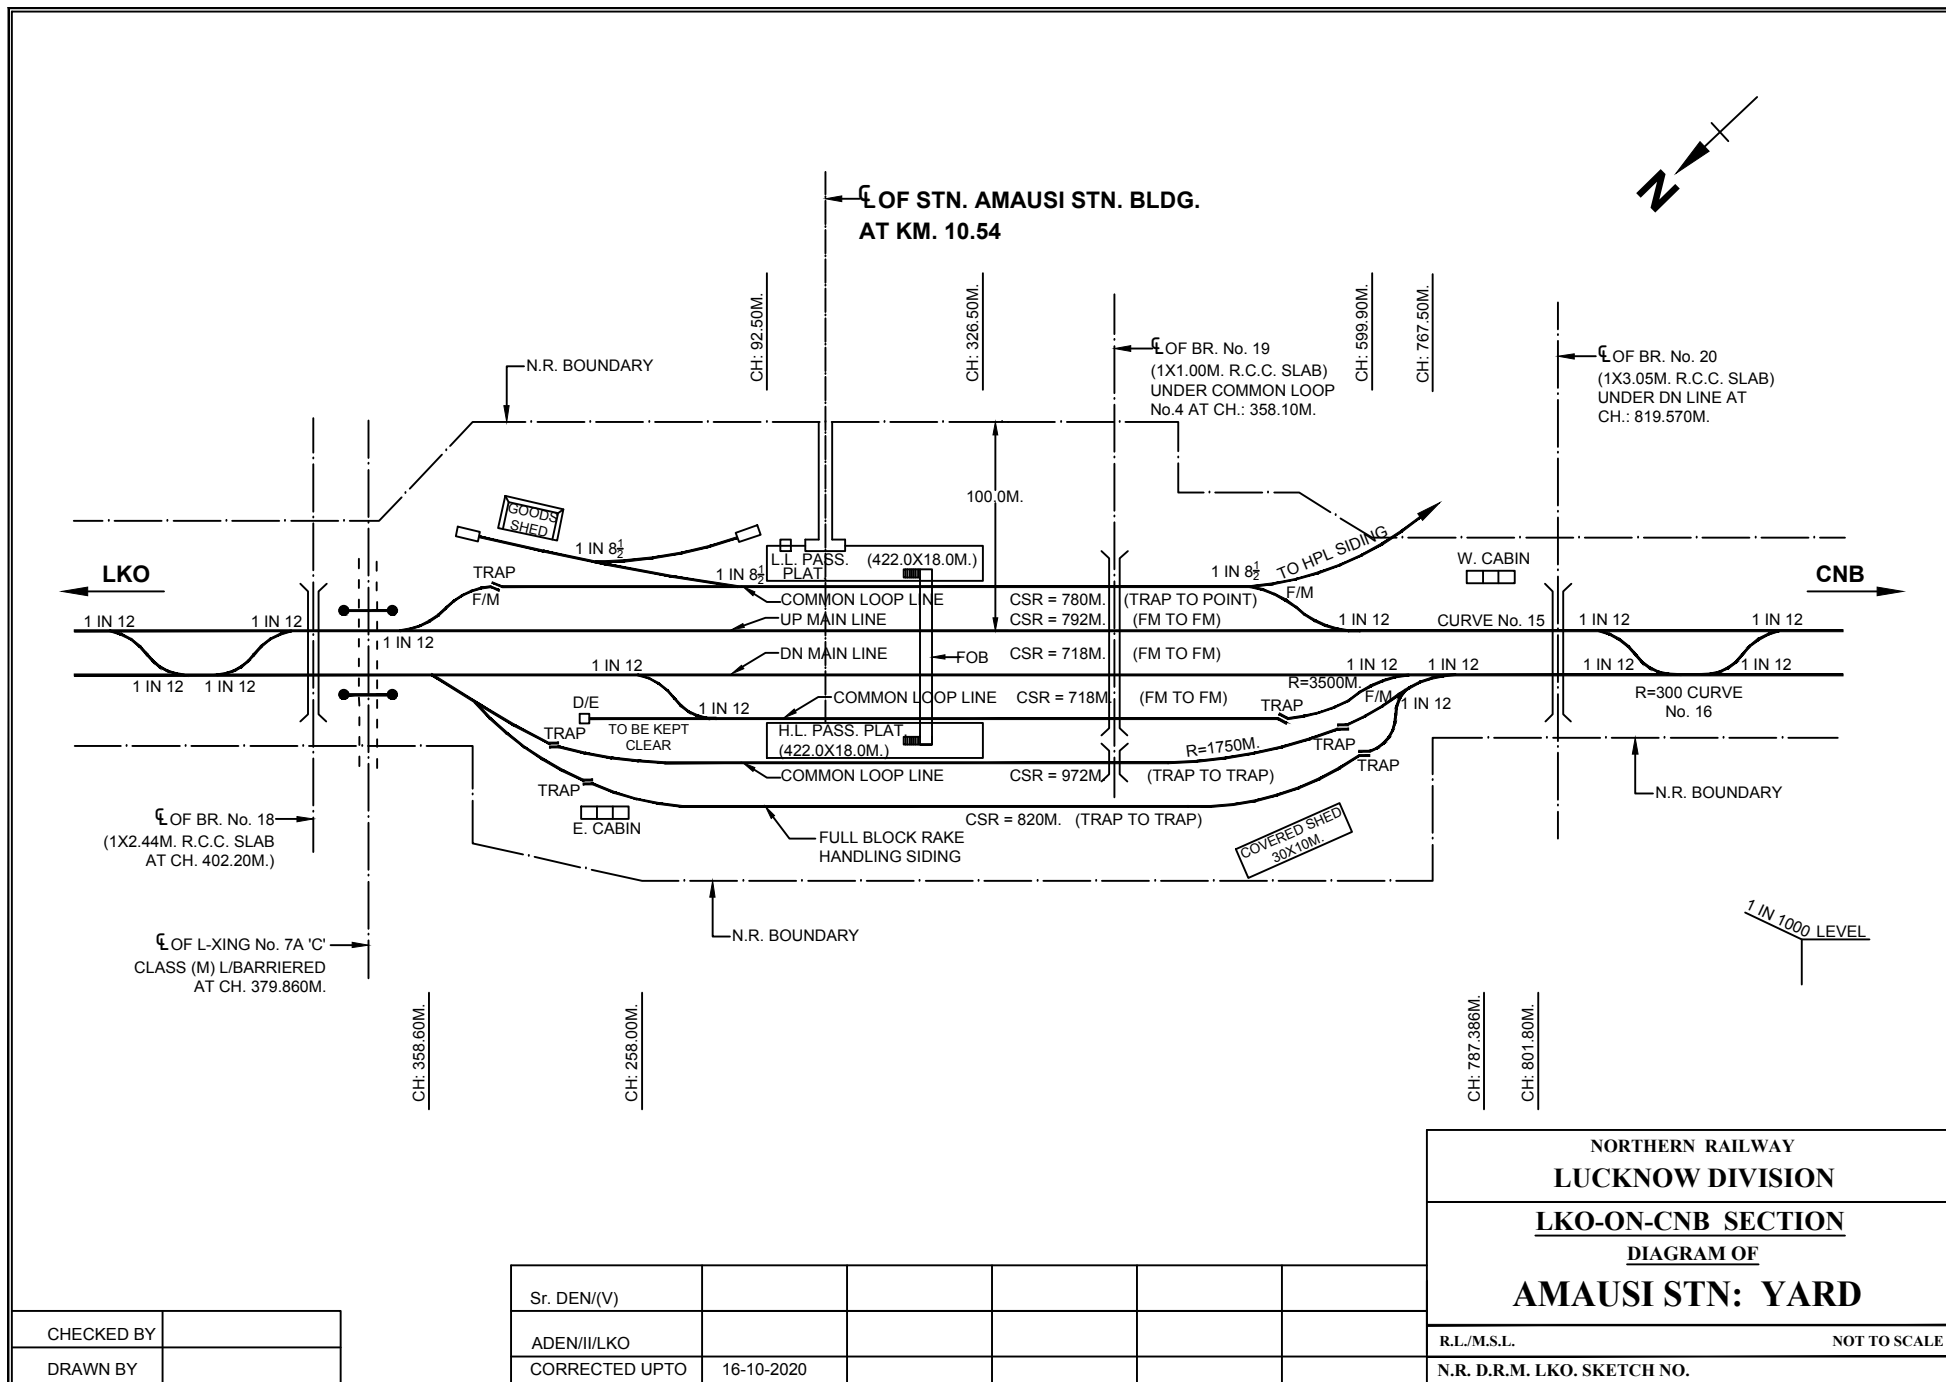

CHECKED BY	
DRAWN BY	

Sr. DEN(V)					
ADEN/III/LKO					
CORRECTED UPTO	16-10-2020				


NORTHERN RAILWAY LUCKNOW DIVISION	
LKO-ON-CNB SECTION	
DIAGRAM OF	
AMAUSI STN: YARD	
R.L./M.S.L.	NOT TO SCALE
N.R. D.R.M. LKO. SKETCH NO.	

CL OF AMETHI STATION

AT KM. 935.250

LEGEND:-

1. EXISTING WORK SHOWN THUS
2. PROPOSED WORK SHOWN THUS 
3. DISMENTLING WORK SHOWN THUS

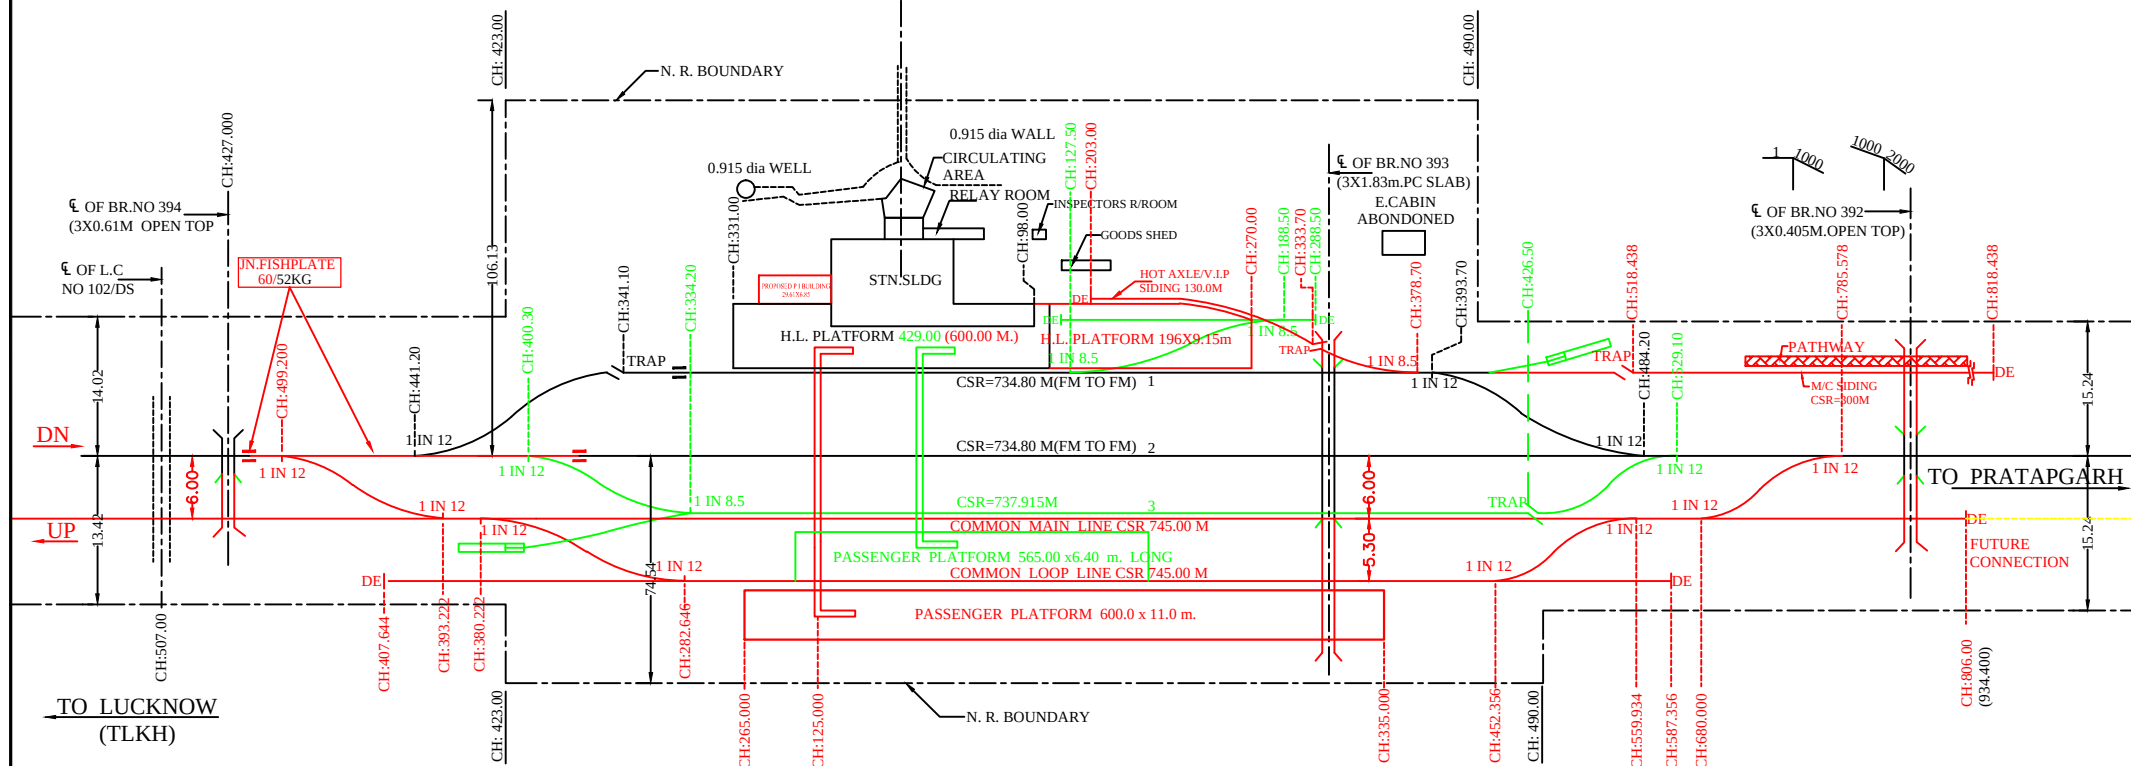

Sr.No.	LINE TYPE	CSR (FM-FM)
1	DN.L.L	734.80m
2	DN.M.L	734.80m
3	COM.M.L	745.00m
4	COM.L.L	745.00m
5	H.A/VIP SID.	130.70m
6	M/C SID.	300.00m

T.O	1 in 12		1 in 8.5		TRAP		DE	SF
	L	R	L	R	L	R		
EXISTING	1	1	-	-	-	1	-	-
DISMANTLING	1	1	2	-	-	1	2	2
PROPOSED	4	4	-	1	1	1	4	-

SCALE:- THIS DRAWING IS NOT TO SCALE




AMETHI STATION YARD

ANTU STATION YARD



LEGEND:-	
EXISTING WORK	—
PROPOSED WORK	—
DISMANTLED WORK	—
FUTURE WORK	—

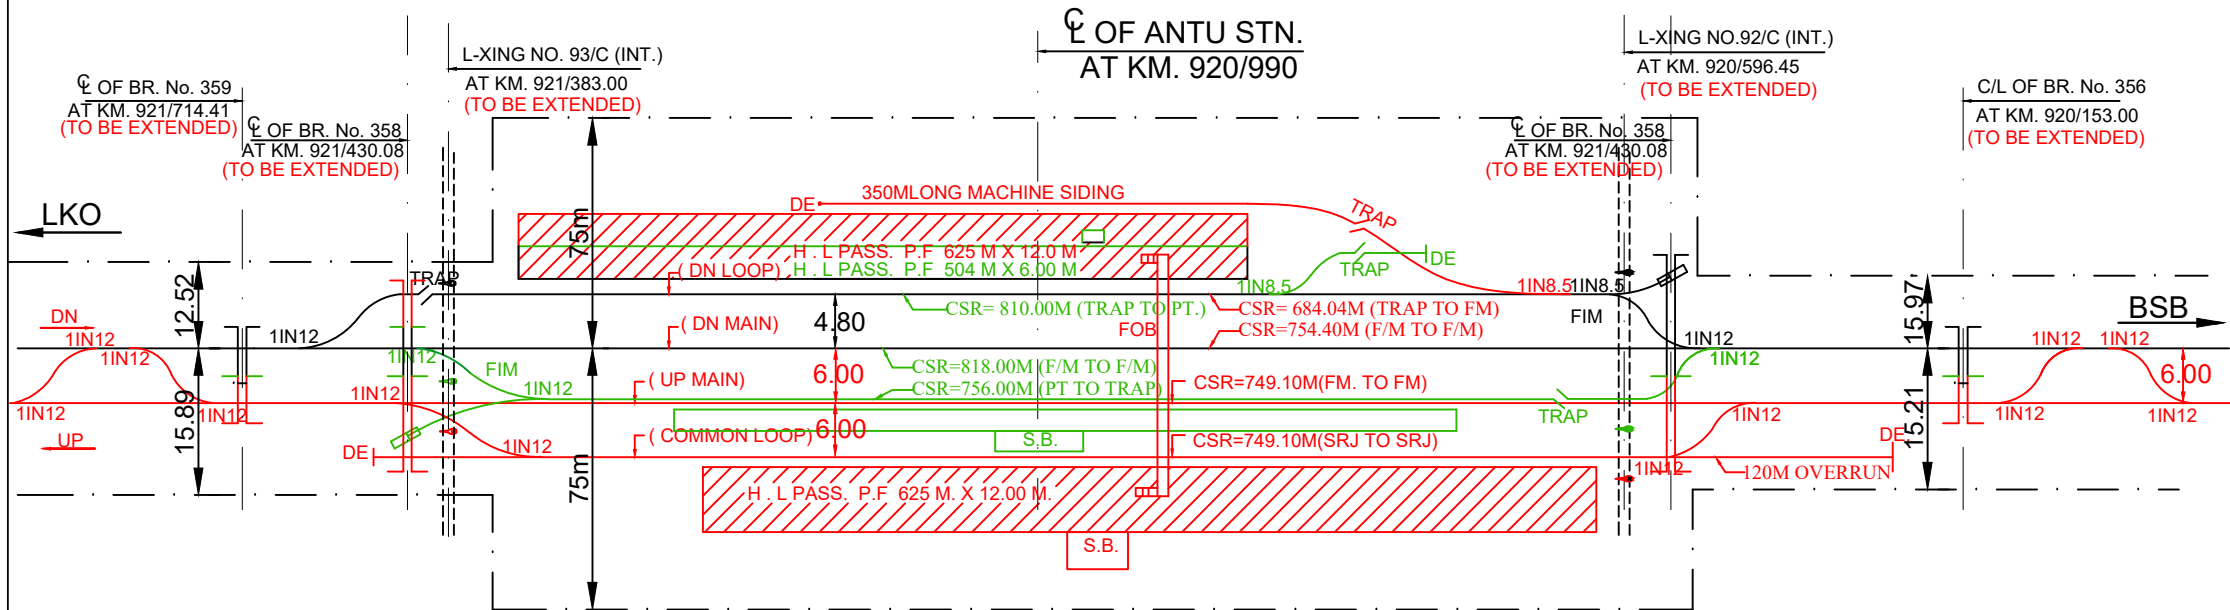

P.way work:

Sr.NO.	Name of Item	To be Dismantled	To be laid
1.	1 in 12 T/out	03	12
2.	1 in 8.5 T/out	01	01
3.	Trap	02	01
4.	Double Dimond	00	00
5.	Dead End	01	03
6.	Sand Hump	01	00
7.	Track (in KM)	1.50	3.50


Facility to be provided:


Sr.NO.	Facility
1.	New H.L. End PF no.1 (625mX12.00)
2.	New H.L. End PF no.2 (625mX12.00)
3.	New F.O.B 3m wide (To cover PF 1 to PF 2)
4.	One new line as line no. 1 with CSR 749.10m
5.	One 350m long Machine siding at Lucknow end.

Detail of traffic movement:

Sr.NO.	Movement	To Line no.
1.	From Lucknow	1 to 4
2.	From Varanasi	1 to 4

NORTHERN RAILWAY
LUCKNOW DIVISION
ANTU STATION YARD
AMETHI-JANGHAI DOUBLING (87 KM)

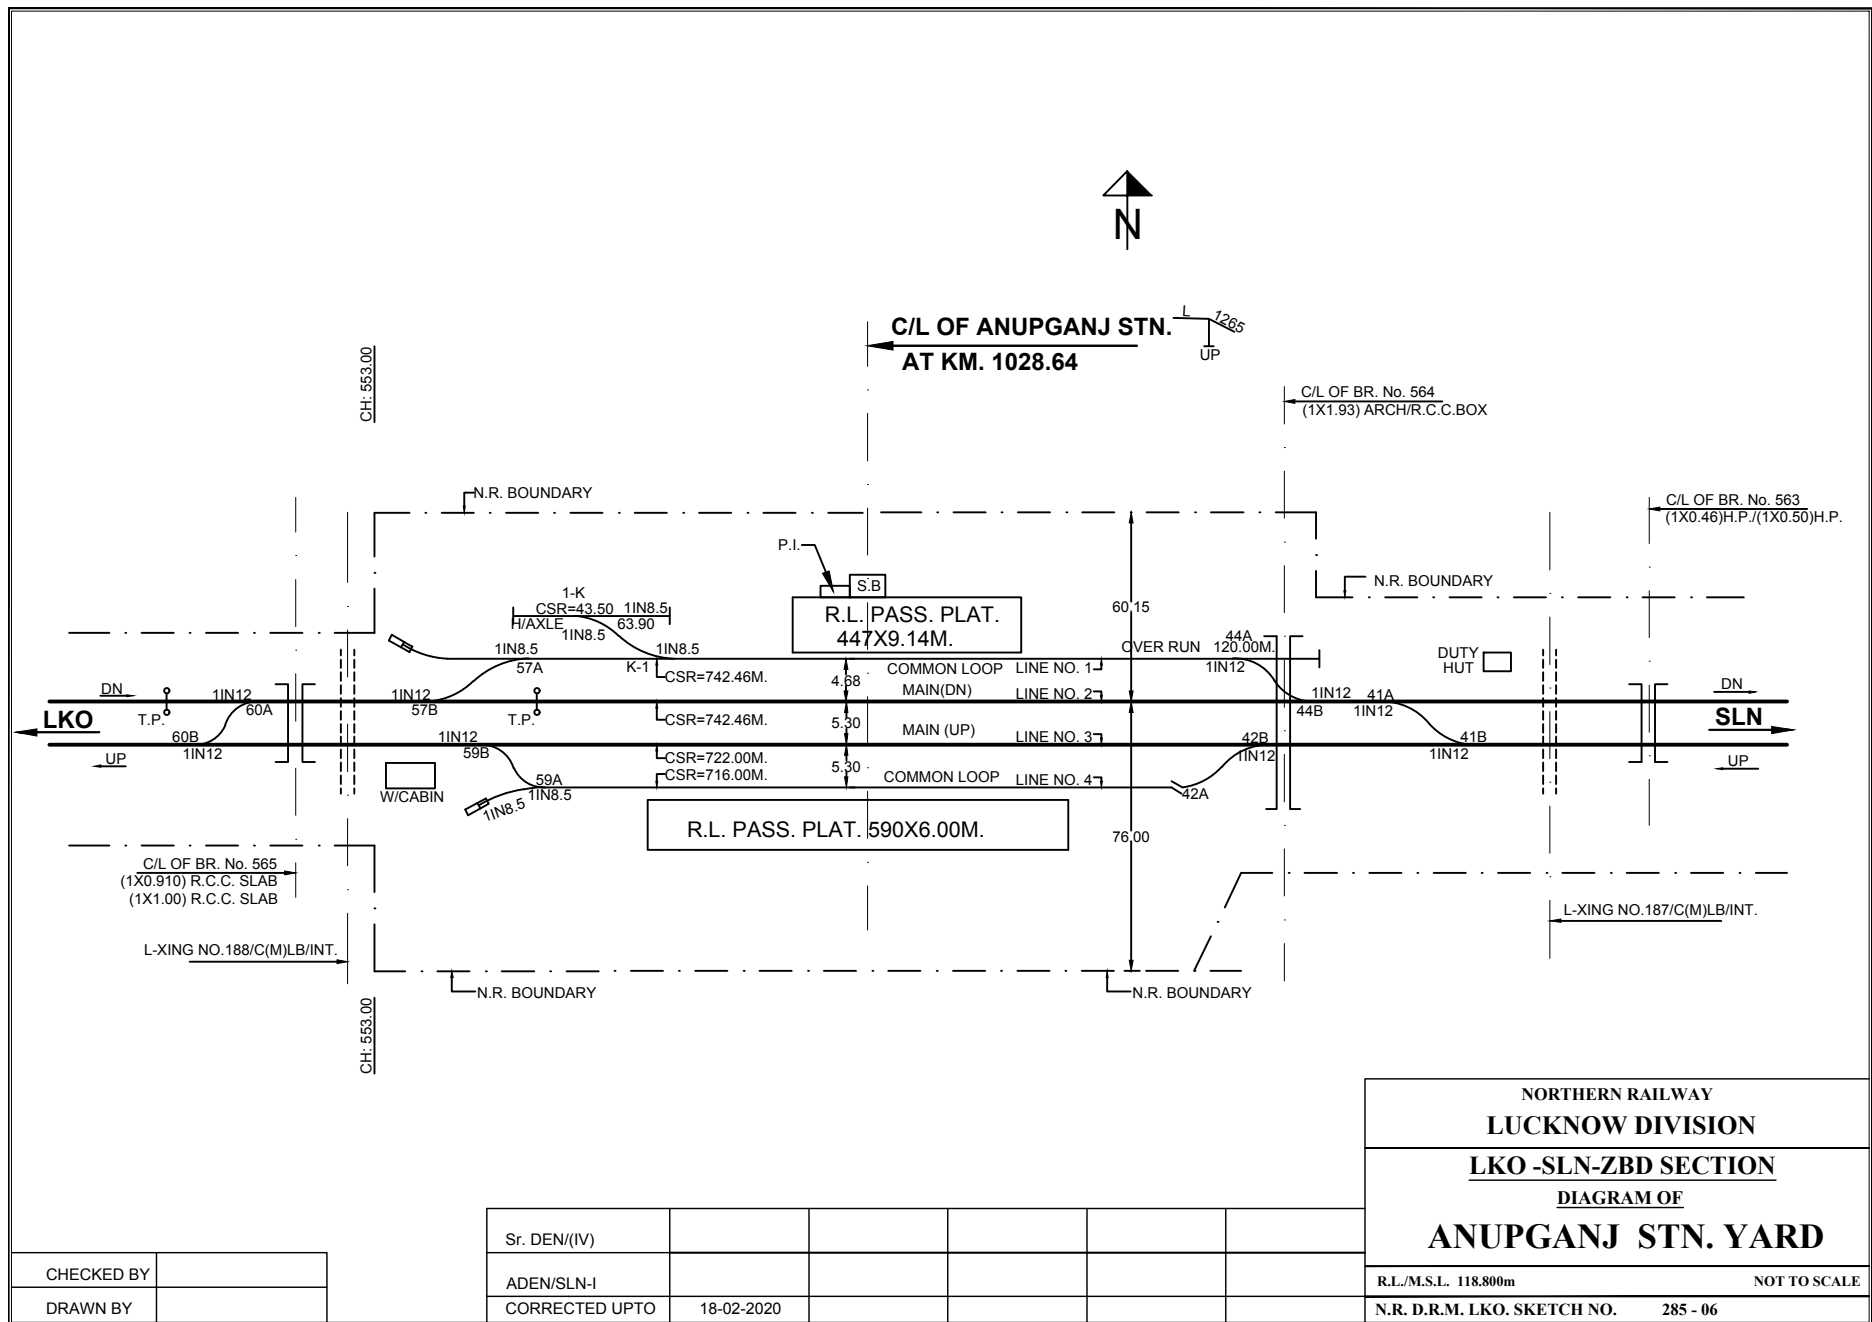

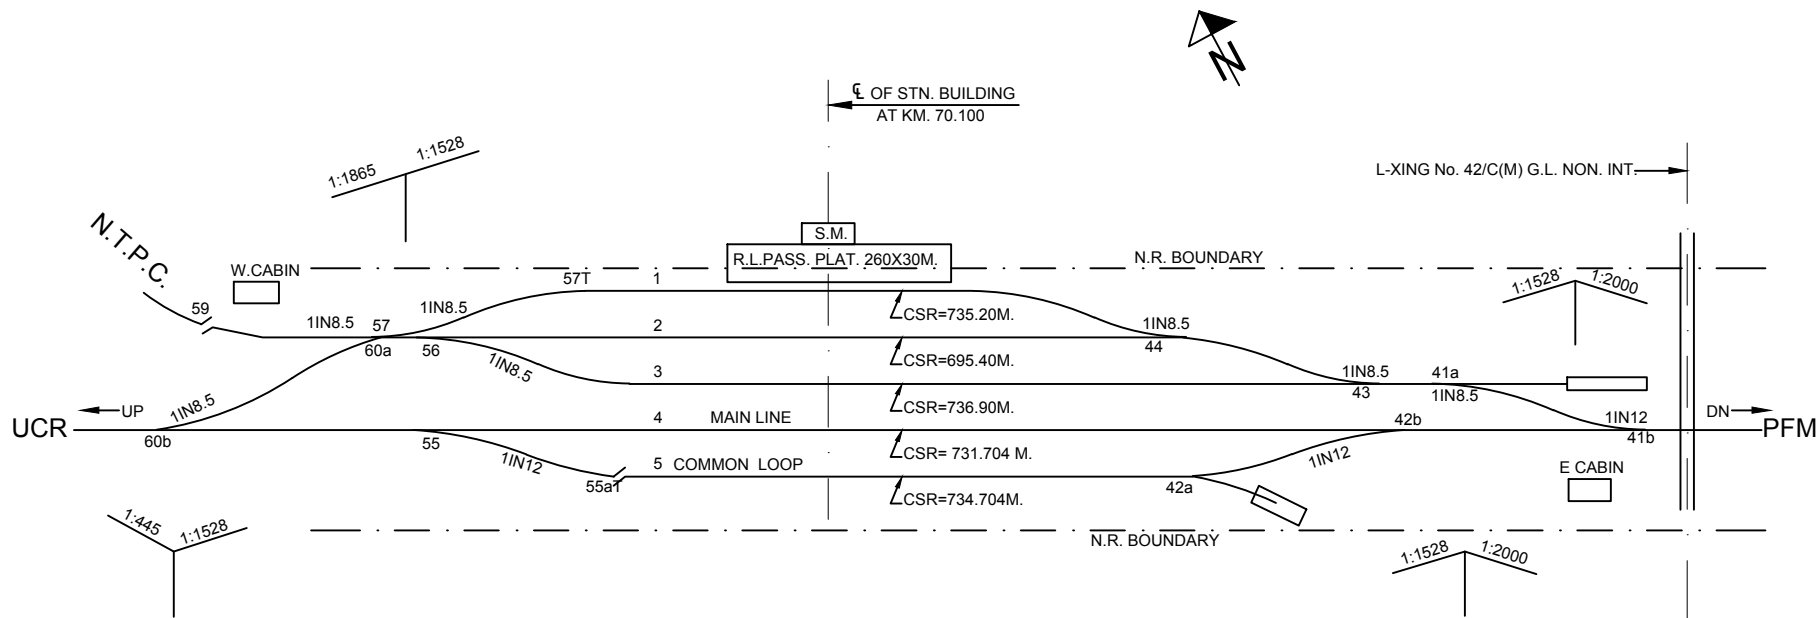

NORTHERN RAILWAY	
LUCKNOW DIVISION	
PFM-UCR-ON SECTION	
DIAGRAM OF	
ARKHA YARD	
R.L./M.S.L.	NOT TO SCALE
N.R. D.R.M. LKO. SKETCH NO. 309-06	

CHECKED BY	
DRAWN BY	

Sr. DEN/(IV)					
ADEN/PRG					
CORRECTED UPTO	18-02-2020				




NORTHERN RAILWAY LUCKNOW DIVISION	
<u>PFM-UCR-ON SECTION</u> <u>DIAGRAM OF</u> ATRAMPUR STN. YARD	
R.L./M.S.L.	NOT TO SCALE
N.R. D.R.M. LKO. SKETCH NO. 302-06	

S. No.	DESCRIPTION	SQ. m.
1.	AREA OF PLATFORM SHELTER (I) ON PLATFORM NO. 1 (II) ON PLATFORM NO. 2	825 825
2.	TOTAL AREA OF PLATFORM. (I) PLATFORM NO. 1 (II) PLATFORM NO. 2	6600.00 4941.00
3.	AREA OF WAITING ROOM (i) UPPER CLASS (LADIES) (ii) WAITING HALL (GENTS)	23.00 23.00 413.40
4.	CIRCULATING AREA	308.00

NOTES:-

- LAVATORIES:-
NO. OF SEATS (LADIES & GENTS, FLUSHED OR DRY)
LADIES = 6 } FLUSHED
GENTS = 6 }
- NO. OF WATER TAPS/HAND PUMPS
ON EACH P.F. & SOURCE OF WATER SUPPLY
TAPS = 20 NOS. (P.F. NO. 1)
TAPS = 48 NOS (P.F. NO. 2)
HAND PUMPS = 240 (TUBE WELL)
- BOOKING OFFICE
NO. OF WINDOWS 1+4
- YEAR OF CONSTRUCTION OF STN. BLDG. -
- WHETHER ENQUIRY OFFICE PROVIDED OR NOT - YES.

Drawn by	Corrected up to 31-3-04	31-3-2005	31-3-2007	31-3-2008	31-3-2010	31-3-2011	31-3-2012	31-3-2013	31-3-2014	31-3-2015	31-3-2016
S.S.E. (DRG.)											
RAWN BY	D.S.E. (T)										
	N.R. / LKO			DEN (V)	DEN (R)	DEN (Y)	DEN (Y)	DEN (Y)	DEN (Y)	ADEN / FD DEN (Y)	ADEN / FD SR DEN (Y)

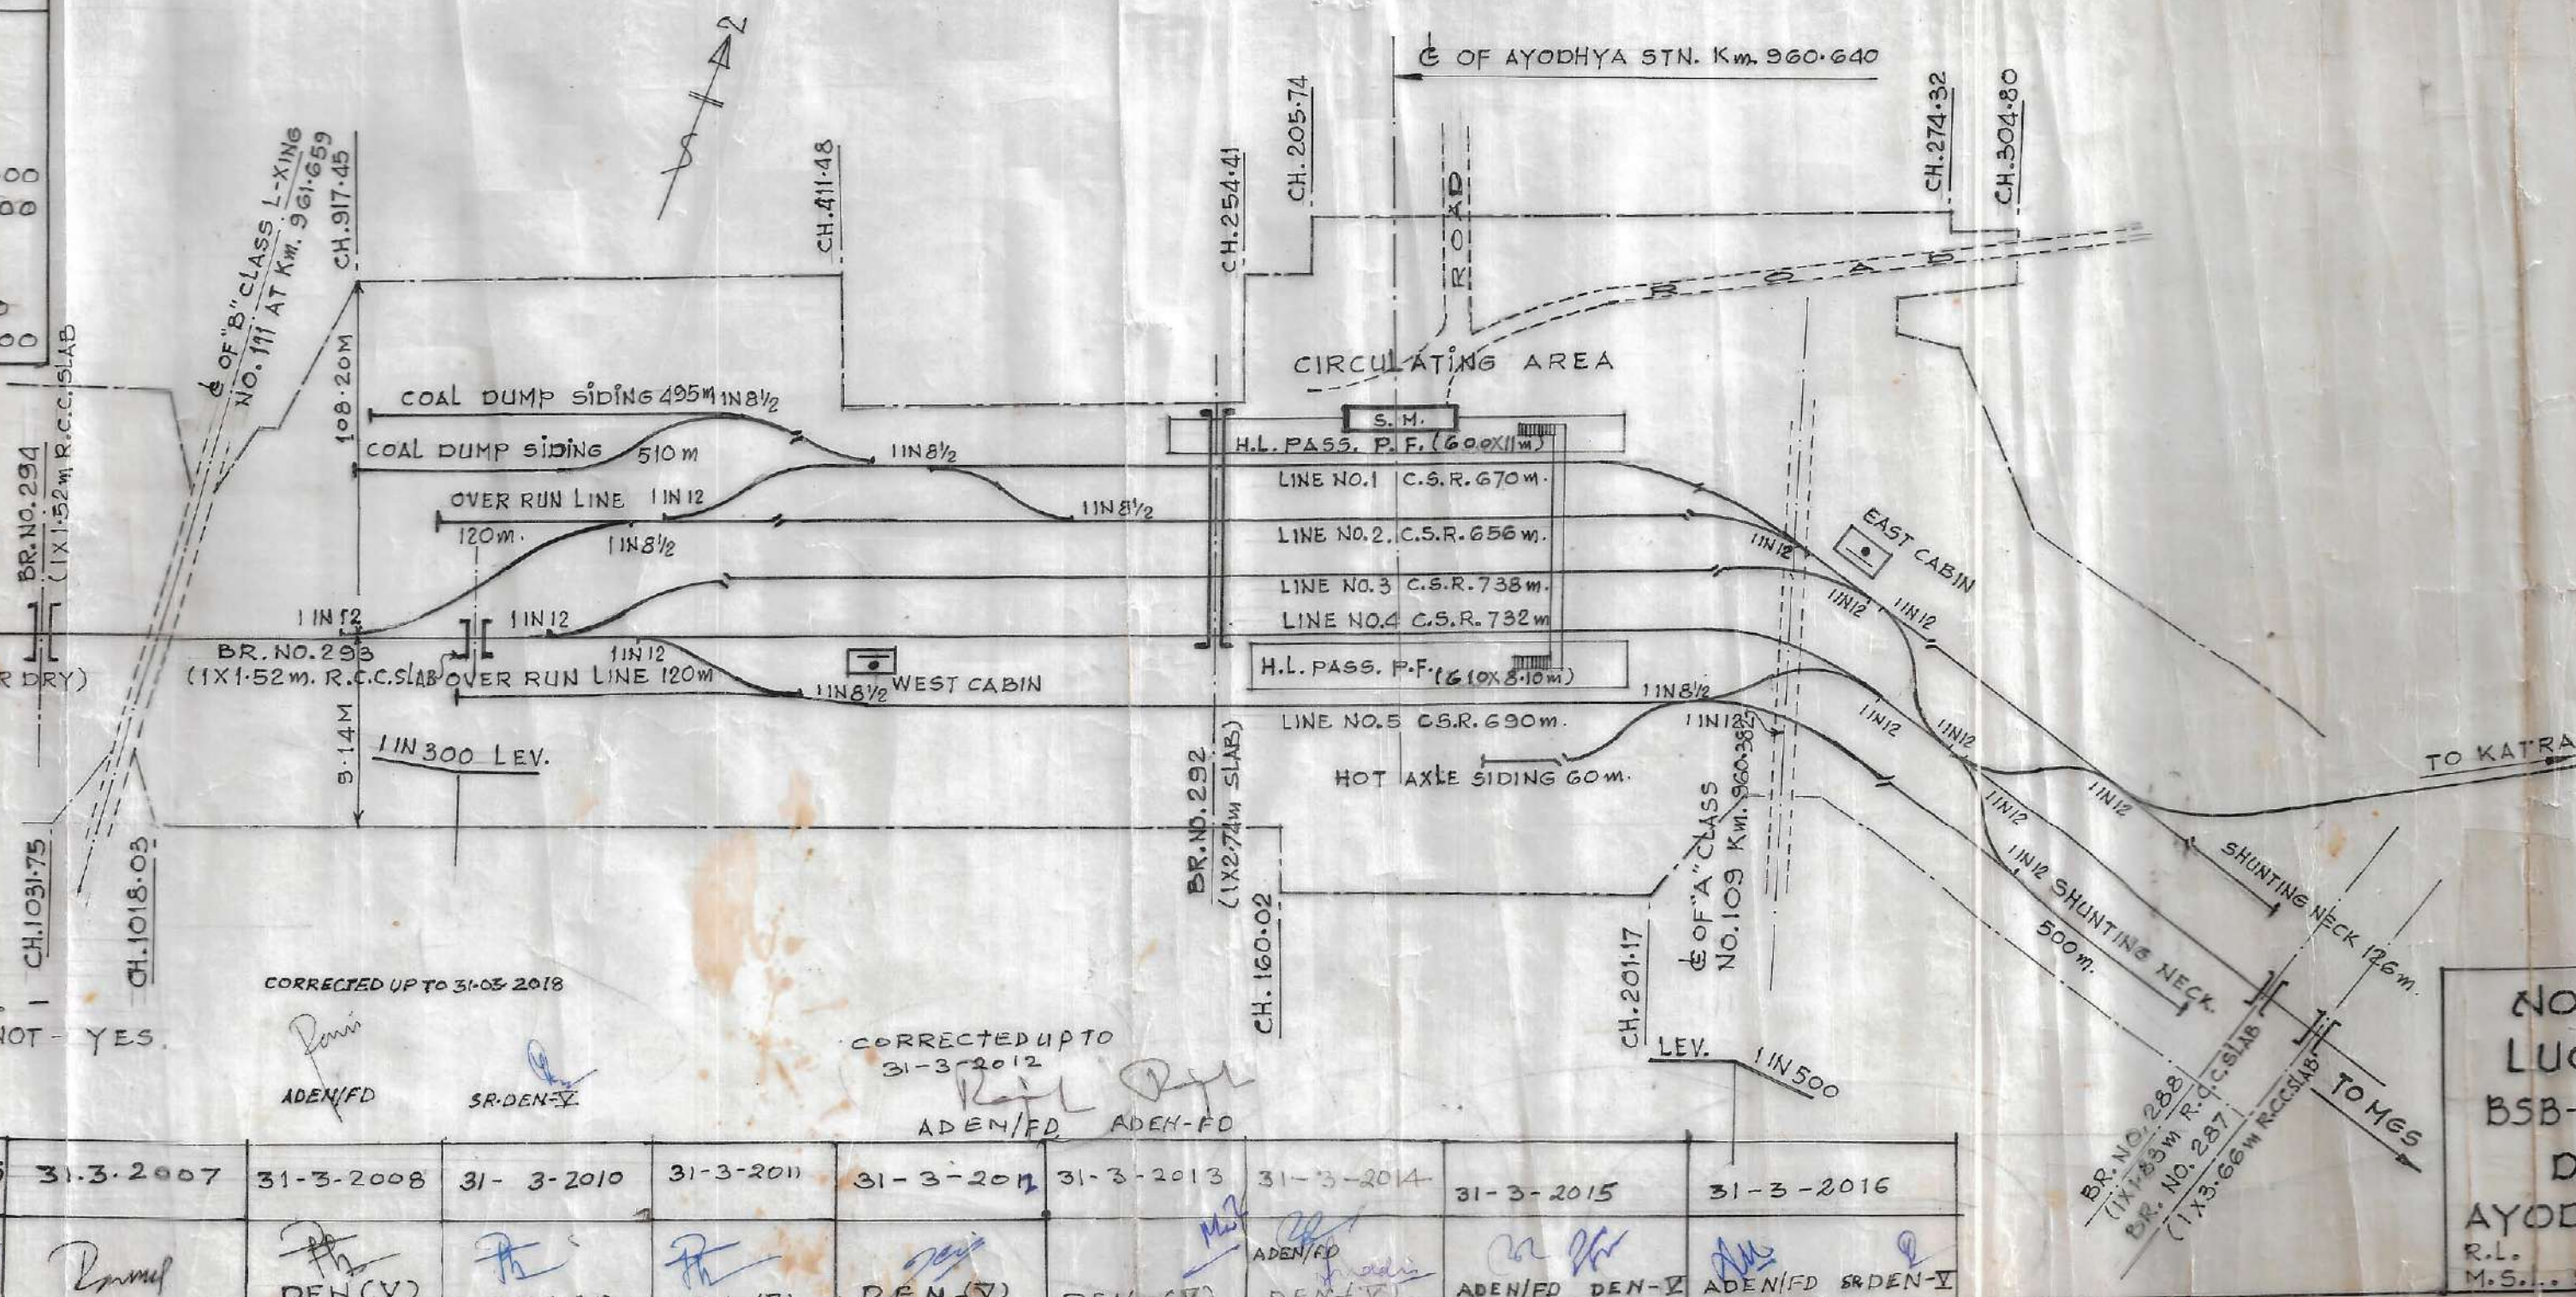

NORTHERN RAILWAY
LUCKNOW DIVISION
BSB-FD-LKO SECTION
DIAGRAM OF
AYODHYA STATION YARD
R.L.
M.S. 91.09 (NOT TO SCALE)

13


S. No.	DESCRIPTION	REMARKS			S. No.	DESCRIPTION	AREA (Sq.m.)
1	LAVATORIES	LAV.	URINAL		1.	AREA OF PLATFORM SHELTER	----
		LADIES	-	-		P/F No.1	----
		GENTS	-	-			----
2	NO OF WATER TAPS/HAND PUMPS ON EACH PLATFORM	P/F No.	TAPS	H.P.		<u>TOTAL AREA OF PLATFORM</u>	
		1	-	1	1.	PLATFORM NO. 1	1254.0
	SOURCE OF WATER SUPPLY	OPEN WELL			2.	PLATFORM NO. 2	1584.0
3	YEAR OF CONSTRUCTION OF STATION BUILDING	1998			3.	AREA OF WAITING ROOM	
4	BOOKING OFFICE NO. OF WINDOWS	ADV. RES.	CURRENT		I- UPPER CLASS WAITING ROOM	----	
		1			II- AREA OF WAITING ROOM	----	
5	NO. OF SEATS	P.F. 1	W/HALL	TOTAL	a- LADIES	----	
		40	-	-	b- GENTS	----	
6	WHETHER ENQUIRY OFFICE PROVIDED OR NOT				III- WAITING HALL	21.70	
					4.	CIRCULATING AREA	200.00

REF.	FENCING	KUTCHA	----
		PUGGA	----
	ROAD	METALLED	=====
		UNMETALLED	=====

CORRECTED UP TO 31-03-2018

ADEN/BSB

SR-DEN-III

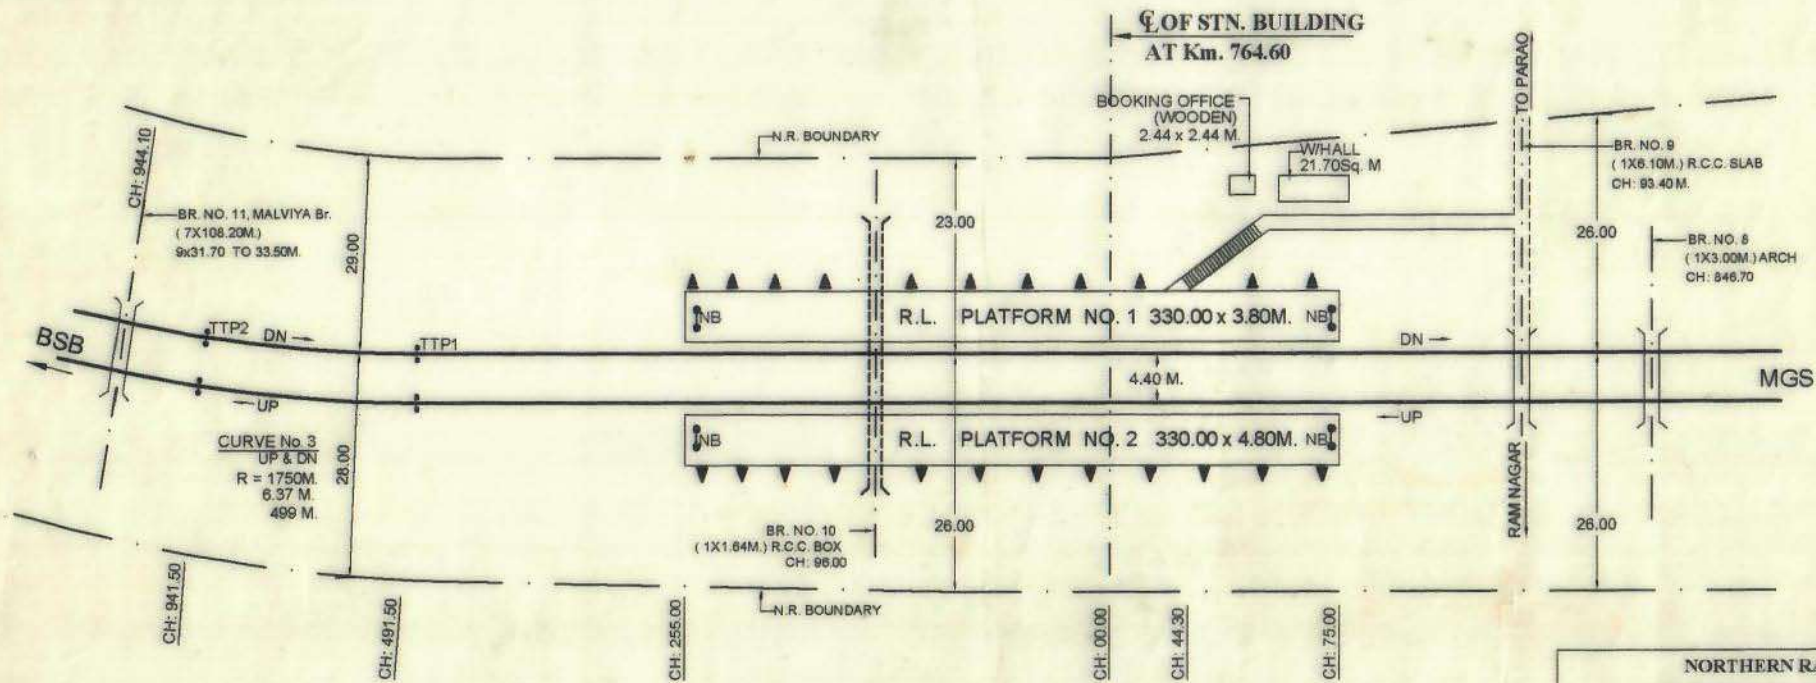

NORTHERN RAILWAY	
LUCKNOW DIVISION	
LKO - PBH - MGS SECTION	
DIAGRAM OF	
BABA BHAGWAN RAM HALT STN: YARD	
R.L./M.S.L. 96.930	NOT TO SCALE
N.R. DIV L. SKETCH NO.	M-120/LKO/2012

CHECKED BY	DAKSCH
DRAWN BY	255, 2ND FLOOR, LOKMATA JYOTI, RAIPUR, CHHISGARH, INDIA

SR-DEN-III	SR-DEN-II	SR-DEN-I	SR-DEN-IV	SR-DEN-V	SR-DEN-VI
ADEN/BSB	ADEN/BSB	ADEN/BSB	ADEN/BSB	ADEN/BSB	ADEN/BSB
CORRECTED UPTO	31-03-12	31-3-13	31-3-2014	31-3-15	31-3-16

14A




LEGEND:-

1. EXISTING WORK SHOWN THUS _____
2. PROPOSED WORK SHOWN THUS _____
3. DISMENTLING WORK SHOWN THUS _____
4. THIS DRAWING IS NOT TO SCALE

S.No	DESCRIPTION	1 in 12	1 in $8\frac{1}{2}$	TRAP
1.	DISMANTLING OF TURN OUT	2	1	2
2.	INSERTION OF TURN OUT	8	0	1



BACHHRAWAN STATION YARD

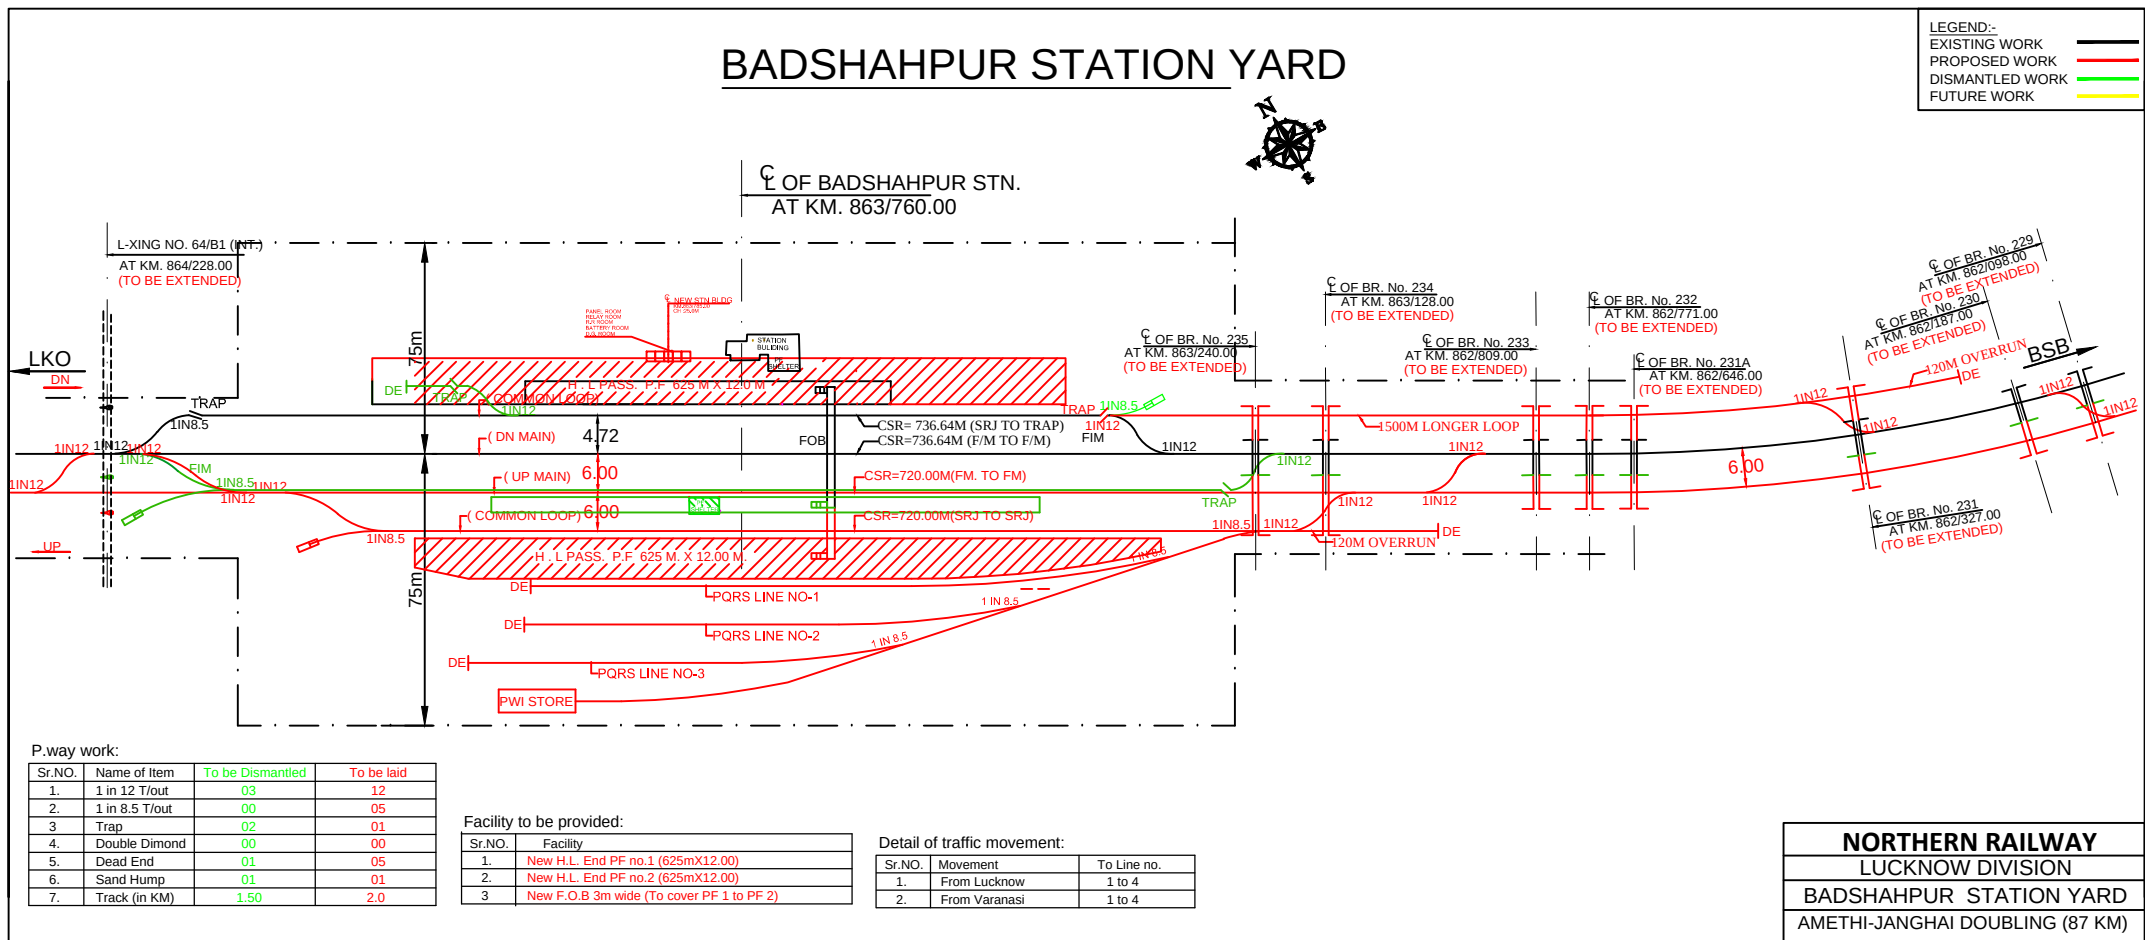

S.No	DESCRIPTION	Sq.m.
1	AREA OF PLATFORM SHELTERS	
	1. ON PLATFORM NO 1	NIL
	2. ON PLATFORM NO 2	NIL
2.	TOTAL AREA OF P.F.	
	I. PLATFORM NO 1.	1120.00
	II. PLATFORM NO 2	NIL
3.	AREA OF WAITING ROOM.	
	I. UPPER CLASS (LADIES)	NIL
	(GENTS)	NIL
	WAITING HALL	12.67

NOTE:-

1. LAYAVATORIES
(a) NO OF SEATS (LADIES & GENTS FLUSHED OR DRY
2. NO OF WATER TAPS/HAND PUMPS ON EACH P.F.
AND SOURCE OF WATER SUPPLY.
3. YEAR OF CONSTRUCTION OF THE STATION BUILDING
4. BOOKING OFFICE
(a) NO OF WINDOWS
5. WHEATHER ENQUIRY OFFICE PROVIDED OR NOT

LADIES-NIL
GENTS-NIL
TAPS-NIL
H.P = ONE

CONTRACTOR
ALMIRAN

N.R.D.R.M. SKETCH NO: 215-2K

CORRECTED UP TO 31.3.2001

D.S.E.-II/NR/LKO

CORRECTED UP TO YEAR	SIGNATURE
31.3.2005	
31-3-2006	
31-3-2007	
31.03.2010	
31.03.2011	
31.3.2012	
CORRECTED UP TO 31-3-2016	
ADEN-RBL	SR DEN-II

REF:-
FENCING


KUTCHA

PUCCA

ROAD

METALLED

UNMETALLED

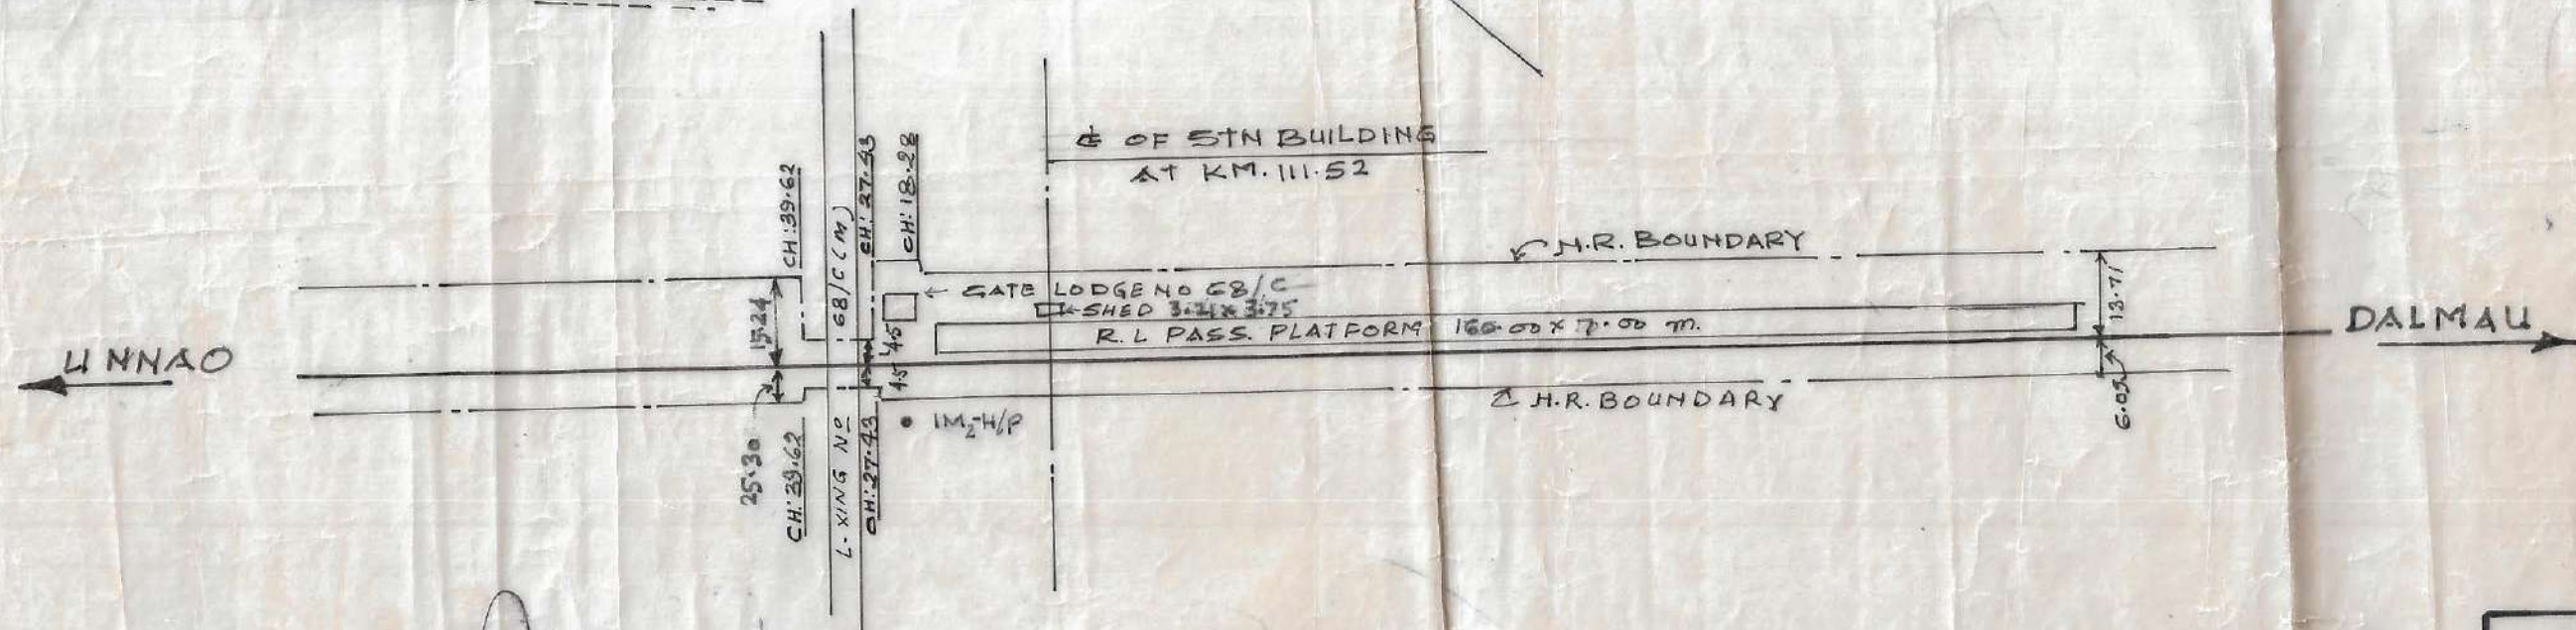

CORRECTED UP TO 31-3-11
ADEN/RBL

CORRECTED UP TO 31-3-2002

DSE-II/NR/LKO

CORRECTED UP TO 31-3-12

CORRECTED UP TO 31-3-13

CORRECTED UP TO 31-3-14

ADEN/RBL

SR DEN-II

ADEN/RBL SR DEN-II

CORRECTED UP TO 31-3-2003

CORRECTED UP TO 31-3-15

D.S.E.-II/NR/LKO

ADEN/RBL

SR DEN-II

NORTHERN RAILWAY

LUCKNOW DIVISION

PFM-UGR-ON SECTION

DIAGRAM OF
BAHAI HALT STN YARD

NOT TO SCALE


CHECKED

DRAWN

Signature

S. No.	DESCRIPTION	REMARKS			S. No.	DESCRIPTION		AREA (Sq.m.)
1	LAVATORIES		LAV	URINAL	1	AREA OF PLATFORM SHELTER	P/F No.1	.
		LADIES	2	1			P/F No.2	.
		GENTS	.					
2	NO OF WATER TAPS, HAND PUMPS ON EACH PLATFORM	P/F No.	TAPS	H.P.	2	TOTAL AREA OF PLATFORM		
		.	.	1		PLATFORM NO. 1	2256	
						PLATFORM NO. 2	.	
SOURCE OF WATER SUPPLY					3	AREA OF WAITING ROOM		
3	YEAR OF CONSTRUCTION OF STATION BUILDING					I. UPPER CLASS WAITING ROOM		.
4	BOOKING OFFICE	ADV. RES.	CURRENT RES.			II. AREA OF WAITING ROOM		.
	NO. OF WINDOWS	1.				a. LADIES		.
5	NO. OF SEATS	P/F No.1	P/F No.2		b. GENTS		.	
		18			III. WAITING HALL		42.97	
6	WHETHER ENQUIRY OFFICE PROVIDED OR NOT				4	CIRCULATING AREA		.

REF.	FENCING	KUTCHA	PUCCA
	ROAD	METALLED	UNMETALLED

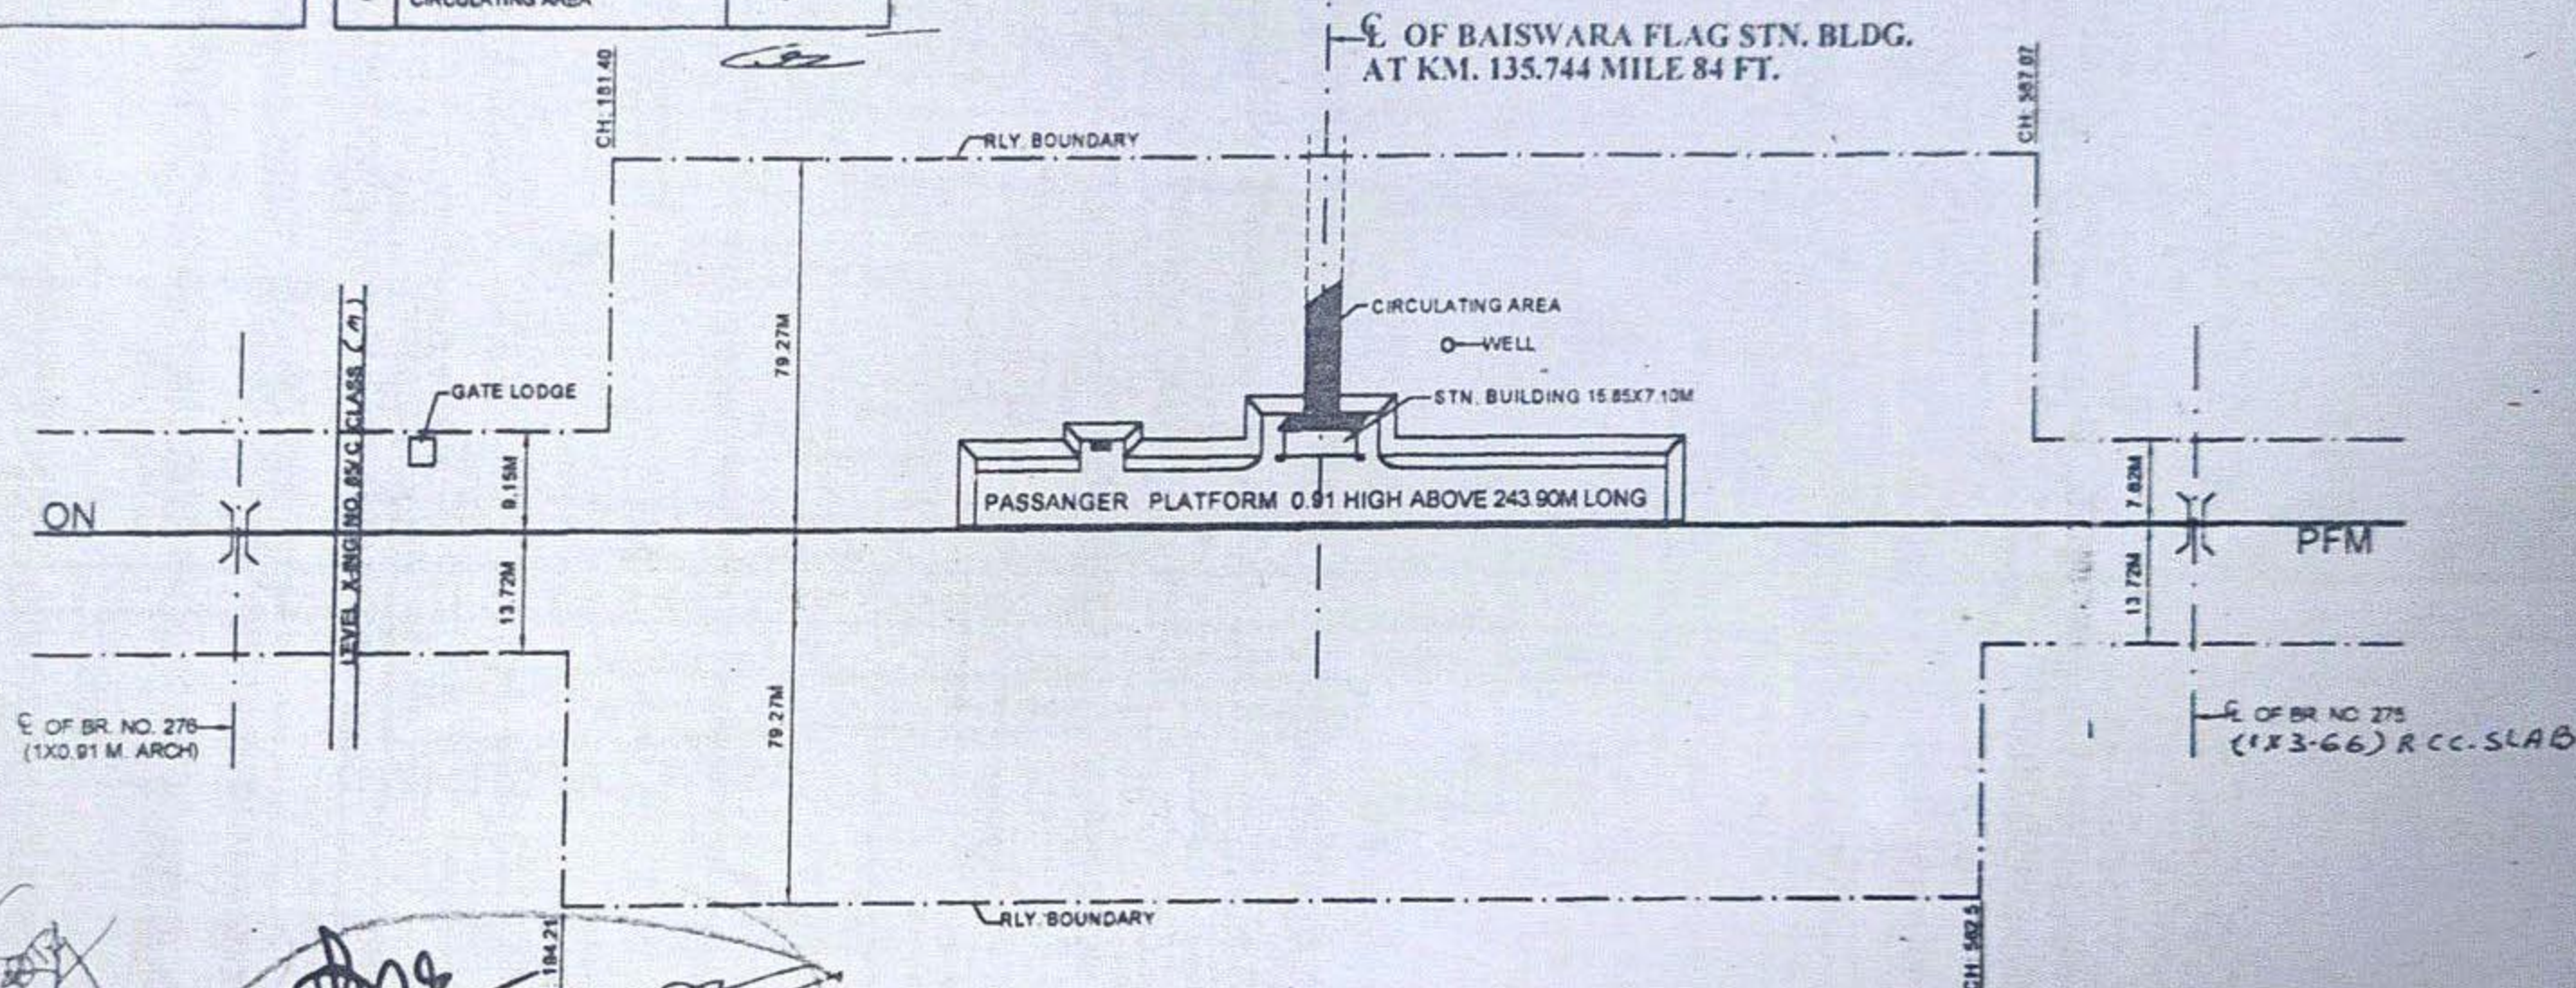

ADEN/RBL SR.DEN-II
CORRECTED UPTO 31-3-15

ADEN/RBL SR.DEN-II
CORRECTED UPTO 31-3-16

Senior Section Engineer (P.Way)
Rly. Dalmiya

ADEN-RBL

ADEN-RBL

NORTHERN RAILWAY
LUCKNOW DIVISION
PFM-UCR-ON SECTION
DIAGRAM OF
BAISWARA FLAG STN: YARD

CHECKED BY
DRAWN BY


SR.DEN-II
ADEN/RBL
CORRECTED UPTO 31-3-2014

Sr. D.E.N (II)	31-3-2010	31-3-2011	31-3-12	31-3-13
CORRECTED UPTO				

RL/MSL
NOT TO SCALE
N.R. D.R.M. LKO. SKETCH NO.



C/L OF BAKHSHA STN.
AT KM. 841.090

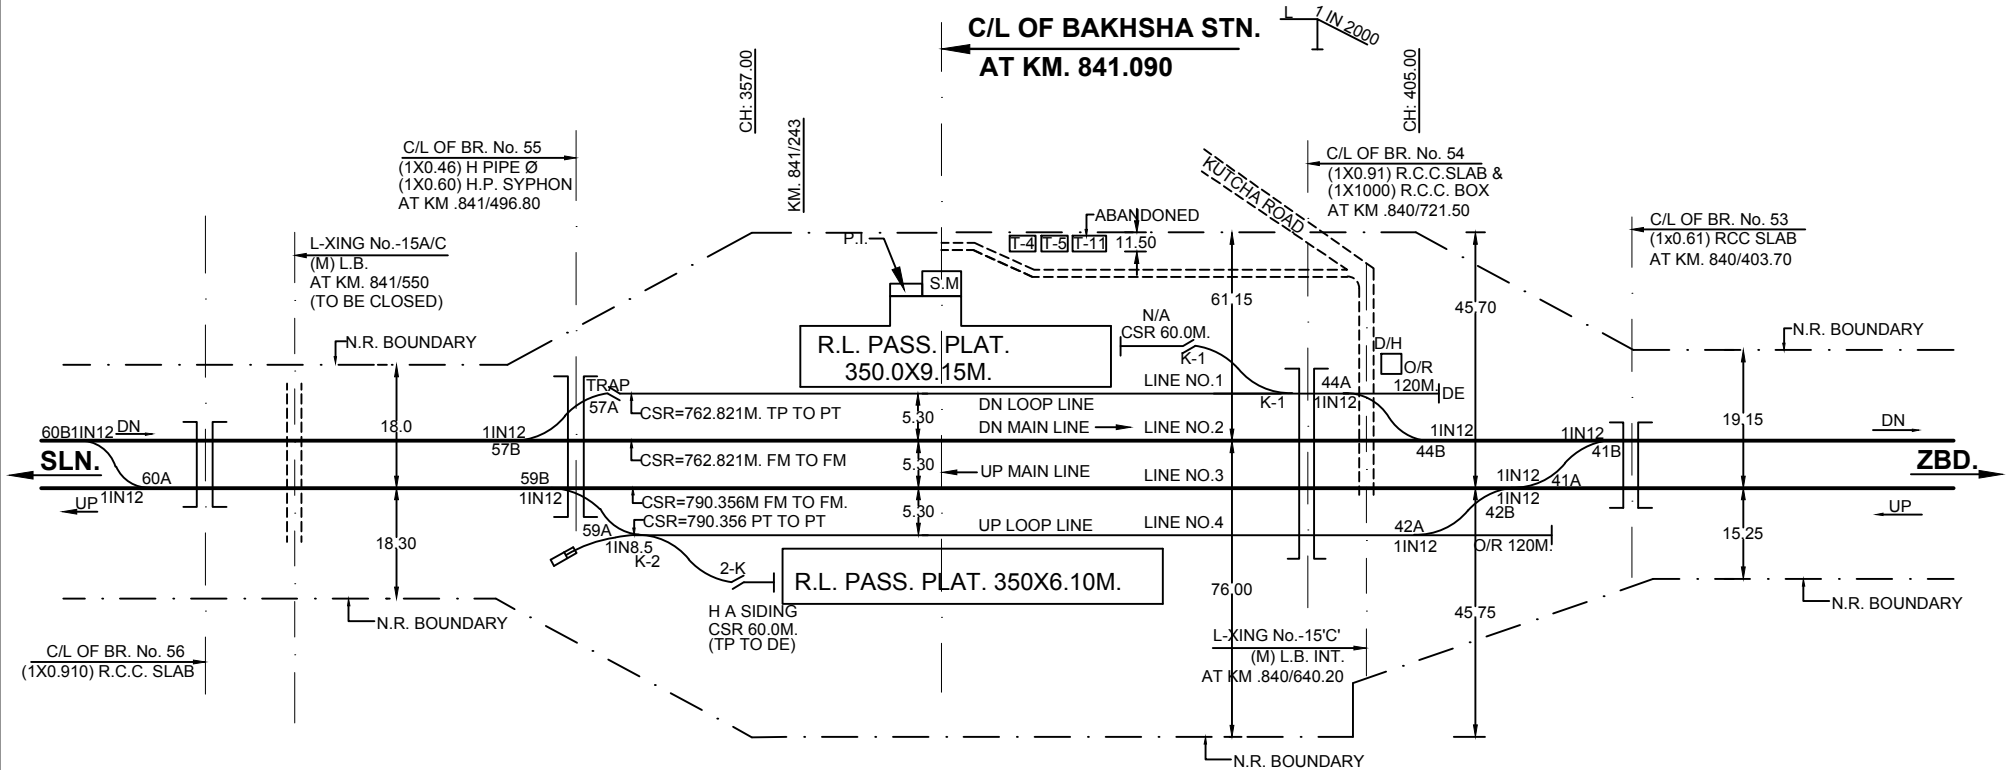

NORTHERN RAILWAY
LUCKNOW DIVISION

LKO -SLN-ZBD SECTION

DIAGRAM OF

BAKSHSHA STN. YARD

R.L./M.S.L. 84.725m

NOT TO SCALE

N.R. D.R.M. LKO. SKETCH NO.

262-06

Sr. DEN/(IV)

ADEN/SLN-II

CORRECTED UPTO


18-02-2020

CHECKED BY

DRAWN BY



**C/L OF BAKKAS STN.
AT KM. 1036/817.40**

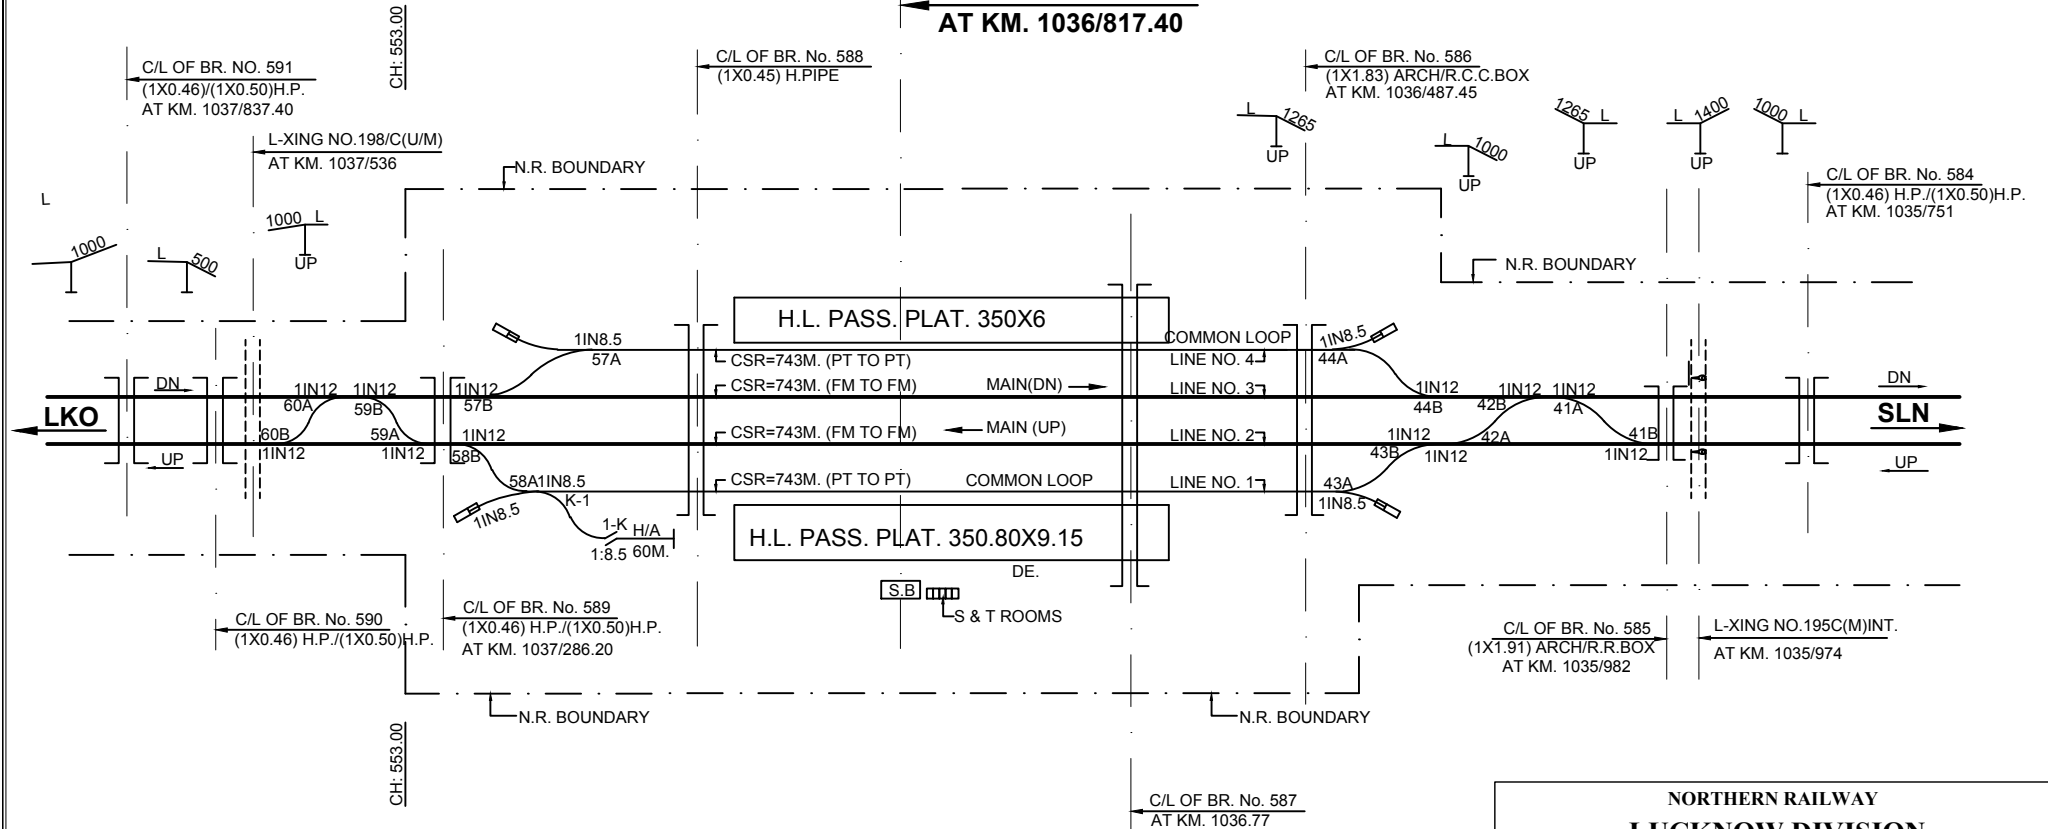


**NORTHERN RAILWAY
LUCKNOW DIVISION
LKO -SLN-ZBD SECTION
DIAGRAM OF
BAKKAS STN. YARD**

CHECKED BY	
DRAWN BY	

Sr. DEN/(IV)					
ADEN/SLN-I					
CORRECTED UPTO	18-02-2020				

R.L./M.S.L. 119.950m	NOT TO SCALE
N.R. D.R.M. LKO. SKETCH NO.	286 - 06

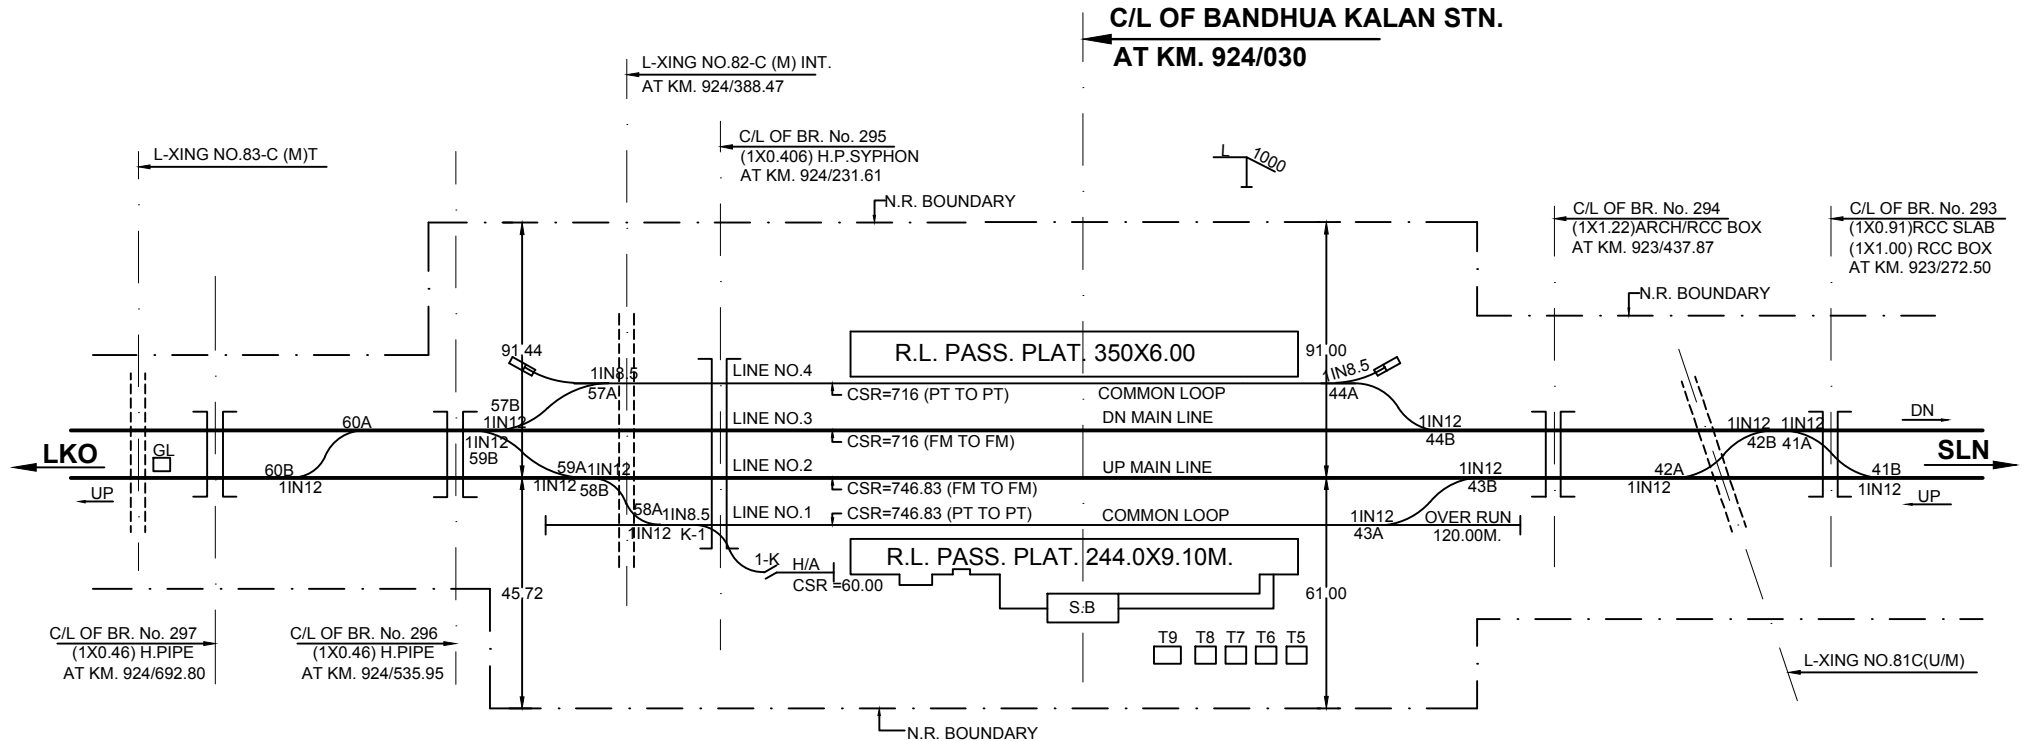

NORTHERN RAILWAY LUCKNOW DIVISION	
LKO -SLN-ZBD SECTION	
DIAGRAM OF	
BANDHUA KALAN STN. YARD	
R.L./M.S.L. 97.905m	NOT TO SCALE
N.R. D.R.M. LKO. SKETCH NO.	273.06


CHECKED BY		Sr. DEN/(IV)					
		ADEN/SLN-I					
		CORRECTED UPTO	18-02-2020				

LEGEND:-

1. EXISTING WORK SHOWN THUS —
2. PROPOSED WORK SHOWN THUS —
3. DISMENTLING WORK SHOWN THUS —



CL OF BANI STN. BLDG. AT KM. 956.870

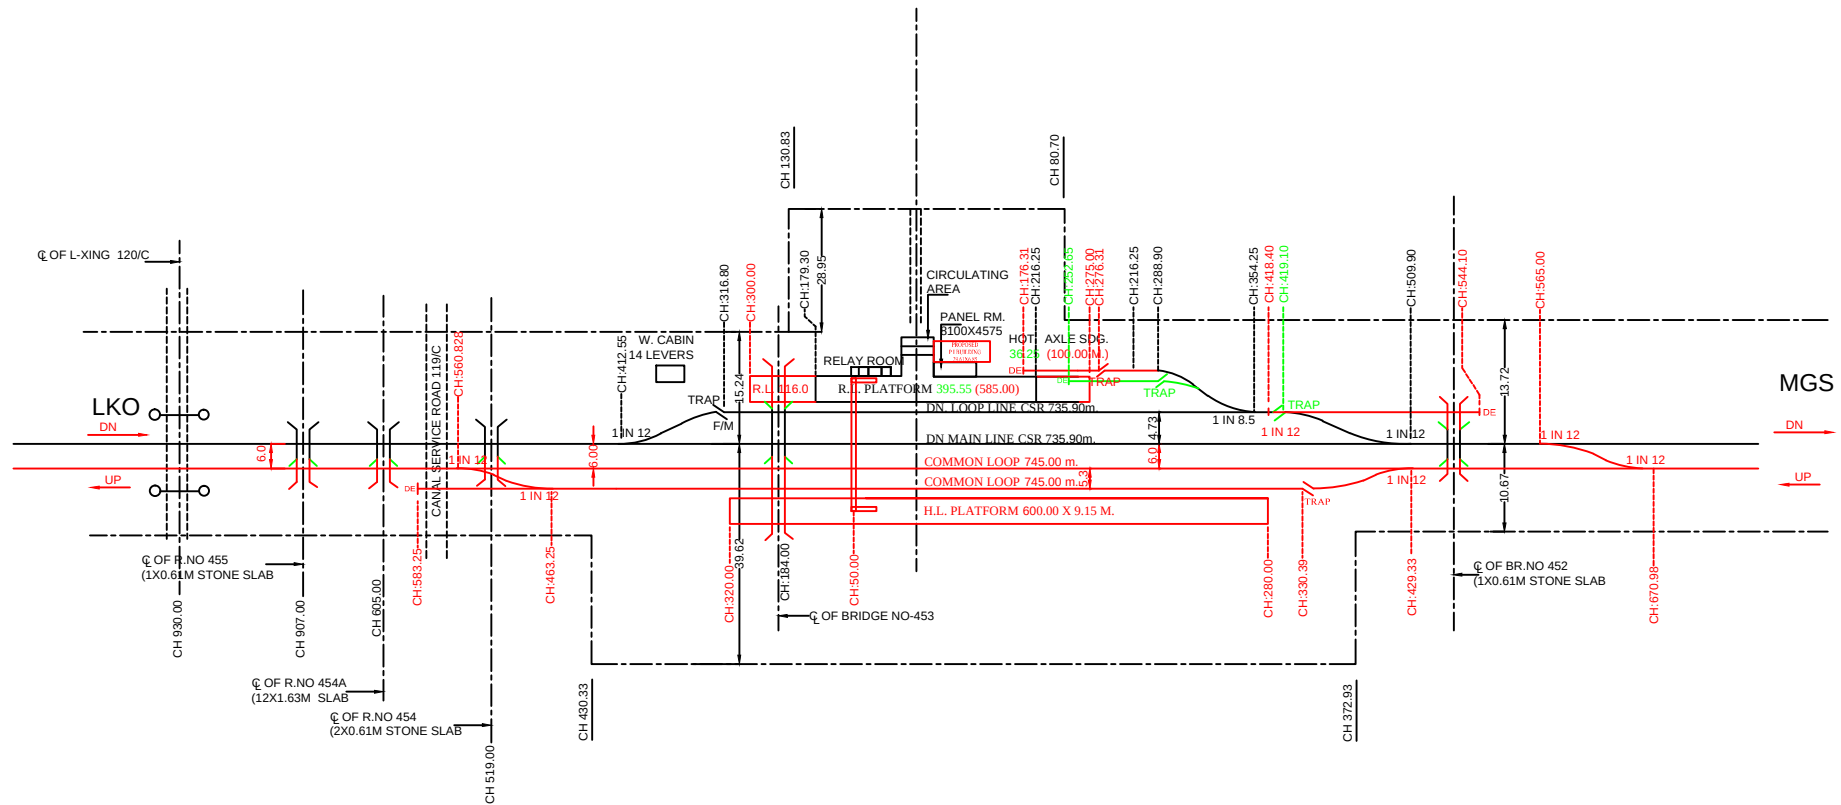

Sr.No.	LINE TYPE	CSR (FM-FM)
1	DN.L.L	735.91m
2	DN.M.L	735.91m
3	UP.M.L	745.0m
4	UP.L.L	745.0m
5	H.A SID.	100.0m


T.O	1 in 12		1 in 8.5		TRAP		DE	SH
	L	R	L	R	SS	L	R	
EXISTING	1	1	-	1	-	1	1	-
DISMANTLING	-	-	-	-	-	-	1	-
PROPOSED	1	5	-	-	-	1	1	3

SCALE:- THIS DRAWING IS NOT TO SCALE





BANI STATION YARD

BARABANKI STATION YARD

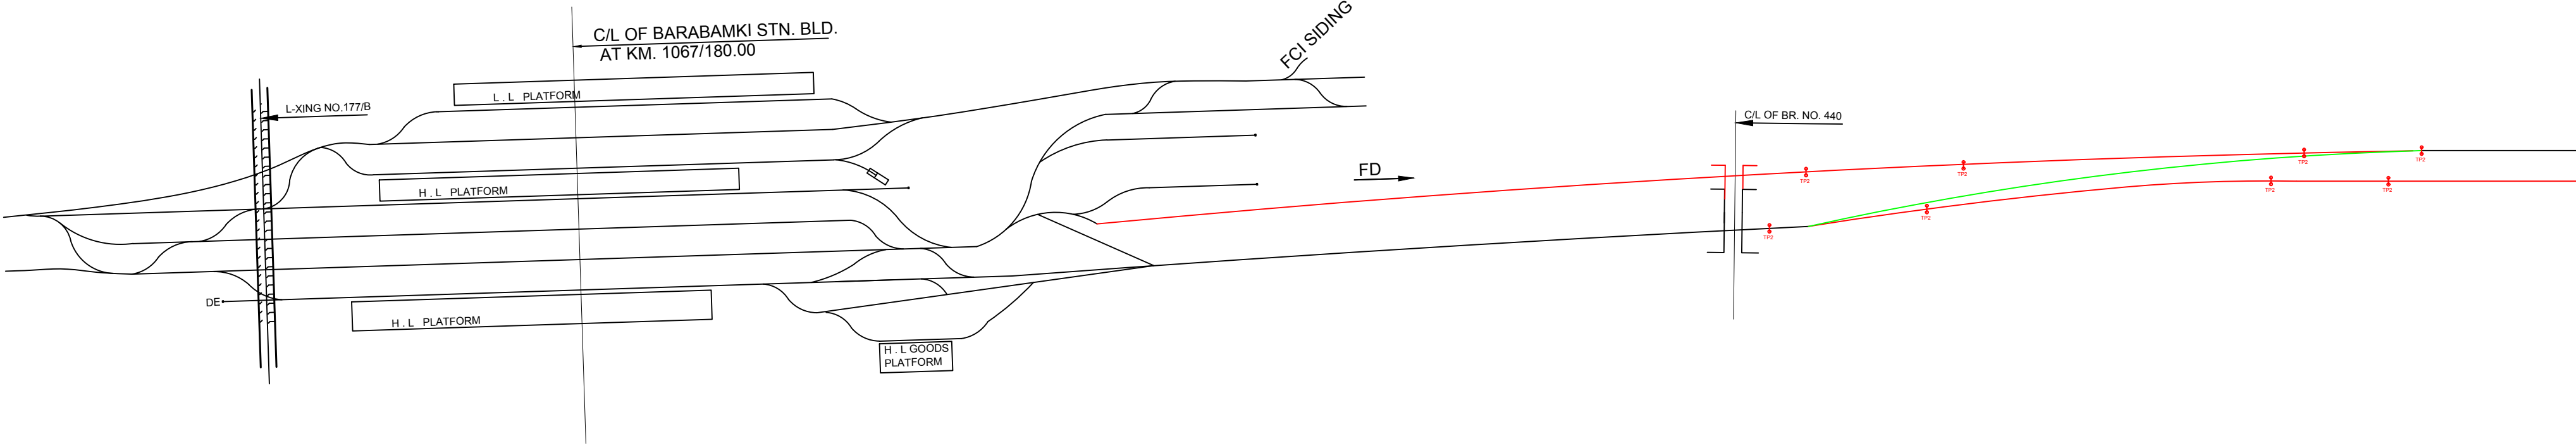

BARAGAON STATION YARD

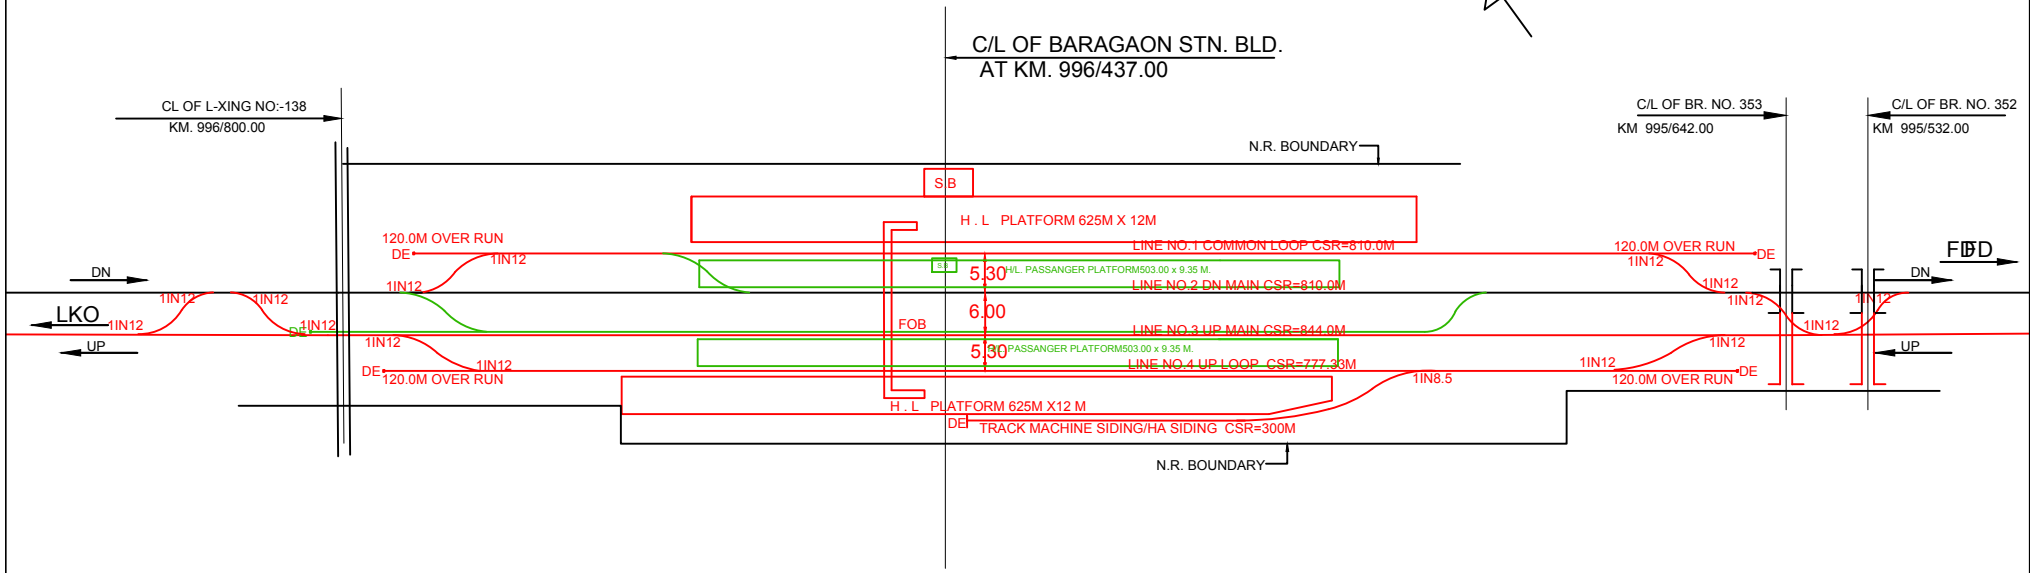

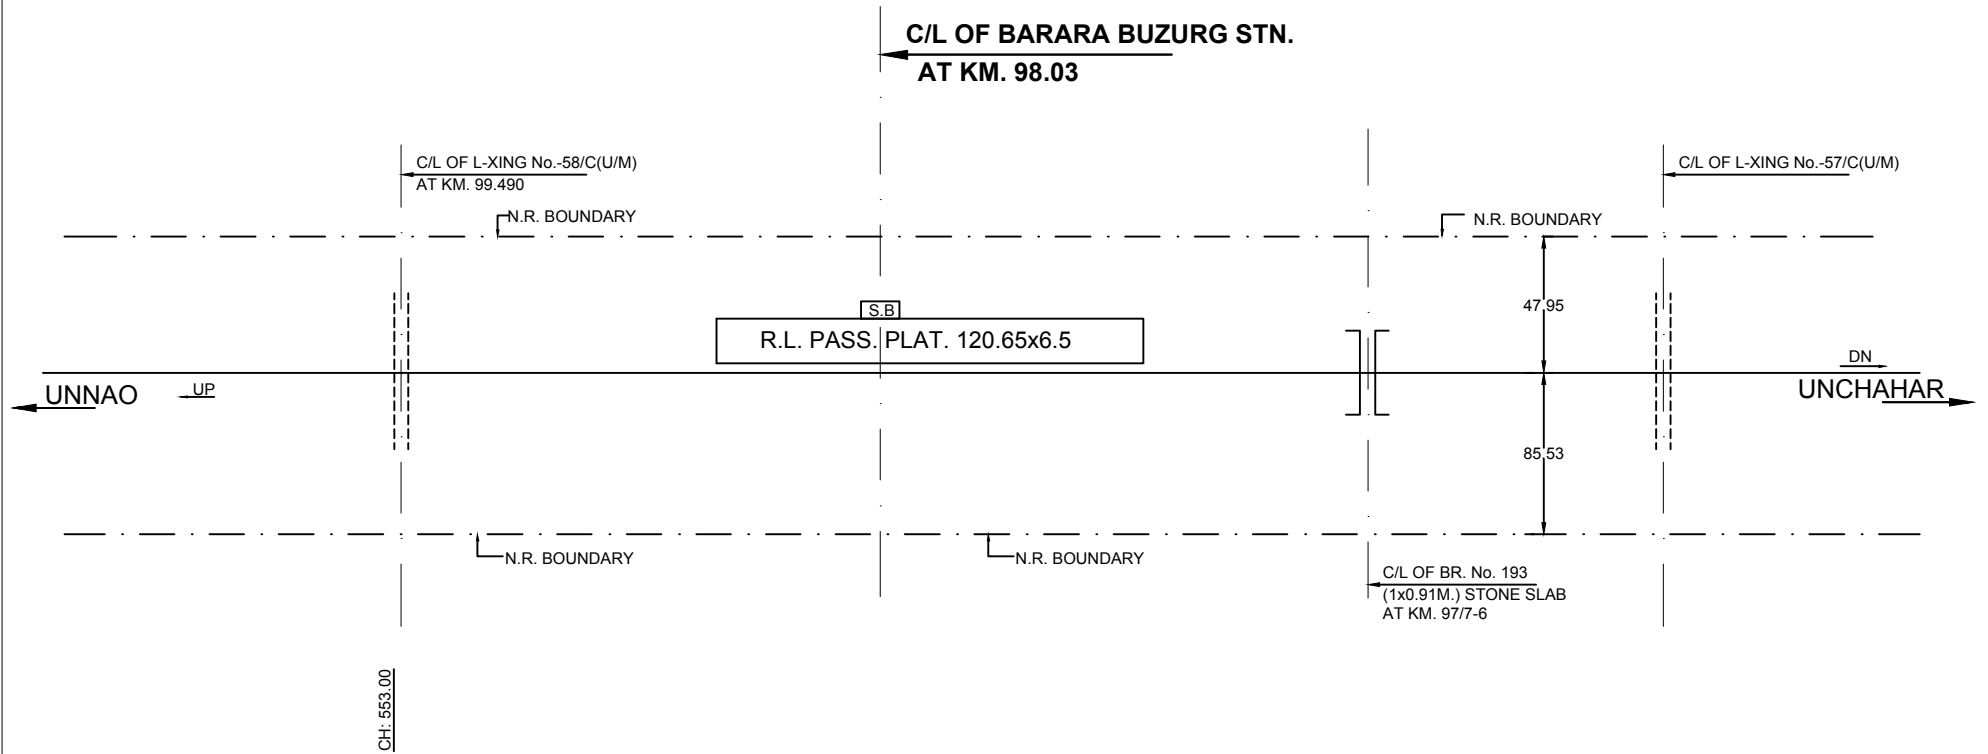

NORTHERN RAILWAY	
LUCKNOW DIVISION	
PFM-UCR-ON SECTION	
DIAGRAM OF	
BARARA BUZURG STN. YARD	
R.L./M.S.L.	NOT TO SCALE
N.R. D.R.M. LKO. SKETCH NO.	M-133/LKO/2012

CHECKED BY	
DRAWN BY	

Sr. DEN/(IV)					
ADEN/PRG					
CORRECTED UPTO	18-02-2020				

S. No.	DESCRIPTION	REMARKS			S. No.	DESCRIPTION	AREA (sq.m.)
		CLASH	LAV.	WATER			
1	LAVATORY				1	AREA OF PLATFORM	PF No.1
							PF No.2
2	NO. OF WATER TAP/HAND PUMPS ON EACH PLATFORM	PF No.	TAPS	H.P.	2	TOTAL AREA OF PLATFORM	
						PLATFORM NO. 1	
						PLATFORM NO. 2	
3	SOURCE OF WATER SUPPLY				3	AREA OF WAITING ROOM	
4	YEAR OF CONSTRUCTION OF STATION BUILDING					1- UPPER CLASS WAITING ROOM	
5	BOOKING OFFICE	ADV. NO.		CURRENT NO.		2- AREA OF WAITING ROOM	
						3- LADIES	
6	NO. OF WINDOWS	PF No.1		PF No.2		4- GENTS	
7	NO. OF SEATS					5- WAITING HALL	
8	WHETHER BRACKY OFFICE PROVIDED OR NOT				6	CIRCULATING AREA	


The diagram illustrates the layout of Barseethi Stn. Yard. It features a central 'PASSANGER PLATFORM' (178.12x6.41 R.L.) with a 'CIRCULATING AREA' and a '2 LEVER FRAME' nearby. The platform is flanked by 'SINGLE LEVEL FRAME' structures. The yard is bounded by 'RLY BOUNDARY' lines. Dimensions are provided for various sections: 76.22 M, 76.27 M, 21.34 M, 10.67 M, 24.30 M, and 24.30 M. The diagram also shows the 'JNH' (Junction) and 'Z.B.O.' (Zonal Boundary) lines. A note indicates the location is 'E. OF BARSETHI STN. BLDG. AT KM. 15.56 FROM JNH'. The diagram is titled 'DIAGRAM OF BARSETHI STN. YARD' and is part of the 'ALD-JNH-JNU SECTION' under the 'LUCKNOW DIVISION' of the 'NORTH INDIA RAILWAY'.

St. D.E.N. (R) *[Signature]*

CORRECTED UPTO 31-3-2000

RL/MLL NOT TO SCALE

N.R. D.E.N. LMO, SKETCH NO. —

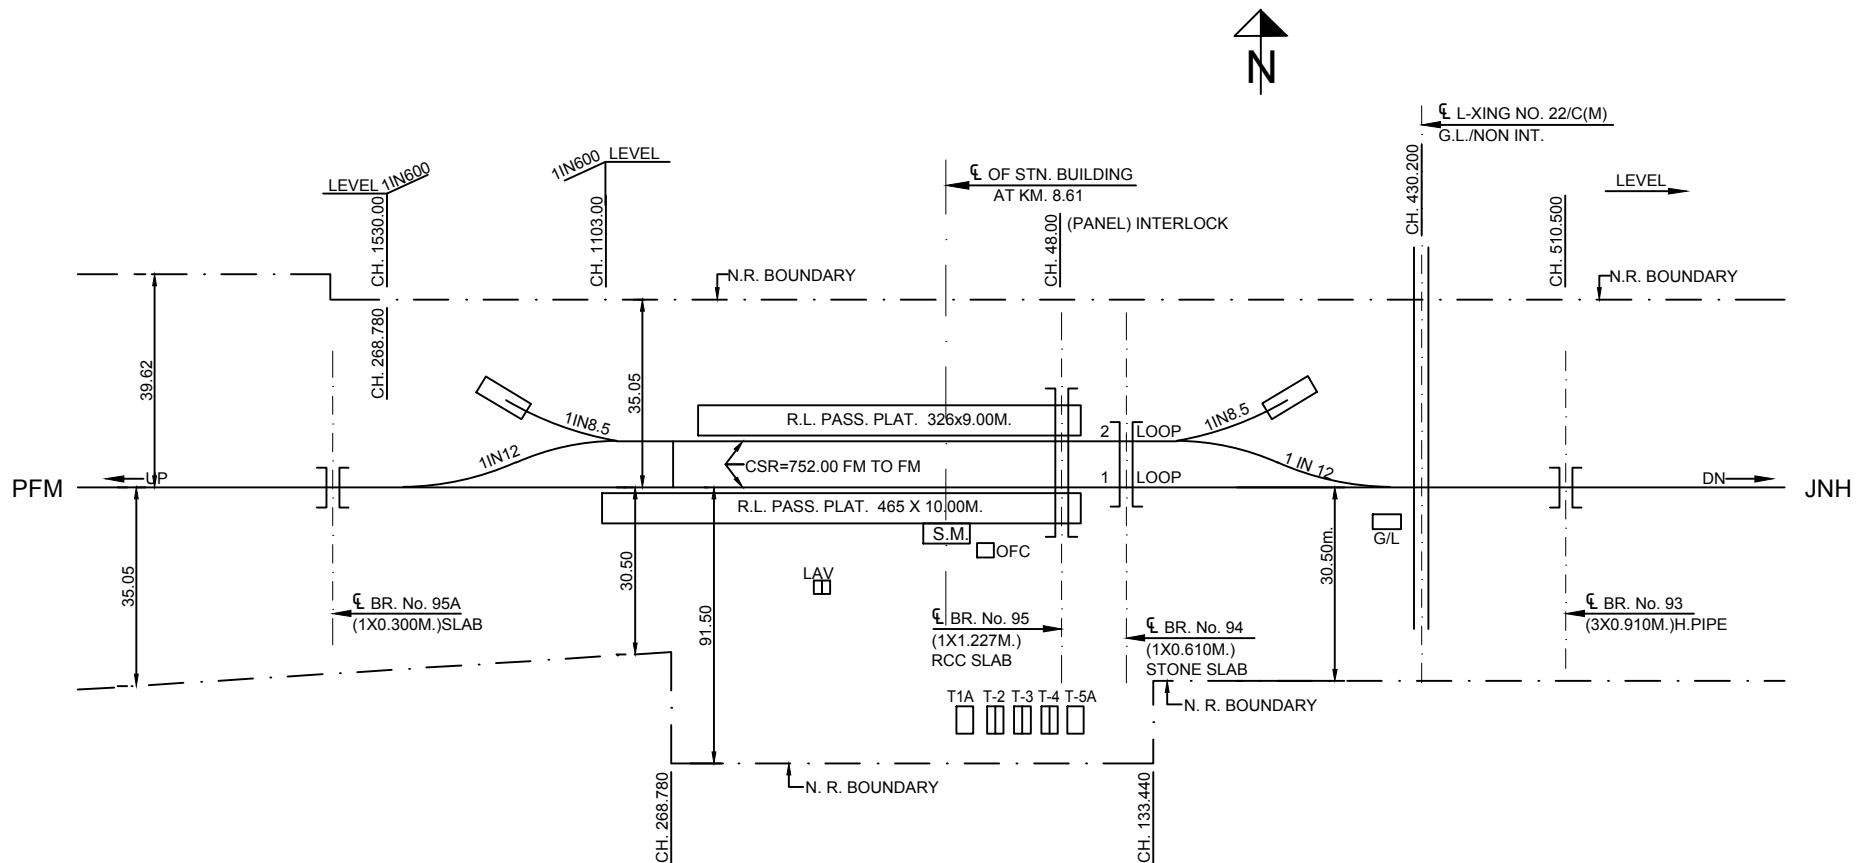

NORTHERN RAILWAY
LUCKNOW DIVISION

JNH-PFM SECTION
DIAGRAM OF
BARYARAM STN. YARD

R.L./M.S.L. 95.420m NOT TO SCALE
N.R. D.R.M. LKO. SKETCH NO. 301-06

CHECKED BY

DRAWN BY

Sr. DEN/(IV)

ADEN/PRG


CORRECTED UPTO

18-02-2020



C/L OF L-XING NO. 64'C(M) INT.
AT KM.899/990

C/L OF BHADAIYAN STN.BLDG.
AT KM. 900/250

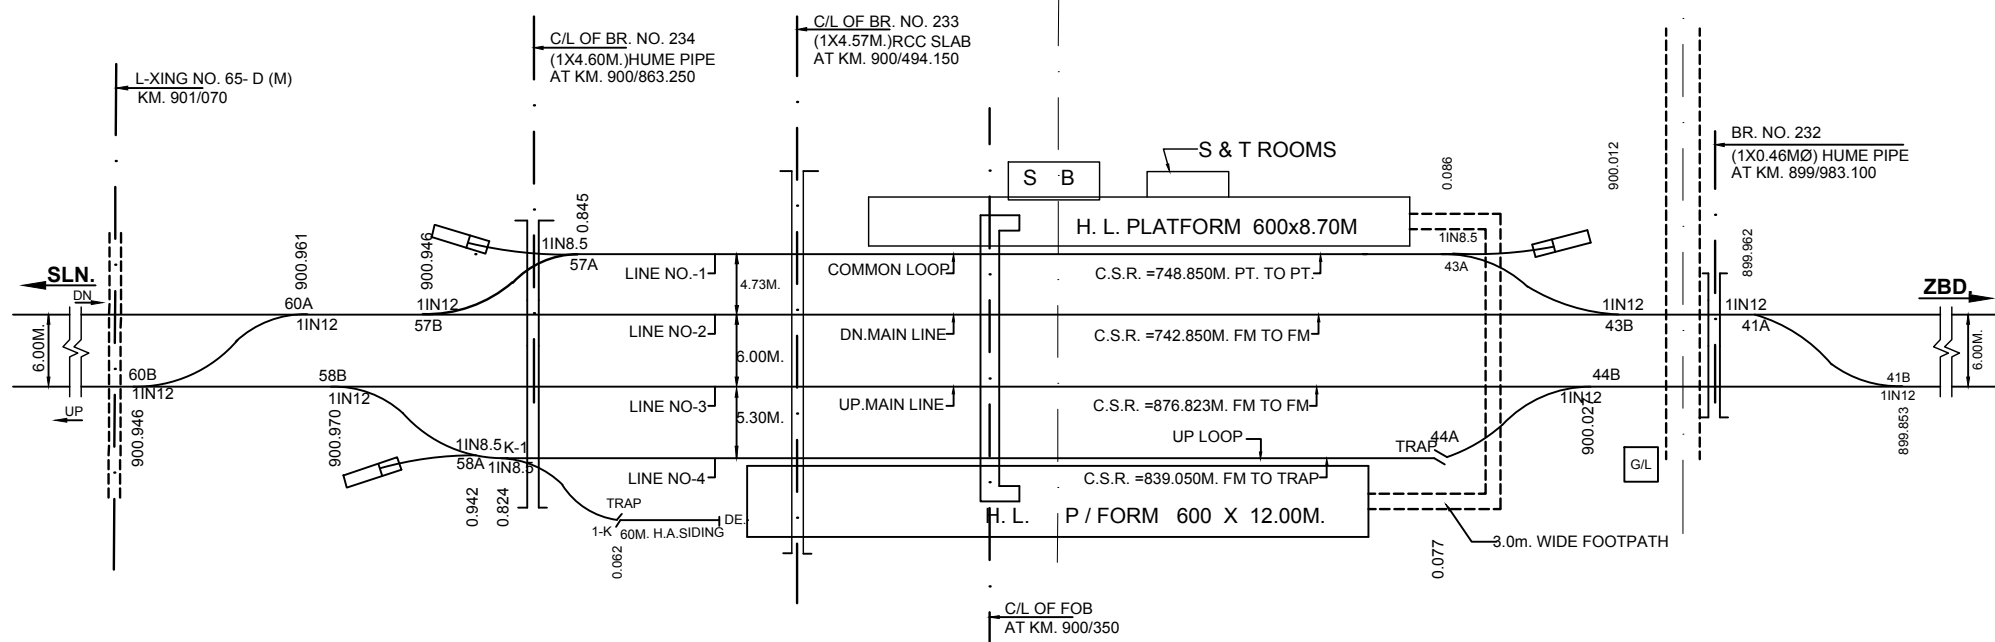


NORTHERN RAILWAY
LUCKNOW DIVISION


LKO -SLN-ZBD SECTION
DIAGRAM OF
BHADAIYAN STN. YARD.

R.L./M.S.L. 107.665m NOT TO SCALE
N.R. D.R.M. LKO. SKETCH NO. 278 - 06

CHECKED BY		Sr. DEN/(IV)					
DRAWN BY		ADEN/SLN-II					
		CORRECTED UPTO	18-02-2020				

BHADOHI STATION
NOT TO SCALE

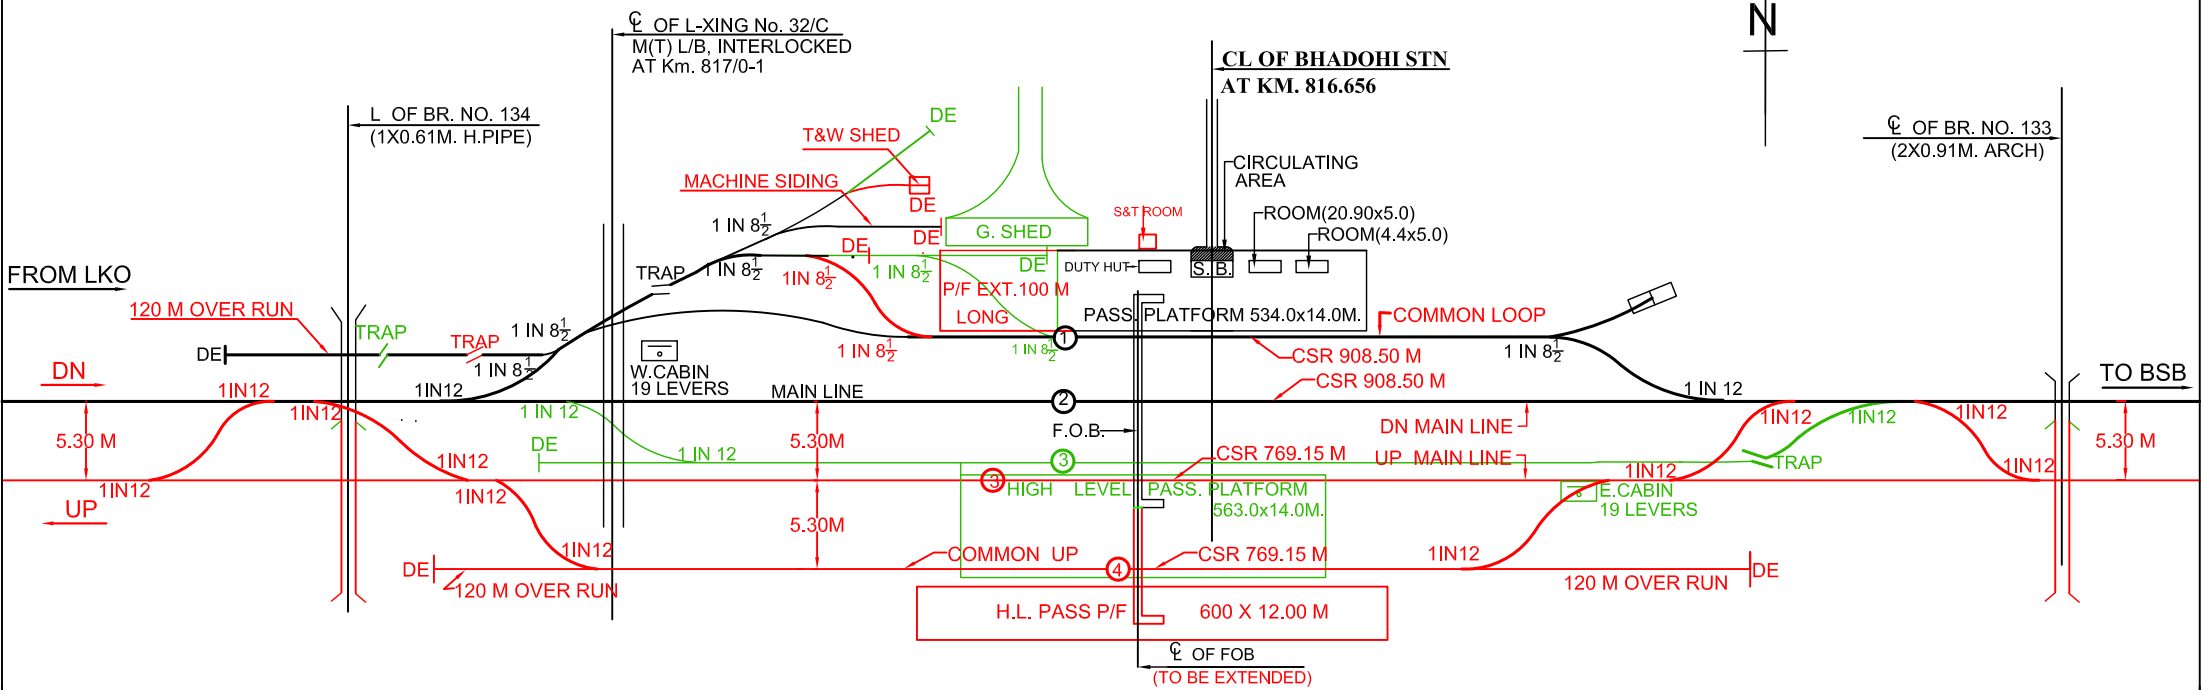

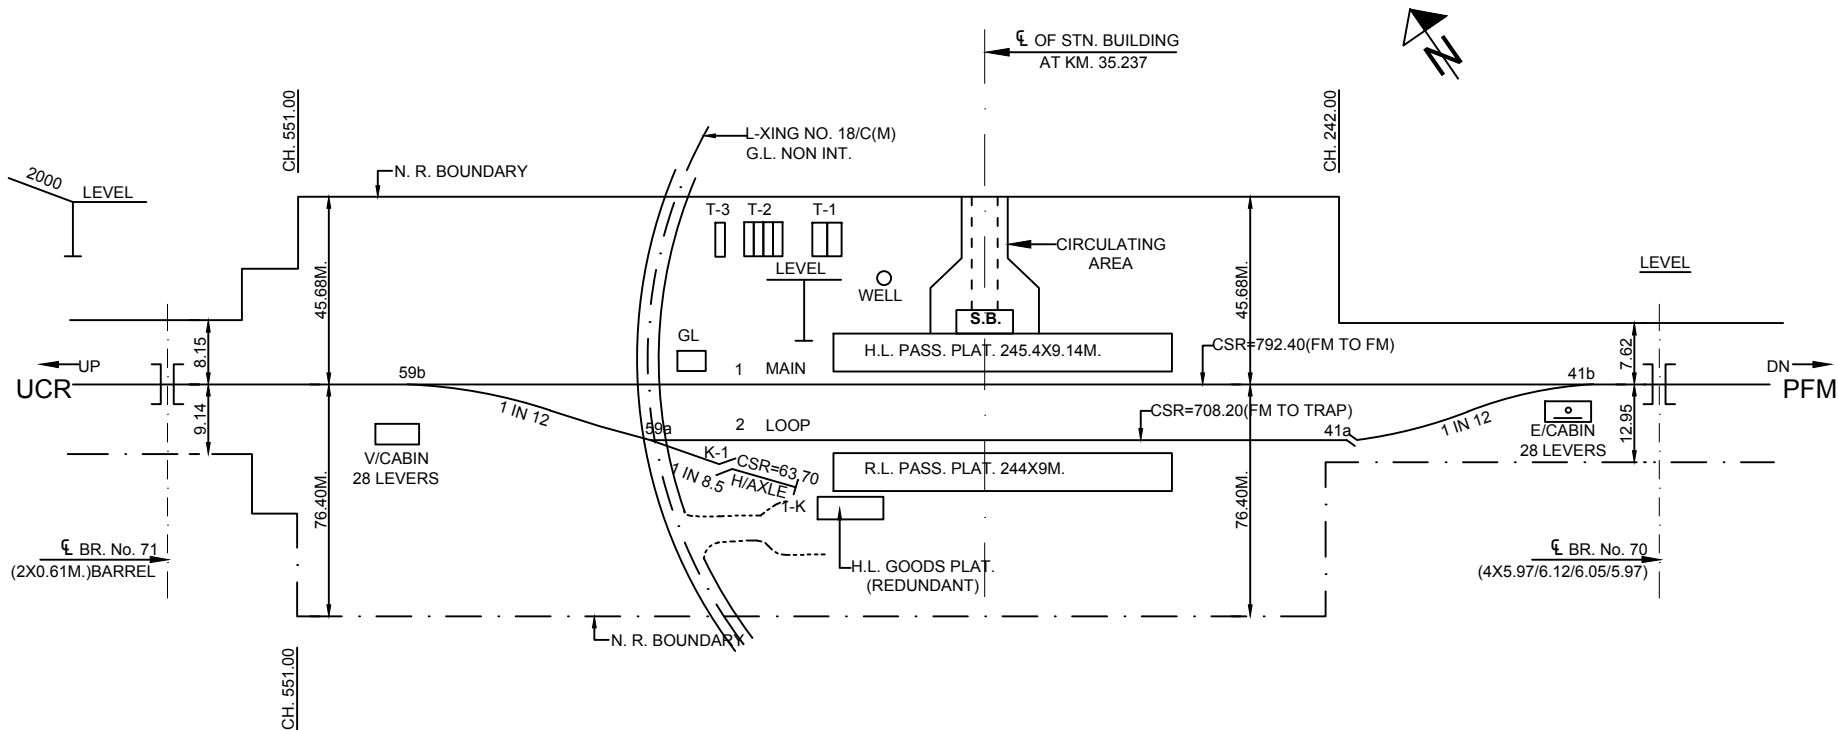

NORTHERN RAILWAY	
LUCKNOW DIVISION	
PFM-UCR-ON SECTION	
DIAGRAM OF	
BHADRI STN. YARD	
R.L./M.S.L.	NOT TO SCALE
N.R. D.R.M. LKO. SKETCH NO. 308-06	

CHECKED BY	
DRAWN BY	

Sr. DEN/(IV)					
ADEN/PRG					
CORRECTED UPTO	18-02-2020				


S. No.	DESCRIPTION	REMARKS	S. No.	DESCRIPTION	AREA (Sq.m.)
1	LA. TUBES	LAV. ☒ URINAL ☒ LADIES ☒ GENTS ☒	1	AREA OF PLATFORM SHELTER	P/F No.1 P/F No.2 NIL NIL
2	NO OF WATER TAPS/HAND PUMPS ON EACH PLATFORM	P/F No. TAPS H.P. - - - - -	2	TOTAL AREA OF PLATFORM PLATFORM NO. 1 PLATFORM NO. 2	16.92
3	SOURCE OF WATER SUPPLY	- - - - -	3	AREA OF WAITING ROOM I - UPPER CLASS WAITING ROOM II - AREA OF WAITING ROOM a - LADIES b - GENTS III - WAITING HALL	NIL NIL NIL 27.51
4	YEAR OF CONSTRUCTION OF STATION BUILDING	- - - - -	4	CIRCULATING AREA	146.64
5	BOOKING OFFICE NO. OF WINDOWS	ADV. RES. -1- CURRENT RES. -1- P/F No.1 P/F No.2			
6	NO. OF SEATS	1 - 5			
7	WHETHER ENQUIRY OFFICE PROVIDED OR NOT	- - - - -			

OF BHANAUR STN. BLDG.
AT KM. 22.101 FROM JNH

Diagram showing the layout of Bhanaur Station Yard. The diagram includes a north arrow, a scale bar, and various labels for the station layout. The layout shows the platform, waiting room, and surrounding boundaries. The diagram is oriented with the railway line running horizontally, with the station building (JNH) on the left and the Bhanaur Station Building on the right. The platform is located between the railway line and the station building. The waiting room is located to the right of the platform. The diagram also shows the location of the Bhanaur Station Building, which is at a distance of 22.101 km from JNH. The diagram includes a scale bar and a north arrow.

ADEN/PBH				FASIBILITY CHECKED		ADEN/PBH	
CHECKED BY	BAKSH			Sr. D.E.N (II)			
DRAWN BY				CORRECTED UPTO	31-3-2010	31-3-11	31-3-12


NORTHERN RAILWAY LUCKNOW DIVISION	
ALD-JNH-JNU SECTION	
DIAGRAM OF BHANAUR STN: YARD	
R.L./M.S.L.	NOT TO SCALE
N.R. D.R.M. LKO. SKETCH NO.	

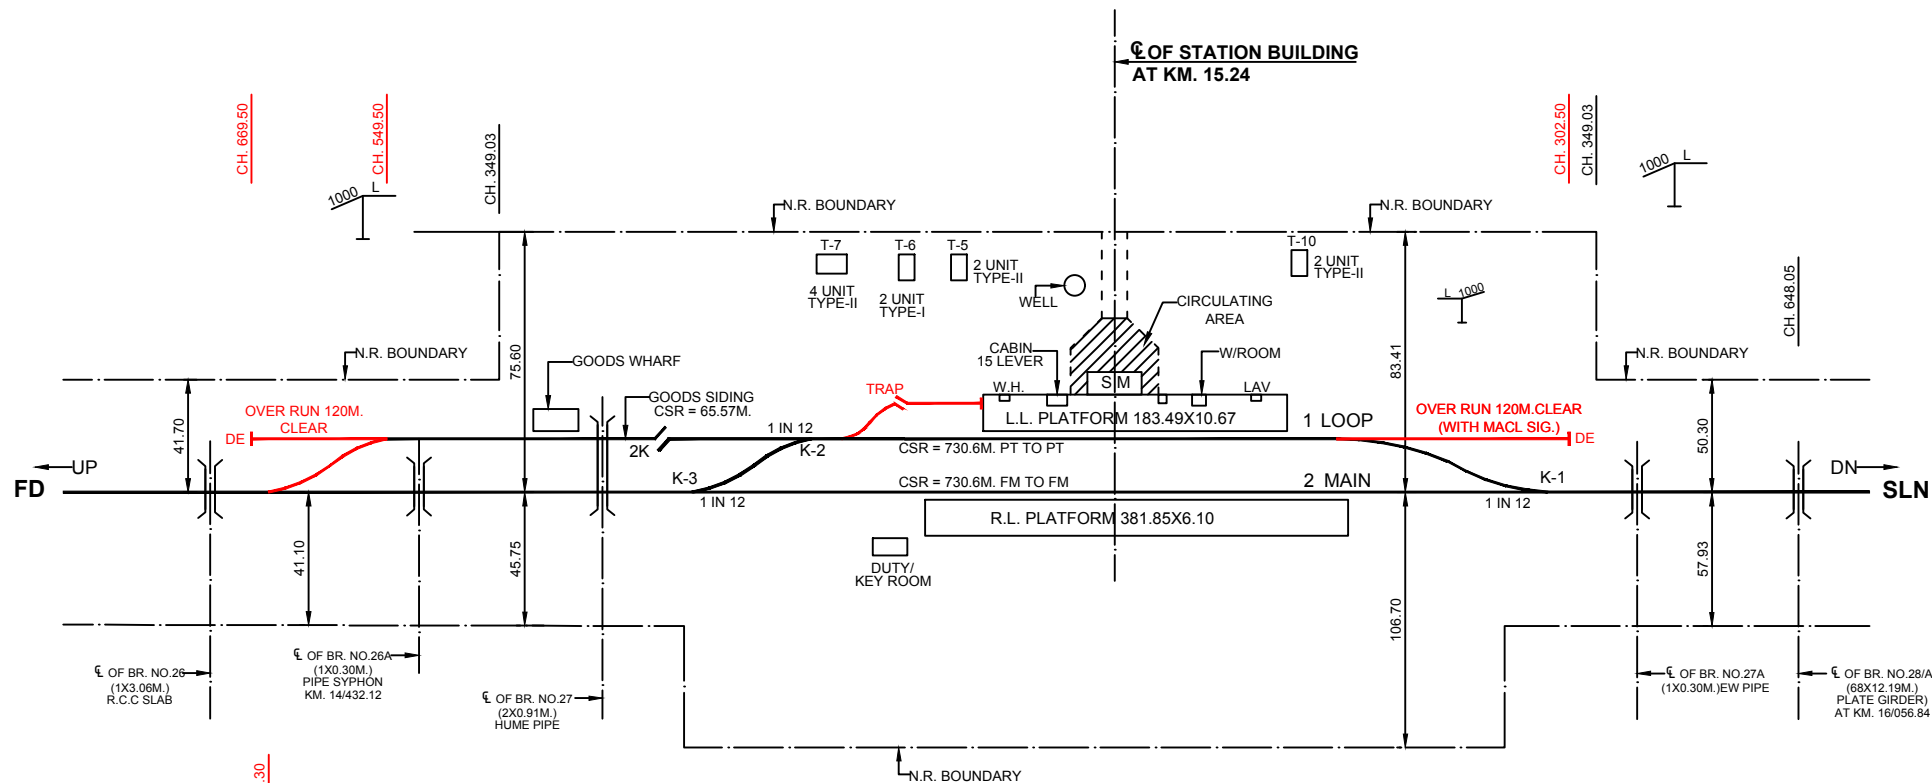

NORTHERN RAILWAY	
LUCKNOW DIVISION	
FD-SLN-ALD SECTION	
DIAGRAM OF	
BHARATKUND STN. YARD	
R.L./M.S.L.	NOT TO SCALE
N.R. D.R.M. LKO. SKETCH NO.	317-06

CHECKED BY	
DRAWN BY	

ADEN/PRG		Sr.DEN/(IV)			
CORRECTED UPTO	18-02-2020				

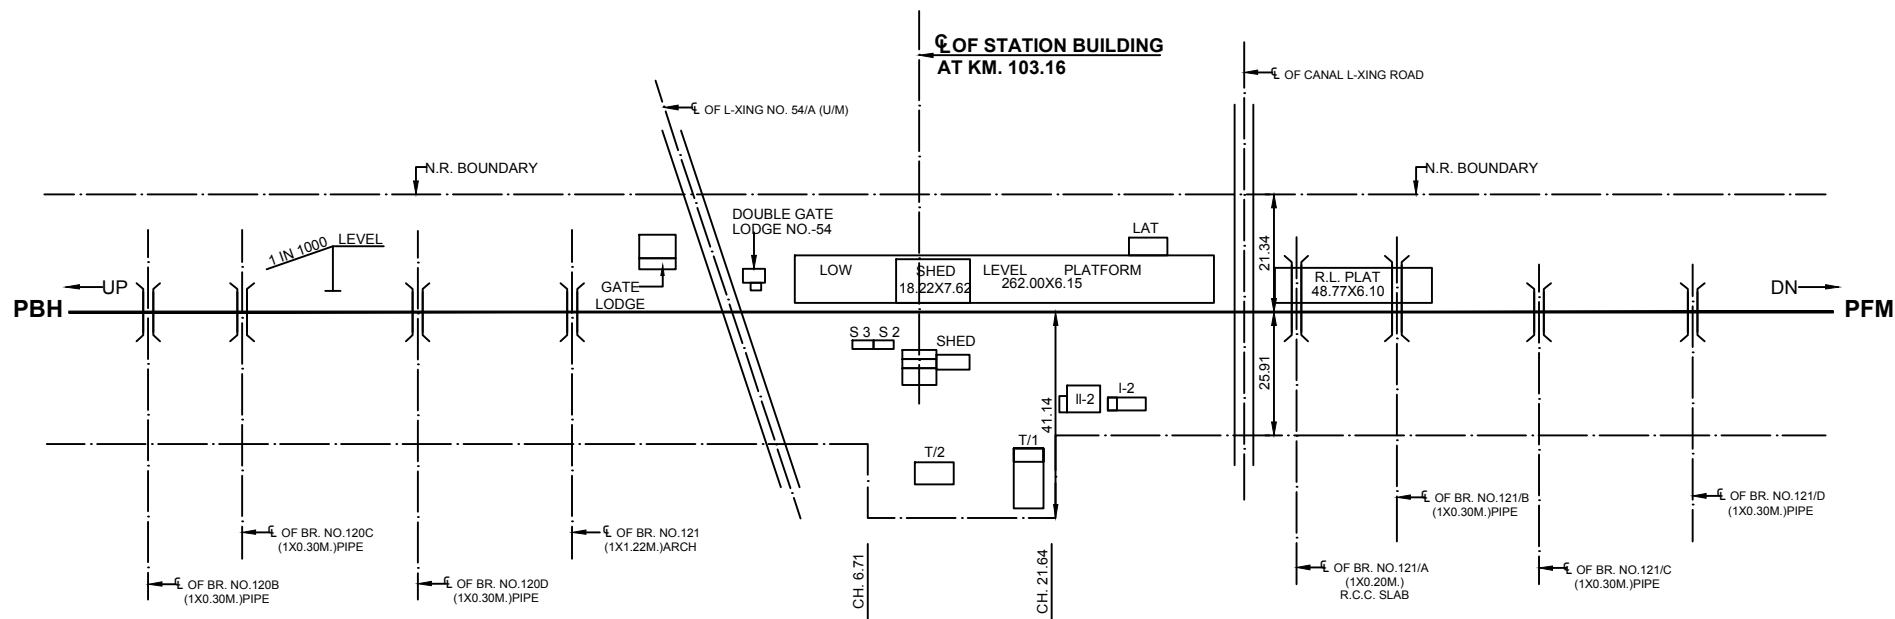

NORTHERN RAILWAY
LUCKNOW DIVISION

FD-SLN-FM SECTION
DIAGRAM OF

BHUPIAMAU STN. YARD

CHECKED BY

DRAWN BY

ADEN/PRG

CORRECTED UPTO

18-02-2020

Sr.DEN/(IV)

R.L./M.S.L.

N.R. D.R.M. LKO. SKETCH NO.

NOT TO SCALE

329-06

S. No.	DESCRIPTION	REMARKS		
		LAV.	URINAL	
1	LAVATORIES	LADIES 2		
		GENTS -		
2	NO OF WATER TAPS/ HAND PUMPS ON EACH PLATFORM	P/F No. 1	TAPS 8	H.P. 2
	SOURCE OF WATER SUPPLY			
3	YEAR OF CONSTRUCTION OF STATION BUILDING			
4	BOOKING OFFICE NO. OF WINDOWS	ADV. RES. -1-	CURRENT RES.	
5	NO. OF SEATS	P/F No.1 40		
6	WHETHER ENQUIRY OFFICE PROVIDED OR NOT			

S. No.	DESCRIPTION	AREA (Sq.m.)
1.	AREA OF PLATFORM SHELTER	146.4
2.	TOTAL AREA OF PLATFORM PLATFORM NO. 1	3603.64
3.	AREA OF WAITING ROOM I- UPPER CLASS WAITING ROOM II - AREA OF WAITING ROOM a- LADIES b- GENTS III- WAITING HALL	116.55
4.	CIRCULATING AREA	1500

ST. DSTE-I

REF.


FENCING	KUTCHA PUCCA	----
ROAD	METALLED	=====
	UNMETALLED	=====

SSE/PSTOMD
2/1/19

11/1/19
01/1/19
1-1-19

4/1/19
4025/RBL

NOTE :- LAND ACQUISITION MAY REQUIRE AT BOTH ENDS.
2-RED INK SHOWING NEW PROPOSED PLAN
3-GREEN INK SHOWING REMOVAL/DISMANTLE OF EXISTING STRUCTURE

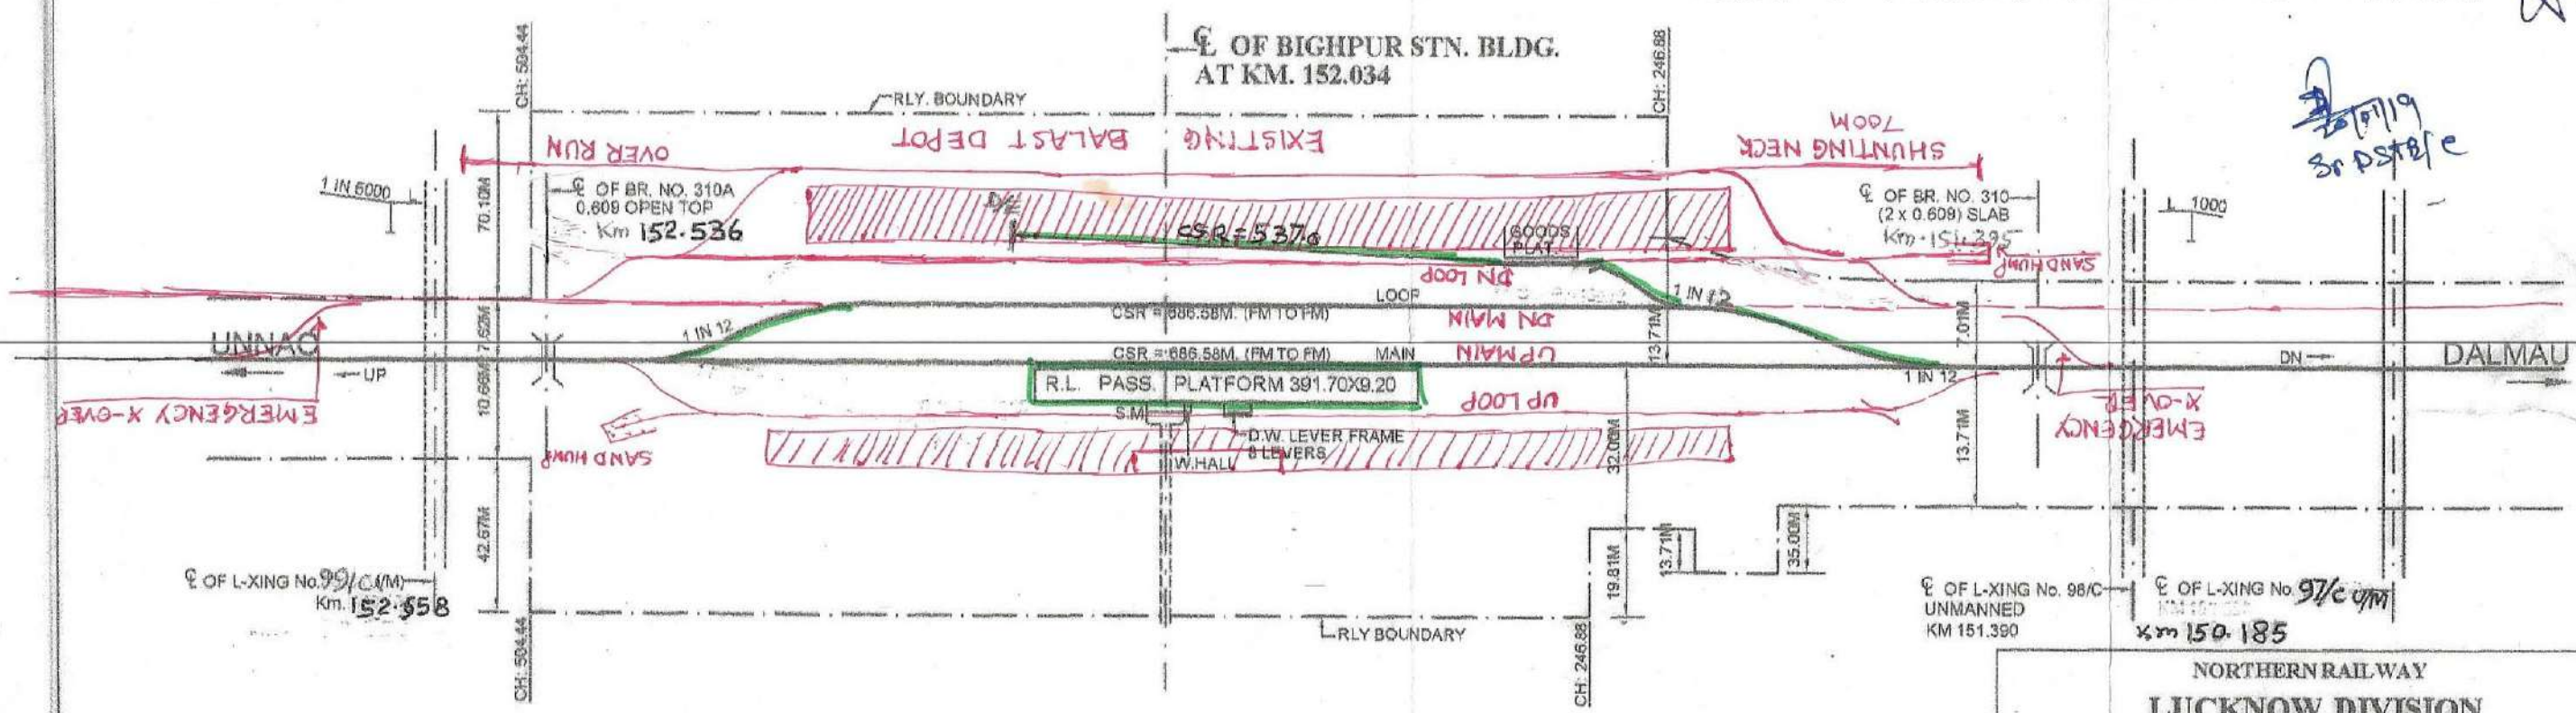


CHECKED BY	S. S. L.
DRAWN BY	DAKSCH

Sr. D.E.N.(II)	2/1/19	31-03-12	31-03-13	31-03-14	31-3-15	31-3-2016	31-03-2018
ADEN/RBL	ADEN/RBL	ADEN/RBL	ADEN/RBL	ADEN/RBL	ADEN/RBL	ADEN/RBL	ADEN/RBL
CORRECTED UPTO	31-03-12	31-03-13	31-03-14	31-3-15	31-3-2016	31-03-2018	

NORTHERN RAILWAY LUCKNOW DIVISION	
PFM-UCR-ON SECTION	
DIAGRAM OF BIGHAPUR STN: YARD	
R.L./M.S.L.	NOT TO SCALE
N.R. DIV L. SKETCH NO.	M-127/LKO/2012

S. No.	DESCRIPTION	REMARKS			S. No.	DESCRIPTION	AREA (Sq.m.)
1	LAVATORIES	LAV.	URINAL		1	AREA OF PLATFORM SHELTER	P/F No.1 161.00 P/F No.2 -
		LADIES	1	-			
		GENTS	1	-			
2	NO OF WATER TAPS/HAND PUMPS ON EACH PLATFORM	P/F No.	TAPS	H.P.	2	TOTAL AREA OF PLATFORM	
		1 & 2	-	3		PLATFORM NO. 1	4210.0
						PLATFORM NO. 2	2947.0
	SOURCE OF WATER SUPPLY	OPEN WELL			3	AREA OF WAITING ROOM	
3	YEAR OF CONSTRUCTION OF STATION BUILDING	-				I- UPPER CLASS WAITING ROOM	NIL
4	BOOKING OFFICE	ADV. RES.	CURRENT RES.			II - AREA OF WAITING ROOM	
	NO. OF WINDOWS	-			a- LADIES	-	
5	NO. OF SEATS	P/F No.1	P/F No.2		b- GENTS	-	
		-			III- WAITING HALL	25	
6	WHETHER ENQUIRY OFFICE PROVIDED OR NOT	NIL			4	CIRCULATING AREA	75.00

REF.	FENCING	KUTCHA PUCCA	----
	ROAD	METALLED UNMETALLED	=====

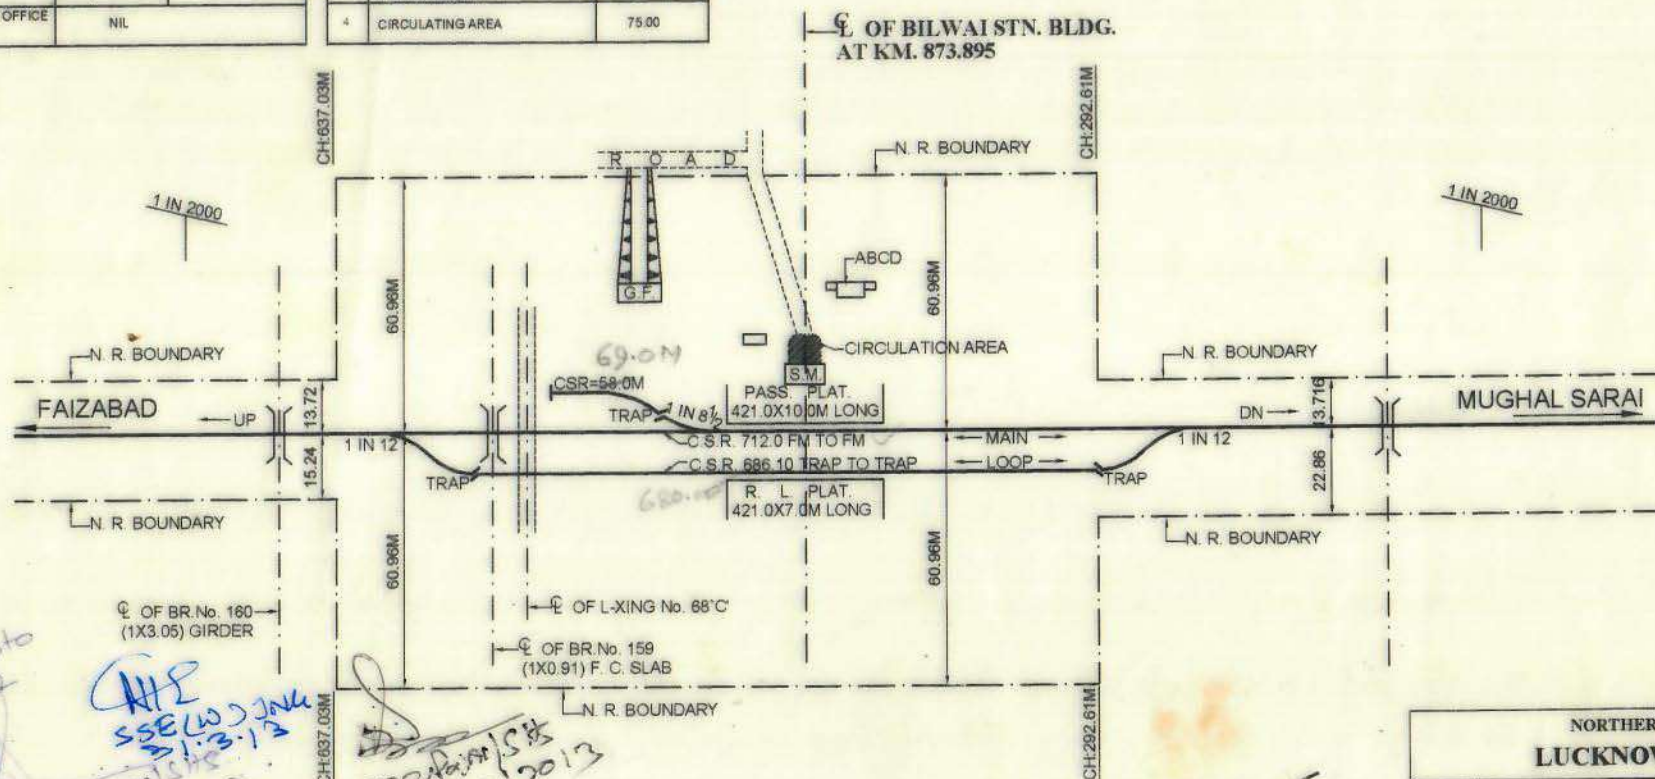

Corrected upto
31/3/2012
SSE WJ JNU
31/3/13
SSE WJ JNU
31/3/13
VS
31-3-13
JE WJ JNU

CHECKED BY	DAKSH
DRAWN BY	DAKSH

Sr. D.E.N.(III)							
ADEN/JNU	31-3-12	31-3-13	31-3-14	31-3-15	31-3-16	31-03-2018	
CORRECTED UPTO	31-03-12	31-3-13	31-3-14	31-3-15	31-3-16	31-03-2018	

NORTHERN RAILWAY LUCKNOW DIVISION LKO-FD-BSB SECTION DIAGRAM OF BILWAI STN: YARD		
R.L./M.S.L.	79.78M	NOT TO SCALE
N.R. DIVL. SKETCH NO: M-202/LKO/2012		

S. No.	DESCRIPTION	REMARKS		
1	LAVATORIES	LAV.		URINAL
		LADIES	1	-
		GENTS	1	
2	NO OF WATER TAPS/HAND PUMPS ON EACH PLATFORM	P/F No.	TAPS	H.P.
		1	-	1
		2		NIL
	SOURCE OF WATER SUPPLY	OPEN WELL-1		
3	YEAR OF CONSTRUCTION OF STATION BUILDING	1991		
4	BOOKING OFFICE NO. OF WINDOWS	ADV RES	CURRENT RES	
		1		
5	NO. OF SEATS	P/F No.1	P/F No.2	
		16	8	
6	WHETHER ENQUIRY OFFICE PROVIDED OR NOT			

S. No.	DESCRIPTION	AREA (Sq.m.)
1	AREA OF PLATFORM SHELTER	P/F No.1 P/F No.2 NIL NIL
2	TOTAL AREA OF PLATFORM	2700.00
	PLATFORM NO. 1	2700.00
	PLATFORM NO. 2	2700.00
3	AREA OF WAITING ROOM	
	I-UPPER CLASS WAITING ROOM	NIL
	II-AREA OF WAITING ROOM	
	a-LADIES	NIL
	b-GENTS	NIL
	III-WAITING HALL	20.00
4	CIRCULATING AREA	


REF.	FENCING	KUTCHA	-----
		PUCCA	-----
	ROAD	METALLED	=====
		UNMETALLED	=====

CORRECTED UP TO 31-03-2018

ADEN/BSB

SR.DEN-III

CL OF BIRAPATTI STN. BLDG.
AT KM. 784.433

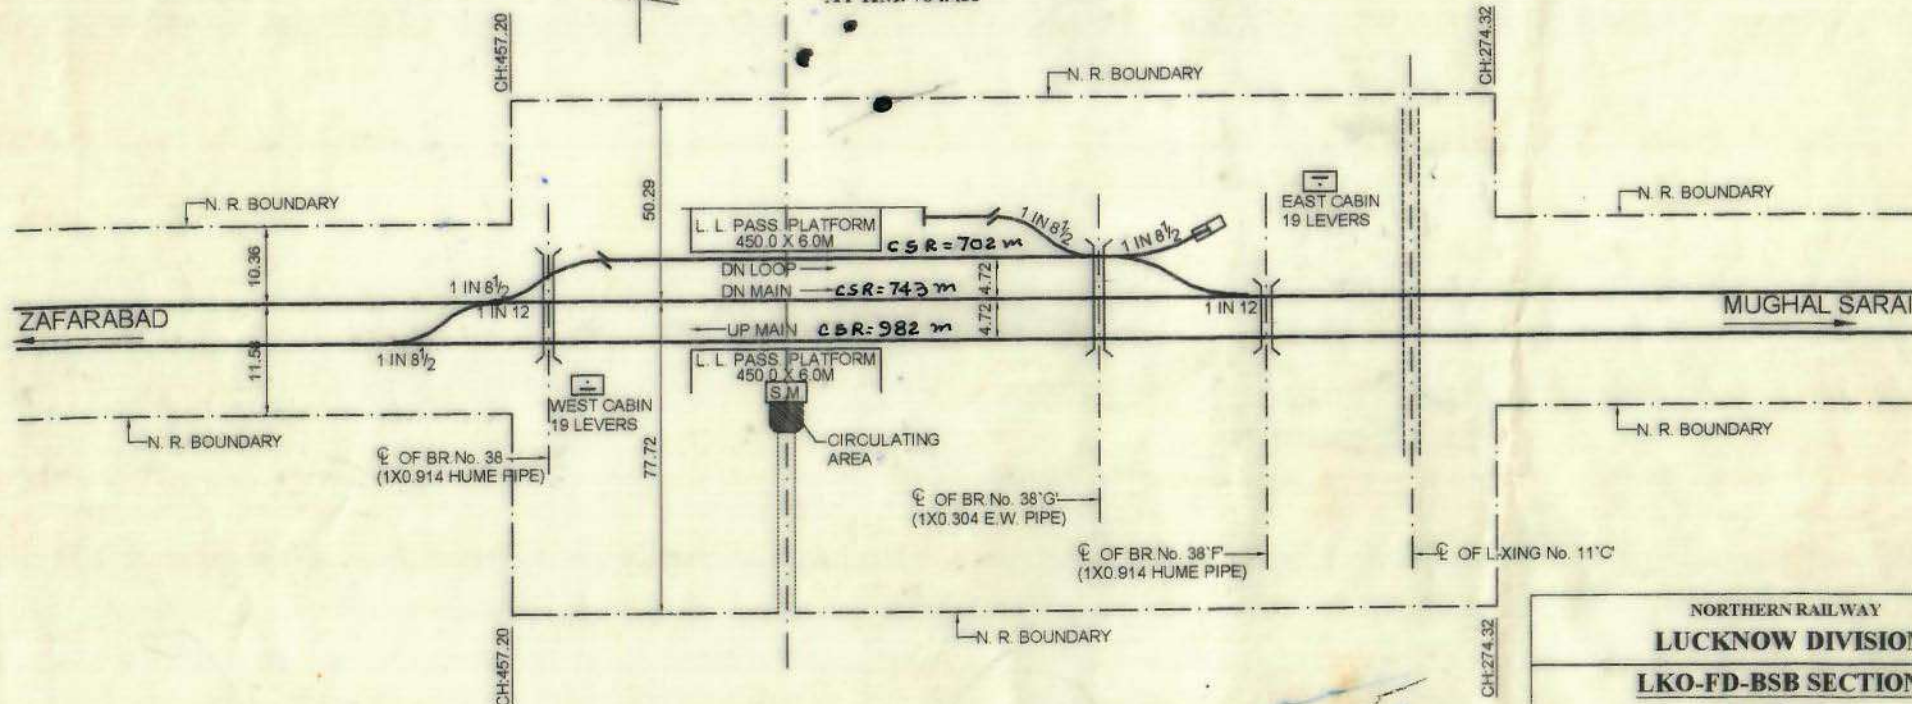

D.E.N.(III)						
ADEN/BSB						
CORRECTED UPTO	31-03-12	31-8-2013	31-3-2014	31-2-15	31-8-16	


NORTHERN RAILWAY	
LUCKNOW DIVISION	
LKO-FD-BSB SECTION	
DIAGRAM OF	
BIRAPATTI STN: YARD	
R.L./M.S.L.	NOT TO SCALE
N.R. DIVL. SKETCH NO: M-188-LKO/2012	

CHECKED BY	DAKSH
DRAWN BY	201, SHELFLOOR, LUCKNOW DIVISION, UTTAR PRADESH, INDIA

S. No.	DESCRIPTION	REMARKS		
1	LAVATORIES	LAV	URINAL	
		LADIES		
		GENTS		
2	NO OF WATER TAPS/HAND PUMPS ON EACH PLATFORM	P/F No	TAPS	H P
		1		1
	SOURCE OF WATER SUPPLY			
3	YEAR OF CONSTRUCTION OF STATION BUILDING			
4	BOOKING OFFICE NO. OF WINDOWS	ADV RES	CURRENT RES	
		-1-		
5	NO. OF SEATS	P/F No 1		
		12		
6	WHETHER ENQUIRY OFFICE PROVIDED OR NOT			


S. No.	DESCRIPTION	AREA (Sq.m.)
1	AREA OF PLATFORM SHELTER	12
2	TOTAL AREA OF PLATFORM PLATFORM NO 1	554.00
3	AREA OF WAITING ROOM I- UPPER CLASS WAITING ROOM II - AREA OF WAITING ROOM a- LADIES b- GENTS III- WAITING HALL	
4	CIRCULATING AREA	10600

REF.	FENCING	KUTCHA PUCCA	-----
	ROAD	METALLED UNMETALLED	=====

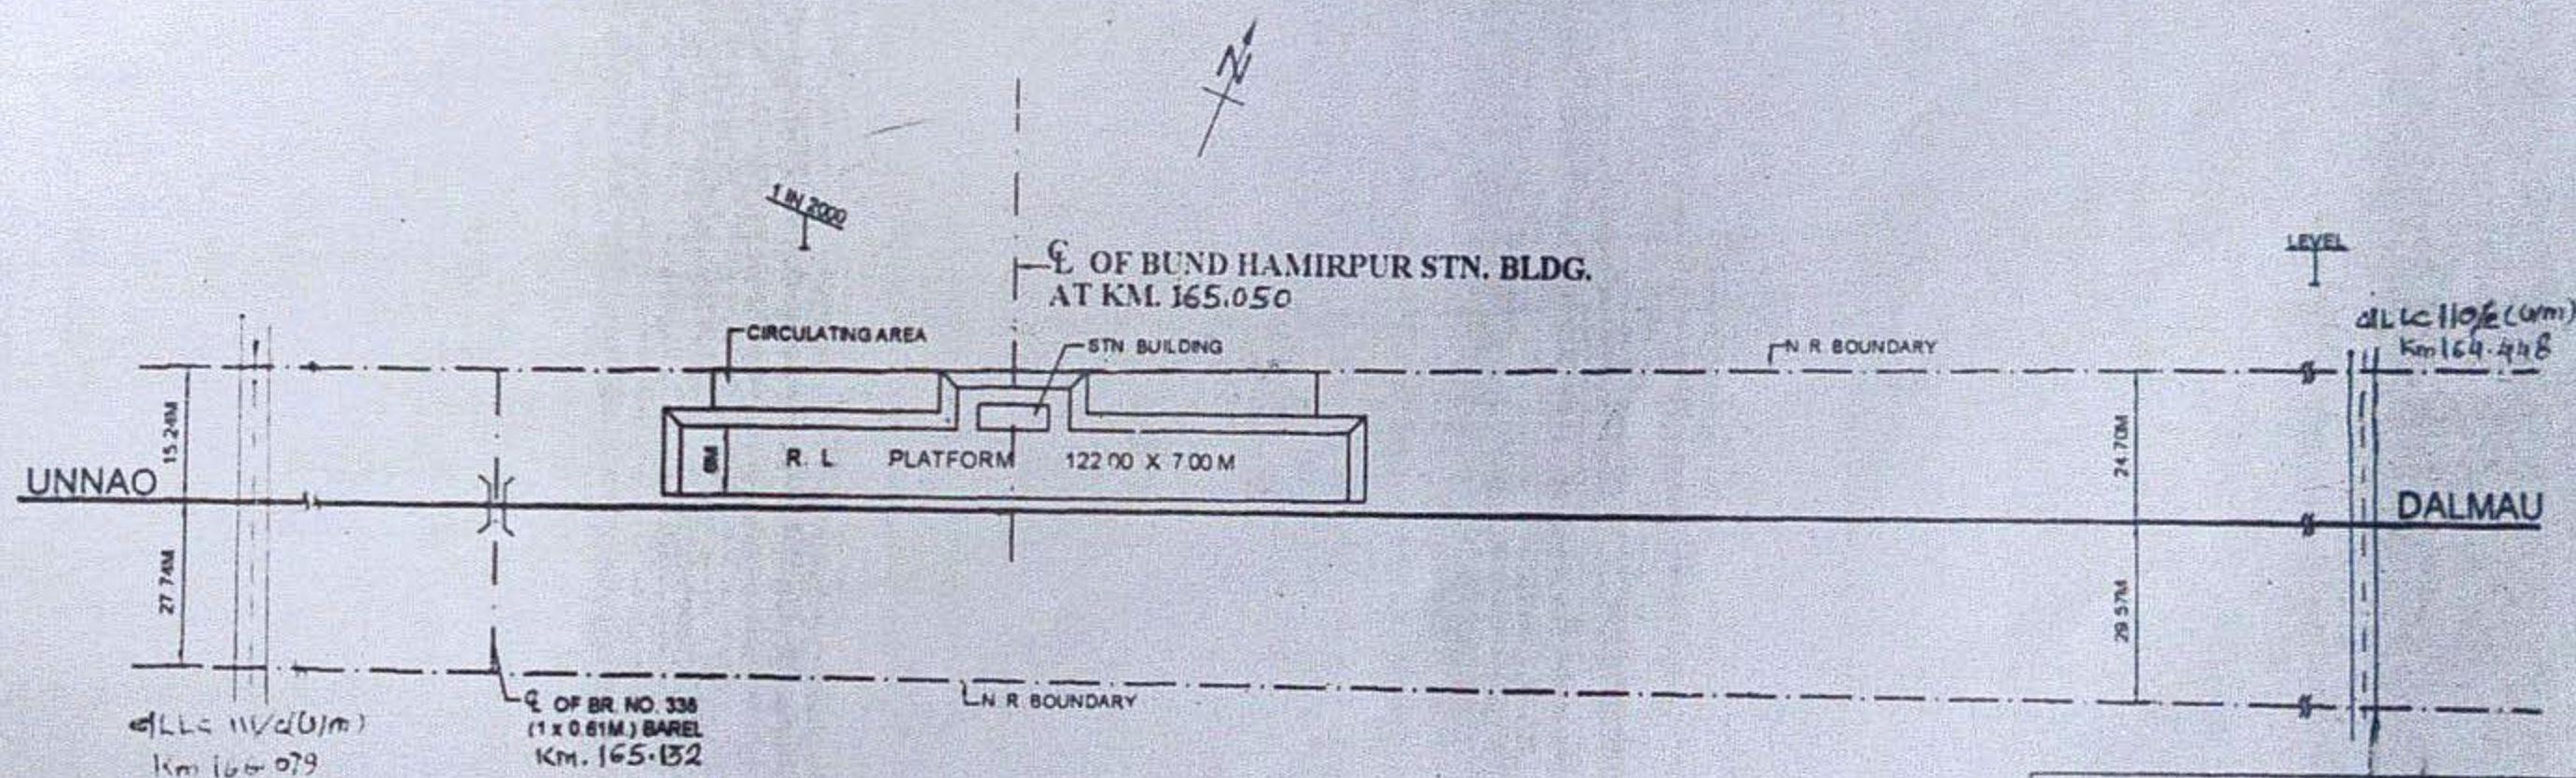

NORTHERN RAILWAY	
LUCKNOW DIVISION	
PFM-UCR-ON SECTION	
DIAGRAM OF	
BUND HAMIRPUR STN: YARD	
R.L. M.S.L.	NOT TO SCALE
N.R. DIV L. SKETCH NO.	M-115/LKO/2012

CHECKED BY	S. S. K.
DRAWN BY	DAKSH
Sr DEN (M)	
ADEN/RBL	
CORRECTED UPTO	31-03-12

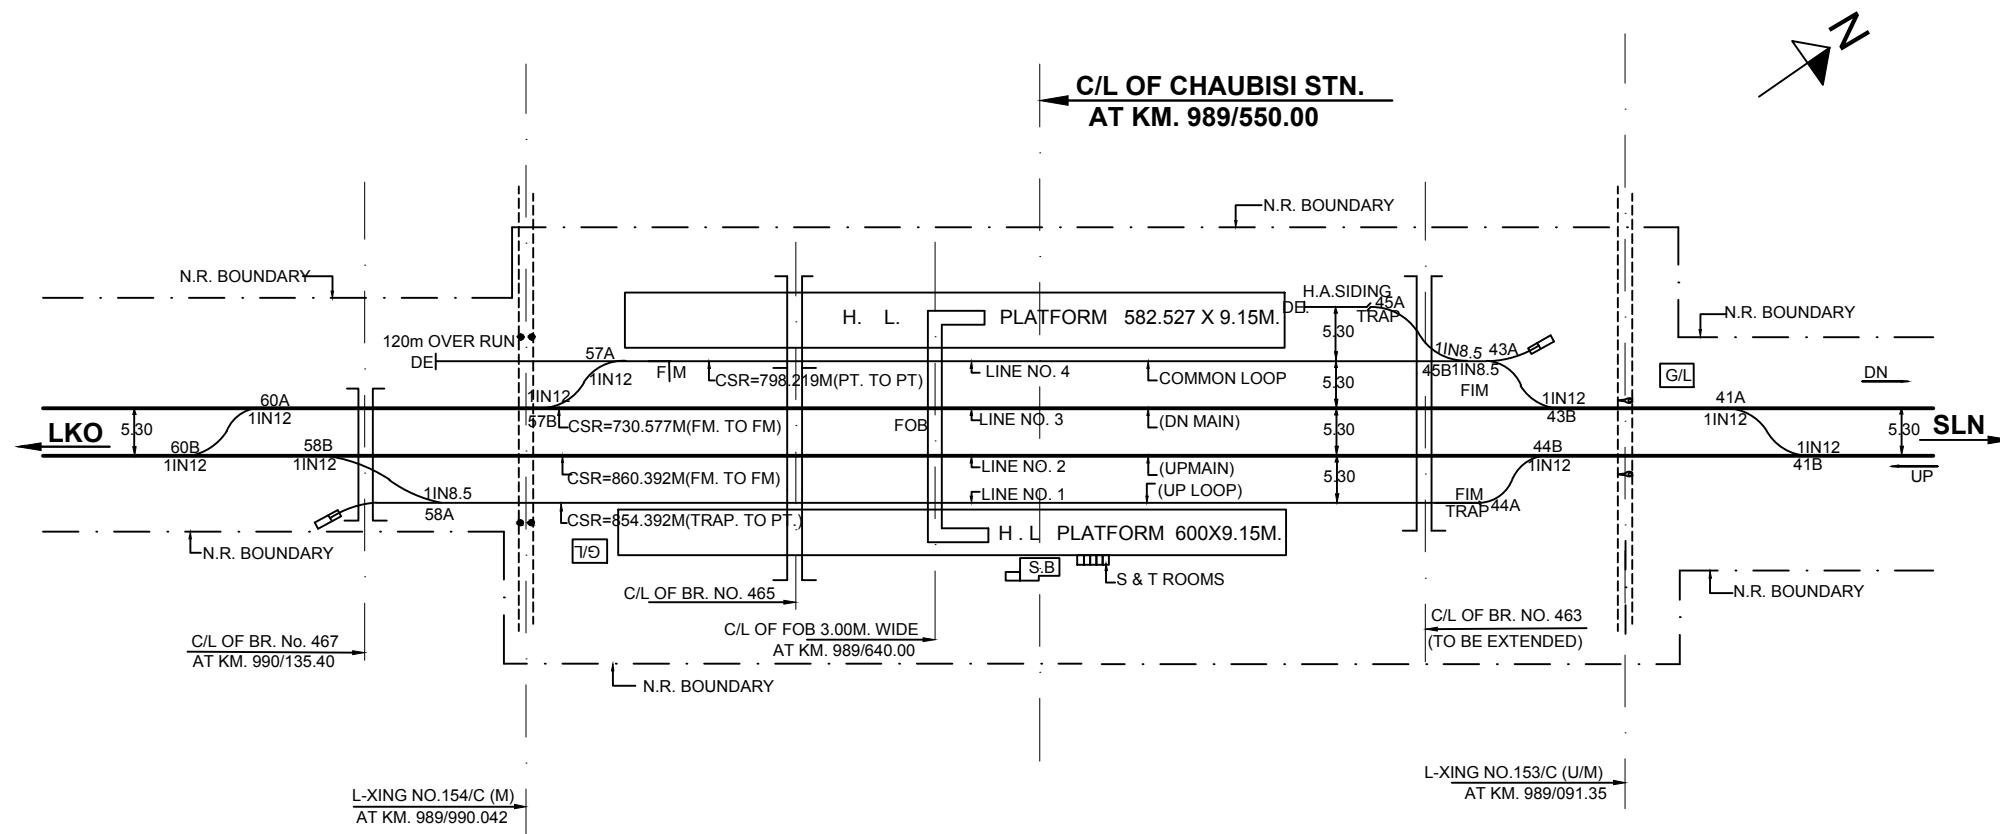

NORTHERN RAILWAY
LUCKNOW DIVISION

LKO -SLN-ZBD SECTION
DIAGRAM OF
CHAUBISI STN. YARD

R.L./M.S.L. 111.960m

NOT TO SCALE

N.R. D.R.M. LKO. SKETCH NO. 280 - 06

CHECKED BY

DRAWN BY


Sr. DEN/(IV)



ADEN/SLN-I

CORRECTED UPTO

18-02-2020

CHAUKHANDI STATION.
NOT TO SCALE

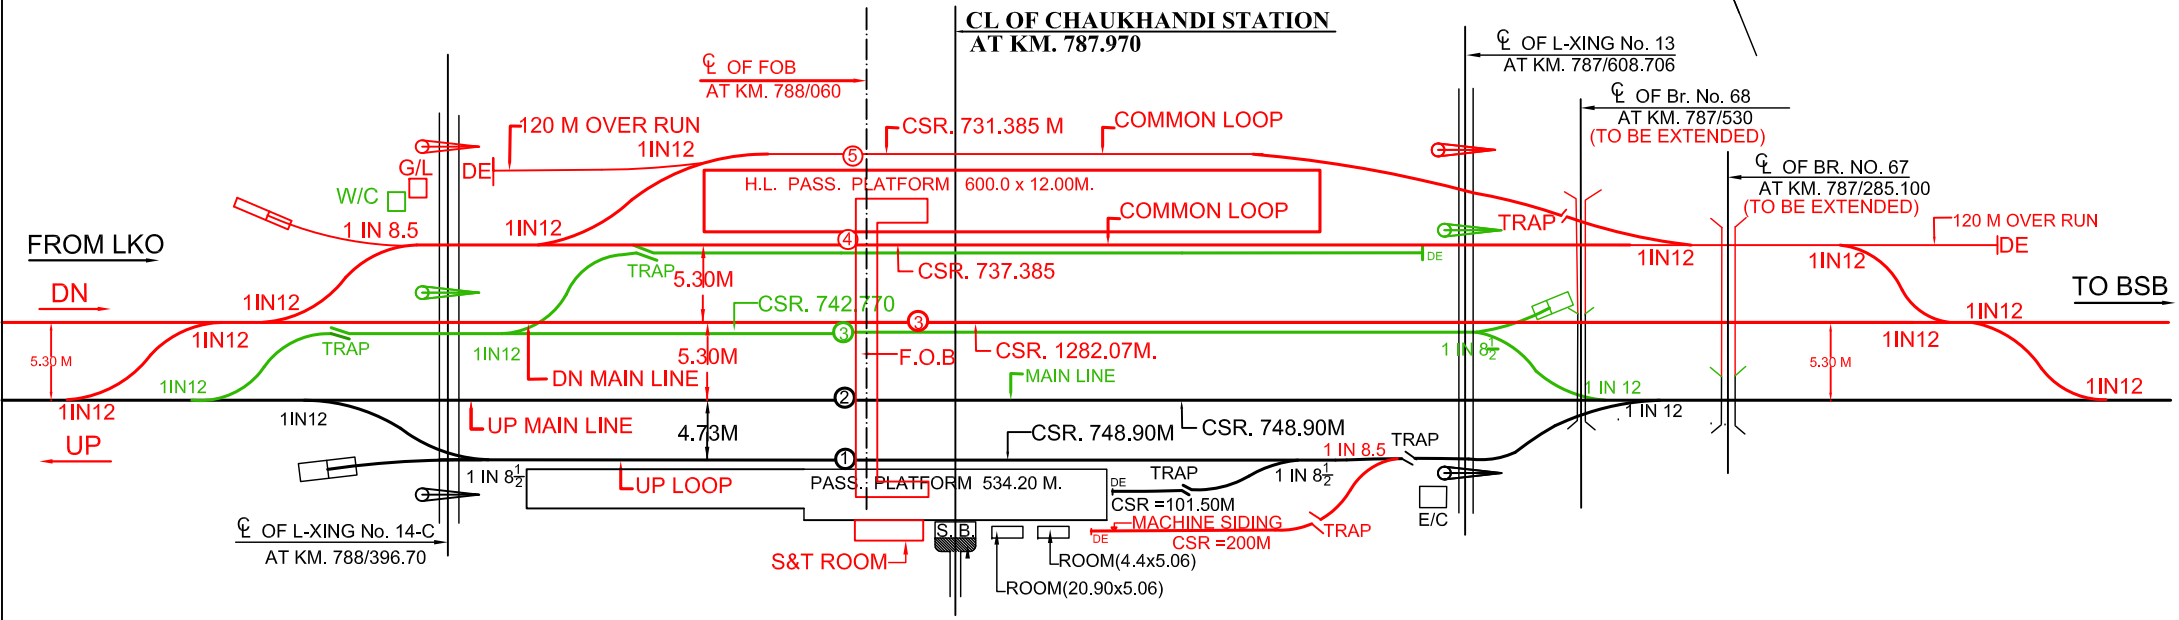


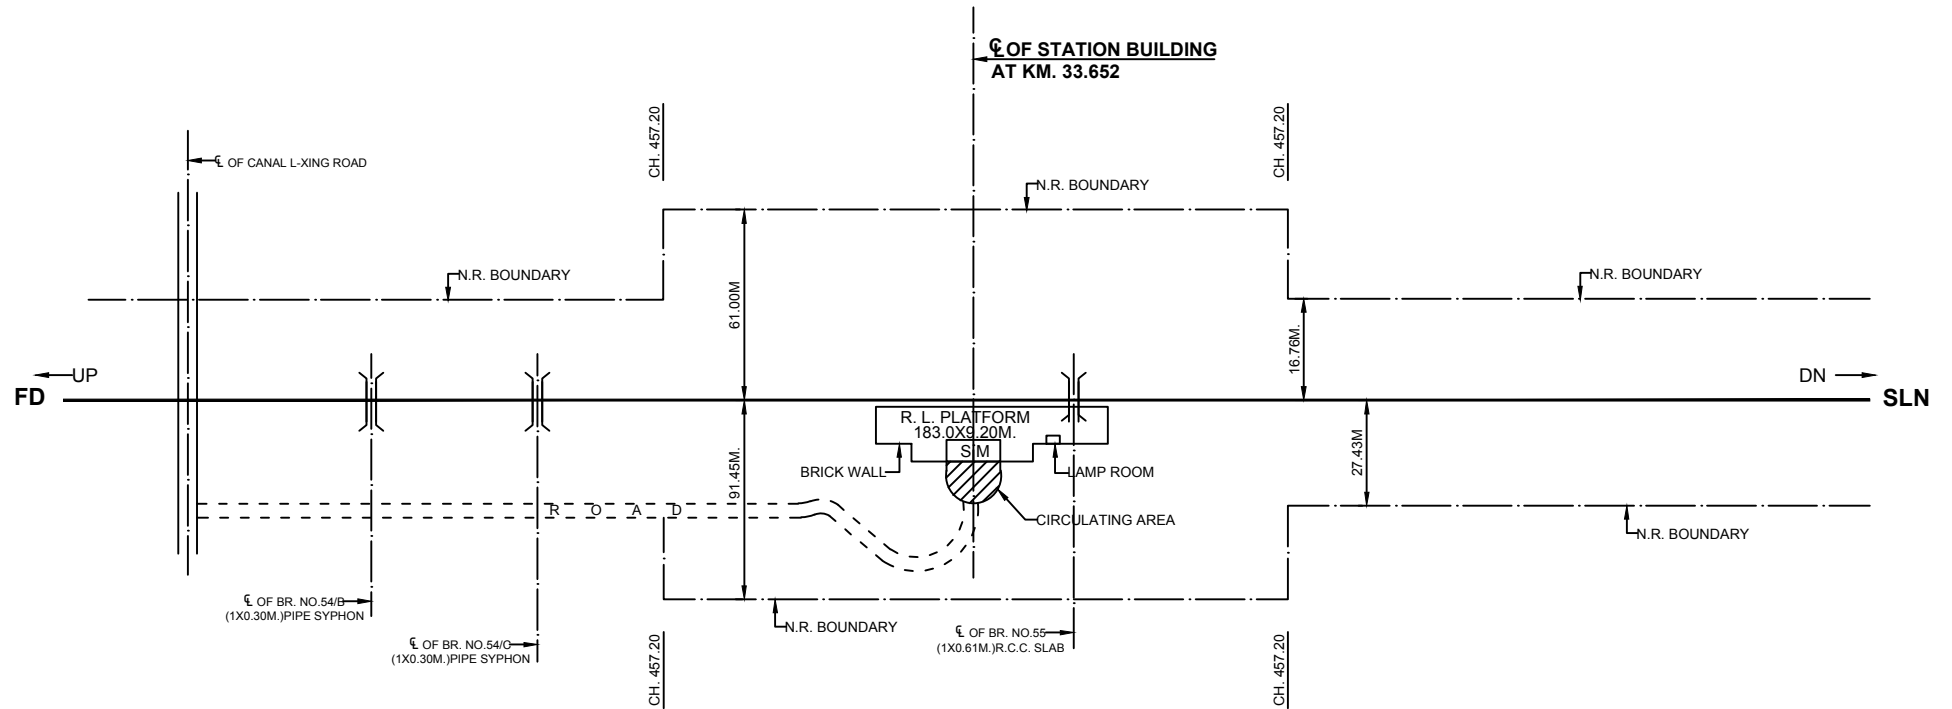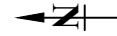

NORTHERN RAILWAY	
LUCKNOW DIVISION	
FD-SLN-ALD SECTION	
DIAGRAM OF	
CHAUREBAZAR STN. YARD	
R.L./M.S.L.	NOT TO SCALE
N.R. D.R.M. LKO. SKETCH NO.	320-06

CHECKED BY	
DRAWN BY	

ADEN/PRG		Sr.DEN/(IV)			
CORRECTED UPTO	18-02-2020				

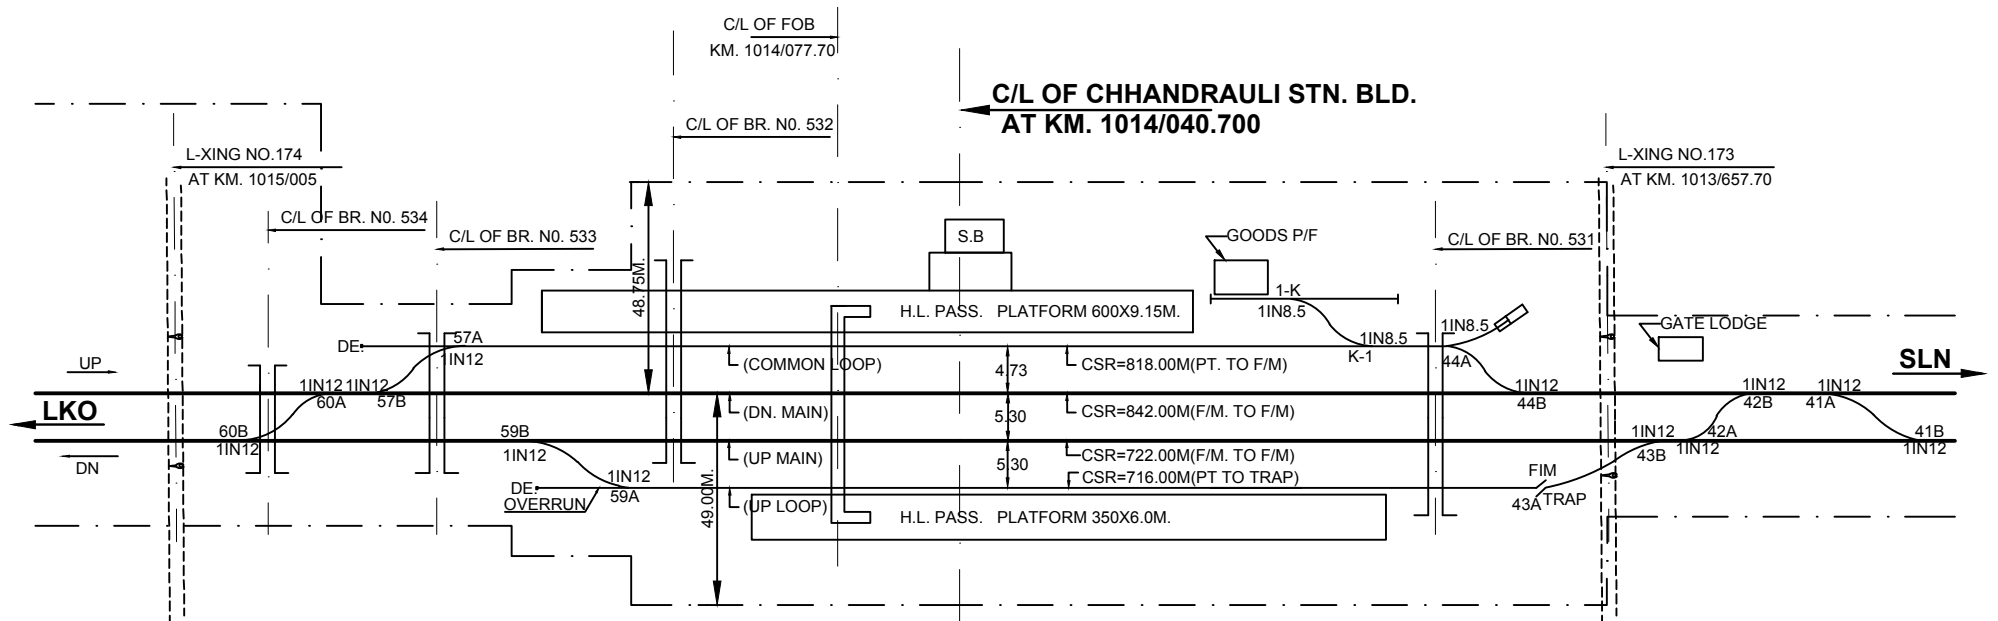


NORTHERN RAILWAY
LUCKNOW DIVISION
LKO -SLN-ZBD SECTION
DIAGRAM OF
CHHANDRAULI STN. YARD

CHECKED BY	
DRAWN BY	

Sr. DEN/(IV)					
ADEN/SLN-I					
CORRECTED UPTO	18-02-2020				

R.L./M.S.L. 107.665m	NOT TO SCALE
N.R. D.R.M. LKO. SKETCH NO.	278 - 06

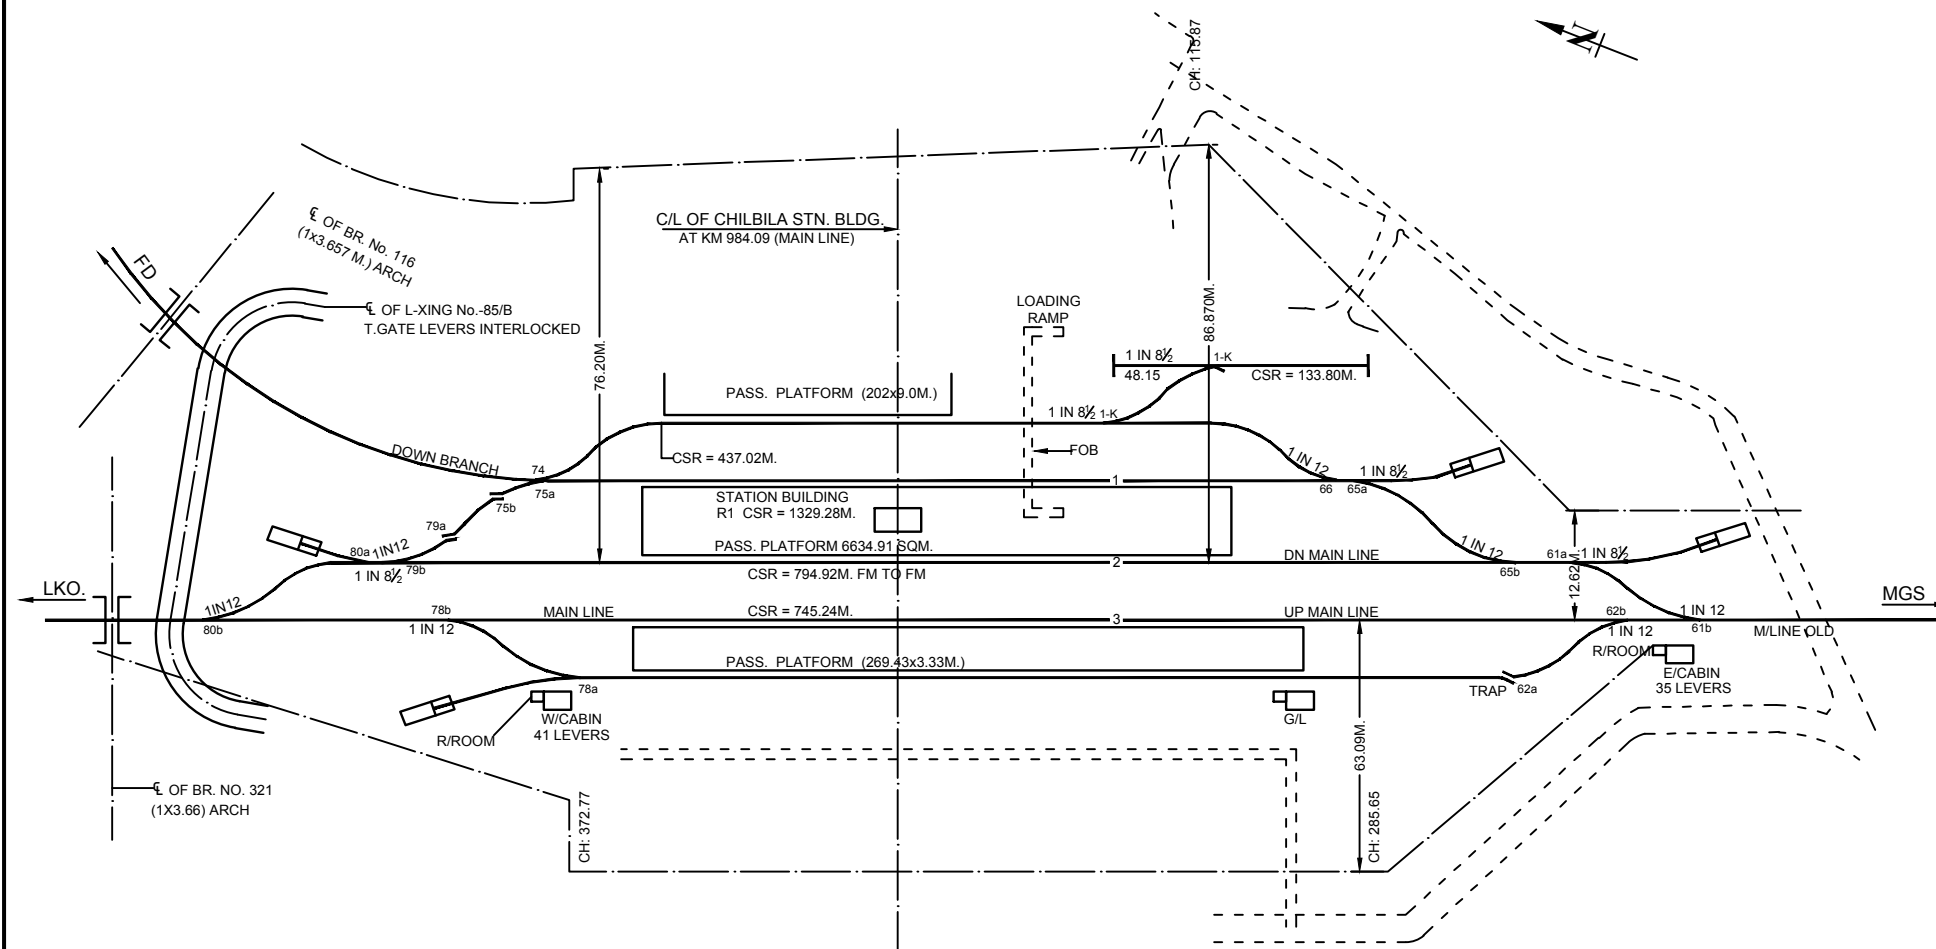

NORTHERN RAILWAY	
LUCKNOW DIVISION	
FD-SLN-FM SECTION	
DIAGRAM OF	
CHILBILA STN. YARD	
R.L./M.S.L.	NOT TO SCALE
N.R. D.R.M. LKO. SKETCH NO.	

CHECKED BY	
DRAWN BY	

ADEN/PRG		Sr.DEN/(IV)			
CORRECTED UPTO	18-02-2020				

S. No.	DESCRIPTION	REMARKS
1	LAVATORIES	LAV.
		URINAL
		LADIES
2	NO. OF WATER TAPS/HAND PUMPS ON EACH PLATFORM	H.P.
		TAPS
		P/F No.
3	YEAR OF CONSTRUCTION OF STATION BUILDING	ADV. RES.
		CURRENT RES.
		P/F No.1
4	BOOKING OFFICE NO. OF WINDOWS	P/F No.2
5	NO. OF SEATS	
6	WHETHER ENQUIRY OFFICE PROVIDED OR NOT	

S. No.	DESCRIPTION	AREA (Sq.m.)
1.	AREA OF PLATFORM SHELTER	233
2.	TOTAL AREA OF PLATFORM	3700
	PLATFORM NO. 1	2160
	PLATFORM NO. 2	
3.	AREA OF WAITING ROOM	
	I- UPPER CLASS WAITING ROOM	
	II- AREA OF WAITING ROOM	
	a- LADIES	27.36
	b- GENTS	
	III- WAITING HALL	49.2
4.	CIRCULATING AREA	3240

REF.	FENCING	ROAD
	KUTCHA PUCCA	METALLED UNMETALLED


CORRECTED UPTO 31-3-16

ADEN/RBL

SRDEN-II

Ref: Red ink shows dismantling of existing structure.
Green ink show new proposed work

Q. OF DALMAU STN. BLDG.
AT KM. 103.686

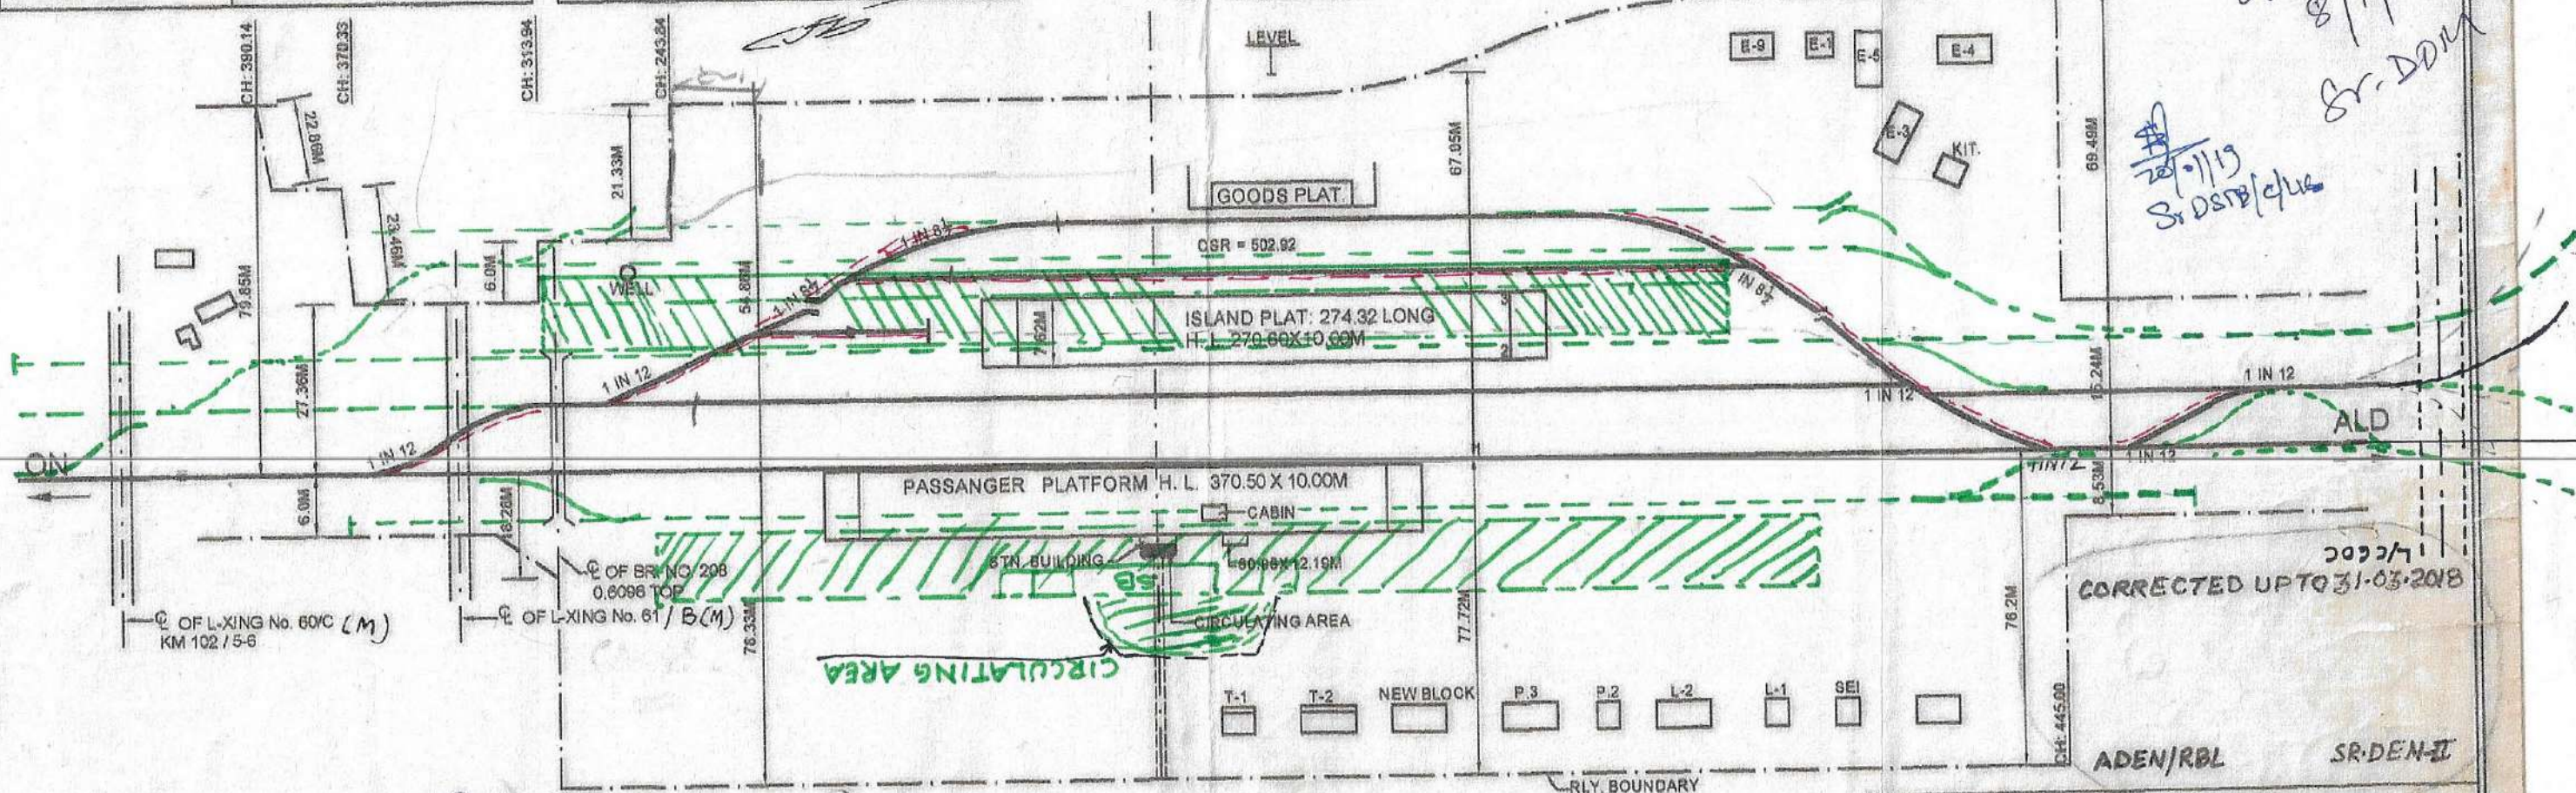

ADEN/RBL SYDEN-II
N.R./L.V.
CORRECTED UPTO
2015

निमित्त संकलन इ-बानियर
Senior Section Engineer (P. Way)
प. र. इकाई/म. रिव. डालमा

ADEN-RBL

ADEN/RBL

NORTHERN RAILWAY
LUCKNOW DIVISION

PFM-UCR-ON SECTION

DIAGRAM OF
DALMAU STN: YARD

R.L./M.S.L. NOT TO SCALE
N.R. D.R.M. LKO. SKETCH NO.

CHECKED BY
DRAWN BY

CORRECTED UPTO
2014
SRDEN-II

Sr. D.E.N.(II)					
CORRECTED UPTO	31-03-2010	31-3-2011	31-3-12	31-03-13	

SSB/ML/SP
ADEN/RBL

ADEN/RBL

SSB/ML/ARC
K.P.2
Mach-12

SSB/PWAY/DMW
29/11/14


41

DANDUPUR STATION YARD



LEGEND:-

EXISTING WORK	—
PROPOSED WORK	—
DISMANTLED WORK	—
FUTURE WORK	—

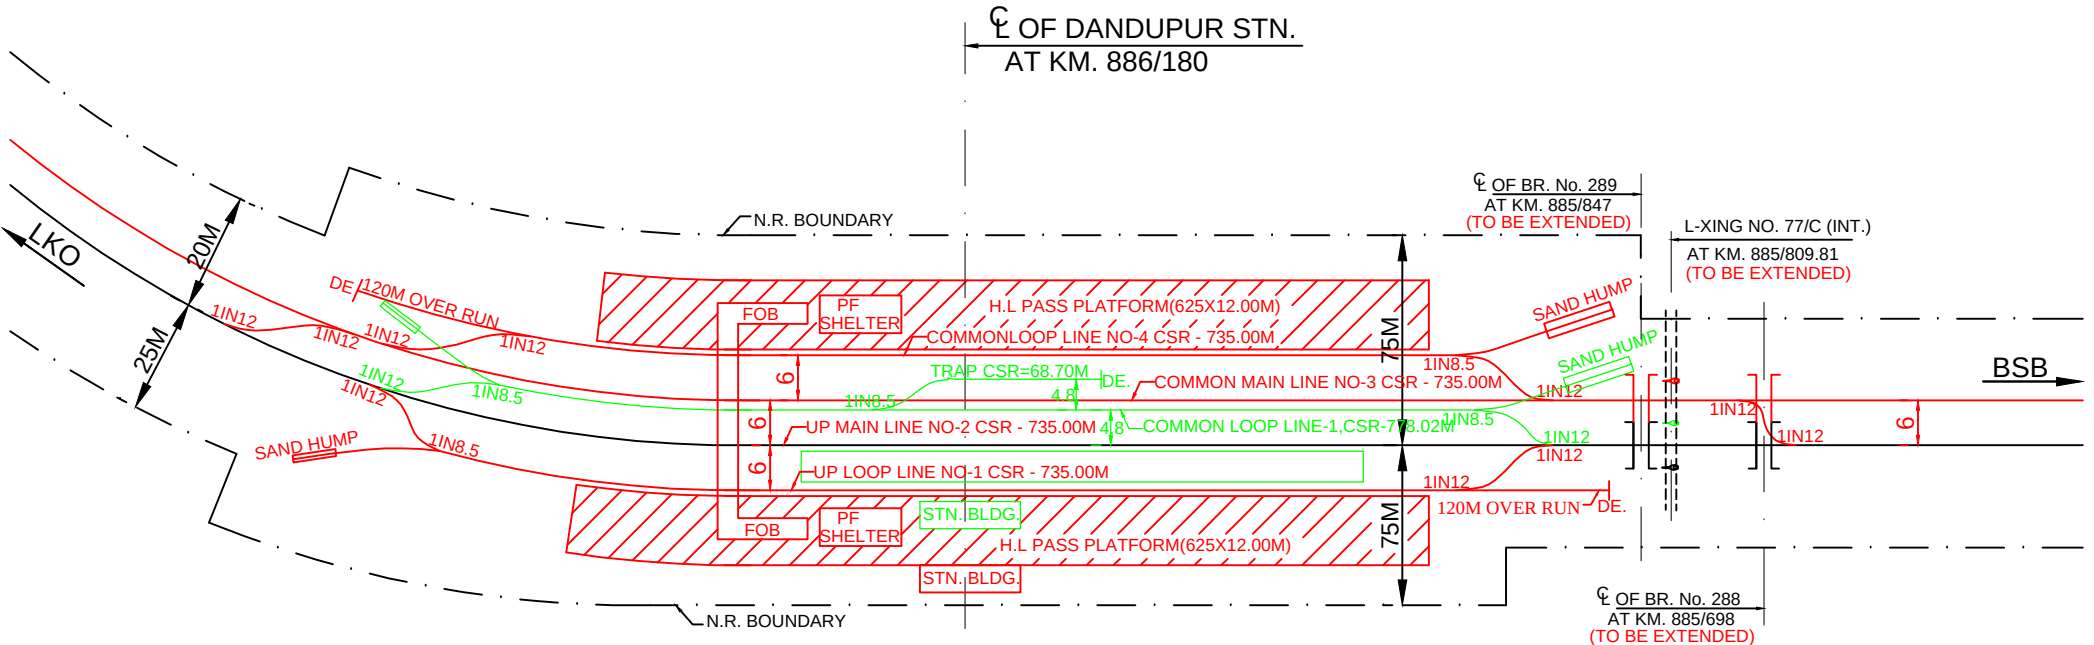

P.way work:

Sr.NO.	Name of Item	To be Dismantled	To be laid
1.	1 in 12 T/out	02	10
2.	1 in 8.5 T/out	03	02
3.	Trap	01	00
4.	Double Dimond	00	00
5.	Dead End	01	02
6.	Sand Hump	02	02
7.	Track (in KM) (Except Main line)	1.00	2.00

Facility to be provided:

Sr.NO.	Facility
1.	New H.L. End PF no.1 (625mX12.00)
2.	New H.L. End PF no.2 (625mX12.00)
3.	New F.O.B 3m wide (To cover PF 1 to PF 2)
4.	One new line as line no. 1 with CSR 735.0m
5.	One new line as line no. 4 with CSR 735.0m

Detail of traffic movement:

Sr.NO.	Movement	To Line no.
1.	From Lucknow	3 & 4
2.	From Varanasi	1 to 4

NORTHERN RAILWAY
LUCKNOW DIVISION
DANDUPUR STATION YARD
AMETHI-JANGHAI DOUBLING (87 KM)

5. WHETHER. ENQUIRY. OFFICE PROVIDED OR - NOT.
NOT.

1


S.No	DESCRIPTION.	SQ.M.
1.	AREA OF PLATFORM SHELTERS.	
	I. ON PLATFORM. No 1	24.00
	II. ON " " No 2	-
2.	TOTAL AREA OF PLATFORM.	
	I. PLATFORM. No 1	2688.50
	II. PLATFORM. No 2.	3150.00
3.	AREA OF WAITING ROOM.	
	I. UPPER CLASS (LADIES)	-
	(GENTS)	-
	II WAITING HALL	49.00
4.	CIRCULATING AREA.	-


FENCING { KUTCHA _____
PUCCA _____

ROAD { METALLED =====
UNMETALLED =====

CORRECTED UP TO 31.3.2000

DSE(T)/N.R.-LKO.

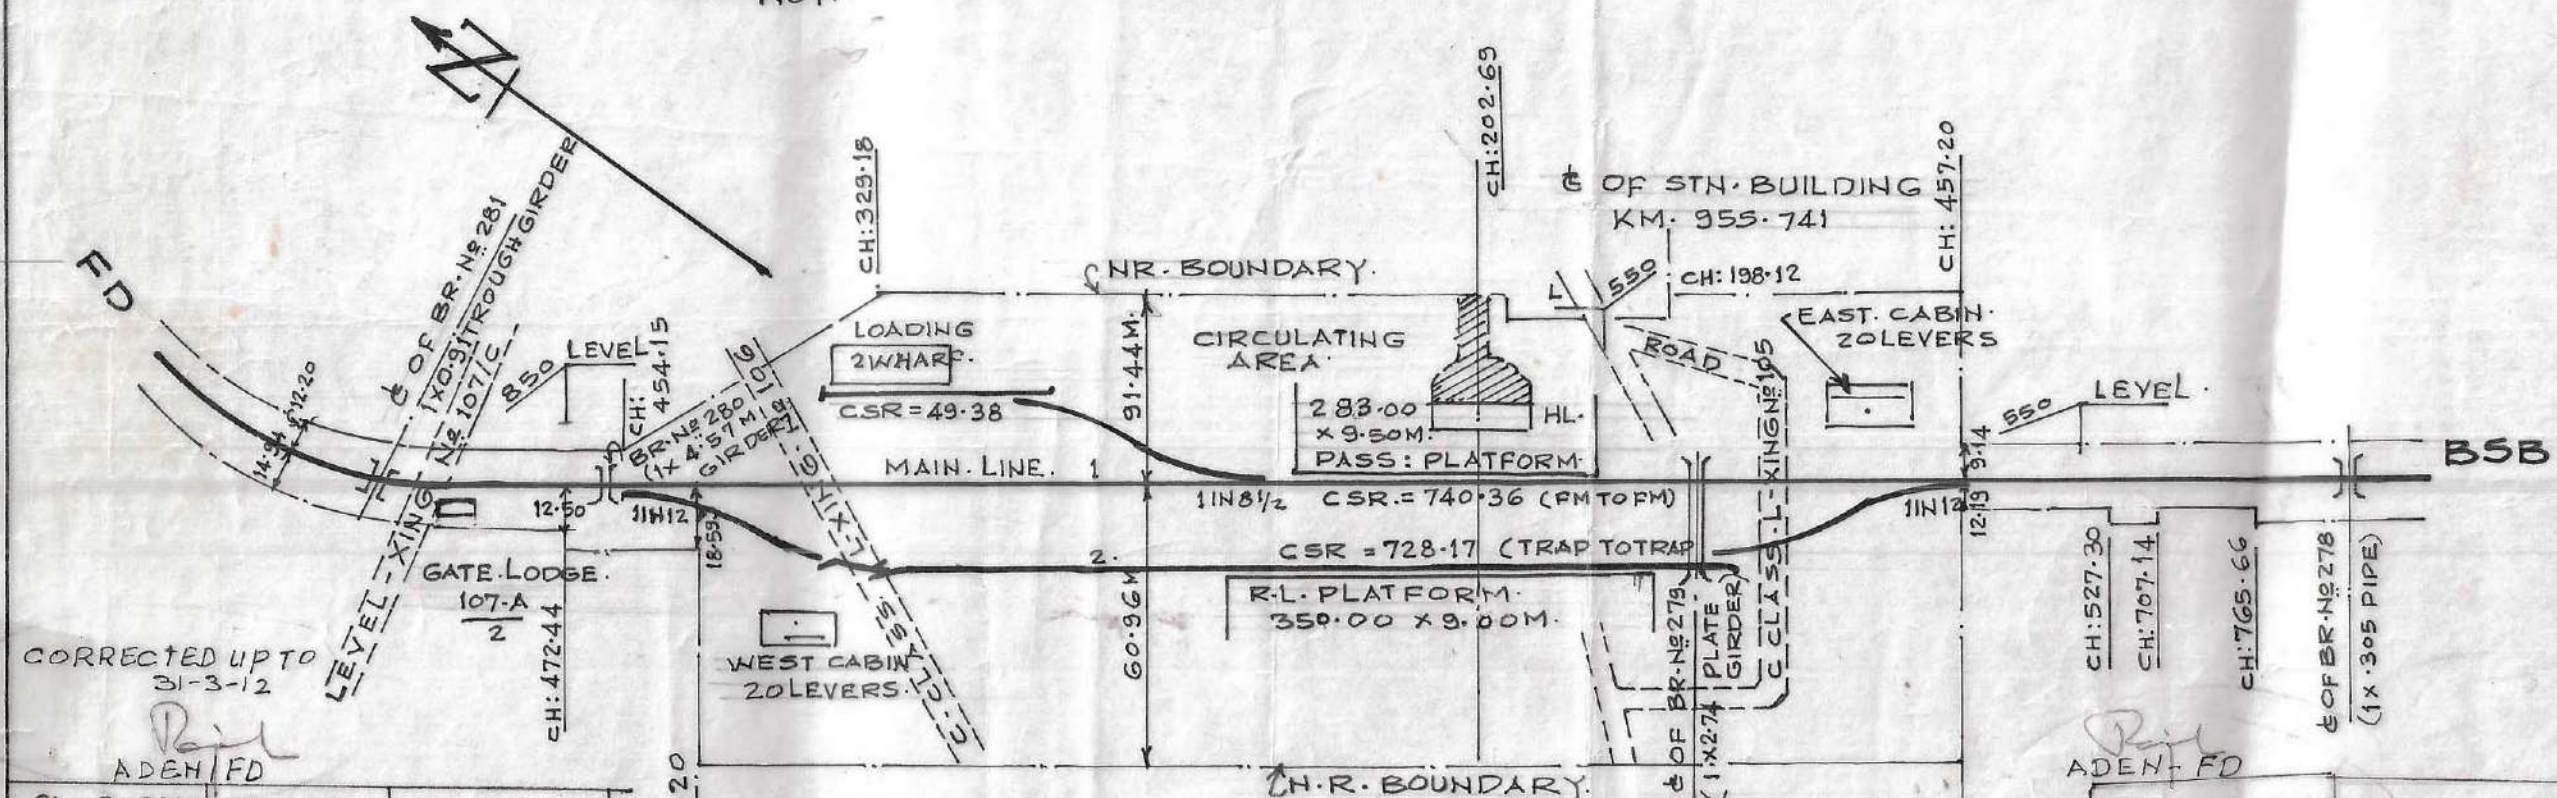

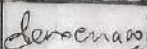
31-3-2010	31-3-2011	31-3-2012
 DEN-IV	 DEN-IV	 DEN-IV
S.S.E.		CORRECTED UP TO
DRAWN		
CHECKED		DSE (T)/LKO
BY S.E. V		


CH: 457-2		CH: R. BOUNDARY		CH 457-20	
31-3-2001	31-3-2002	31-3-2003	31-3-2004	31-3-2005	31.3.2006
<i>[Signature]</i>	<i>[Signature]</i> 30/4/02	<i>[Signature]</i> 8/5/03	<i>[Signature]</i>	<i>[Signature]</i> 21/5/05	<i>[Signature]</i> 21/06

31-3-2013	31-3-2014
<i>Mu</i> DEN-(V)	<i>OR</i> <i>James</i> ADEN/FD DEN-(V)
31-3-2007	31/03/2008 31/03/2009
<i>James</i>	<i>James</i> DEN(V)

NORTHERN RAILWAY
LUCKNOW DIVISION
LKO-FD-BSB-SECTION
DIAGRAM OF
DARSHAN NAGAR STN. YARD
ML. NOT TO SCALE
RSL.=98.3

DARIYABAD STATION YARD

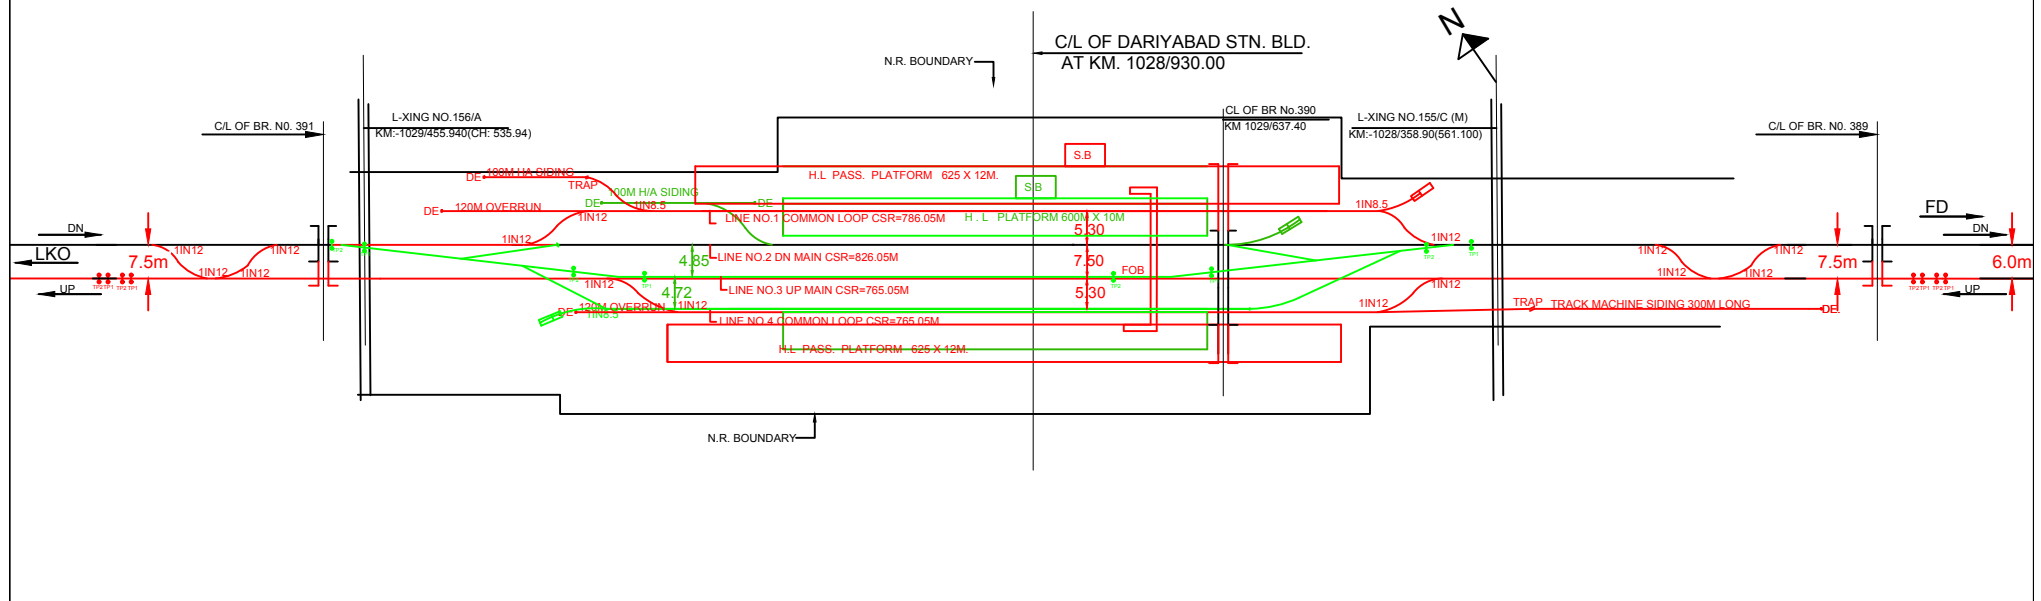



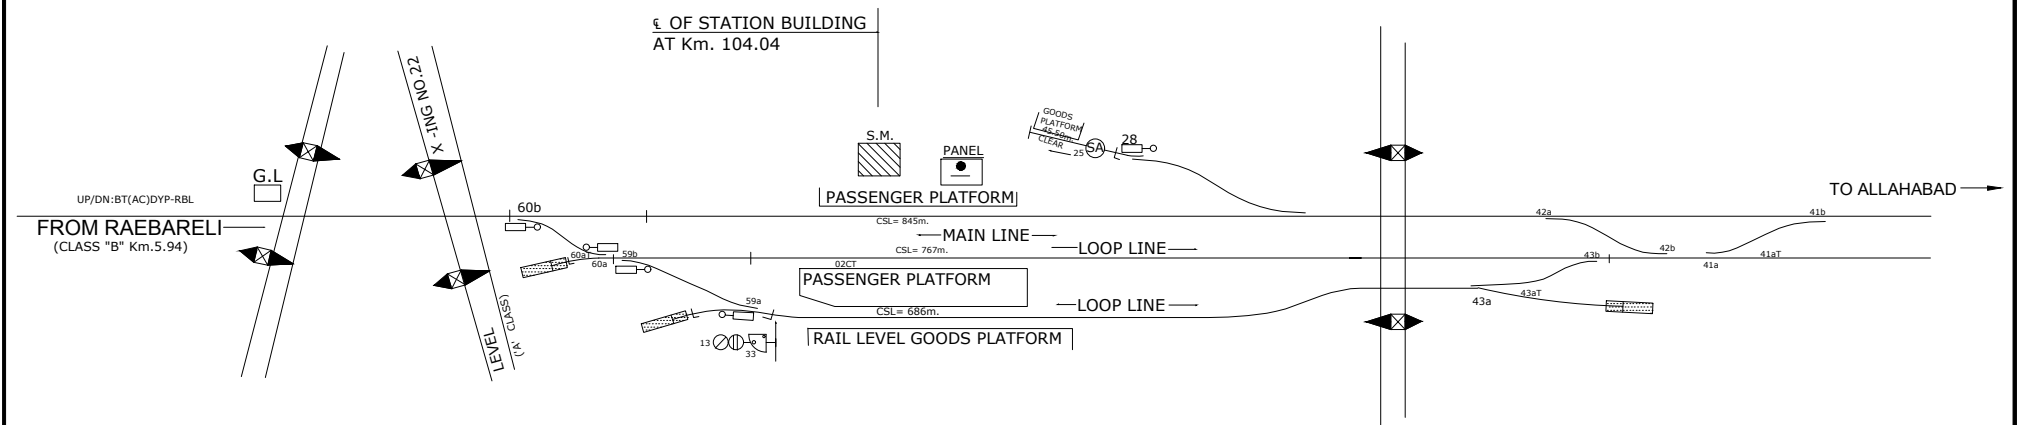


CHECKED BY	
DRAWN BY	

ADEN/PRG		Sr.DEN/(IV)			
CORRECTED UPTO	18-02-2020				

NORTHERN RAILWAY	
LUCKNOW DIVISION	
FD-SLN-ALD SECTION	
DIAGRAM OF	
DARYAPUR STN. YARD	
R.L./M.S.L.	NOT TO SCALE
N.R. D.R.M. LKO. SKETCH NO.	316-06

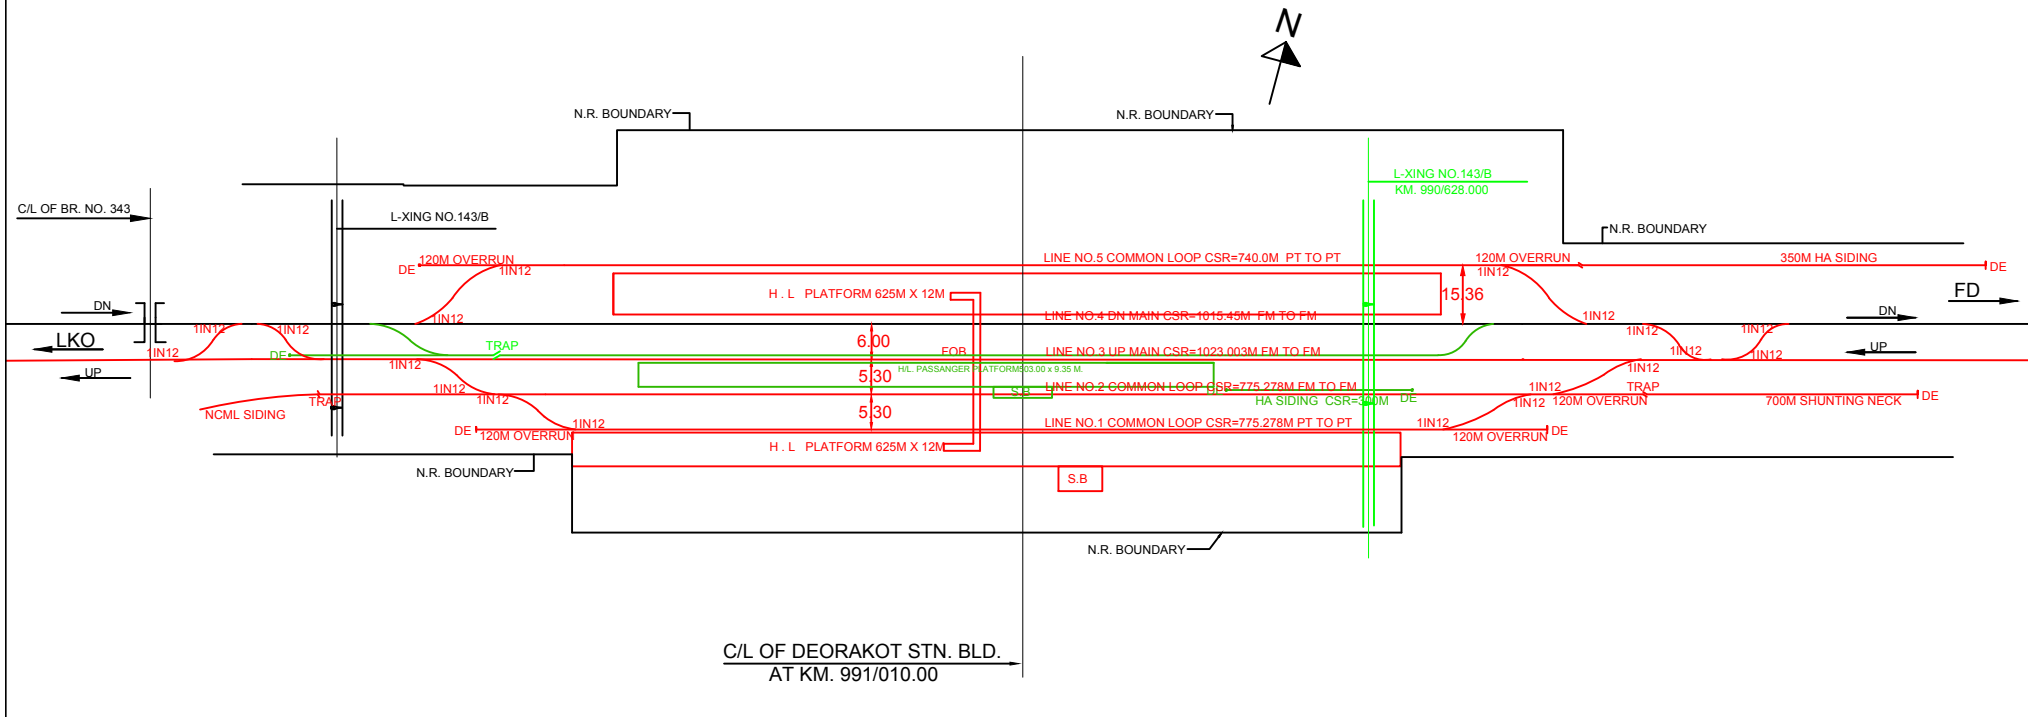

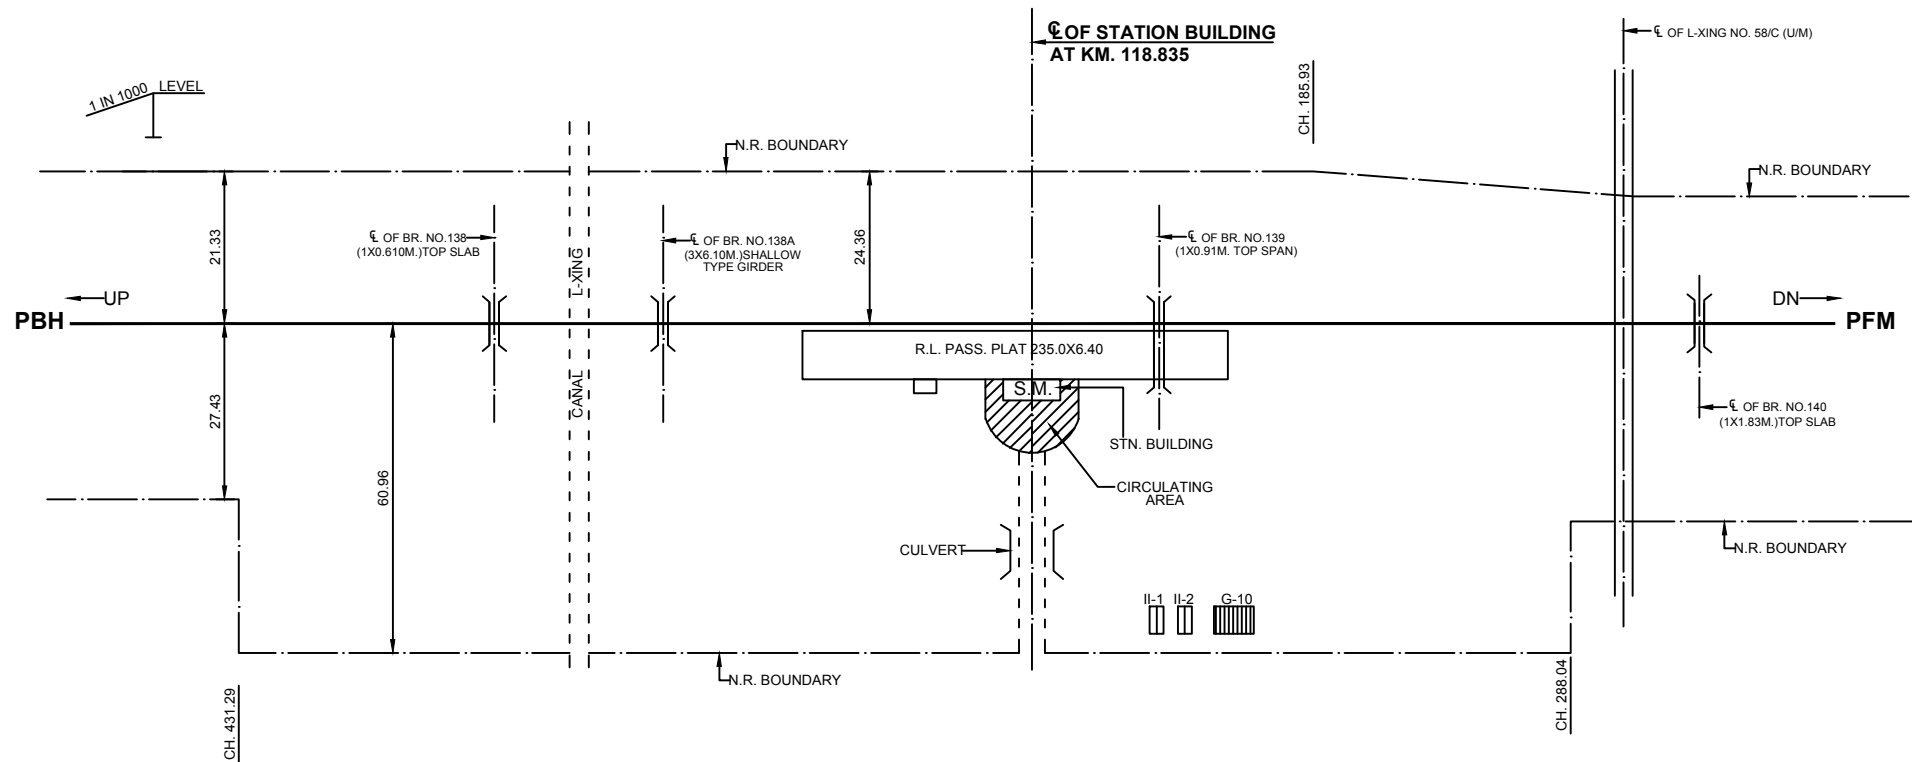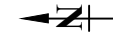

NORTHERN RAILWAY
LUCKNOW DIVISION
FD-SLN-FM SECTION
DIAGRAM OF
DHIRGANJ STN. YARD


R.L./M.S.L. NOT TO SCALE
N.R. D.R.M. LKO. SKETCH NO. 329-06

CHECKED BY
DRAWN BY

ADEN/PRG
CORRECTED UPTO 18-02-2020
Sr.DEN/(IV)

S. No.	DESCRIPTION	REMARKS			S. No.	DESCRIPTION	AREA (Sq.m.)
1	TOILETS	LAV.	URINAL		1	AREA OF PLATFORM SHELTER	---
		LADIES				P/F No.1	
		GENTS					
2	NO OF WATER TAPS/HAND PUMPS ON EACH PLATFORM	P/F No.	TAPS	H.P.		TOTAL AREA OF PLATFORM	
		1			1.	PLATFORM NO. 1	
	SOURCE OF WATER SUPPLY	OPEN WELL -			2.	PLATFORM NO. 2	
3	YEAR OF CONSTRUCTION OF STATION BUILDING	1998			3.	AREA OF WAITING ROOM	
4	BOOKING OFFICE NO. OF WINDOWS	ADV. RES.	CURRENT		I- UPPER CLASS WAITING ROOM		
5	NO. OF SEATS	P.F. 1	W/ HALL	TOTAL	II - AREA OF WAITING ROOM		
6	WHETHER ENQUIRY OFFICE PROVIDED OR NOT	40			a- LADIES		
					b- GENTS		
					III- WAITING HALL		
					4.	CIRCULATING AREA	CH. 254.43

REF.	FENCING	KUTCHA PUCCA
	ROAD	METALLED UNMETALLED

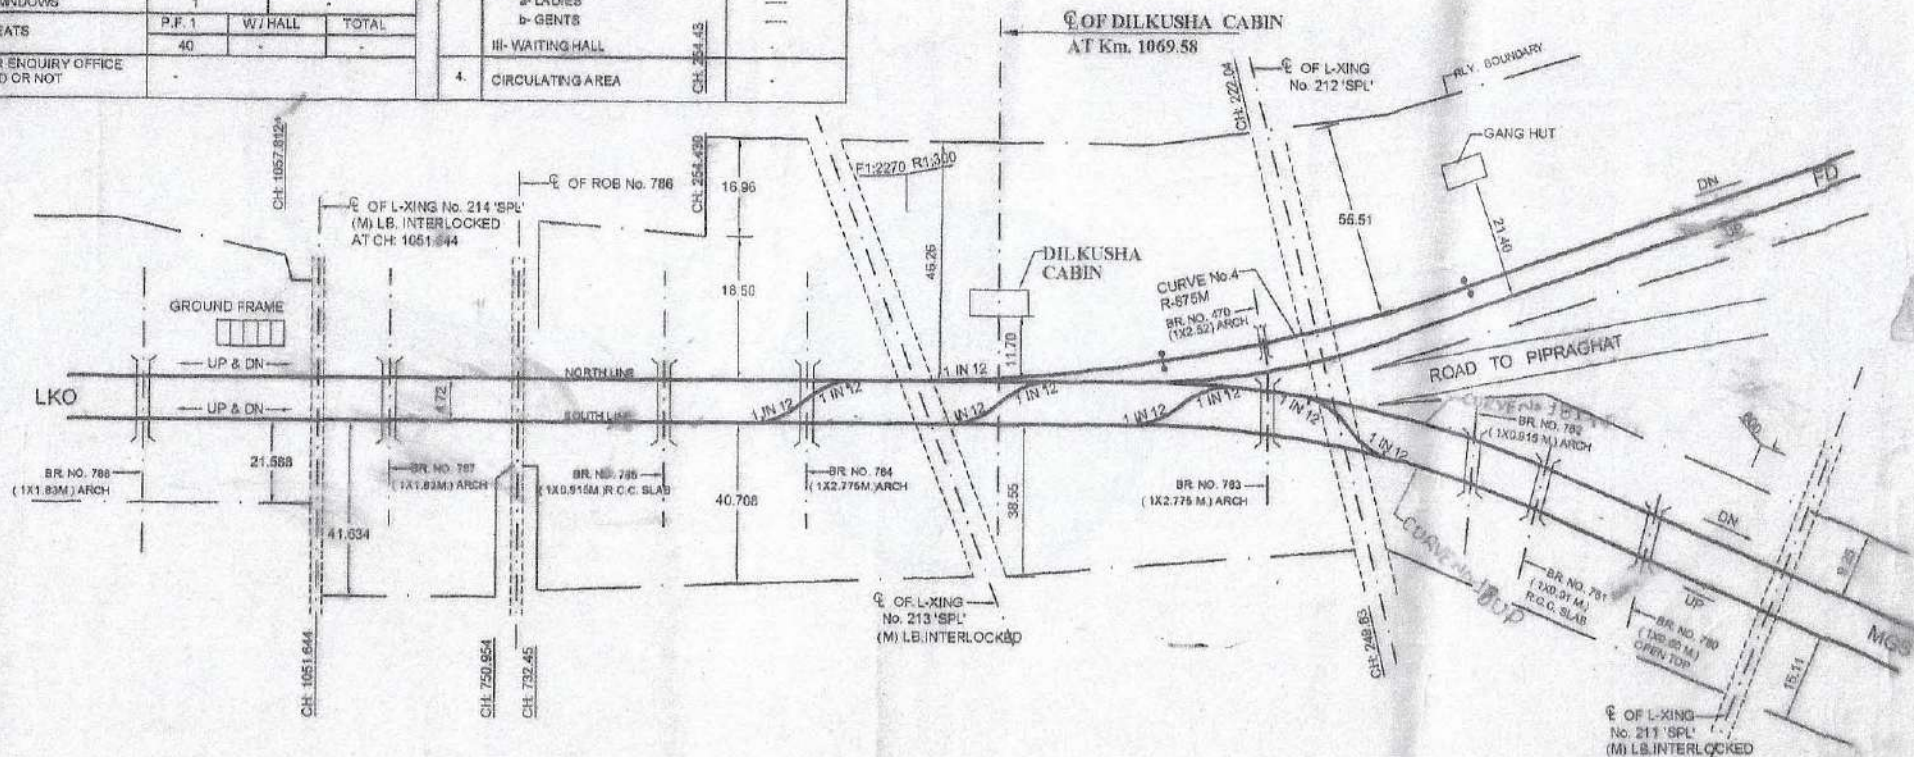


NORTHERN RAILWAY	
LUCKNOW DIVISION	
LKO - PBH - MGS SECTION	
DIAGRAM OF	
DILKUSHA CABIN STN. YARD	
R.L./M.S.L. 96.930	NOT TO SCALE
N.R. DIV. L. SKETCH NO.	M-126/LKO/2012

CHECKED BY	DAKSCH
DRAWN BY	235, 241, 242, 243, 999, 1000

Sr. D.E.N. (I)	31-03-12	31-3-13	31-3-14	31-3-2015	31-3-2016	31-03-2018
ADEN-ILKO						
CORRECTED UPTO	31-03-12	31-3-13	31-3-14	31-3-2015	31-3-2016	31-03-2018

31/3/18


49A

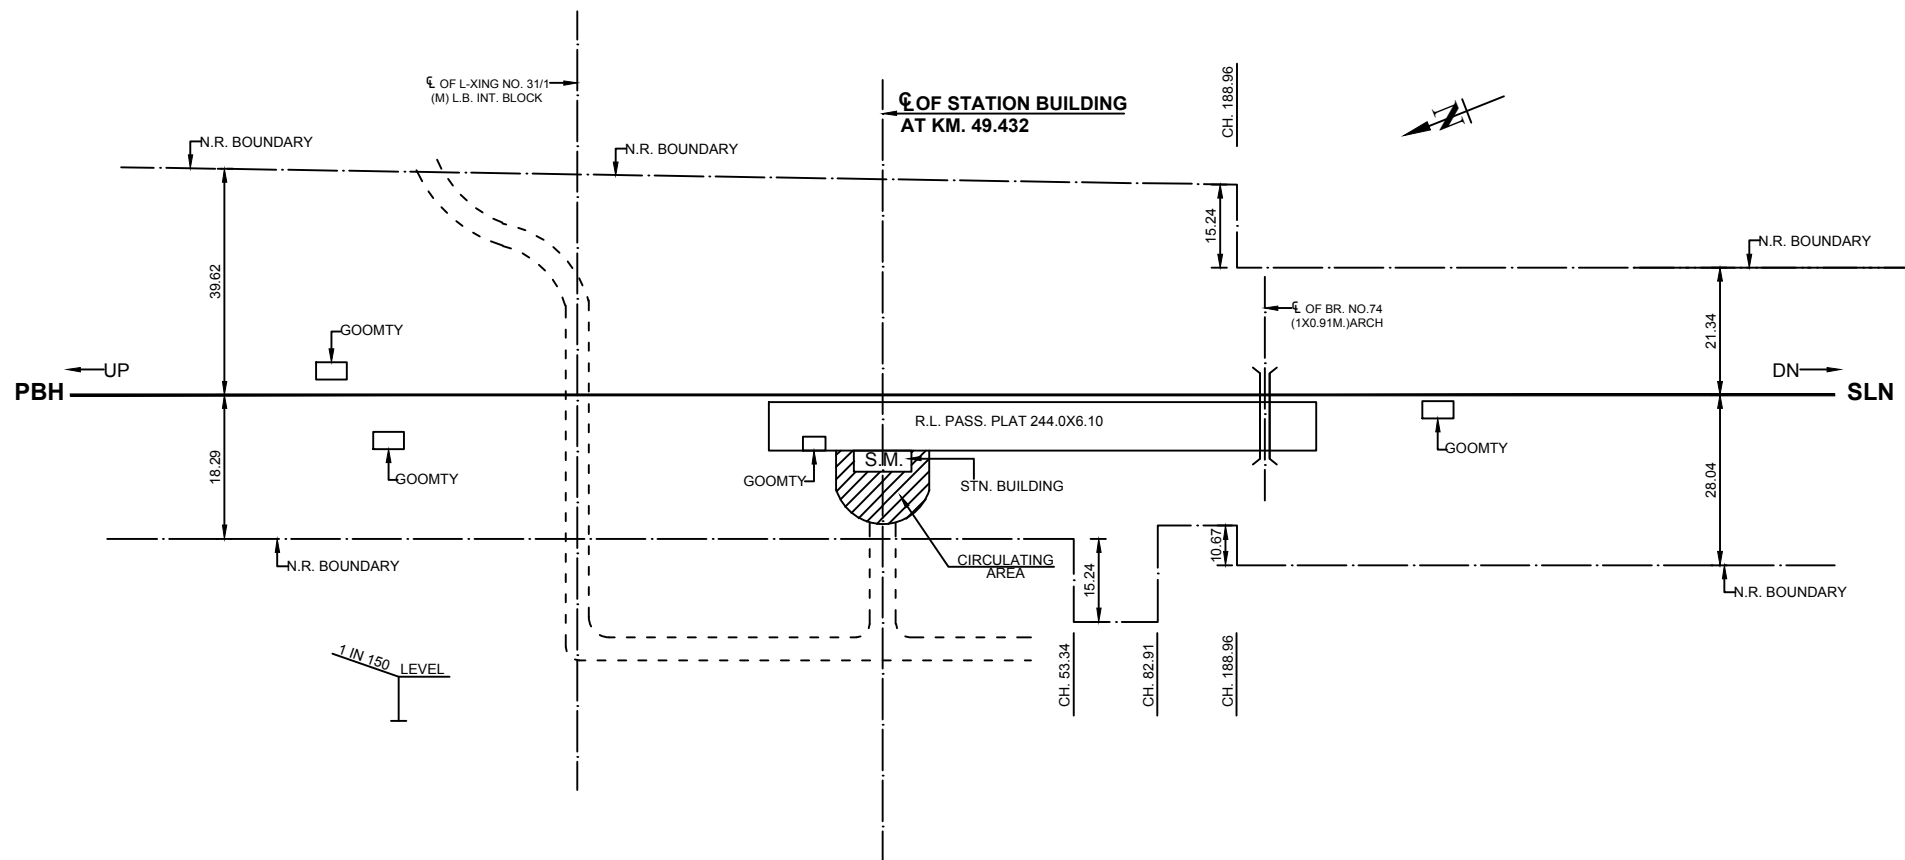

NORTHERN RAILWAY	
LUCKNOW DIVISION	
FD-SLN-ALD SECTION	
DIAGRAM OF	
DWARKAGANJ STN. YARD	
R.L./M.S.L.	NOT TO SCALE
N.R. D.R.M. LKO. SKETCH NO.	322-06

CHECKED BY	
DRAWN BY	

ADEN/PRG		Sr.DEN/(IV)			
CORRECTED UPTO	18-02-2020				

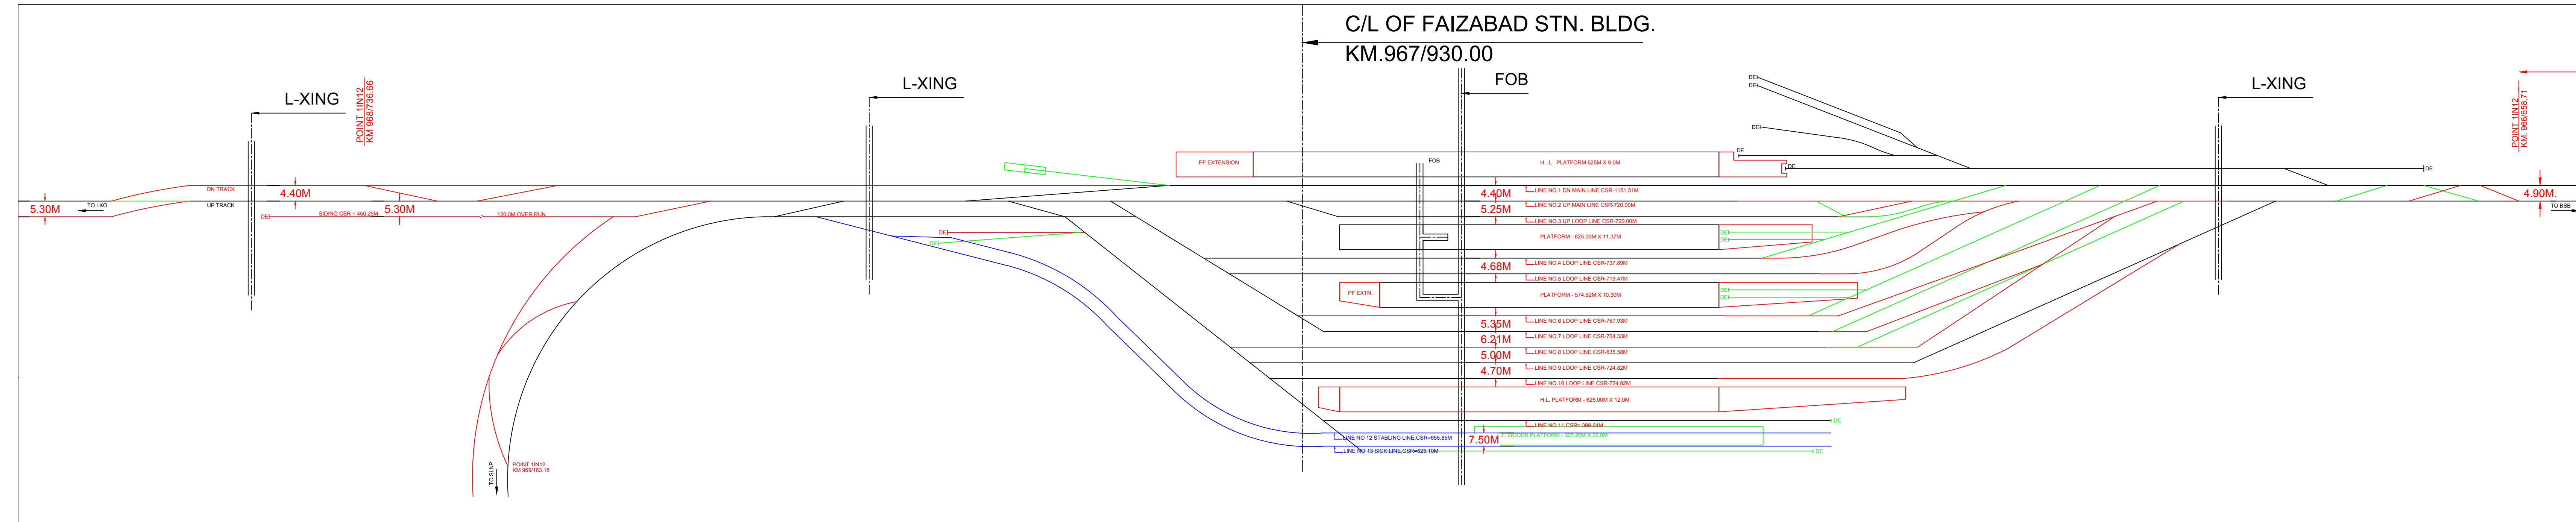


₹ FURSATGANJ STATION

AT Km. 977.100

LEGEND:-

1. EXISTING WORK SHOWN THUS —
2. PROPOSED WORK SHOWN THUS —
3. DISMENTLING WORK SHOWN THUS —

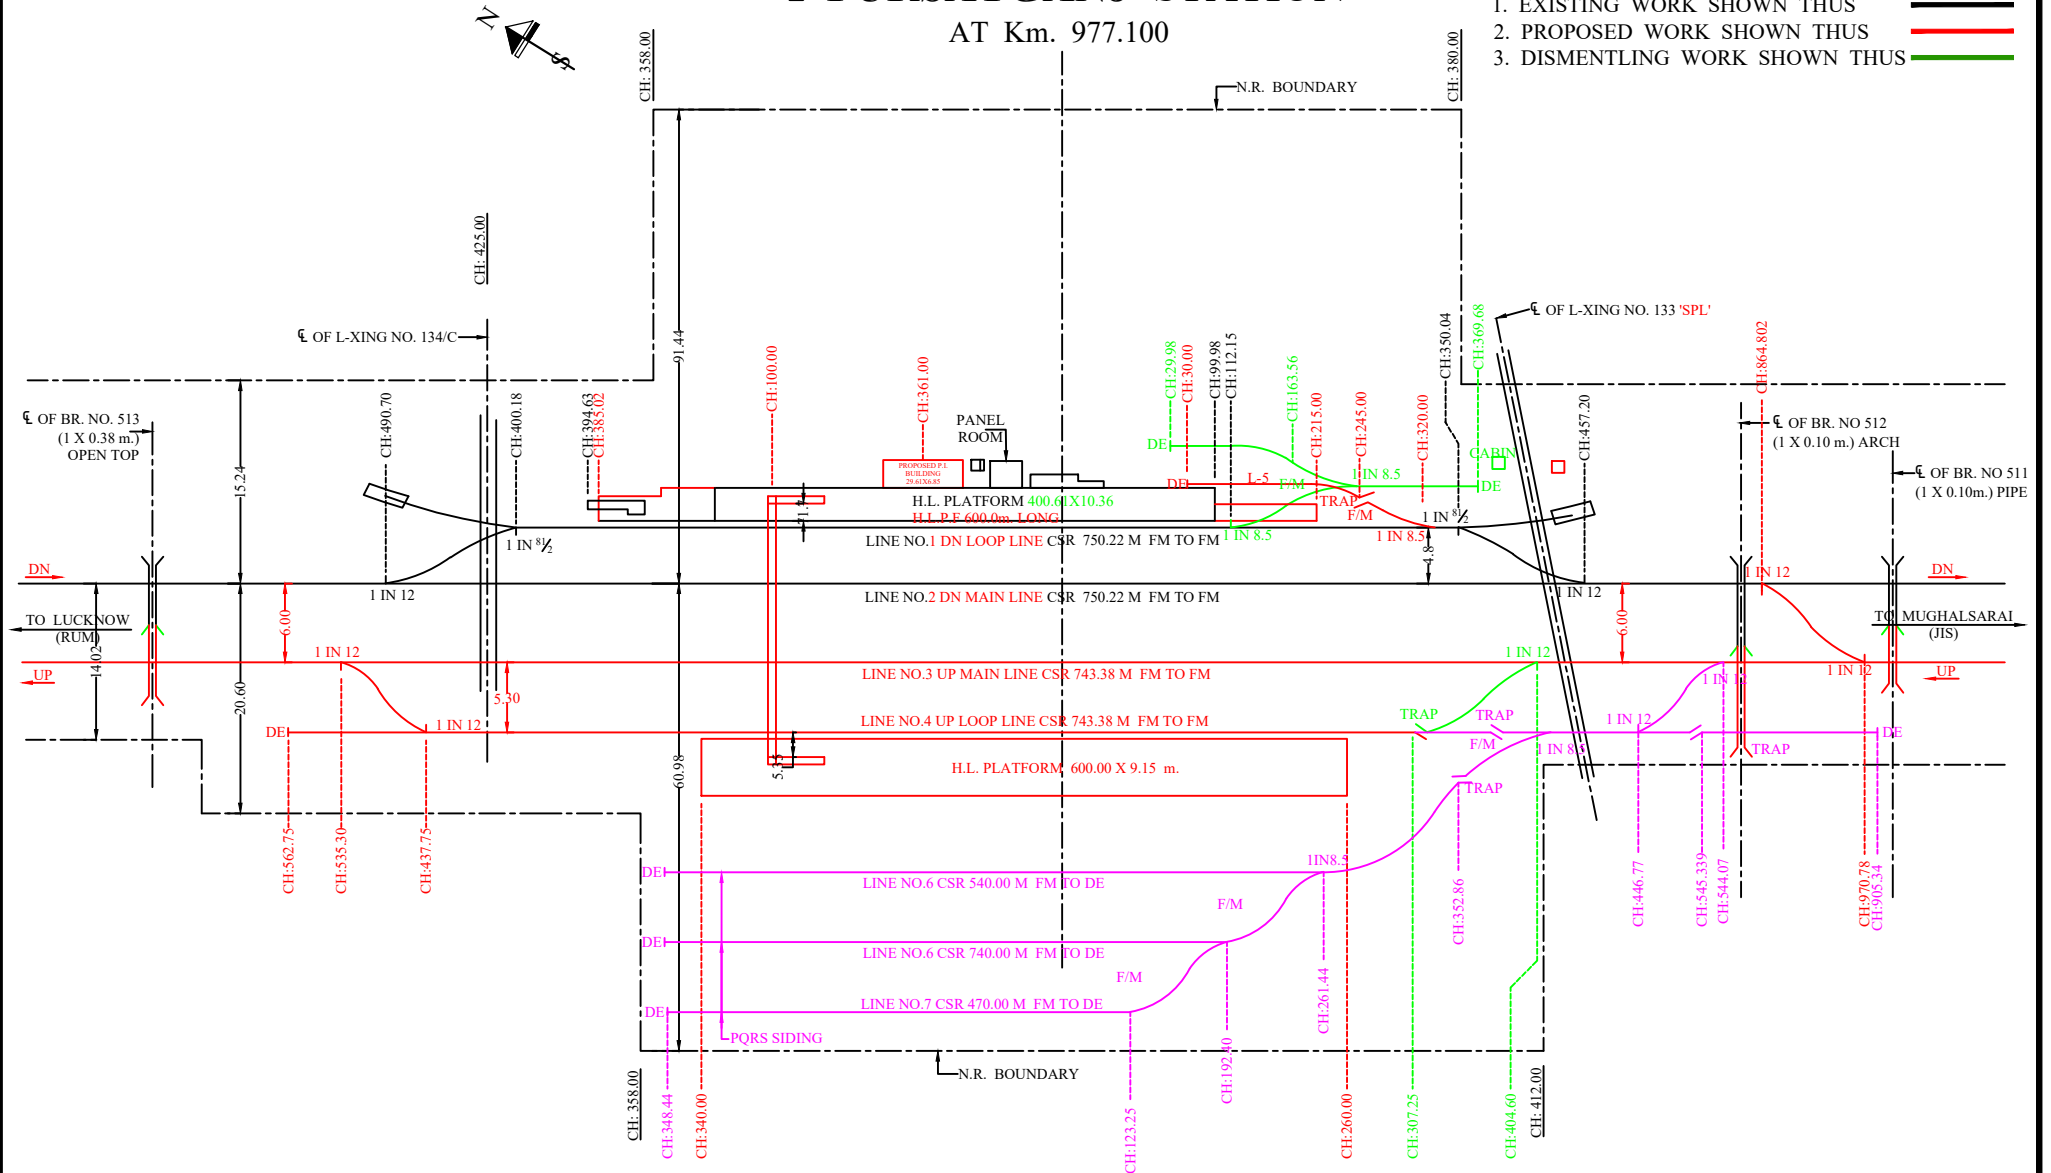

Sr.No.	LINE TYPE	CSR (FM-FM)
1	DN.L.L	750.22m
2	DN.M.L	750.22m
3	UP.M.L	745.00m
4	UP.L.L	745.00m
5	H.A SID.	100.0m

T.O	1 in 12		1 in 8.5			TRAP		DE	SH
	L	R	L	R	SS	L	R		
EXISTING	1	1	-	-	2	-	-	-	2
DISMANTLING	-	-	2	-	-	-	-	-	2
PROPOSED	1	4	-	1	-	1	1	-	2

SCALE:- THIS DRAWING IS NOT TO SCALE




-
-
-



रेल विकास निगम लिमिटेड
Rail Vikas Nigam Limited

GANGAGANJ STATION YARD

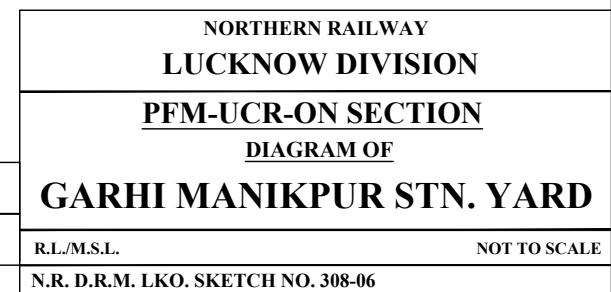


CHECKED BY	
DRAWN BY	

Sr. DEN/(IV)					
ADEN/PRG					
CORRECTED UPTO	18-02-2020				

LEGEND:-

EXISTING WORK	—
PROPOSED WORK	—
DISMANTLED WORK	—
FUTURE WORK	—

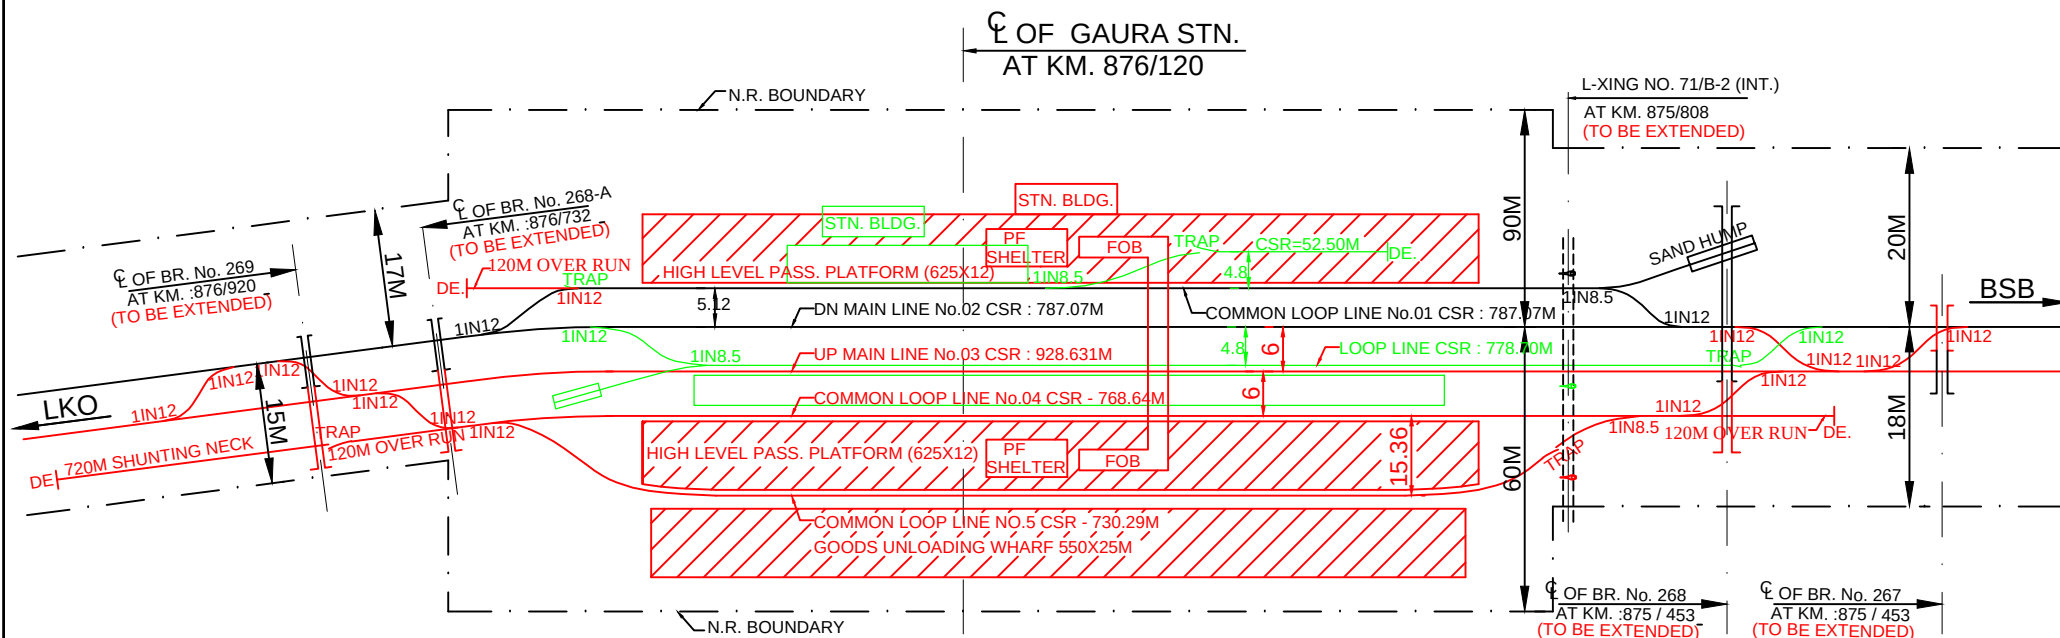

Detail of traffic movement:

Sr.NO.	Movement	To Line no.
1.	From Lucknow	1 to 5
2.	From Varanasi	1 to 5

AMETHI-JANGHAI DOUBLING (87 KM)


LEGEND:-

1. EXISTING WORK SHOWN THUS —
2. PROPOSED WORK SHOWN THUS —
3. DISMENTLING WORK SHOWN THUS —

CL OF GAURIGANJ STATION

AT KM.948.62

CH:000.00

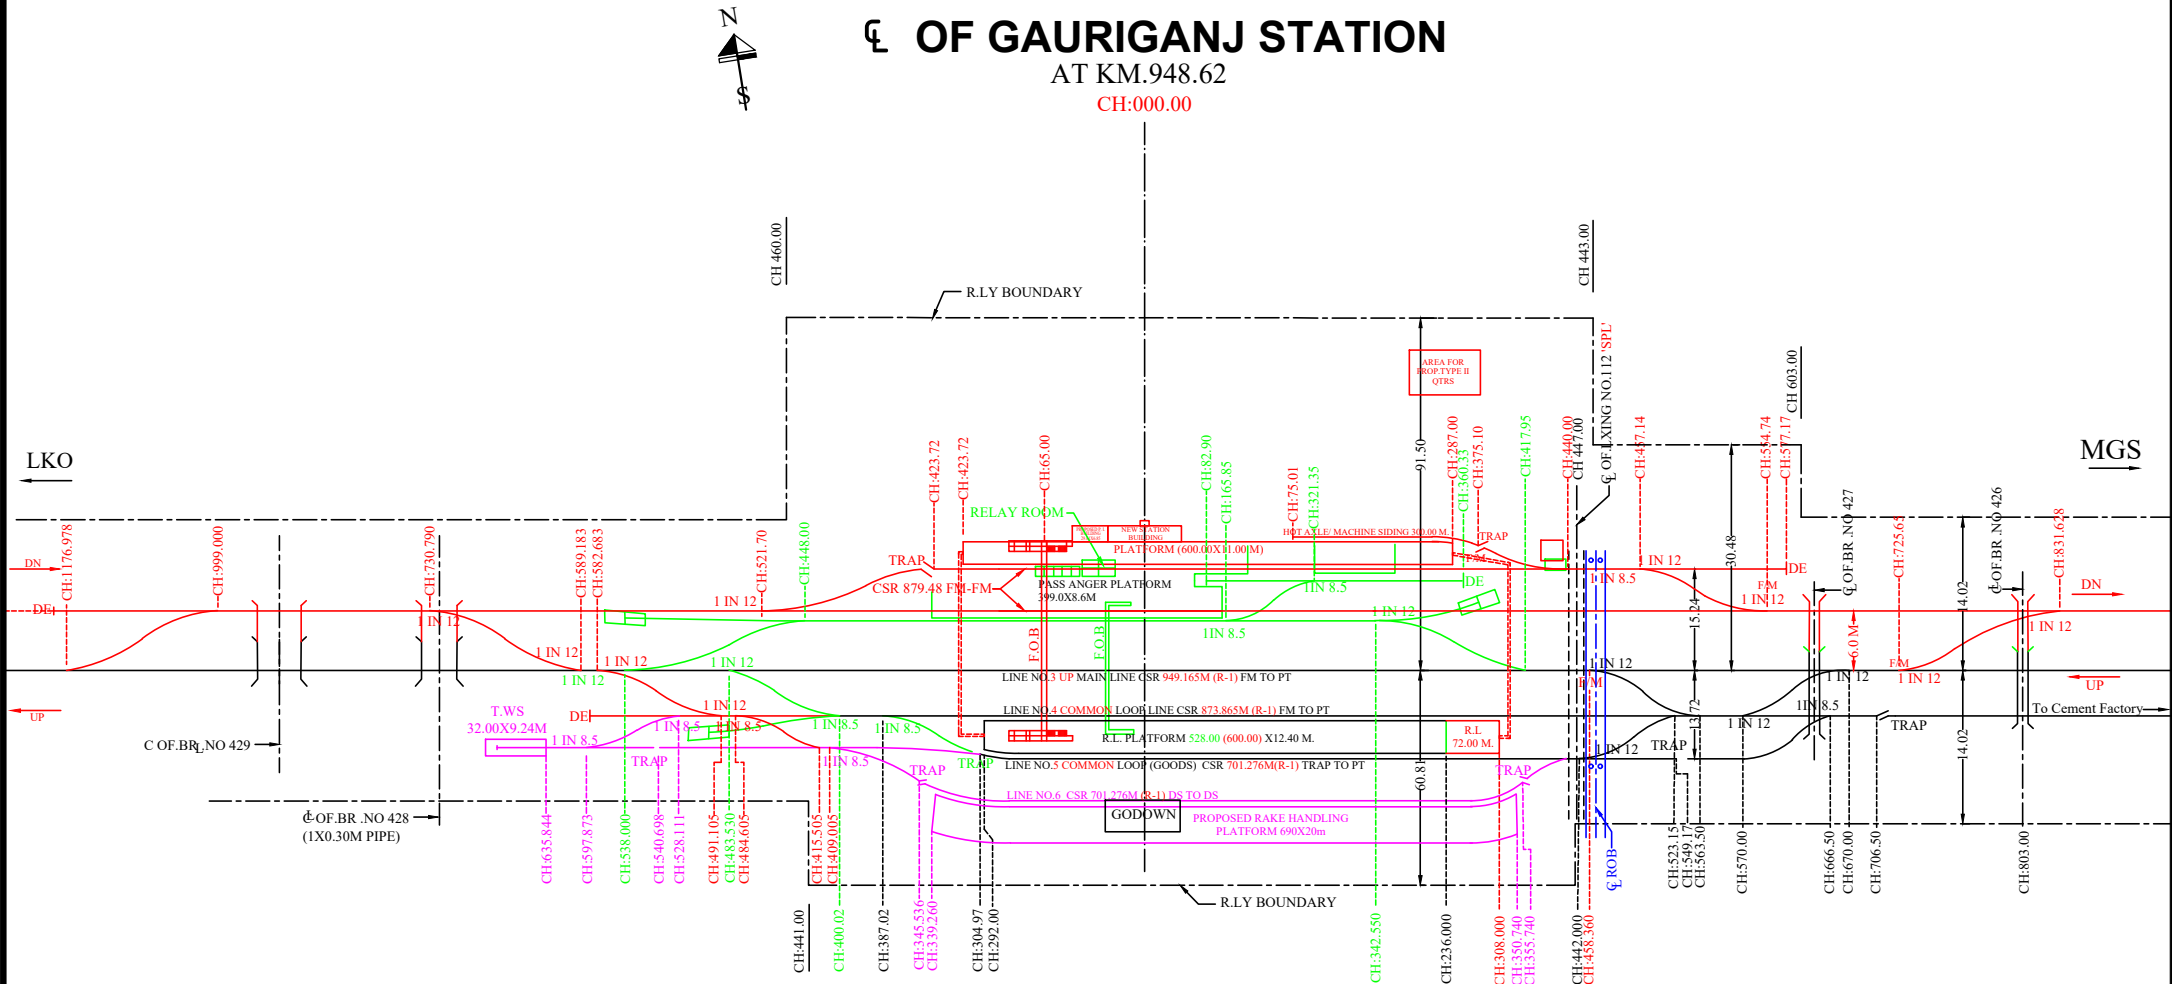

Sr.No.	LINE TYPE	CSR (FM-FM)
1	COM.L.L	762.00m
2	COM.M.L	762.00m
3	UP M.L	880.86m
4	UP L.L	880.86m
5	COM.G.L	726.17m
6	H.A./M/C SID.	300.00m

T.O	1 in 12		1 in 8.5		SS	TRAP		DE	SH
	L	R	L	R		L	R		
EXISTING	3	2	1	1	-	1	-	-	-
DISMANTLING	1	2	2	-	3	-	-	1	2
PROPOSED	3	6	-	1	-	1	2	1	-

SCALE:- THIS DRAWING IS NOT TO SCALE




GAURI GANJ STATION YARD

GAURIYAMAU STATION YARD



C/L OF GAURIYAMAU STN. BLD.
AT KM. 1005/747.00

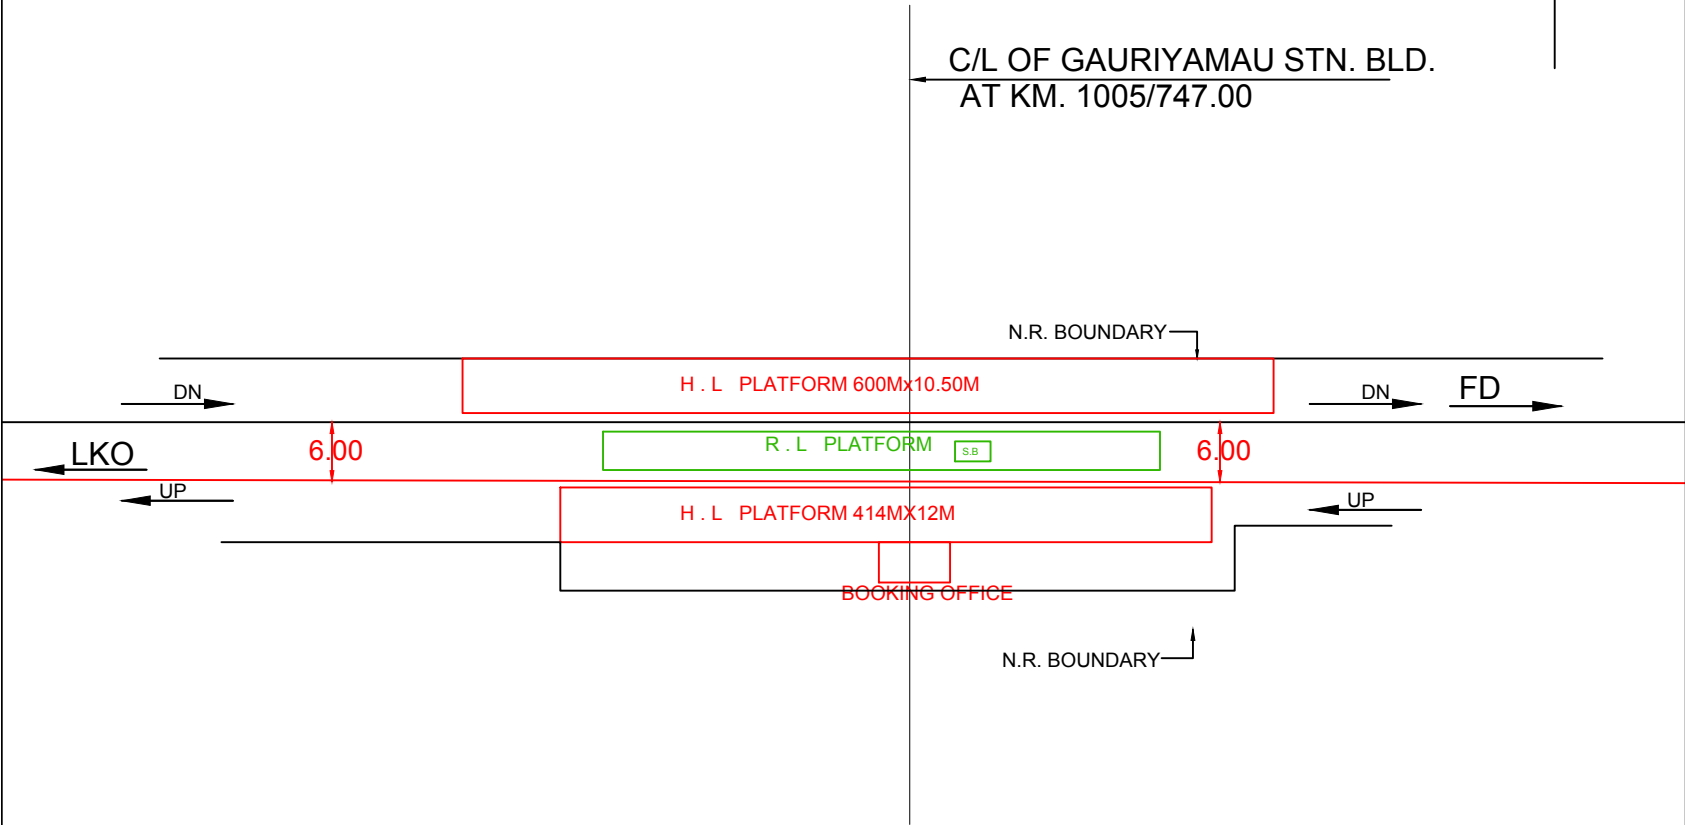


NOTE:-
1. LAVATORIES:-
a) NO. OF SEATS (LADIES & GENTS FLUSHED OR DRY) LADIES=1 A/PV
GENTS=1 2
2. NO. OF WATER TAPS/HAND PUMPS ON EACH PLATFORM AND SOURCE OF WATER SUPPLY. HAND PUMP=3+2
3. YEAR OF CONSTRUCTION OF THE STATION BUILDING WELL=1
4. BOOKING OFFICE
c) NO. OF WINDOWS 1+1
5. WHETHER ENQUIRY OFFICE PROVIDED OR NOT NOT.

S.No	DESCRIPTION	SQ.M.
1.	AREA OF PLATFORM SHELTERS:- I. ON PLATFORM NO 1 II. ON " NO 2	179.00 114.00
2.	TOTAL AREA OF PLATFORM I. PLATFORM NO 1 II. PLATFORM NO 2	4459.00 3270.80
3.	AREA OF WAITING ROOM I. UPPER CLASS (LADIES) (GENTS) II. WAITING HALL	- - 91.00
4.	CIRCULATING AREA	225.00


REF:-	
FENCING	{ KUTCHA PUCCA
ROAD	{ METALLED UNMETALLED

N.R.DRM. LKO. SKETCH NO 107-2000
CORRECTED UP TO 31.3.2000
DSE(T)/NR.LKO.

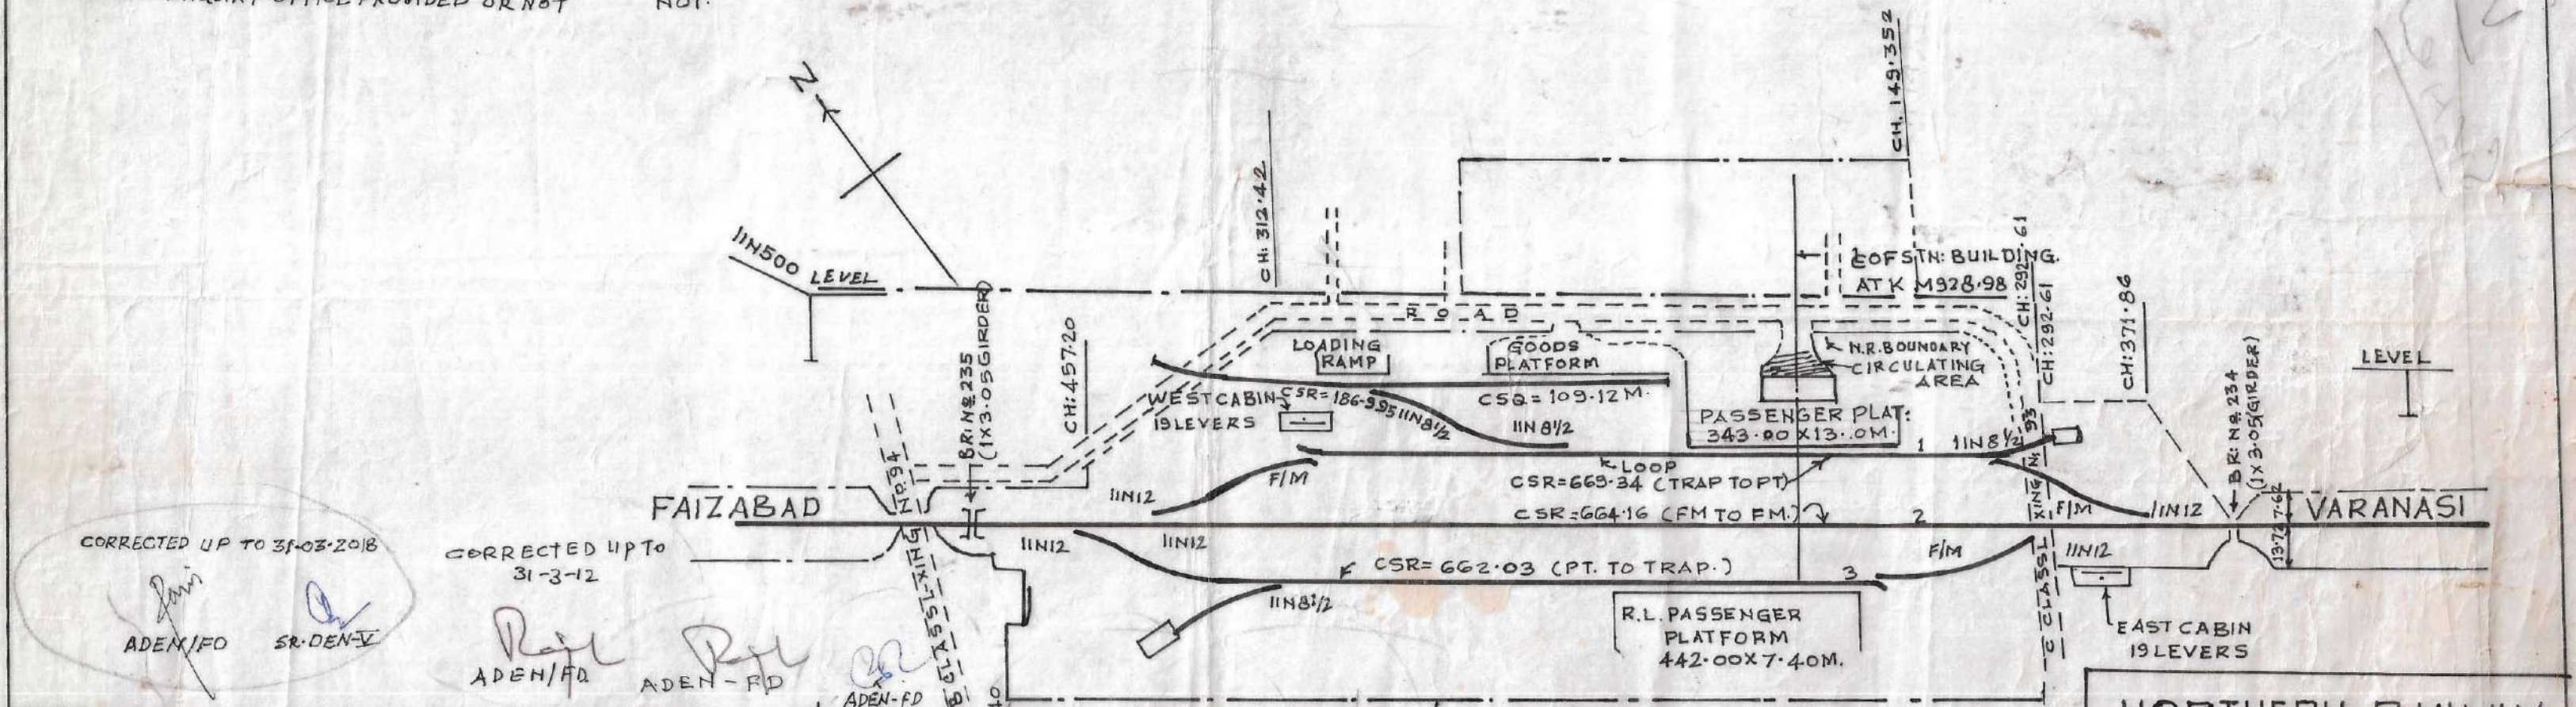

31-3-2010	31-3-2011	31-03-2012	31-03-2013	31-03-2014	31-3-2015	31-3-2016	31-3-2017	31-3-2018	31-3-2019
DEN-(V)	DEN-(V)	DEN-V	DEN-V	DEN-V	DEN-V	DEN-V	DEN-V	DEN-V	DEN-V
S.S.E.	CORRECTED UP TO	31-3-2001	31-3-2002	31-3-2003	31-3-2004	31-3-2005	31.3.2006	31.3.2007	31-3-2008
TRACED	DSE(T)/LKO								
CHECKED S.E./V									



NORTHERN RAILWAY.
LUCKNOW DIVISION.
LKO-FD-BSB-SECTION.
DIAGRAM OF
GOSHAINGANJ. STN. YARD
RL. MSL. 34.20
NOT TO SCALE.

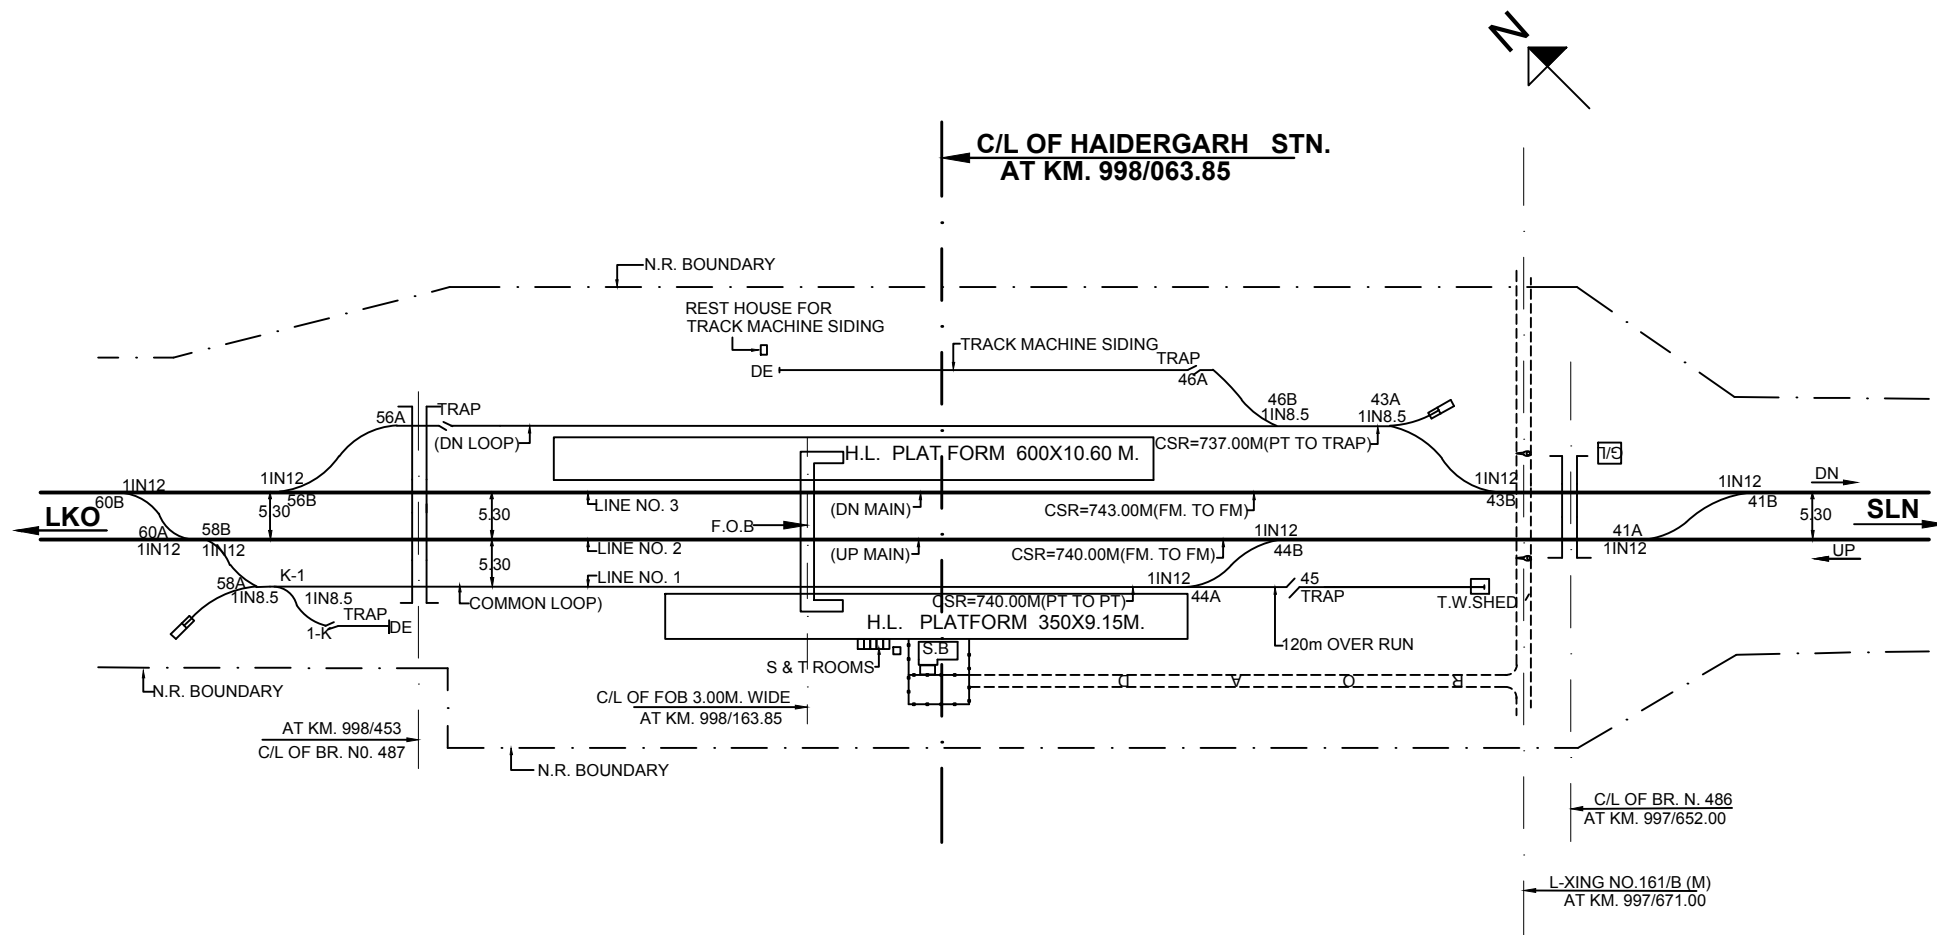

NORTHERN RAILWAY LUCKNOW DIVISION	
LKO -SLN-ZBD SECTION	
DIAGRAM OF	
HAIDERGARH STN. YARD	
R.L./M.S.L. 112.540m	NOT TO SCALE
N.R. D.R.M. LKO. SKETCH NO.	281 - 06

CHECKED BY	
DRAWN BY	


Sr. DEN/(IV)					
ADEN/SLN-I					
CORRECTED UPTO	18-02-2020				

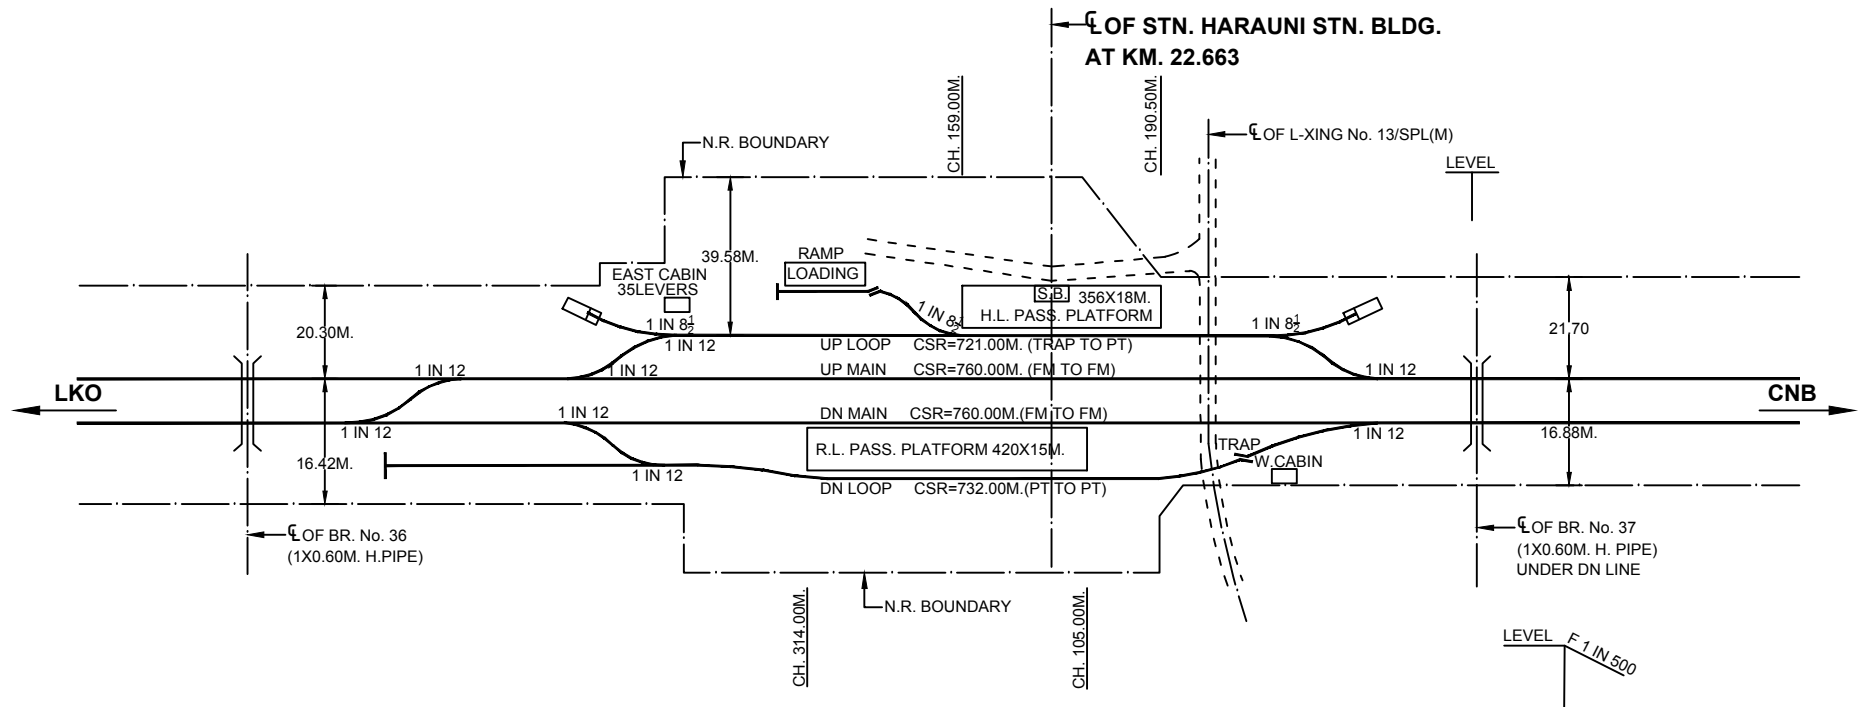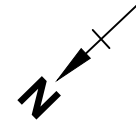


CHECKED BY	
DRAWN BY	

Sr. DEN/(V)						
ADEN/III/LKO						
CORRECTED UPTO	16-10-2020					

NORTHERN RAILWAY LUCKNOW DIVISION	
LKO-ON-CNB SECTION	
DIAGRAM OF	
HARAUNI STN: YARD	
R.L./M.S.L.	NOT TO SCALE
N.R. D.R.M. LKO. SKETCH NO.	

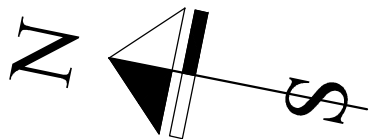

CL OF HARCHANDPUR STN. BLDG. Km: 1010.199

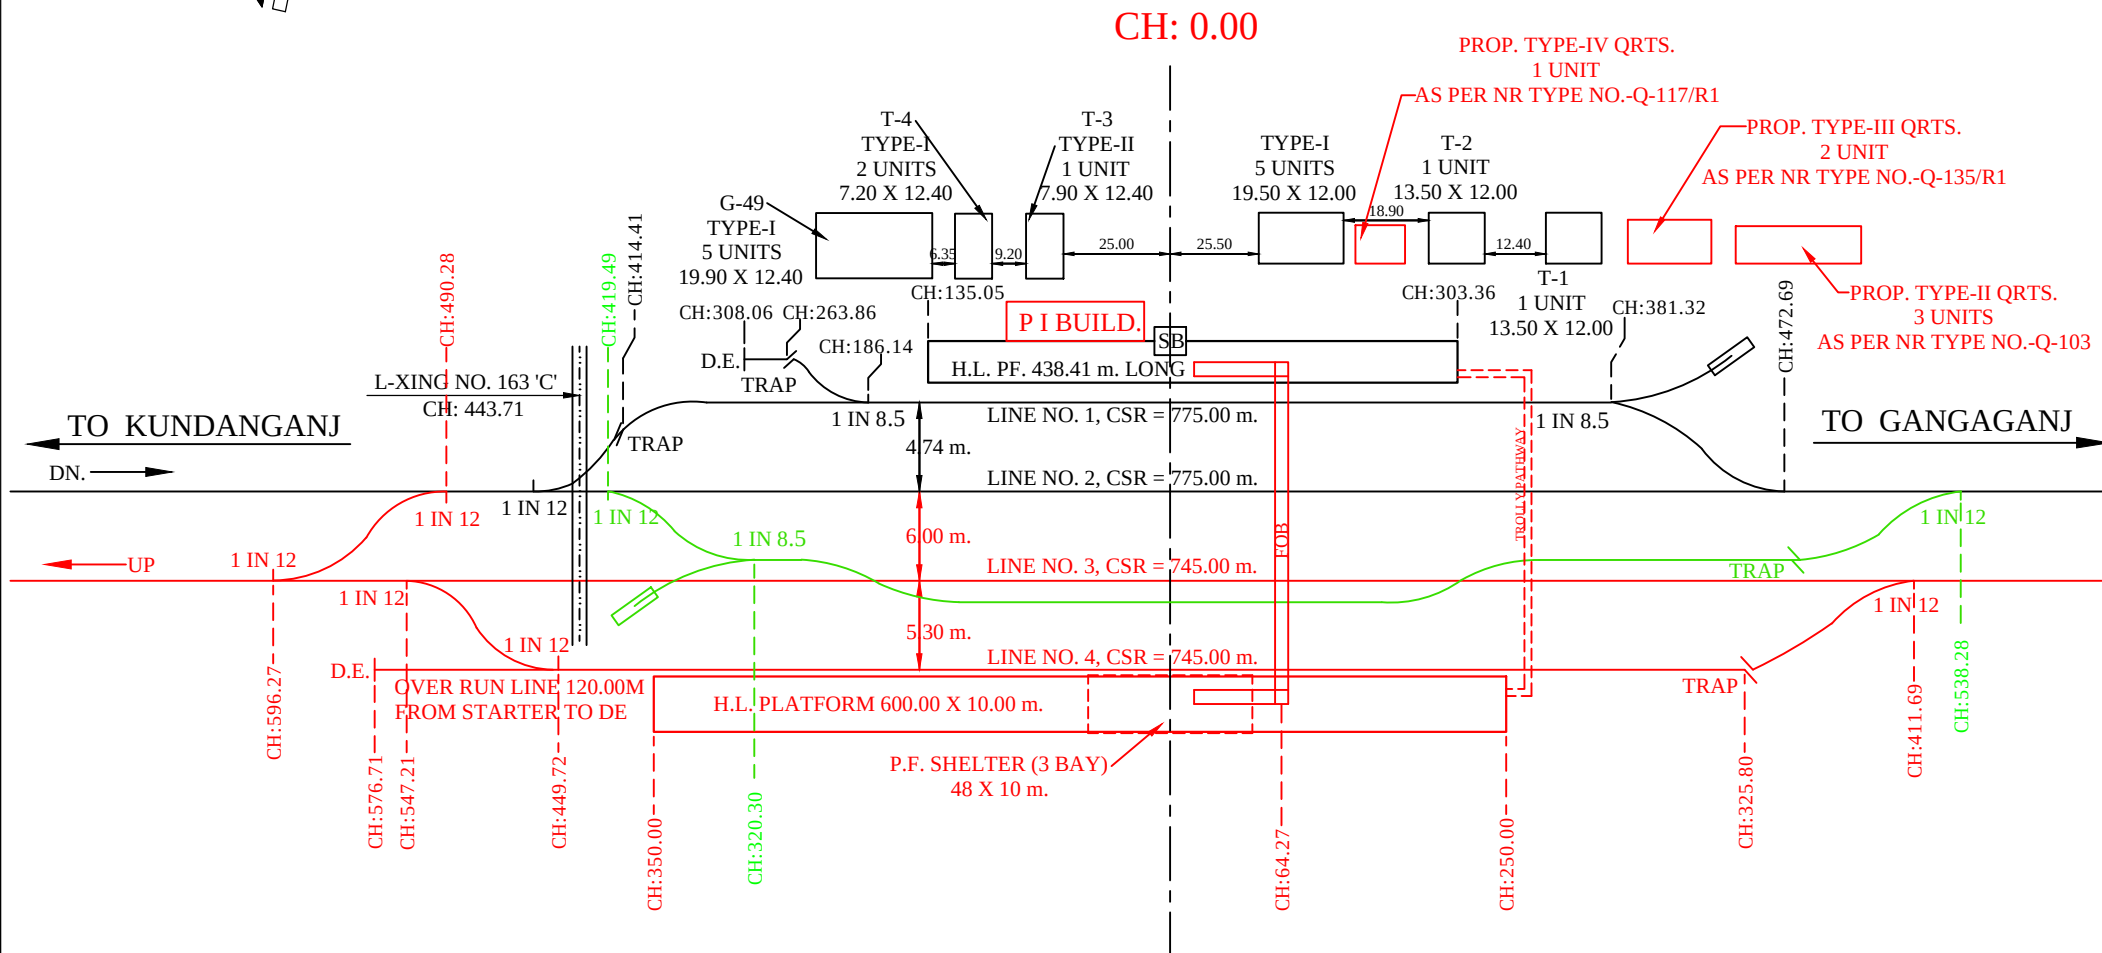


LEGEND:-

1. EXISTING WORK SHOWN THUS —
2. PROPOSED WORK SHOWN THUS —
3. DISMENTLING WORK SHOWN THUS —
4. THIS DRAWING IS NOT TO SCALE

S.No	DESCRIPTION	1 in 12	1 in 8½	TRAP
1.	DISMANTLING OF TURN OUT	2	1	1
2.	INSERTION OF TURN OUT	5	0	1



HARCHANDPUR STATION YARD

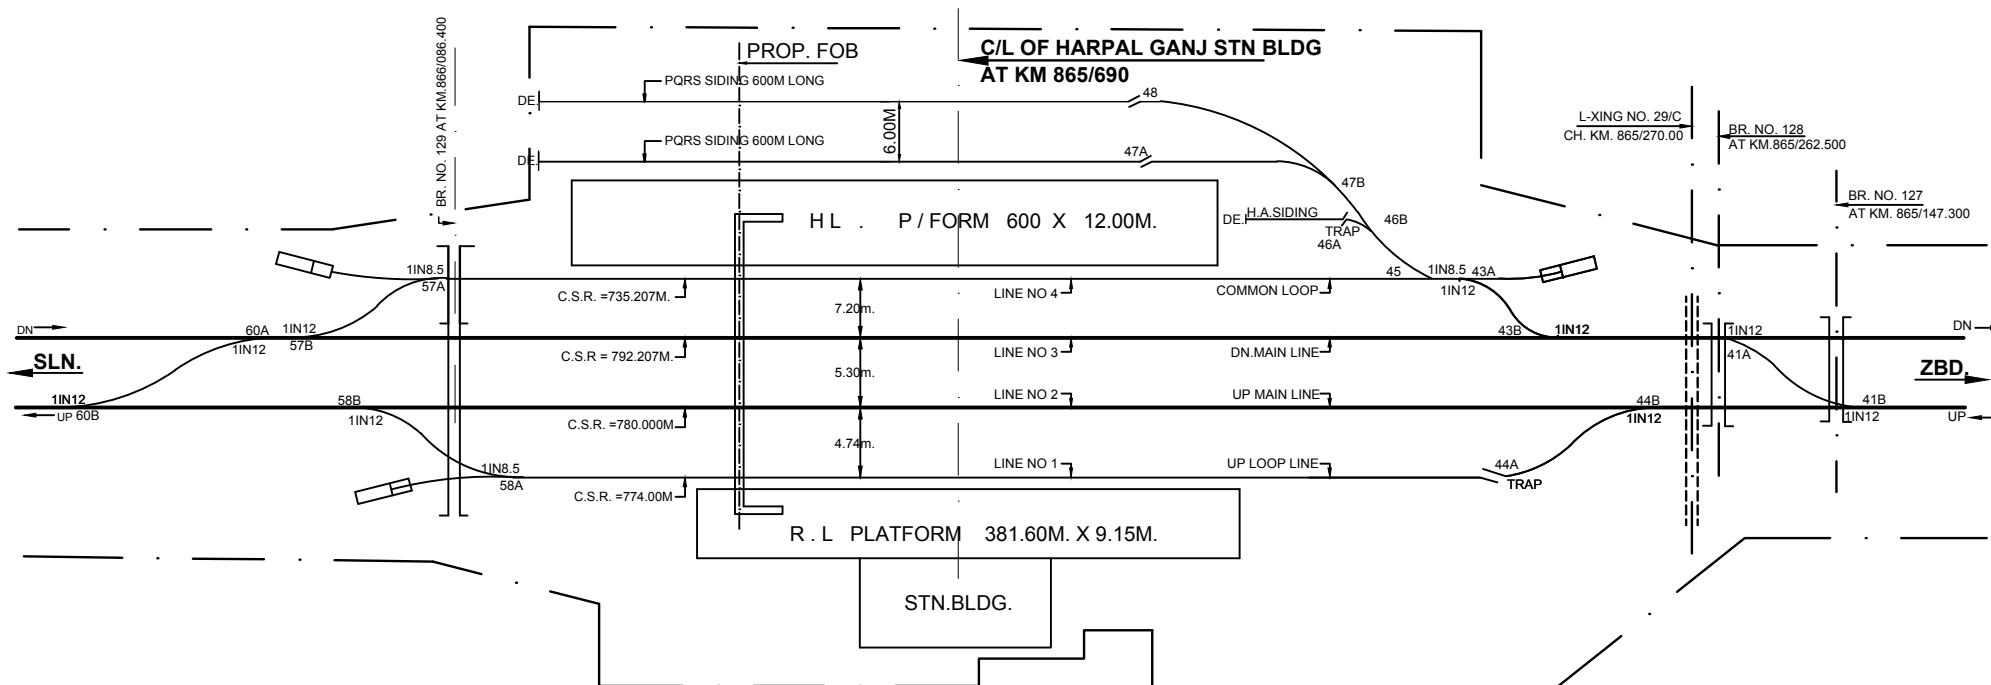

CHECKED BY	
DRAWN BY	


Sr. DEN/(IV)					
ADEN/SLN-II					
CORRECTED UPTO	18-02-2020				

NORTHERN RAILWAY LUCKNOW DIVISION	
LKO -SLN-ZBD SECTION DIAGRAM OF HARPAL GANJ STN. YARD.	
R.L./M.S.L. 88.450m	NOT TO SCALE
N.R. D.R.M. LKO. SKETCH NO.	265 - 06

S. No.	DESCRIPTION	REMARKS		
1	LAVATORIES		LAV	URINAL
		LADIES	-	
		GENTS	-	
2	NO OF WATER TAPS/ HAND PUMPS ON EACH PLATFORM	P/F No.	TAPS	H.P.
		1	-	1
	SOURCE OF WATER SUPPLY	-		
3	YEAR OF CONSTRUCTION OF STATION BUILDING	-		
4	BOOKING OFFICE NO. OF WINDOWS	ADV. RES. -1-	CURRENT RES.	
5	NO. OF SEATS	P/F No.1	P/F No.2	
		18	-	
6	WHETHER ENQUIRY OFFICE PROVIDED OR NOT	-		

S. No.	DESCRIPTION	AREA (Sq.m.)
1.	AREA OF PLATFORM SHELTER P/F No.1	-
2.	TOTAL AREA OF PLATFORM PLATFORM NO. 1	1099
3.	AREA OF WAITING ROOM I- UPPER CLASS WAITING ROOM II- AREA OF WAITING ROOM a- LADIES b- GENTS III- WAITING HALL	- - - - 11.43
4.	CIRCULATING AREA	-

REF.	FENCING	KUTCHA PUCCA	----- -----
	ROAD	METALLED UNMETALLED	=====

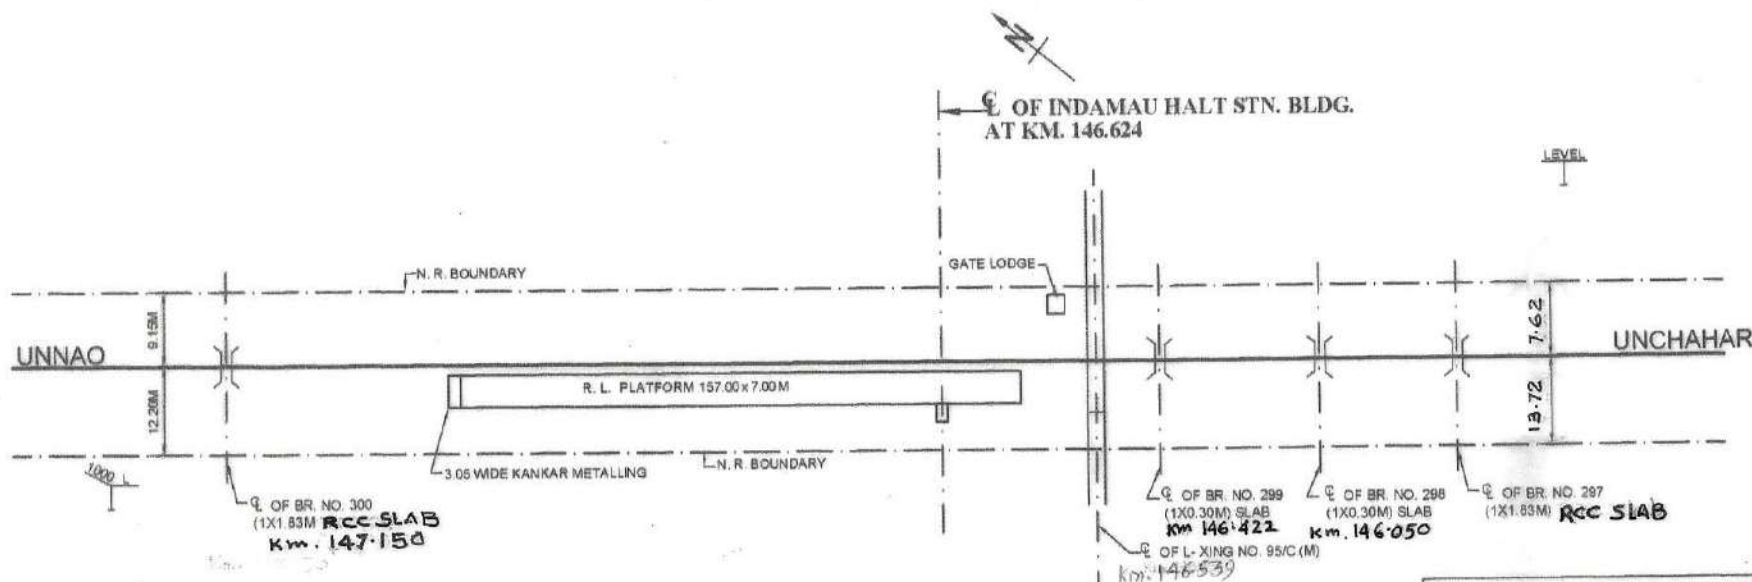


Sr. D.E.N.(II)							
ADEN/REL	Musciis						
CORRECTED UPTO	31-03-12	31-03-13	31-03-14	31-03-15	31-03-2016	31-03-2018	

NORTHERN RAILWAY LUCKNOW DIVISION	
PFM-UCR-ON SECTION	
DIAGRAM OF	
INDAMAU HALT STN: YARD	
R.L./M.S.L.	NOT TO SCALE
N.R. DIV L. SKETCH NO.	M-128/LKO/2012

CHECKED BY	S. S. L.
DRAWN BY	DAKSH

Handwritten signatures and dates are present at the bottom of the page, including 'S. S. L.', 'DAKSH', '31-03-12', '31-03-13', '31-03-14', '31-03-15', '31-03-2016', '31-03-2018', and 'March 16'.

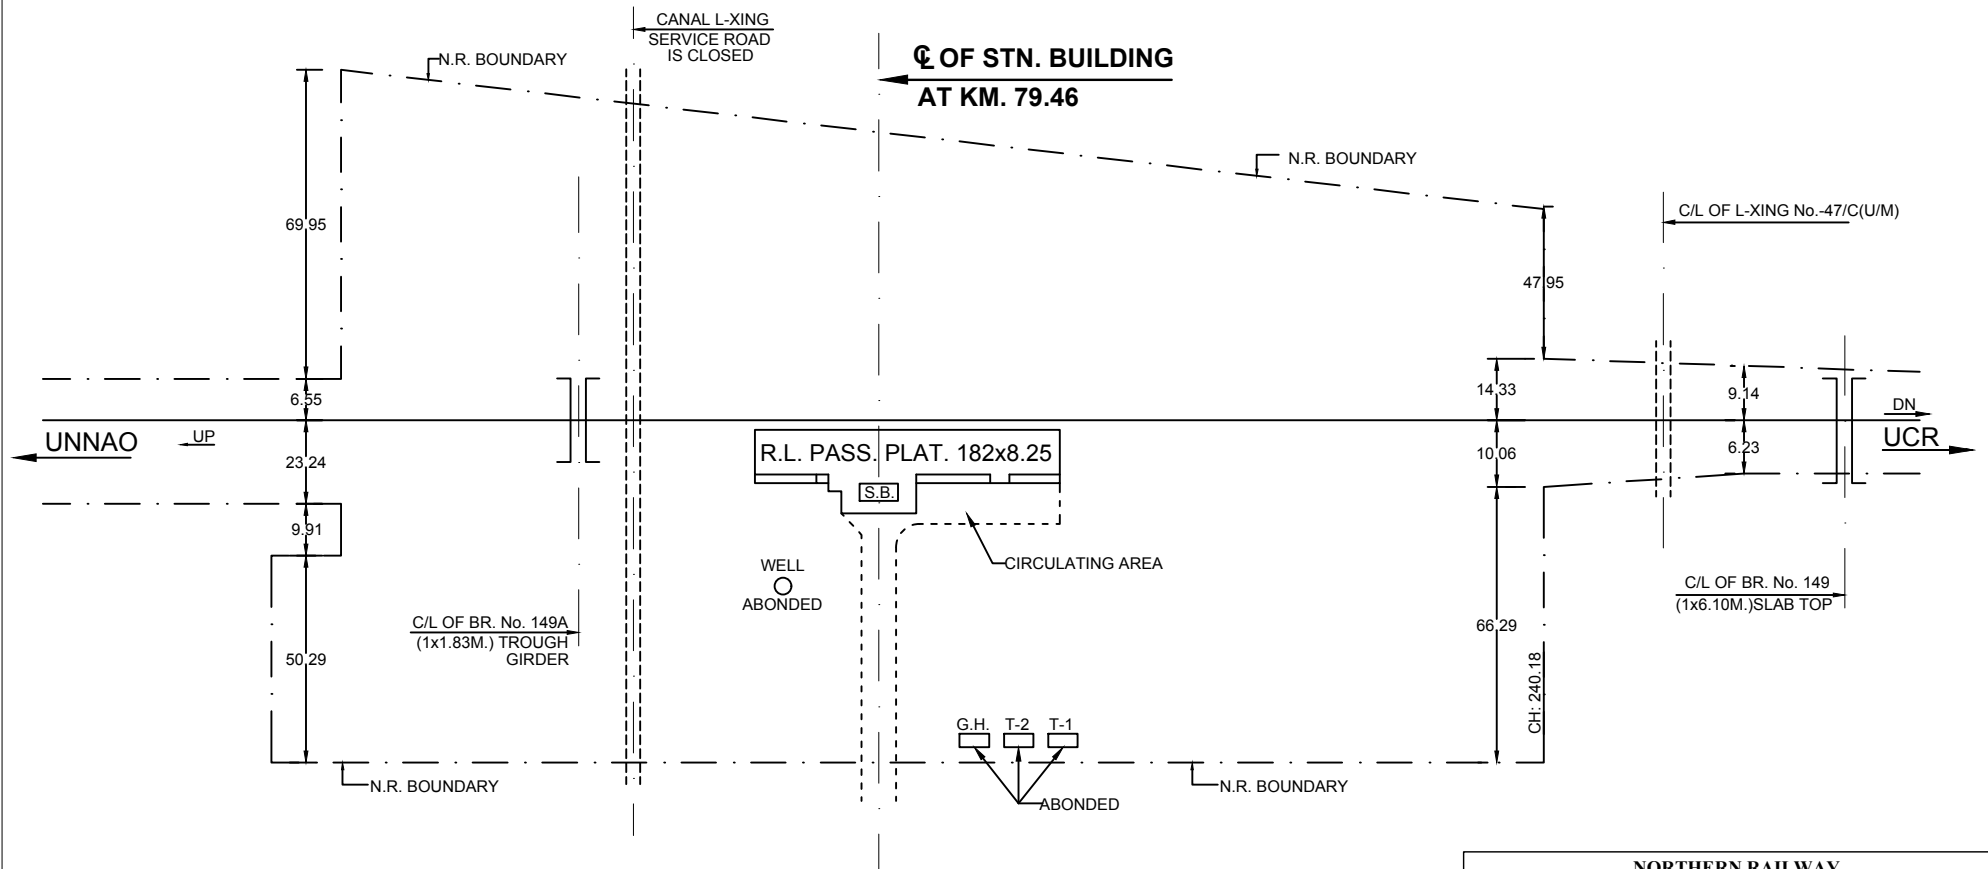

NORTHERN RAILWAY	
LUCKNOW DIVISION	
PFM-UCR-ON SECTION	
DIAGRAM OF	
ISHWARDASPUR STN. YARD	
R.L./M.S.L. 109.600M.	NOT TO SCALE
N.R. D.R.M. LKO. SKETCH NO.	311-06


CHECKED BY		Sr. DEN/(IV)					
		ADEN/PRG					
		CORRECTED UPTO	18-02-2020				

S. No.	DESCRIPTION	REMARKS		
1	LAVATORIES	LAV.	URINAL	
		LADIES	1	-
		GENTS	1	-
2	NO OF WATER TAPS/ HAND PUMPS ON EACH PLATFORM	P/F No.	TAPS	H.P.
		1	-	2
	SOURCE OF WATER SUPPLY	WELL		
3	YEAR OF CONSTRUCTION OF STATION BUILDING	-		
4	BOOKING OFFICE NO. OF WINDOWS	ADV. RES.	CURRENT RES.	
		1		
5	NO. OF SEATS	P/F No.1	P/F No.2	
		-		
6	WHETHER ENQUIRY OFFICE PROVIDED OR NOT	NIL		

S. No.	DESCRIPTION		AREA (Sq.m.)
1	AREA OF PLATFORM	P/F No.1	NIL
	SHELTER	P/F No.2	NIL
2	TOTAL AREA OF PLATFORM		
	PLATFORM NO. 1		2340
	PLATFORM NO. 2		-
3	AREA OF WAITING ROOM		
	I- UPPER CLASS WAITING ROOM		NIL
	II - AREA OF WAITING ROOM		
	a- LADIES		-
	b- GENTS		-
	III- WAITING HALL		2849
4	CIRCULATING AREA		-

S. No.	DESCRIPTION	AREA (Sq.m.)
1	AREA OF PLATFORM SHELTER	P/F No.1 P/F No.2 NIL NIL
2	TOTAL AREA OF PLATFORM	2340
	PLATFORM NO. 1	
	PLATFORM NO. 2	
3	AREA OF WAITING ROOM	NIL
	I- UPPER CLASS WAITING ROOM	
	II - AREA OF WAITING ROOM	
	a- LADIES b- GENTS	
	III- WAITING HALL	2849
4	CIRCULATING AREA	-

REF.	FENCING	KUTCHA PUCCA	----
	ROAD	METALLED UNMETALLED	=====

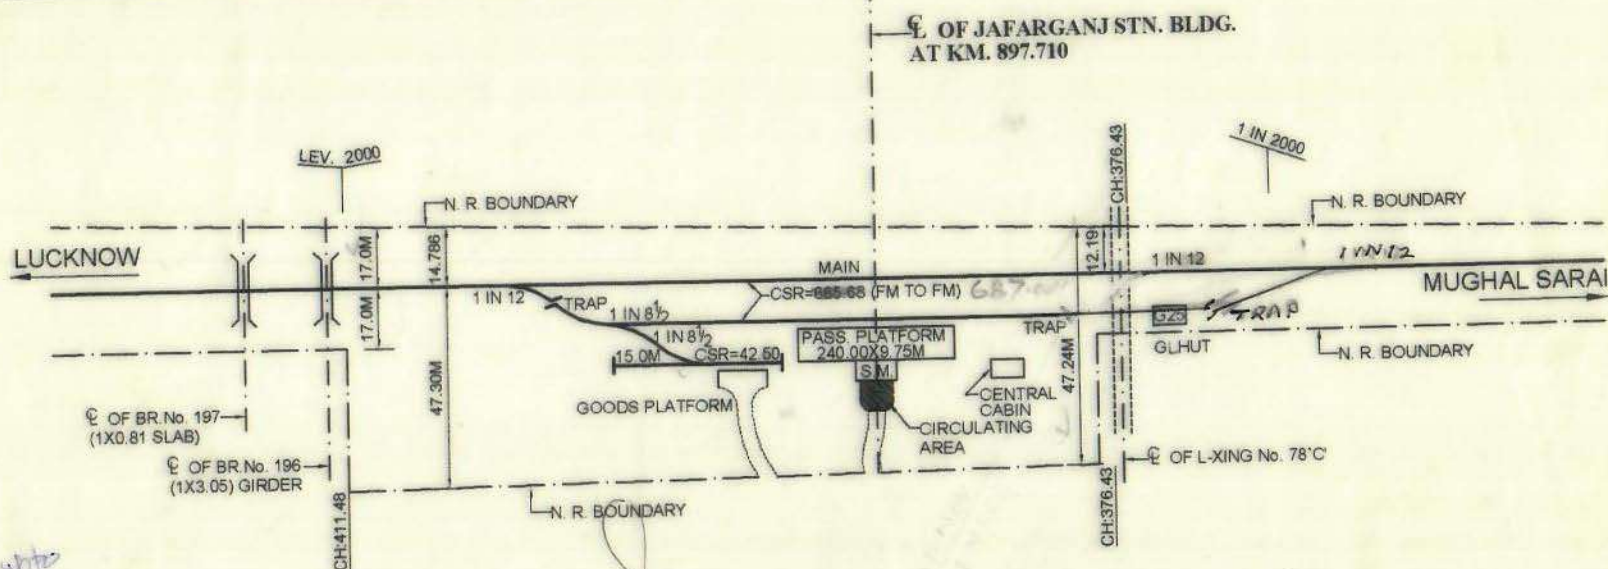

℄ OF JAFARGANJ STN. BLDG.
AT KM. 897.710

Corrected upto
31/3/2012
SSE/PHM/S/S
31-03-2013

SS/PHM/S/S
31-3-13
SSE/PHM/S/S
31-3-13

SS/PHM/S/S
31-3-13

CHECKED BY	DAKSH
DRAWN BY	281, 2ND FLOOR, LKH/RA/193AW RAJENDRA KUMAR, LKH/RA/193AW


Sr. D.E.N.(III)							
ADEN/JNU							
CORRECTED UPTO	31-03-12	31-3-13	31-3-2014	31-3-2015	31-3-2016	31-03-2018	

NORTHERN RAILWAY LUCKNOW DIVISION	
LKO-FD-BSB SECTION	
DIAGRAM OF JAFARGANJ STN: YARD	
R.L./M.S.L.	90.05M
NOT TO SCALE	
N.R. DIVL. SKETCH NO: M-205/LKO/2012	

JAGESHARGANJ STATION YARD



LEGEND:-	
EXISTING WORK	—
PROPOSED WORK	—
DISMANTLED WORK	—
FUTURE WORK	—

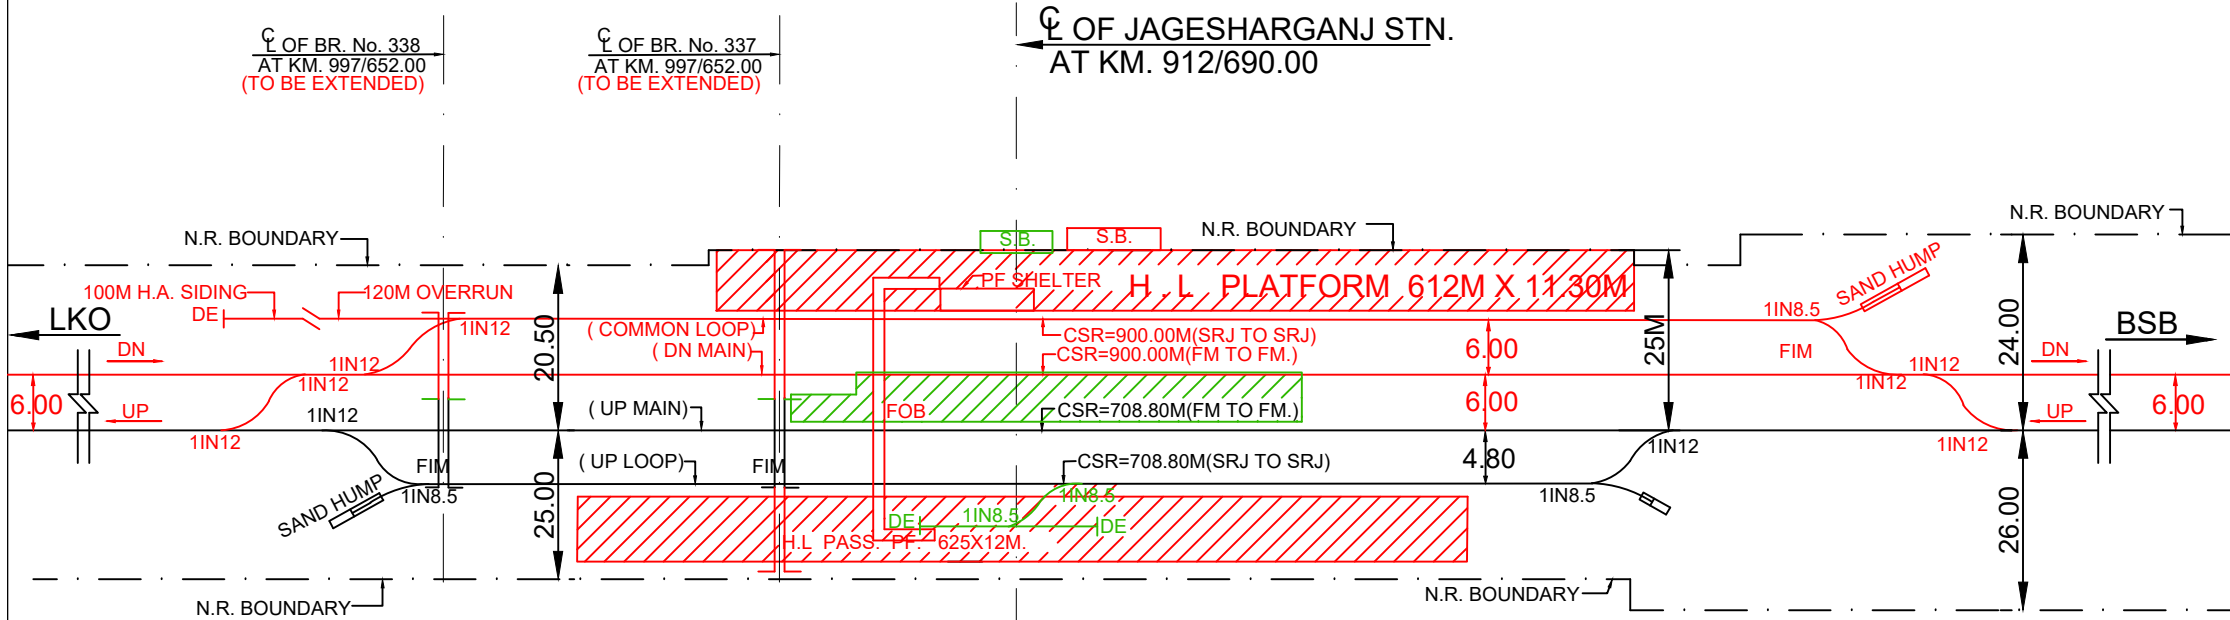

P.way work:

Sr.NO.	Name of Item	To be Dismantled	To be laid
1.	1 in 12 T/out	00	07
2.	1 in 8.5 T/out	02	01
3.	Trap	00	01
4.	Double Diamond	00	00
5.	Dead End	02	01
6.	Sand Hump	00	01
7.	Track (in KM)	1.50	3.50

Facility to be provided:

Sr.NO.	Facility
1.	New H.L. End PF no.1 (612mX11.30)
2.	New H.L. End PF no.2 (625mX12.00)
3.	New F.O.B 3m wide (To cover PF 1 to PF 2)
4.	One new line as line no. 1 with CSR 900m
5.	One 100m long track Hot Axle siding at Lucknow end.

Detail of traffic movement:

Sr.NO.	Movement	To Line no.
1.	From Lucknow	1 to 2
2.	From Varanasi	1 to 4

NORTHERN RAILWAY
LUCKNOW DIVISION
JAGESHARGANJ STATION YARD
AMETHI-JANGHAI DOUBLING (87 KM)

1. EXISTING WORK SHOWN THUS

2. PROPOSED WORK SHOWN THUS


3. DISMENTLING WORK SHOWN THUS



T.O	1 in 12		1 in 8.5			TRAP		DE	S
	L	R	L	R	SS	L	R		
EXISTING	1	1	-	-	1	-	-	-	
DISMANTLING	1	1	2	-	1	-	1	1	
PROPOSED	4	4	-	1	-	-	1	3	



JAIS STATION YARD

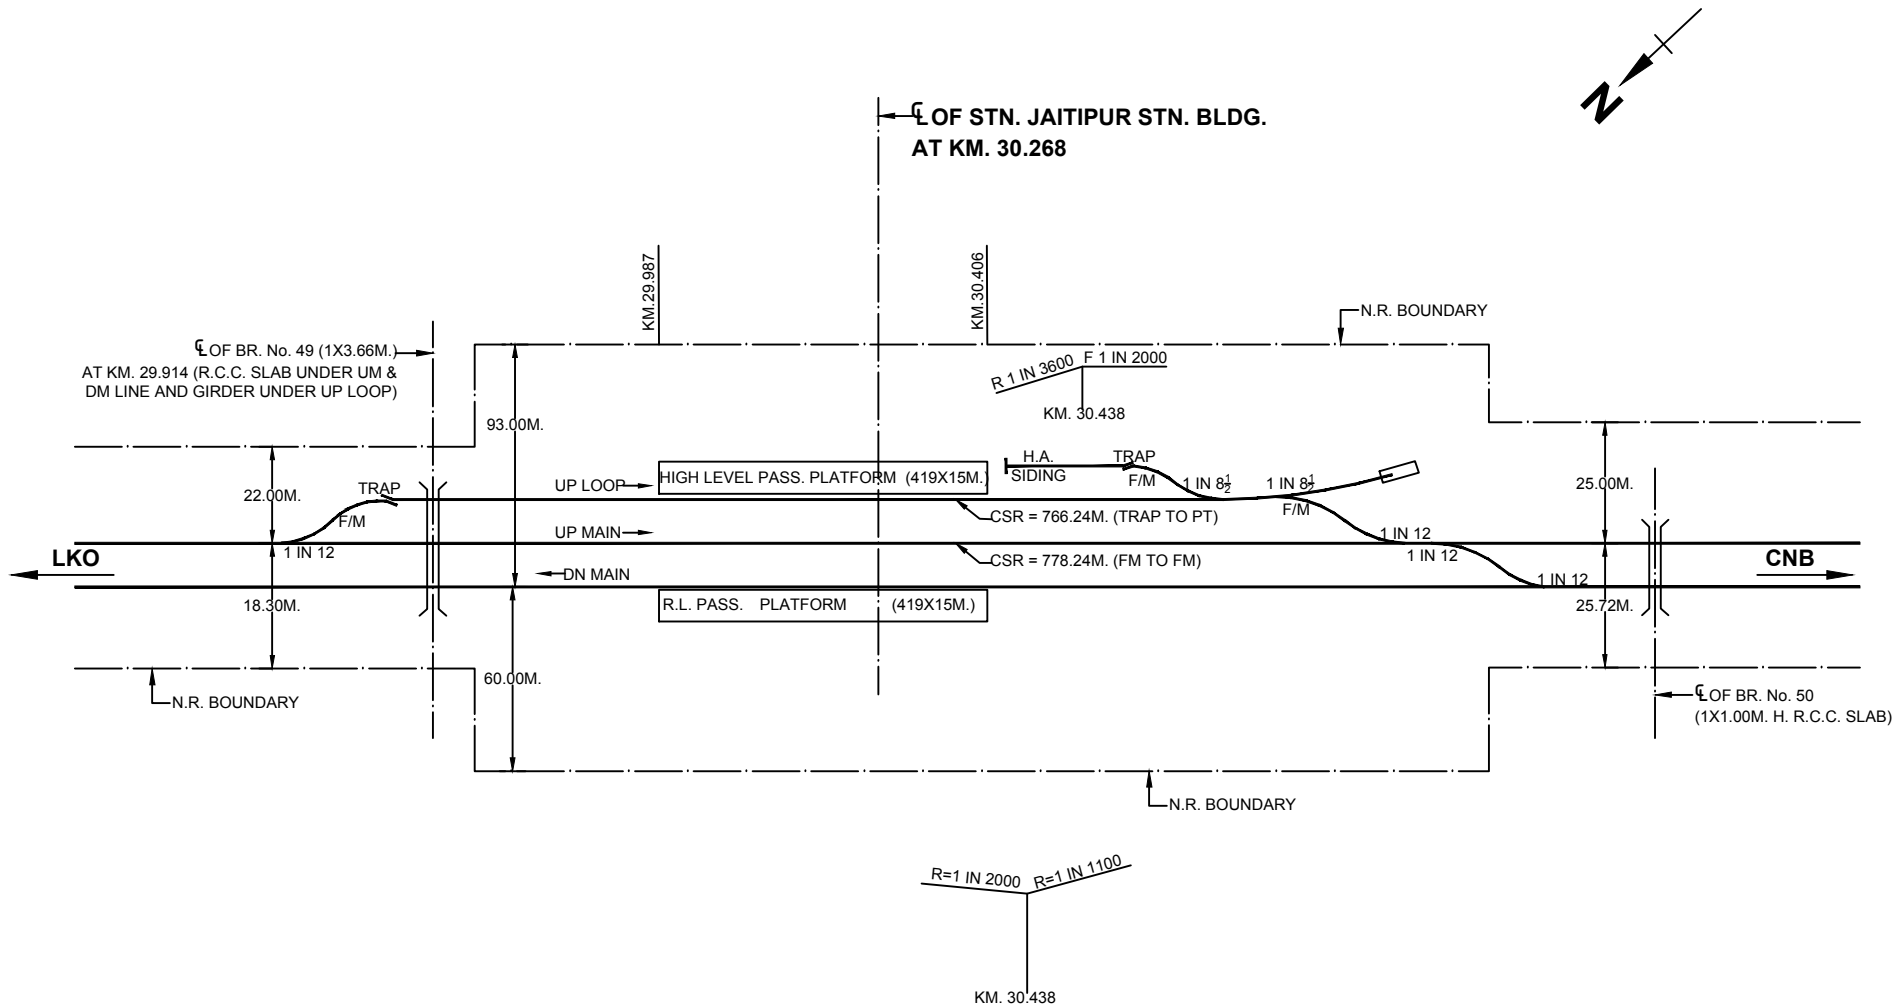


CHECKED BY	
DRAWN BY	

Sr. DEN/(V)					
ADEN/III/LKO					
CORRECTED UPTO	16-10-2020				

NORTHERN RAILWAY LUCKNOW DIVISION	
LKO-ON-CNB SECTION	
DIAGRAM OF	
JAIPUR STN: YARD	
R.L./M.S.L.	NOT TO SCALE
N.R. D.R.M. LKO. SKETCH NO.	



**C/L OF JALALPUR DHAI STN.
AT KM. 90.943**


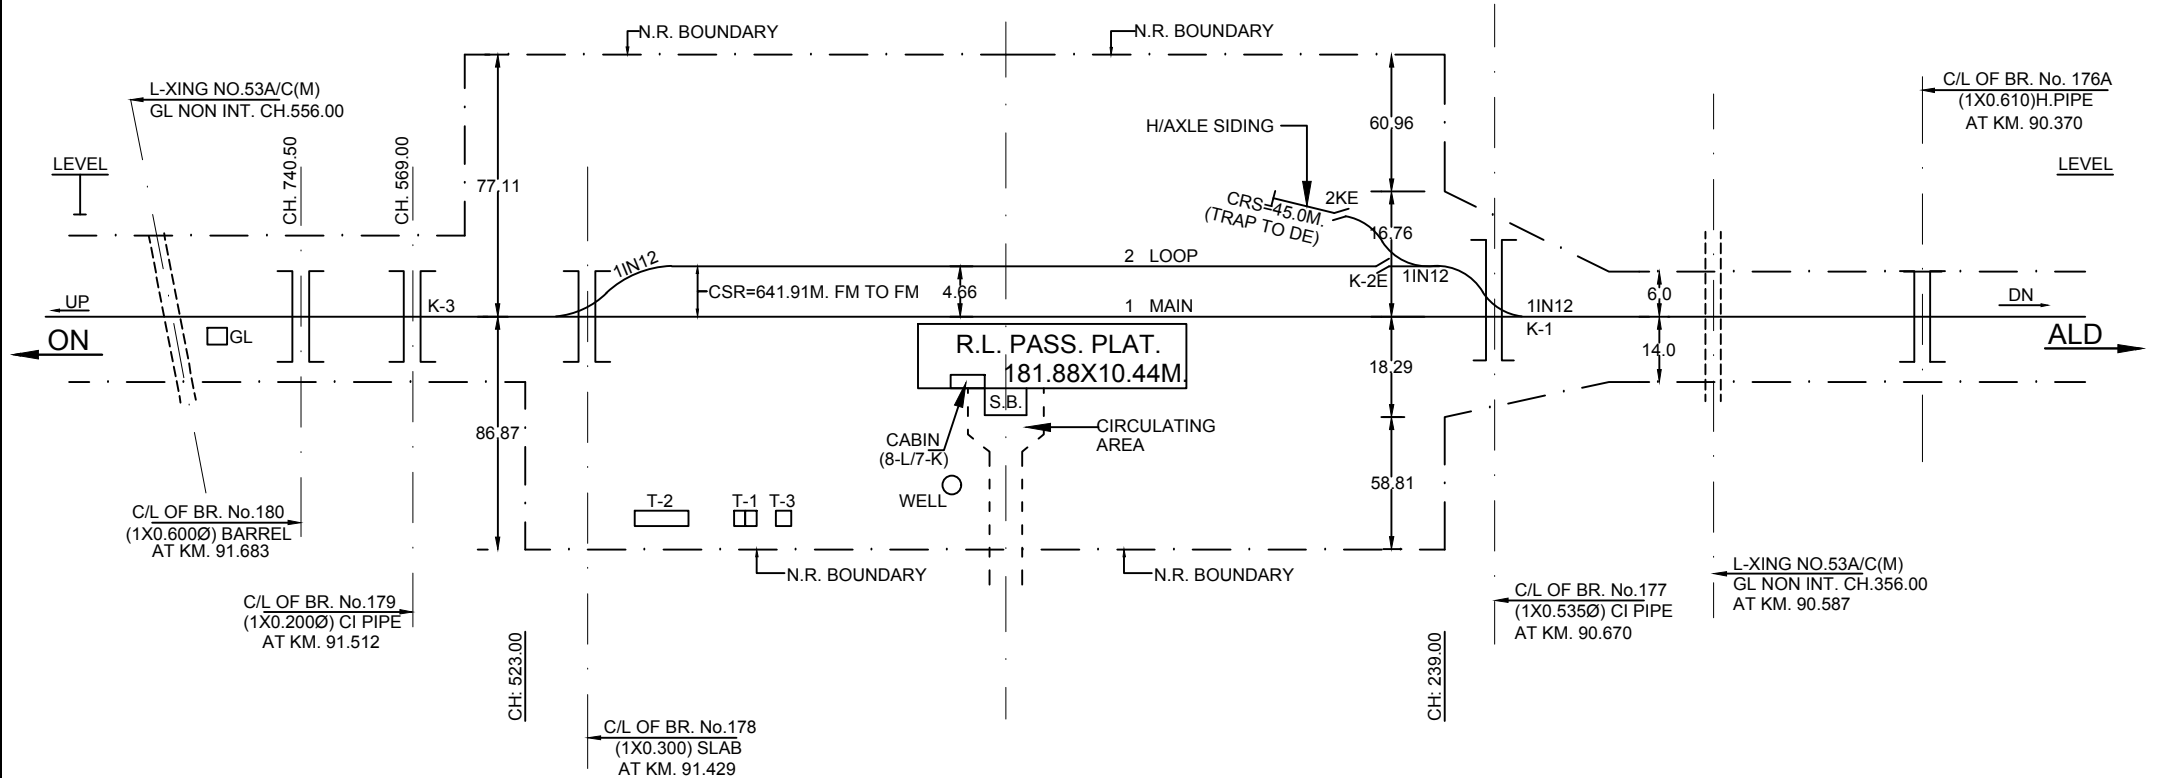


NORTHERN RAILWAY LUCKNOW DIVISION	
PFM-UCR-ON SECTION DIAGRAM OF JALALPUR DHAI STN. YARD	
R.L./M.S.L. 96.930m	NOT TO SCALE
N.R. D.R.M. LKO. SKETCH NO.	313-06

Sr. DEN/(IV)						
ADEN/PRG						
CORRECTED UPTO		18-02-2020				
CHECKED BY						
DRAWN BY						

YARD REMODELING AT JANGHAI RAILWAY STATION

LEGEND
DISMANTLING WORK
PROPOSED WORK
EXISTING WORK
LAND ACQUISITION
NOT TO SCALE

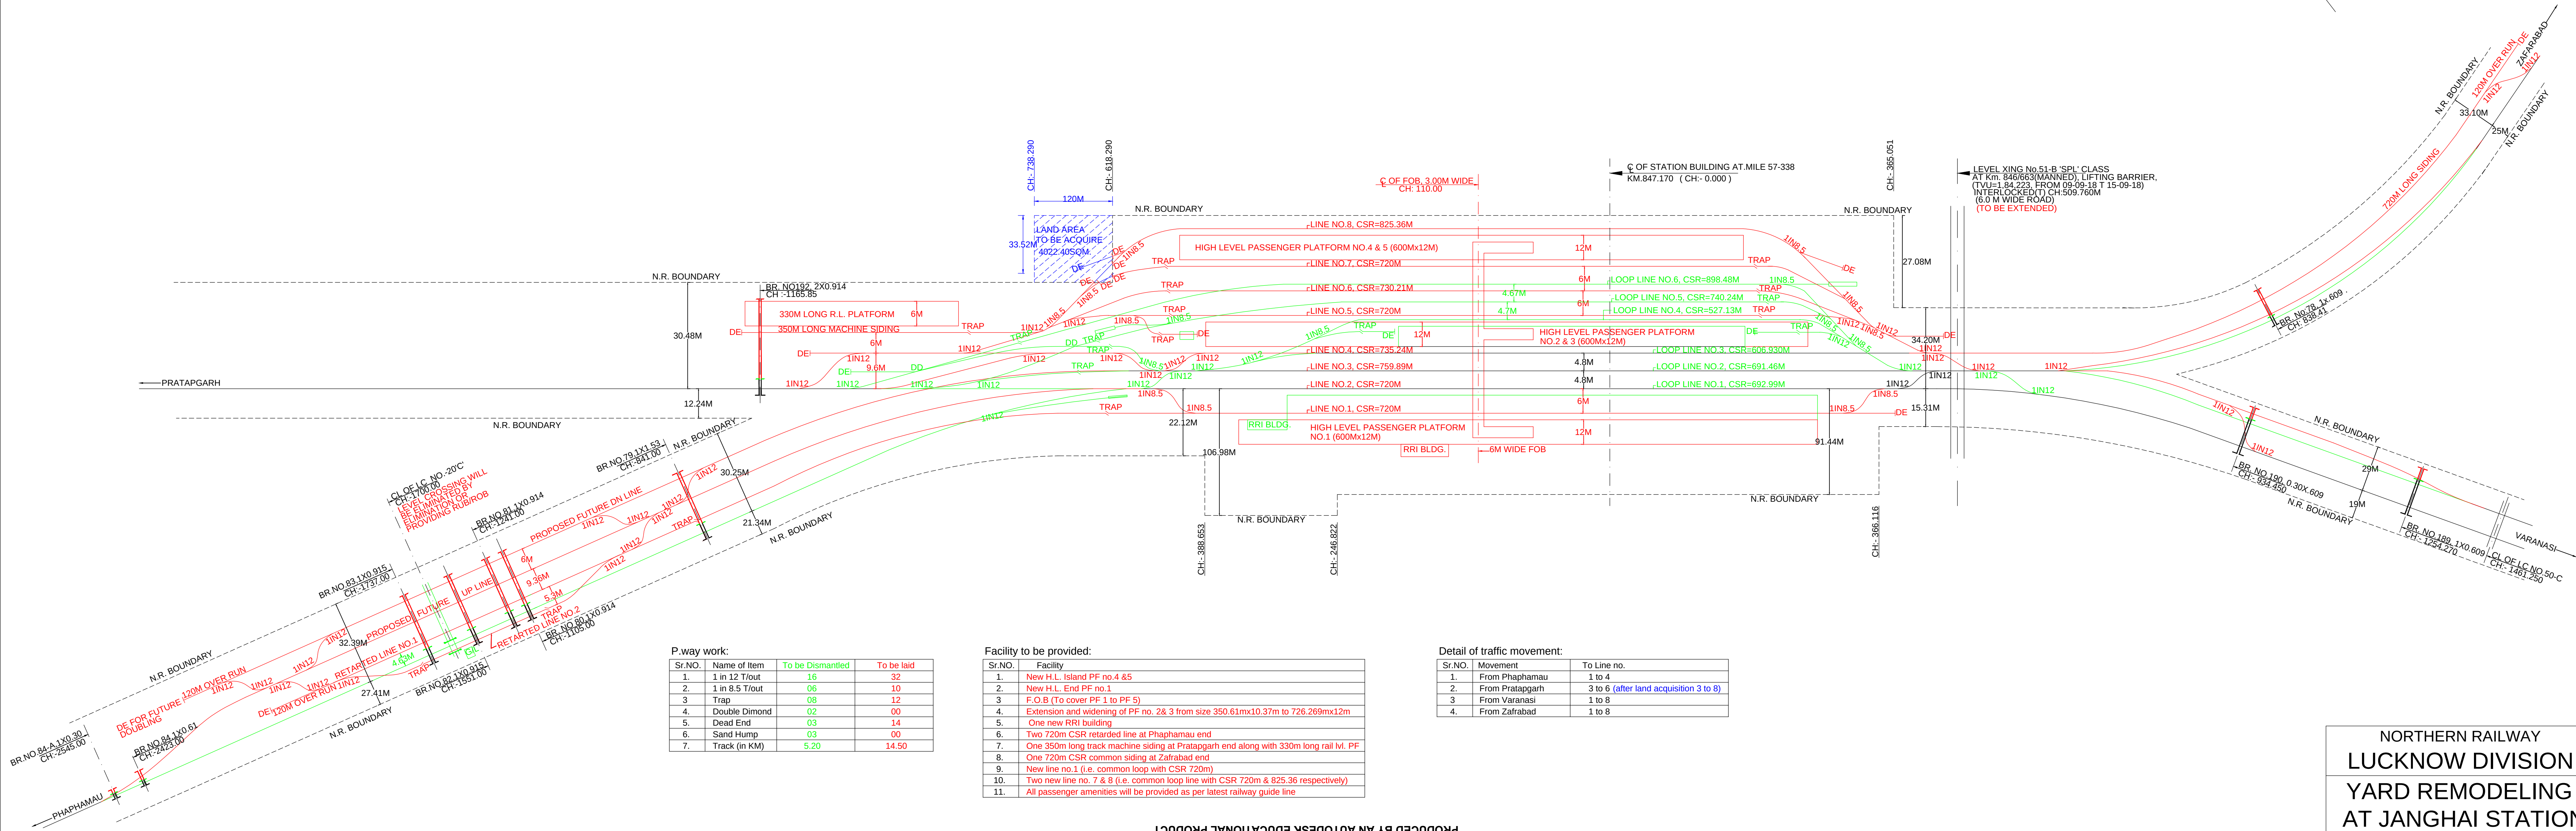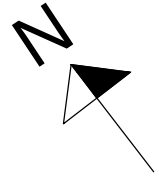

P.way work:

Sr.NO.	Name of Item	To be Dismantled	To be laid
1.	1 in 12 T/out	16	32
2.	1 in 8.5 T/out	06	10
3.	Trap	08	12
4.	Double Diamond	02	00
5.	Dead End	03	14
6.	Sand Hump	03	00
7.	Track (in KM)	5.20	14.50

Facility to be provided:


Sr.NO.	Facility
1.	New H.L. Island PF no.4 &5
2.	New H.L. End PF no.1
3.	F.O.B (To cover PF 1 to PF 5)
4.	Extension and widening of PF no. 2& 3 from size 350.61mx10.37m to 726.269mx12m
5.	One new RRI building
6.	Two 720m CSR retarded line at Phaphamau end
7.	One 350m long track machine siding at Pratapgarh end along with 330m long rail lvl. PF
8.	One 720m CSR common siding at Zafrabad end
9.	New line no.1 (i.e. common loop with CSR 720m)
10.	Two new line no. 7 & 8 (i.e. common loop line with CSR 720m & 825.36 respectively)
11.	All passenger amenities will be provided as per latest railway guide line

Detail of traffic movement:

Sr.NO.	Movement	To Line no.
1.	From Phaphamau	1 to 4
2.	From Pratapgarh	3 to 6 (after land acquisition 3 to 8)
3.	From Varanasi	1 to 8
4.	From Zafrabad	1 to 8

NORTHERN RAILWAY
LUCKNOW DIVISION
YARD REMODELING
AT JANGHAI STATION

S.No	DESCRIPTION	REMARKS			S.No	DESCRIPTION	AREA (sq. m)
		LAV.	URINAL				
1	LAVATORIES	2	1		1	AREA OF P.F. SHELTER	—
2	NO. OF WATER TAPS/HAND PUMPS ON R.P.	2	1		2	TOTAL AREA OF P.F. NO. 1	1289
3	YEAR OF CONSTRUCTION OF STATION BUILDING				3	AREA OF WAITING ROOM (U) UPPER CLASS W/ROOM (L) AREA OF WAITING ROOM (L) - LADIES (G) - GENTS (H) WAITING MALL	30
4	BOOKING OFFICE NO. OF WINDOWS	ADV. RES.	CURRENT		4	CIRCULATING AREA	128
5		P.F. NO. 1	W/HALL	TOTAL			
6	WEATHER ENQUIRY OFFICE PROVIDED	NOT					

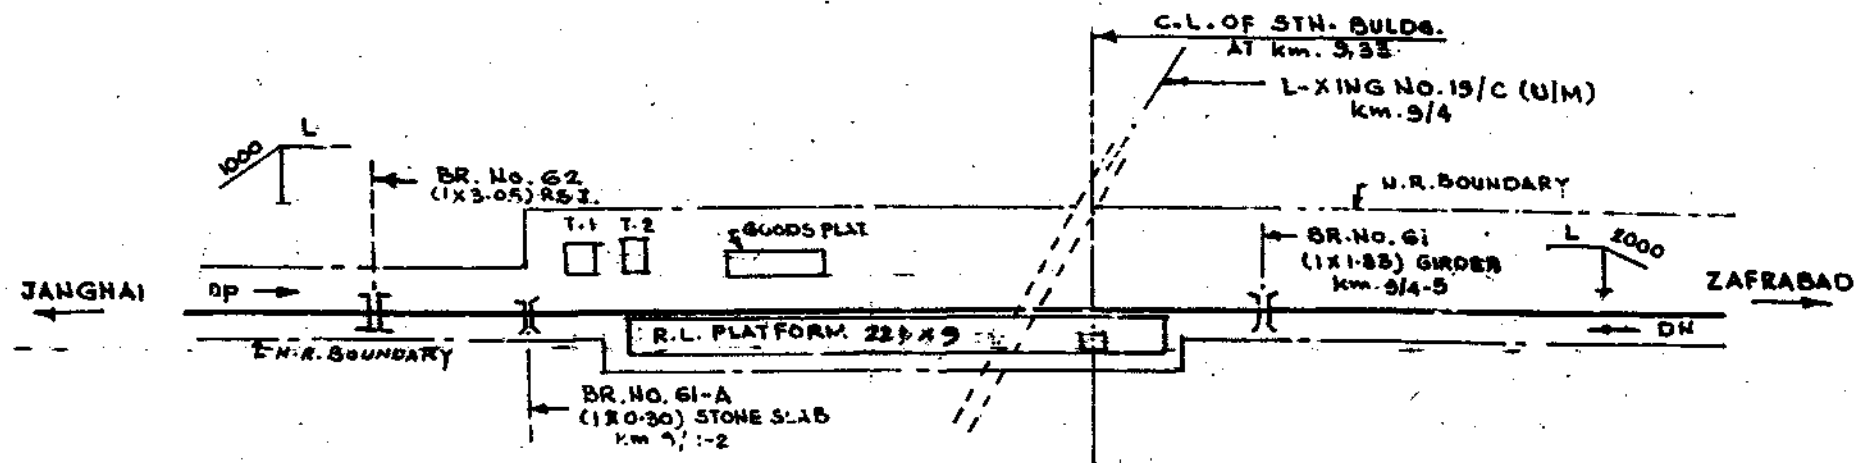

ADEN/RBH

NORTHERN RAILWAY
LUCKNOW DIVISION


ALD-JNH-ZBD SECTION
DIAGRAM OF
JARAUNA STATION YARD

R.L./M.S.L. NOT TO SCALE
N.R. DRAWING LKO SKETCH NO.

DR. GEN-X
CORRECTED

21.5.10

REF.		
FENCING	{ KUTCHA PUCCA	----- -----
ROAD	{ METALLOD UNMETALLOD	=====

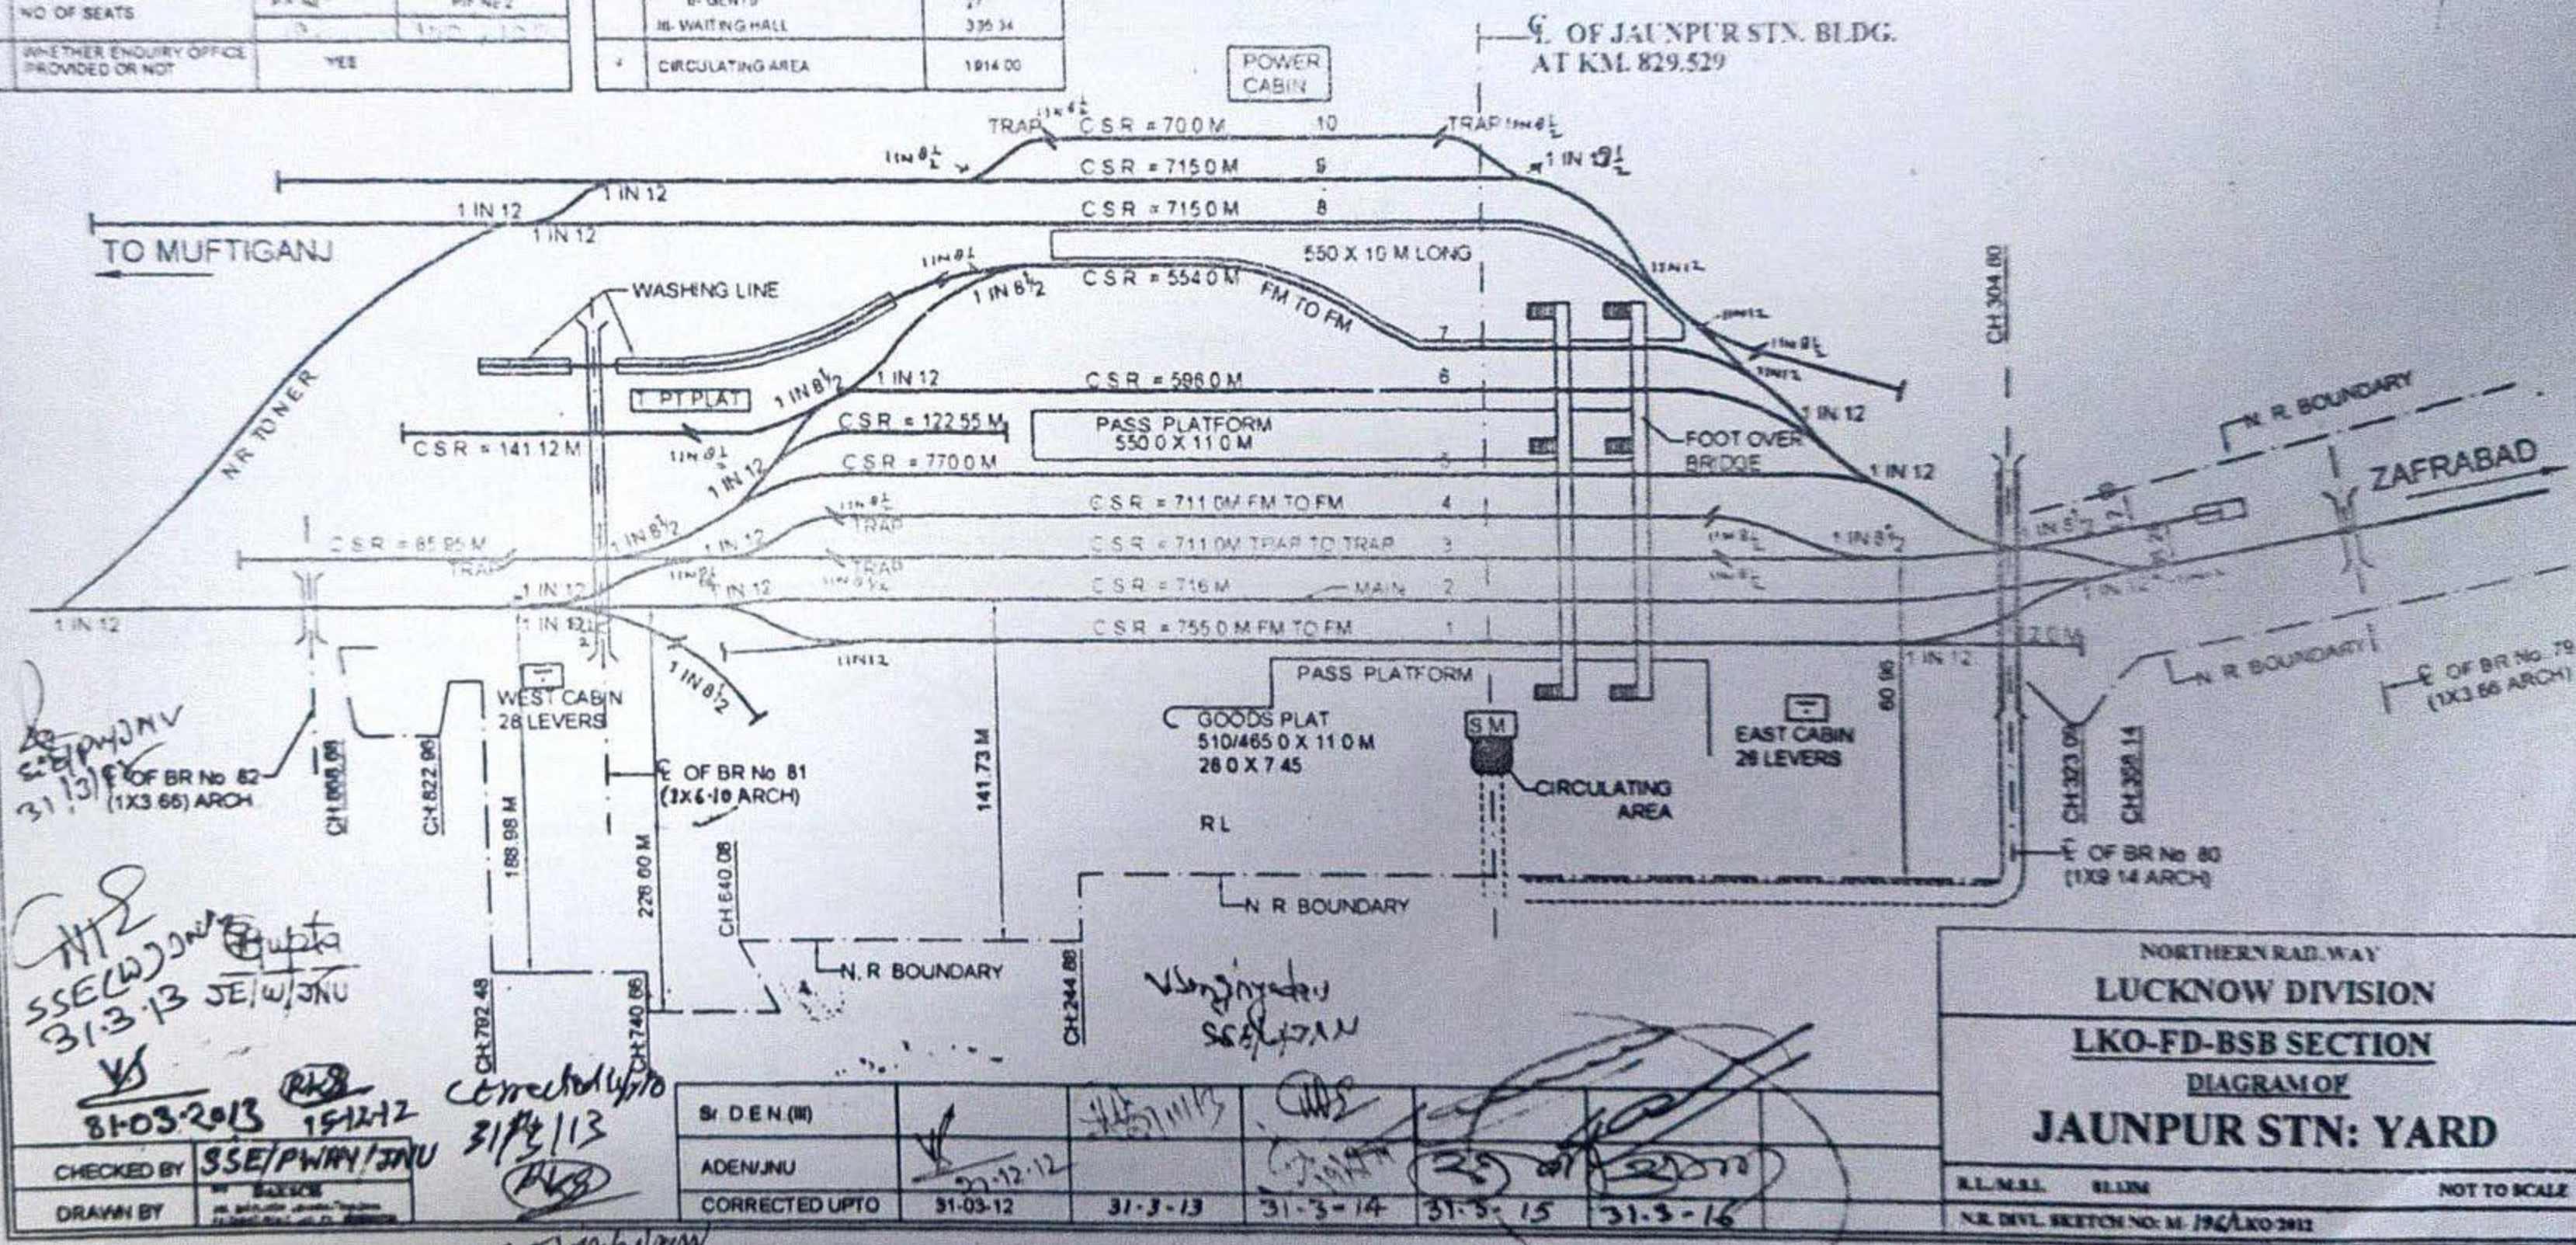


S. No.	DESCRIPTION	REMARKS		
1	LAVATORIES		LAV.	URINAL
		LADIES	-	-
		GENTS	-	-
2	NO OF WATER TAPS/ HAND PUMPS ON EACH PLATFORM	P/F No.	TAPS	H.P.
		1	-	1
		2	-	-
	SOURCE OF WATER SUPPLY	OPEN WELL =1		
3	YEAR OF CONSTRUCTION OF STATION BUILDING	-----		
4	BOOKING OFFICE NO. OF WINDOWS	ADV. RES.		CURRENT
		-		1
5	NO. OF SEATS	P.F. 1	P.F. 2	W / HALL
		-	-	-
6	WHETHER ENQUIRY OFFICE PROVIDED OR NOT	NOT		

S. No.	DESCRIPTION	AREA (Sq.m.)
1.	AREA OF PLATFORM SHELTER P/F No.1 P/F No.2 }	67.65
2.	TOTAL AREA OF PLATFORM	
	PLATFORM NO. 1	1810.00
	PLATFORM NO. 2	1780.00
3.	AREA OF WAITING ROOM	
	I- UPPER CLASS WAITING ROOM	-----
	II - AREA OF WAITING ROOM	-----
	a- LADIES	26.00
	b- GENTS	
	III- WAITING HALL	99.00
4.	CIRCULATING AREA	52.78

S. No.	TYPES OF QUATERS	Nos.
1	TYPE -I	-----
2	TYPE -II	-----
3	TYPE -III	-----
4	TYPE -IV	-----

S. No.	SOURCE OF WATER SUPPLY	CAPACITY

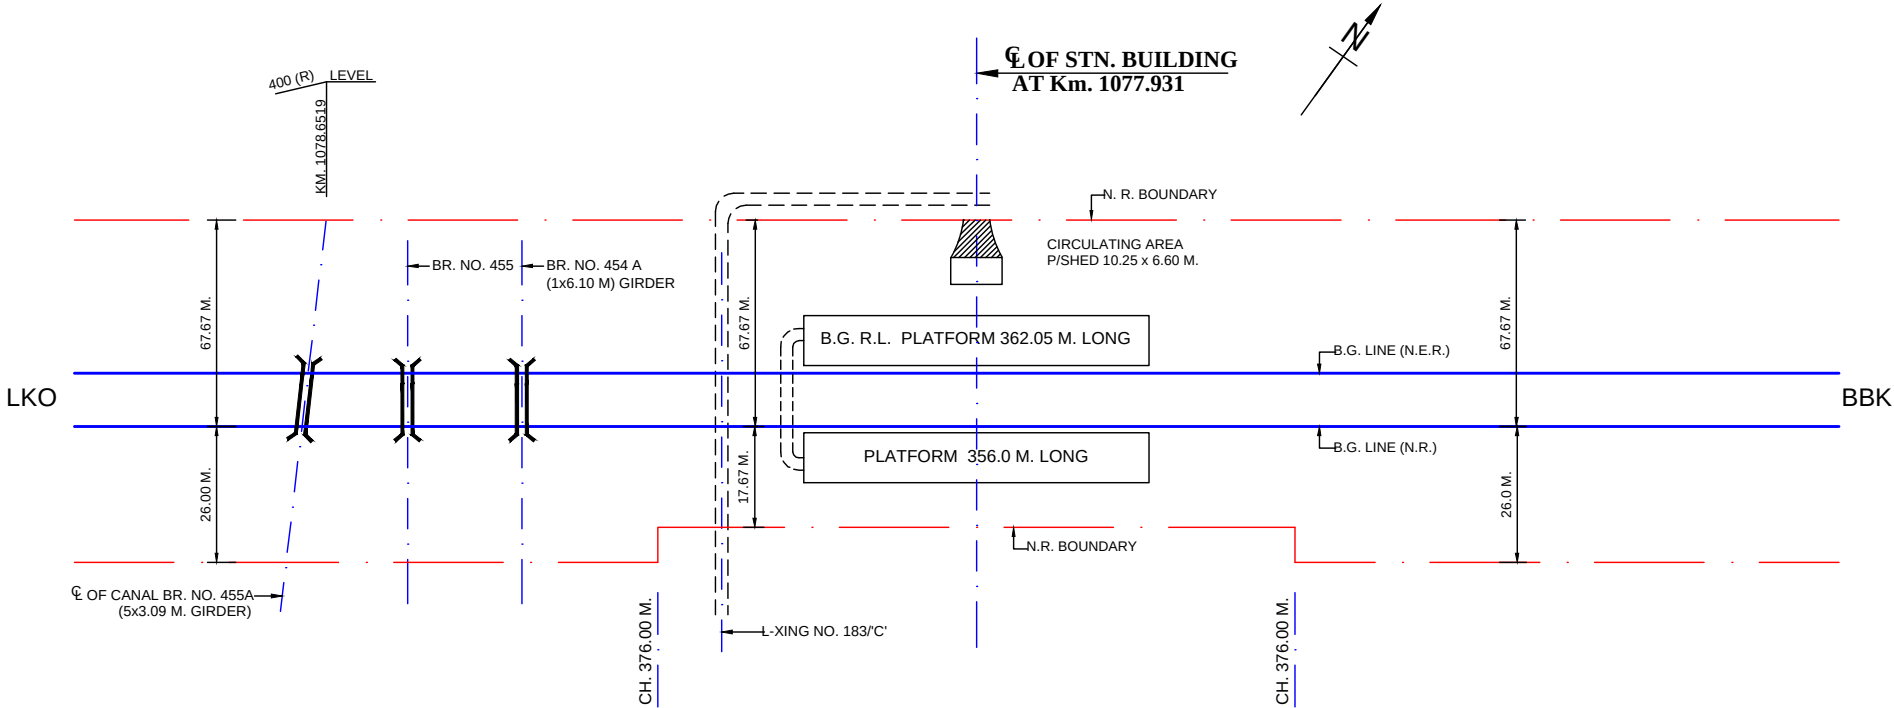

NORTHERN RAILWAY
LUCKNOW DIVISION

LKO -FD-BSB SECTION
DIAGRAM OF
JUGAUR STN : YARD

R.L./M.S.L. -----NOT TO SCALE

N.R. D.R.M. LKO. SKETCH NO. -----

CHECKED BY		Sr. D.E.N.(V)				
DRAWN BY	M/S DAKSCH 255, 2nd FLOOR, LEKHRAJ KHAZANA, FAIZABAD ROAD, LKO, Ph. 9335902736	CORRECTED UPTO	31-12-06			

S. No.	DESCRIPTION	REMARKS
1	LAVATORIES	LAV. ☐ URINAL ☐
2	NO. OF WATER TAPS/ HAND PUMPS ON EACH PLATFORM	P/F No. ☐ TAPS ☐ H.P. ☐
3	SOURCE OF WATER SUPPLY	
4	YEAR OF CONSTRUCTION OF STATION BUILDING	
5	BOOKING OFFICE NO. OF WINDOWS	ADV. RES. ☐ CURRENT RES. ☐
6	NO. OF SEATS	P/F No.1 ☐ P/F No.2 ☐
7	WHETHER ENQUIRY OFFICE PROVIDED OR NOT	NOT

S. No.	DESCRIPTION	AREA (sq. m.)
1	AREA OF PLATFORM SHELTER	P/F No.1 ☐ P/F No.2 ☐
2	TOTAL AREA OF PLATFORM PLATFORM NO. 1 PLATFORM NO. 2	744.00
3	AREA OF WAITING ROOM I- UPPER CLASS WAITING ROOM II- AREA OF WAITING ROOM a- LADIES b- GENTS III- WAITING HALL	11.46
4	CIRCULATING AREA	NIL


REF.	FENCING	ROAD
	KUTCHA PUCCA	METALLED UNMETALLED




ADEN/PBH FEASIBILITY CHECKED
 CHECKED BY ☐ ADEN/PBH
 DRAWN BY ☐ ADEN/PBH

Sr. D.E.N. (II)	31-3-20/2	31-3-11	31-3-12
CORRECTED UPTO			

NORTHERN RAILWAY
 LUCKNOW DIVISION
 ALD-JNH-JNU SECTION
 DIAGRAM OF
 KAJGAON STN: YARD
 R.L./M.S.L. NOT TO SCALE
 N.R. D.R.M. LKO. SKETCH NO.

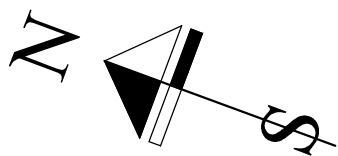


CL OF KANKAHA STN. BLDG. Km:1044.550
CH: 0.00

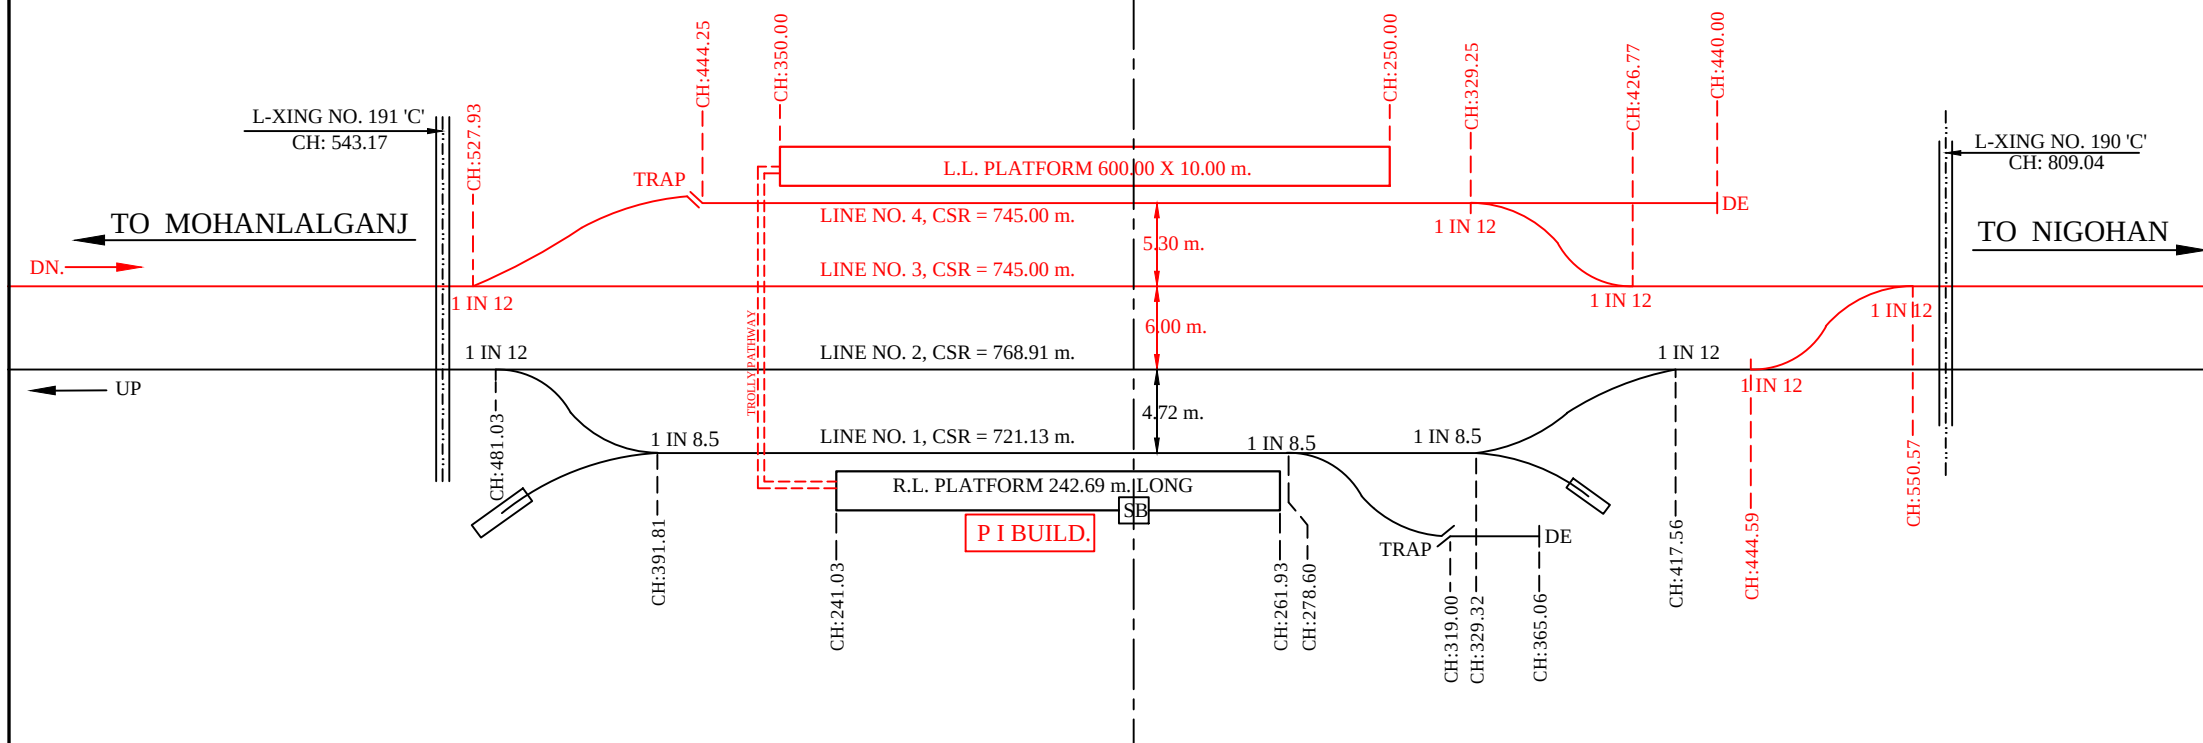

LEGEND:-

1. EXISTING WORK SHOWN THUS ———
2. PROPOSED WORK SHOWN THUS ———
3. DISMENTLING WORK SHOWN THUS ———
4. THIS DRAWING IS NOT TO SCALE


S.No	DESCRIPTION	1 in 12	1 in 8½	TRAP
1.	DISMANTLING OF TURN OUT	0	0	0
2.	INSERTION OF TURN OUT	5	0	1

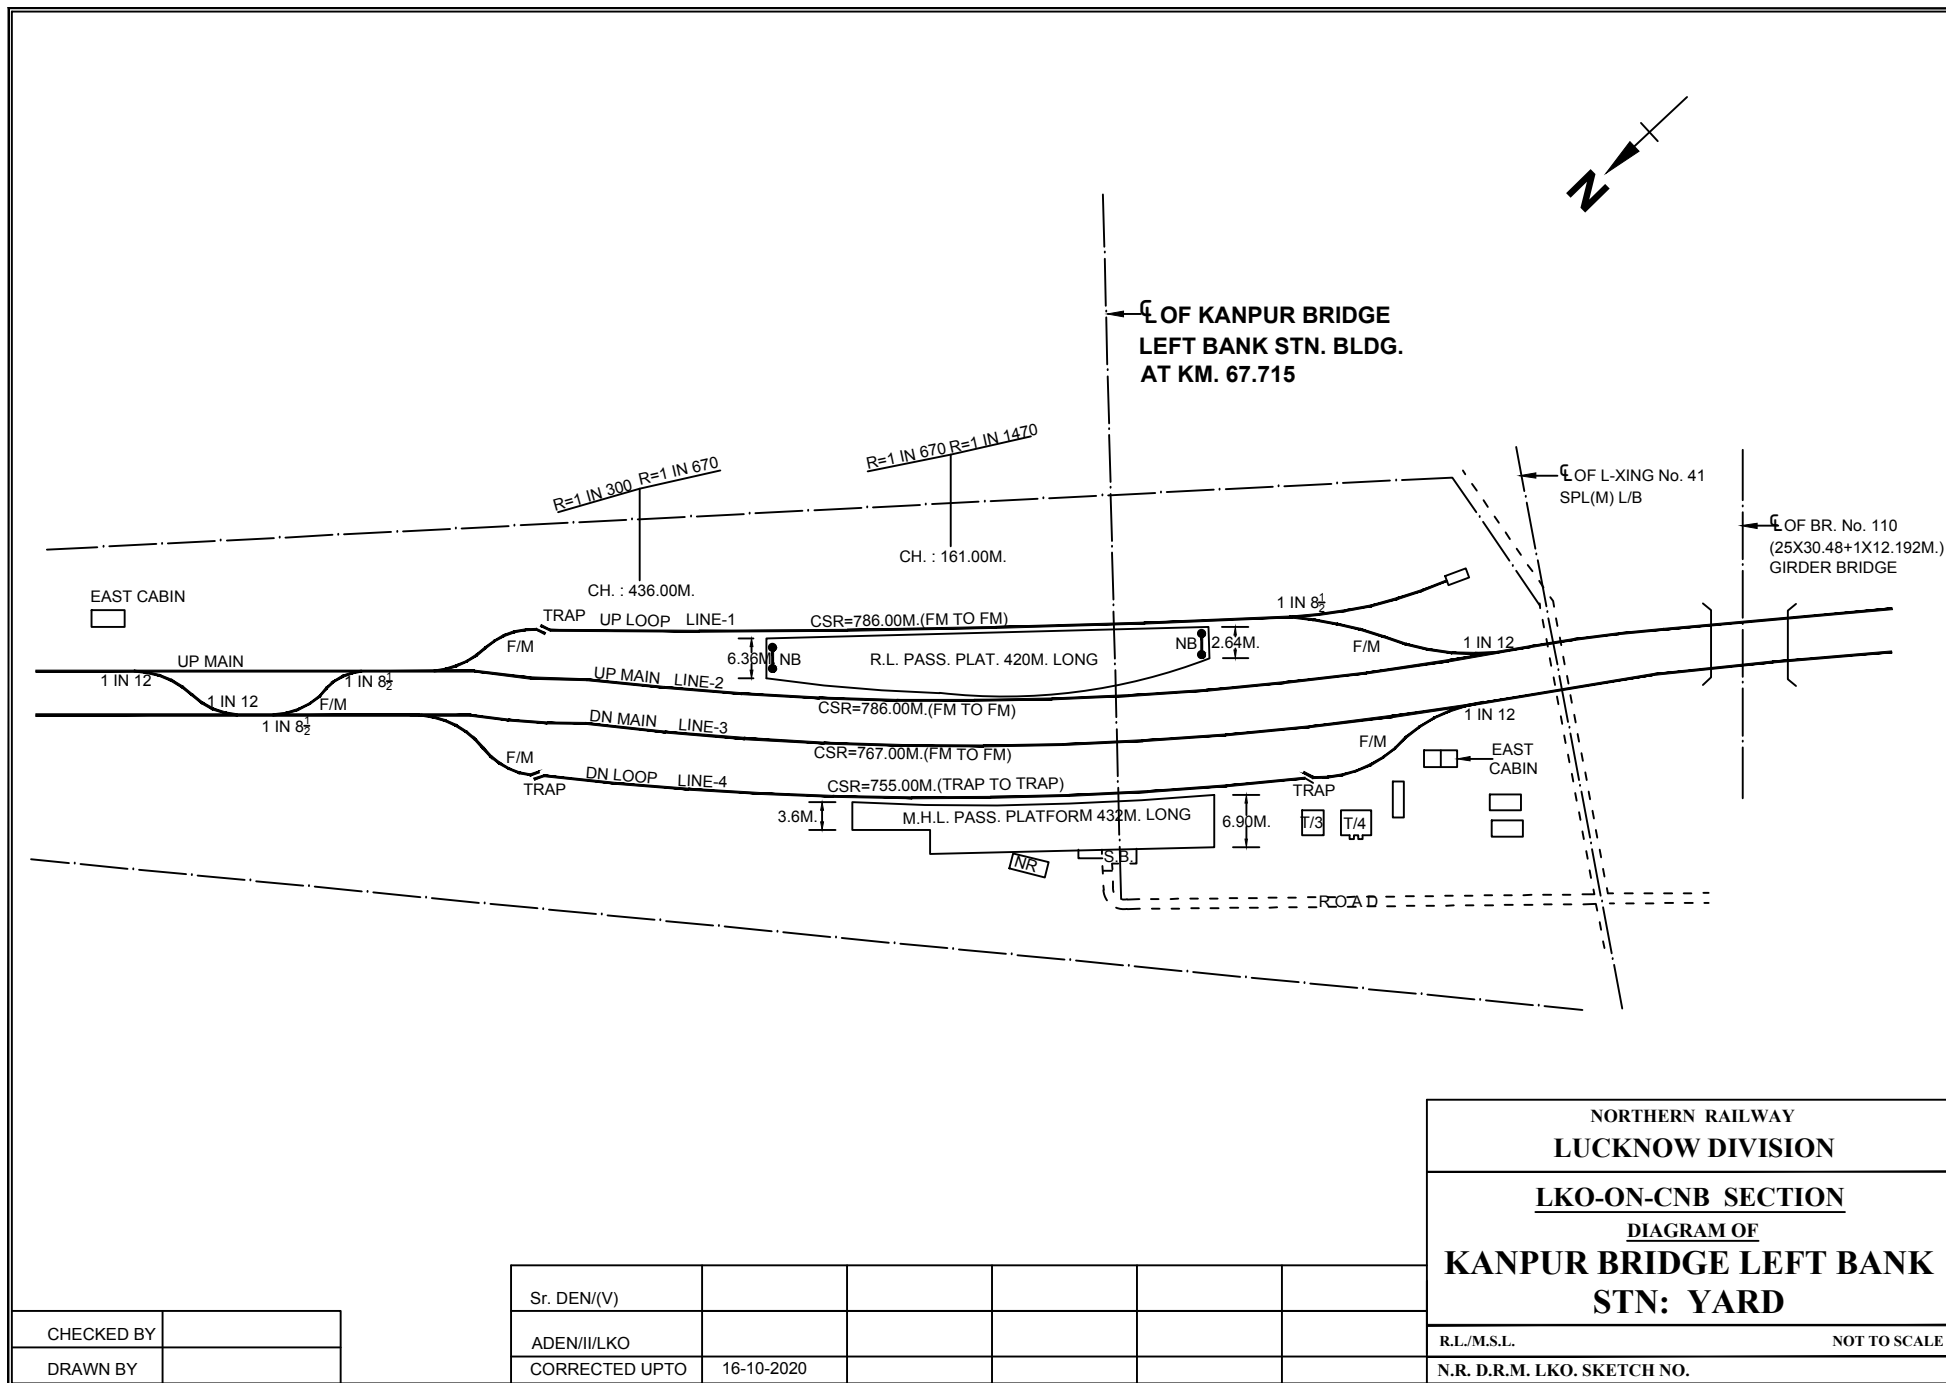

NORTHERN RAILWAY	
LUCKNOW DIVISION	
LKO-ON-CNB SECTION	
DIAGRAM OF	
KANPUR BRIDGE LEFT BANK	
STN: YARD	
R.L./M.S.L.	NOT TO SCALE
N.R. D.R.M. LKO. SKETCH NO.	

CHECKED BY		Sr. DEN/(V)					
DRAWN BY		ADEN/III/LKO					
		CORRECTED UPTO	16-10-2020				

KAPSETHI STATION
NOT TO SCALE

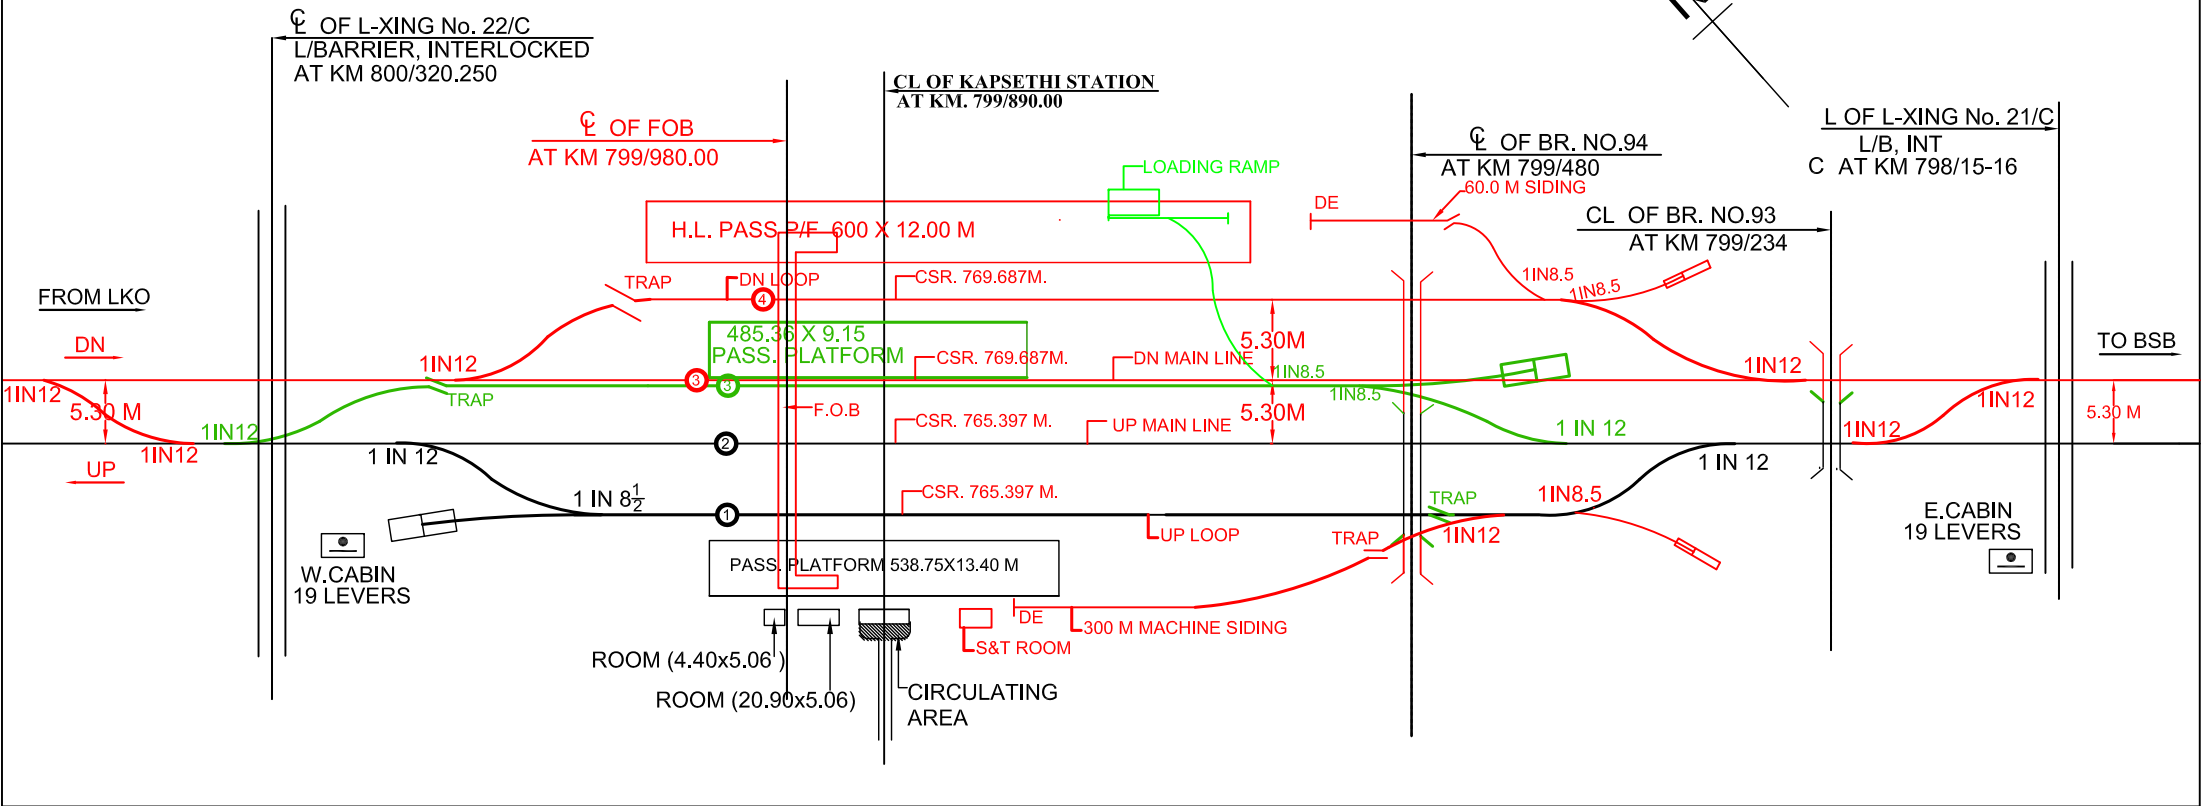


S. No.	DESCRIPTION	REMARKS		
1	LAVATORIES		LAV.	URINAL
		LADIES	3	1
		GENTS	4	
2	NO OF WATER TAPS/ HAND PUMPS ON EACH PLATFORM	P/F No.	TAPS	H.P.
		1	12	-
		2 & 3	16	
	SOURCE OF WATER SUPPLY	3		
3	YEAR OF CONSTRUCTION OF STATION BUILDING	-		
4	BOOKING OFFICE NO. OF WINDOWS	ADV. RES.	CURRENT RES.	
		-	1	
5	NO OF SEATS	P/F No.1	P/F No.2 & 3	
		60	68	
6	WHETHER ENQUIRY OFFICE PROVIDED OR NOT			
7	BORE WELL	2		
8	WATER TROLLEY/ WATER HUT	-		
9	WATER - COOLER	1		

S. No.	DESCRIPTION	AREA (sq.m.)
1	AREA OF PLATFORM SHELTER	P/F No.1 1795.0
		P/F No.2 680.0
2	TOTAL AREA OF PLATFORM	
	PLATFORM NO. 1	3612
	PLATFORM NO. 2 & 3	3661.60
	PLATFORM NO. 4	2039.84
3	AREA OF WAITING ROOM	NIL
	I- UPPER CLASS WAITING ROOM	
	II - AREA OF WAITING ROOM	
	a- LADIES	86 m ²
	b- GENTS	
	III- WAITING HALL	350 & 370
4	CIRCULATING AREA	1786

REF.	FENCING	KUTCHA PUCCA	----
	ROAD	METALLED UNMETALLED	=====

CORRECTED UP TO 31-03-2018

ADEN/BSB SR-DEN-III

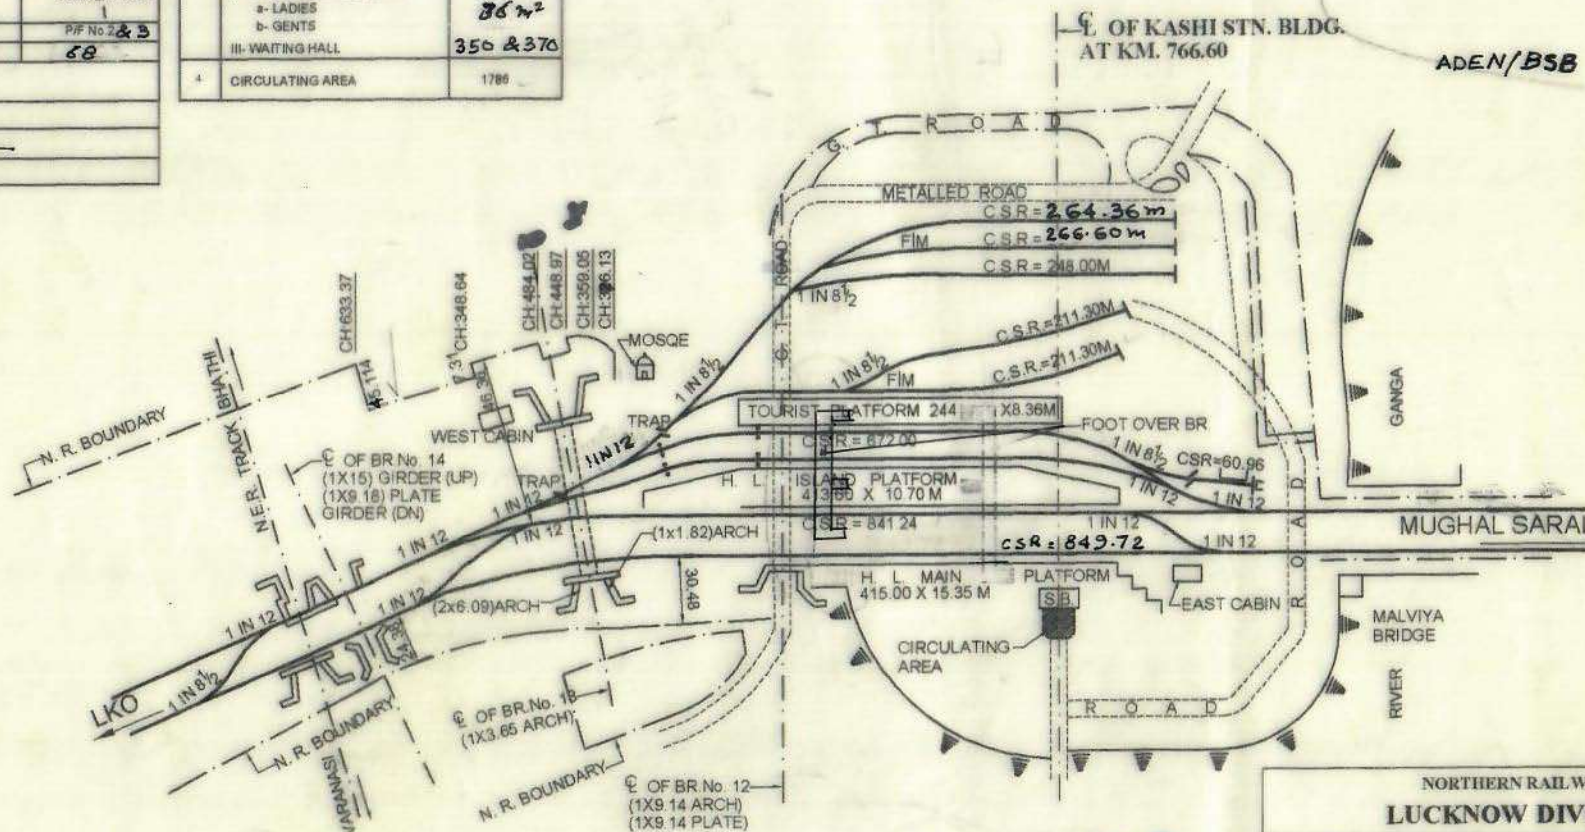

NORTHERN RAILWAY	
LUCKNOW DIVISION	
LKO-PBH-MGS SECTION	
DIAGRAM OF	
KASHI STN: YARD	
R.L./M.S.L.	83.39M
NOT TO SCALE	
N.R. DIVL. SKETCH NO: M.186 LKO 2012	

CHECKED BY	DAKSCH
DRAWN BY	285, 3RD FLOOR, SEVEN HILLS, NEW DELHI, 110016

DEN (III)					
ADEN/BSB					
CORRECTED UPTO	31-03-12	31-3-2013	31-3-2014	31-3-15	31-3-2016


LEGEND:-

1. EXISTING WORK SHOWN THUS 
2. PROPOSED WORK SHOWN THUS 
3. DISMENTLING WORK SHOWN THUS 

CL OF KASIMPUR HALT STN. BLDG.

AT Km. 964.208

CH: 0.000

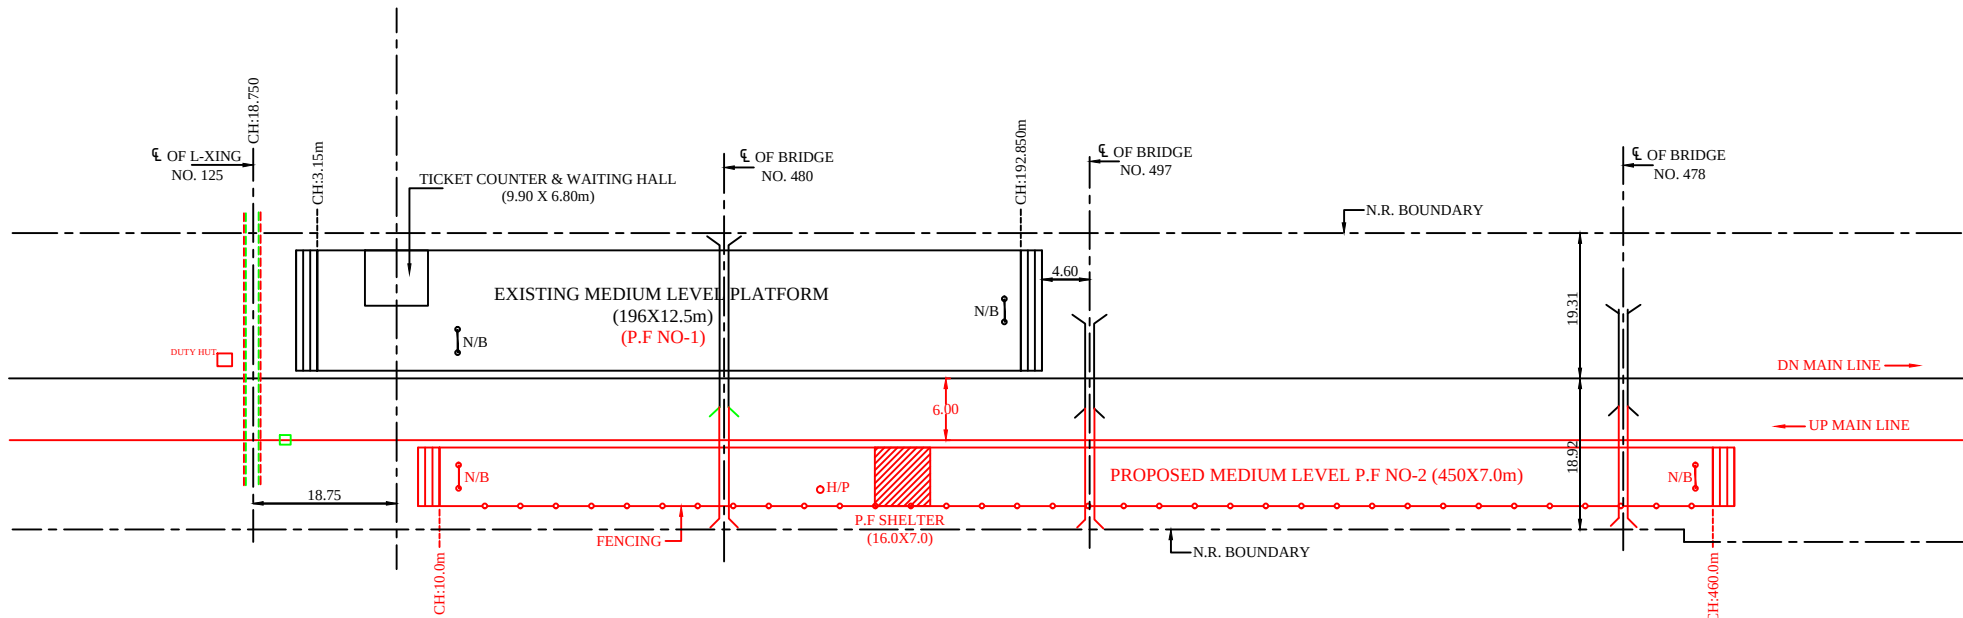

SCALE:- THIS DRAWING IS NOT TO SCALE

N.R.DRM.LKO. SKETCH No 108/2000

NOTE:-

- 1. LAVATORIES:-
a) No of SEATS (LADIES & GENTS FLUSHED) OR DRY. LADIES=12 APVY GENTS=1
- 2. No of WATER TAPS/HAND PUMPS ON EACH PLATFORM AND SOURCE OF WATER SUPPLY. H.P=2+2=4 WELL=1
- 3. YEAR OF CONSTRUCTION OF THE STATION BUILDING -
- 4. BOOKING OFFICE
a) No of WINDOWS 1
- 5. WHETHER ENQUIRY OFFICE PROVIDED OR NOT. NOT

S.No	DESCRIPTION	SQ.M.
1.	AREA OF PLATFORM SHELTERS:- I. ON PLATFORM No 1 II. ON " " No 2	- 24
2.	TOTAL AREA OF PLATFORM I. PLATFORM No 1 II. PLATFORM No 2	1417.5 M 2655.0 M
3.	AREA OF WAITING ROOM I. UPPER CLASS (LADIES) (GENTS) II. WAITING HALL	- 25.00 25.00
4.	CIRCULATING AREA	-

REF:-


FENCING

ROAD

- KUTCHA -----
- PUCCA -----
- METALLED =====
- UNMETALLED =====


CORRECTED UP TO 31.3.2000

DSE(T)/N.R.LKO

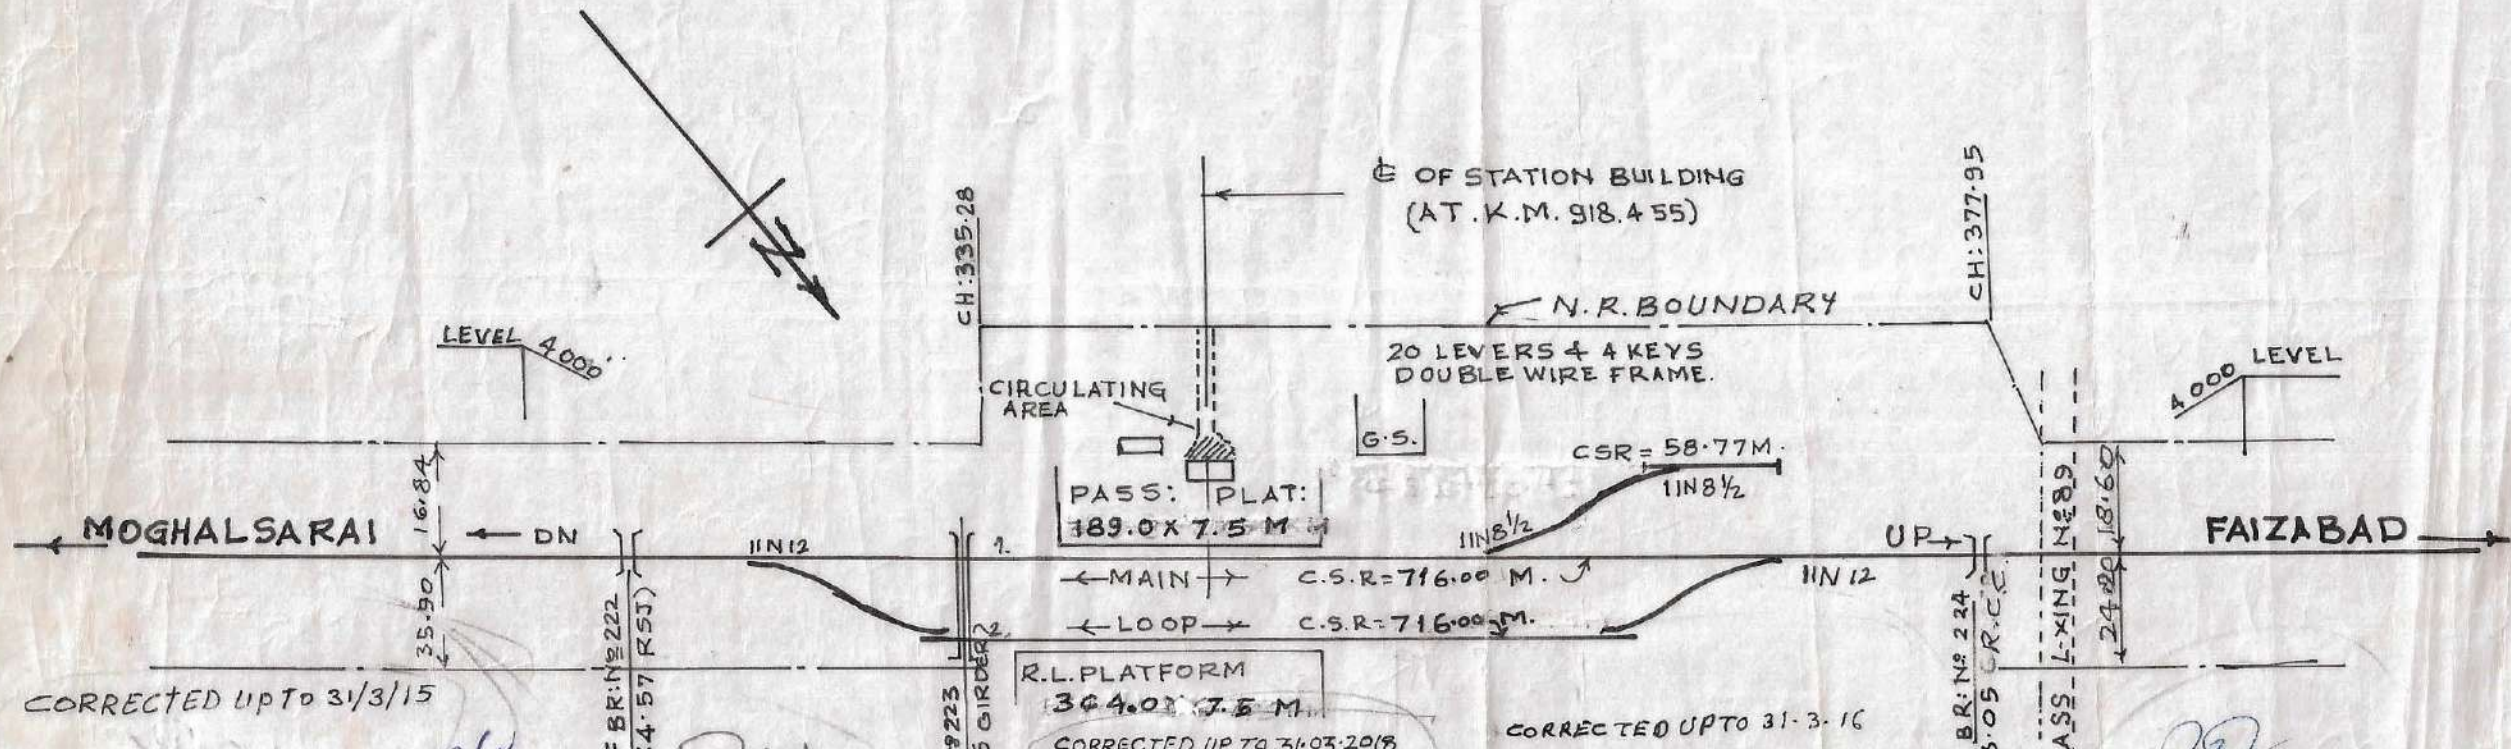

ADEN/FD		DEN-V		ADEN-FD		ADEN/FD		SR.DEN-V		ADEN-FD		SR.DEN-V	
31-3-2010		31-3-2011		31-3-2012		31-3-2013				31-3-2014		31-03-2009	
DEN-V		DEN-V		DEN-V		DEN-V		M.R. BOUNDARY		DEN-V		DEN-V	
S.S.E.		S.S.E.		CORRECTED UP TO		31-3-2001		31-3-2002		31-3-2003		31-3-2004	
TRACED		TRACED		DSE(T)/LKO		31-3-2005		31-3-2006		31-3-2007		31-3-2008	
CHECKED		S.E.V				31-3-2009		31-3-2010		31-3-2011		31-3-2012	

NORTHERN. RAILWAY.
LUCKNOW. DIVISION.
LKO-FD-BSB. SECTION
DIAGRAM. OF
KATAHARI. STN: YAR
ML. RSL=92.81
NOT TO SC.

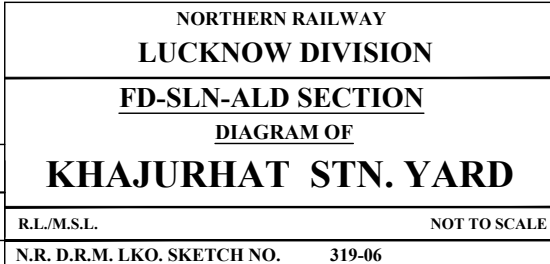


CHECKED BY	
DRAWN BY	

ADEN/PRG		Sr.DEN/(IV)			
CORRECTED UPTO	18-02-2020				

S. No.	DESCRIPTION	REMARKS			S. No.	DESCRIPTION	AREA (Sq. m.)
1	LAVATORIES	LAV.	URINAL		1	AREA OF PLATFORM SHELTER	P/F No.1 160.0 P/F No.2 NIL
		LADIES	1	-			
		GENTS	-	1			
2	NO OF WATER TAPS/HAND PUMPS ON EACH PLATFORM	P/F No.	TAPS	H.P.	2	TOTAL AREA OF PLATFORM	
		1	4	2		PLATFORM NO. 1	3873.20
		2	6	1		PLATFORM NO. 2	3999.5
3	SOURCE OF WATER SUPPLY	-			3	AREA OF WAITING ROOM	
3	YEAR OF CONSTRUCTION OF STATION BUILDING	-				I- UPPER CLASS WAITING ROOM	NIL
4	BOOKING OFFICE NO. OF WINDOWS	ADV. RES.	CURRENT RES.			II - AREA OF WAITING ROOM	
5	NO OF SEATS	P/F No.1	P/F No.2			a- LADIES	NIL
		- 30	21			b- GENTS	NIL
						III- WAITING HALL	42
6	WHETHER ENQUIRY OFFICE PROVIDED OR NOT	NIL			4	CIRCULATING AREA	44.45

REF.	FENCING	KUTCHA PUCCA	----
	ROAD	METALLED UNMETALLED	=====

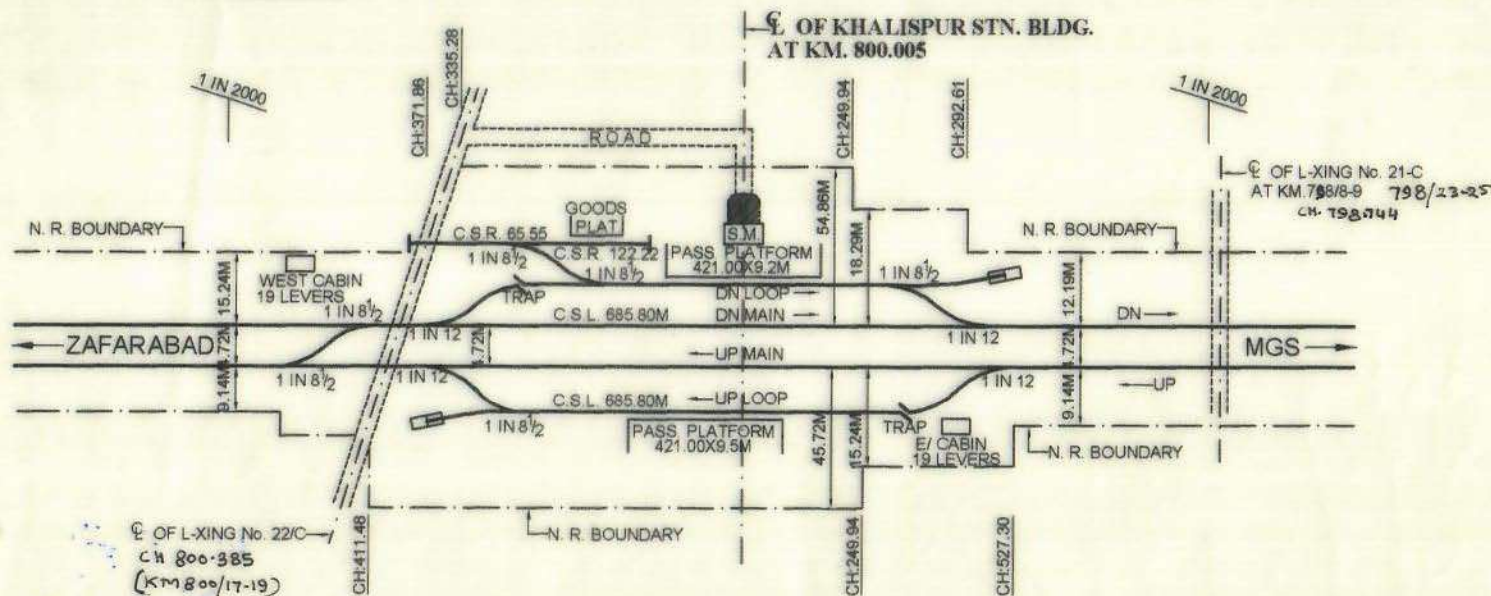

31/3/12

31-03-2013

31-3-13

31-3-13

15-12-12

CHECKED BY SSE/PWAY/JNU


Sr. D.E.N. (III)						
ADEN/JNU						
CORRECTED UPTO	31-03-12	31-3-13	31-3-14	31-3-15	31-3-20/6	31-03-2018

NORTHERN RAILWAY	
LUCKNOW DIVISION	
LKO-FD-BSB SECTION	
DIAGRAM OF	
KHALISPUR STN: YARD	
R.L./M.S.L.	81.06M
NOT TO SCALE	
N.R. DIVL. SKETCH NO: M-131/LKO/2012	

S. No.	DESCRIPTION	REMARKS		
1	LAVATORIES	LAV.	URINAL	
		LADIES	4	-
		GENTS	1	-
2	NO OF WATER TAPS/HAND PUMPS ON EACH PLATFORM	P/F No.	TAPS	H.P.
		1	3	-
		2	3	-
3	SOURCE OF WATER SUPPLY	-	-	-
4	YEAR OF CONSTRUCTION OF STATION BUILDING	-	-	-
5	BOOKING OFFICE NO. OF WINDOWS	ADV. RES.	CURRENT RES.	
		P/F No.1	P/F No.2	
6	NO. OF SEATS	-	-	-
7	WHETHER ENQUIRY OFFICE PROVIDED OR NOT	NIL		

S. No.	DESCRIPTION	AREA (Sq.m.)
1	AREA OF PLATFORM SHELTER	68.85
	P/F No.1	-
	P/F No.2	-
2	TOTAL AREA OF PLATFORM	3502.0
	PLATFORM NO. 1	3388.00
	PLATFORM NO. 2	114.00
3	AREA OF WAITING ROOM	NIL
	I-UPPER CLASS WAITING ROOM	-
	II-AREA OF WAITING ROOM	-
	a-LADIES	-
	b-GENTS	-
	III-WAITING HALL	30.00
4	CIRCULATING AREA	201.00


REF.	FENCING	KUTCHA PUCCA	----
	ROAD	METALLED UNMETALLED	=====

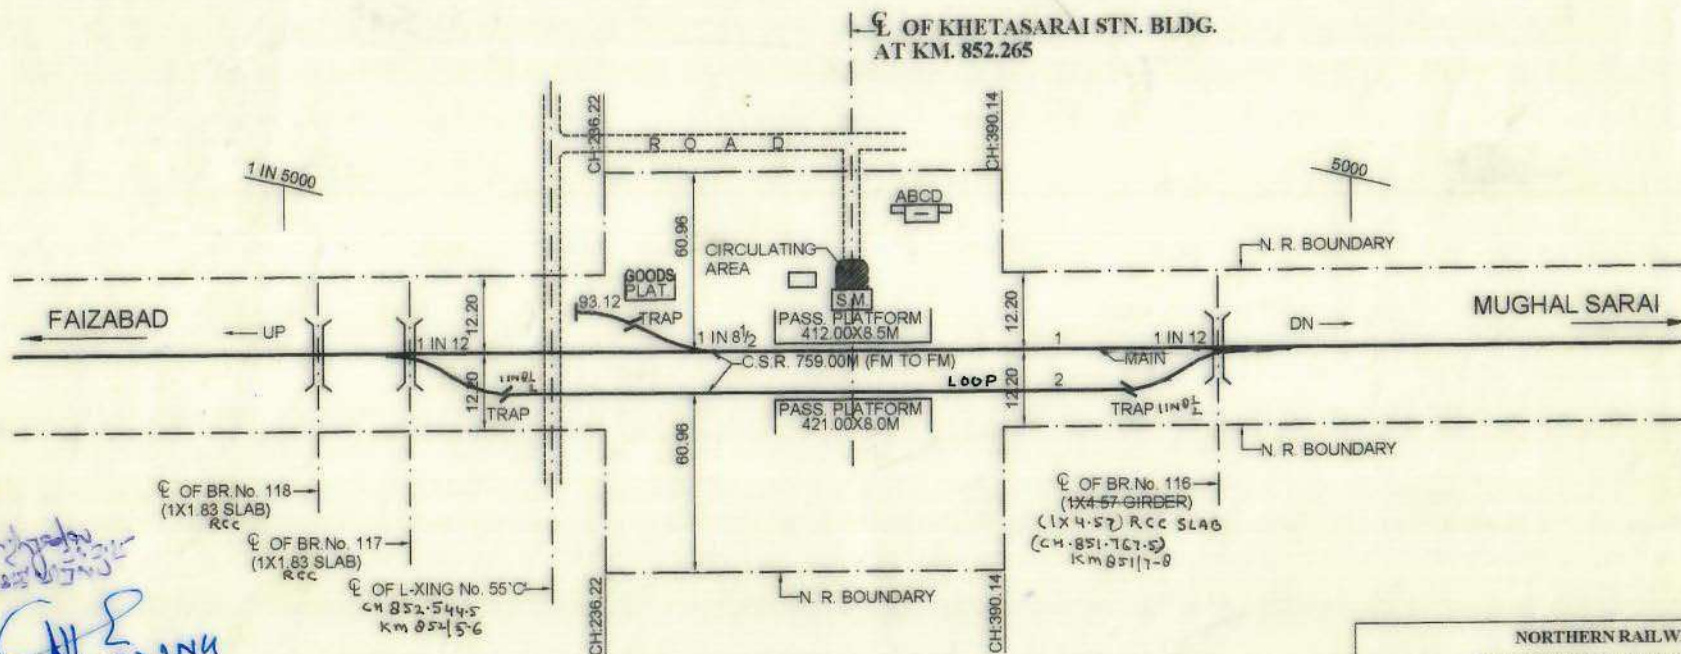

NORTHERN RAILWAY LUCKNOW DIVISION	
LKO-FD-BSB SECTION	
DIAGRAM OF KHETASARAI STN: YARD	
R.L./M.S.L.	NOT TO SCALE
N.R. DIVL. SKETCH NO: M 200 LKO 2012	

CHECKED BY	SSE/R.WAY/JNU	Sr. D.E.N. (III)	ADEN/JNU	CORRECTED UPTO	31-03-12	31-3-13	31-3-14	31-3-15	31-3-2016	31-03-2018
DRAWN BY	DAKSCH									

86

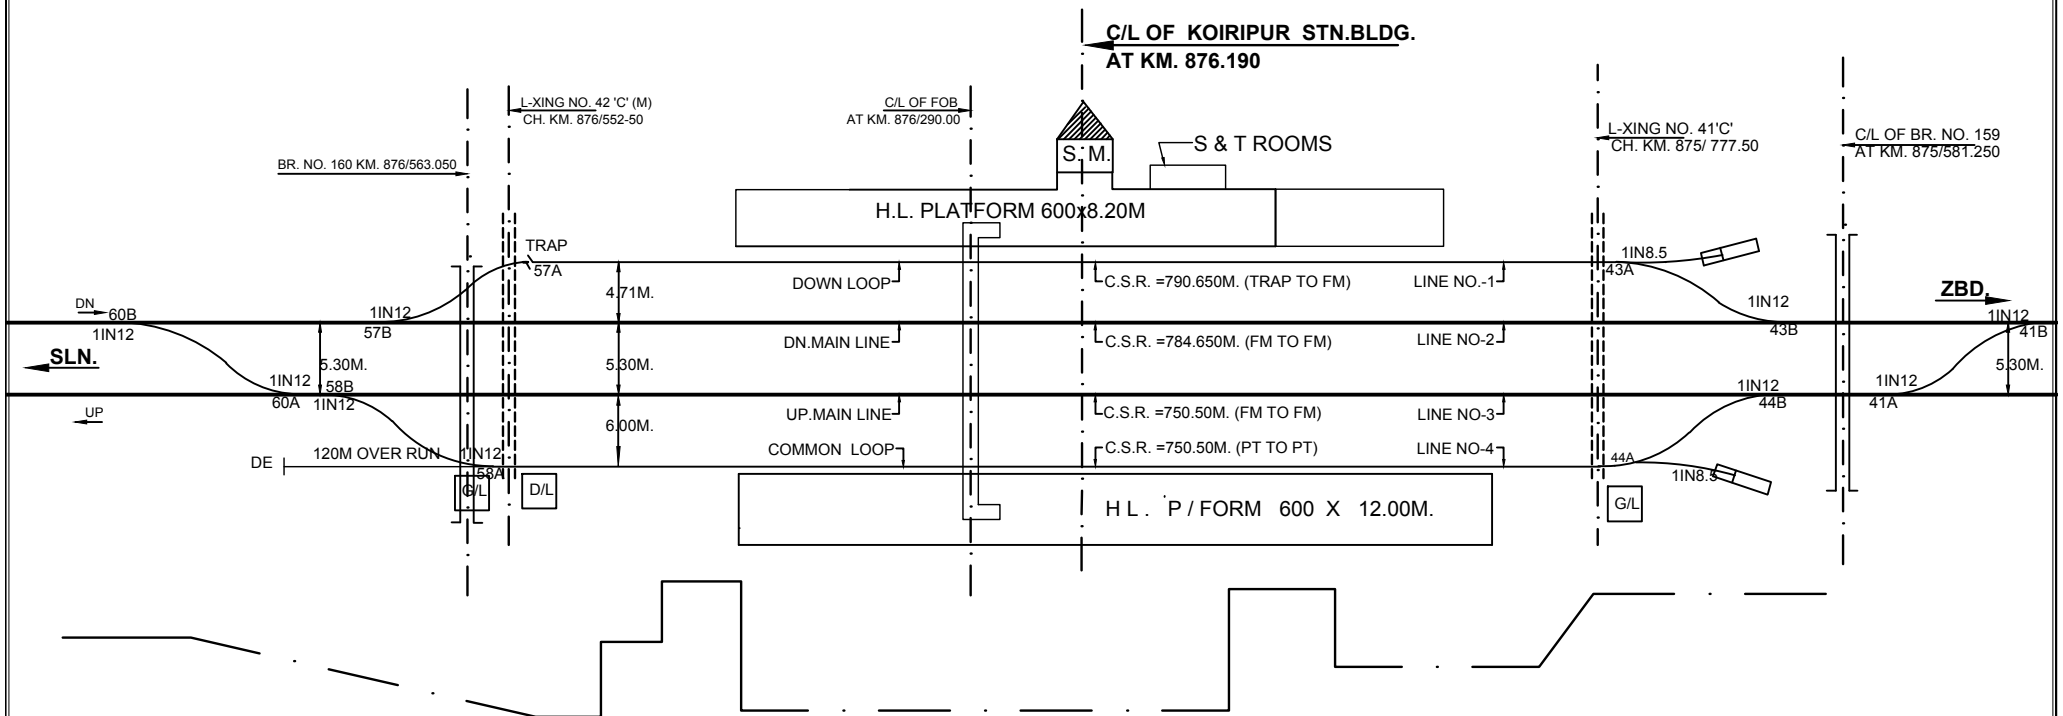


CHECKED BY	
DRAWN BY	

Sr. DEN/(IV)					
ADEN/SLN-II					
CORRECTED UPTO	18-02-2020				

NORTHERN RAILWAY LUCKNOW DIVISION	
LKO -SLN-ZBD SECTION DIAGRAM OF KOIRIPUR STN. YARD.	
R.L./M.S.L. 107.665m	NOT TO SCALE
N.R. D.R.M. LKO. SKETCH NO.	278 - 06

REF.		
	FENCING	KUTCHA PUCCA
	ROAD	METALLED UNMETALLED

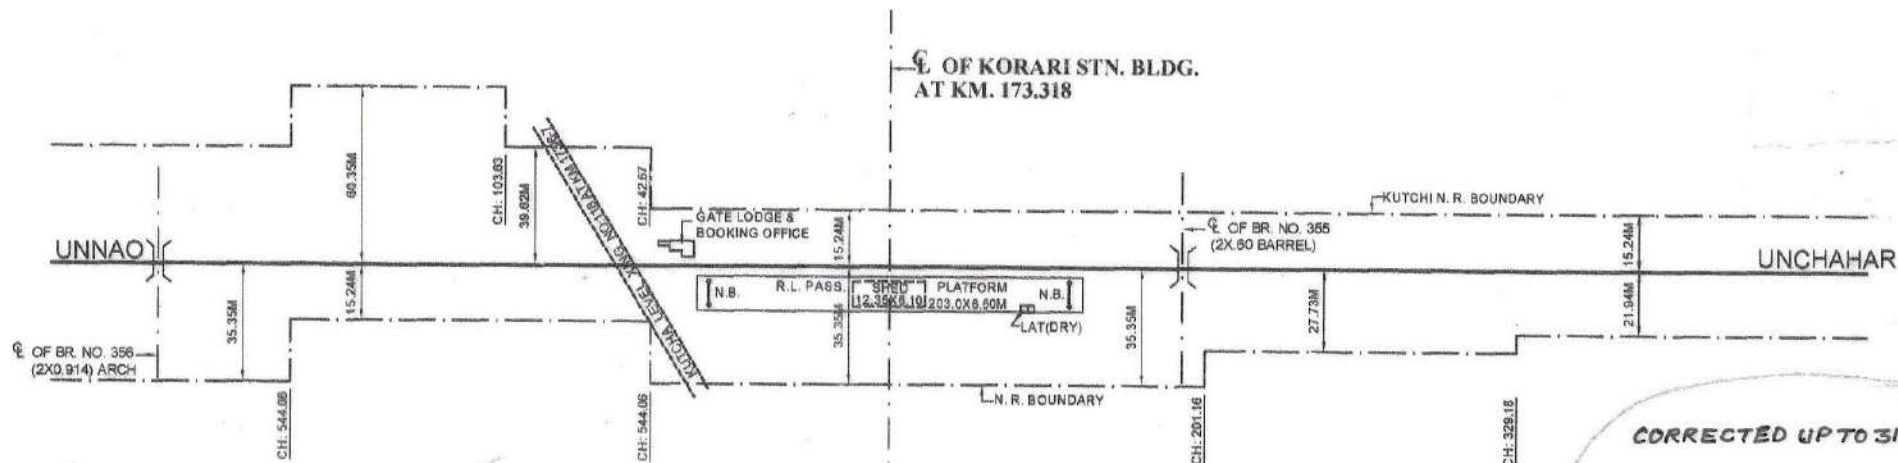

CORRECTED UP TO 31.03.2018

SA DEH - II

निविद संख्या ५-२०१५ १०५०
Senior Resident Engineer (P.W.D.)
३०.६.२०१५, अ.प्र. वि. अ.प्र. वि. अ.प्र. वि.

ADEN-RBL

Sr. D.E.N.(II)				
CORRECTED UPTO	31-03-2010	31-3-2011	31-3-12	31-03-13

NORTHERN RAILWAY	
LUCKNOW DIVISION	
<u>PFM-UCR-ON SECTION</u>	
<u>DIAGRAM OF</u>	
KORARI STN: YARD	
R.L./M.S.L.	NOT TO SCALE
N.R. D.R.M. LKO. SKETCH NO.	


52

5/1/77 ARE
R 82
march 16

S. No.	DESCRIPTION	REMARKS		
1	LAVATORIES		LAV.	URINAL
		LADIES	-	
		GENTS	-	
2	NO OF WATER TAPS/ HAND PUMPS ON EACH PLATFORM	P/F No.	TAPS	H.P.
		1	-	1
	SOURCE OF WATER SUPPLY	-		
3	YEAR OF CONSTRUCTION OF STATION BUILDING	-		
4	BOOKING OFFICE NO. OF WINDOWS	ADV. RES.	CURRENT RES.	
		-1-		
5	NO. OF SEATS	P/F No.1		
		9		
6	WHETHER ENQUIRY OFFICE PROVIDED OR NOT	-		

S. No.	DESCRIPTION	AREA (Sq.m.)
1.	AREA OF PLATFORM SHELTER	P/F No.1
2.	TOTAL AREA OF PLATFORM PLATFORM NO. 1	1134
3.	AREA OF WAITING ROOM	
	I- UPPER CLASS WAITING ROOM	-
	II - AREA OF WAITING ROOM	-
	a- LADIES	-
	b- GENTS	-
	III- WAITING HALL	12
4.	CIRCULATING AREA	-


REF.	FENCING	KUTCHA	-----
		PUCCA	-----
	ROAD	METALLED	=====
		UNMETALLED	=====

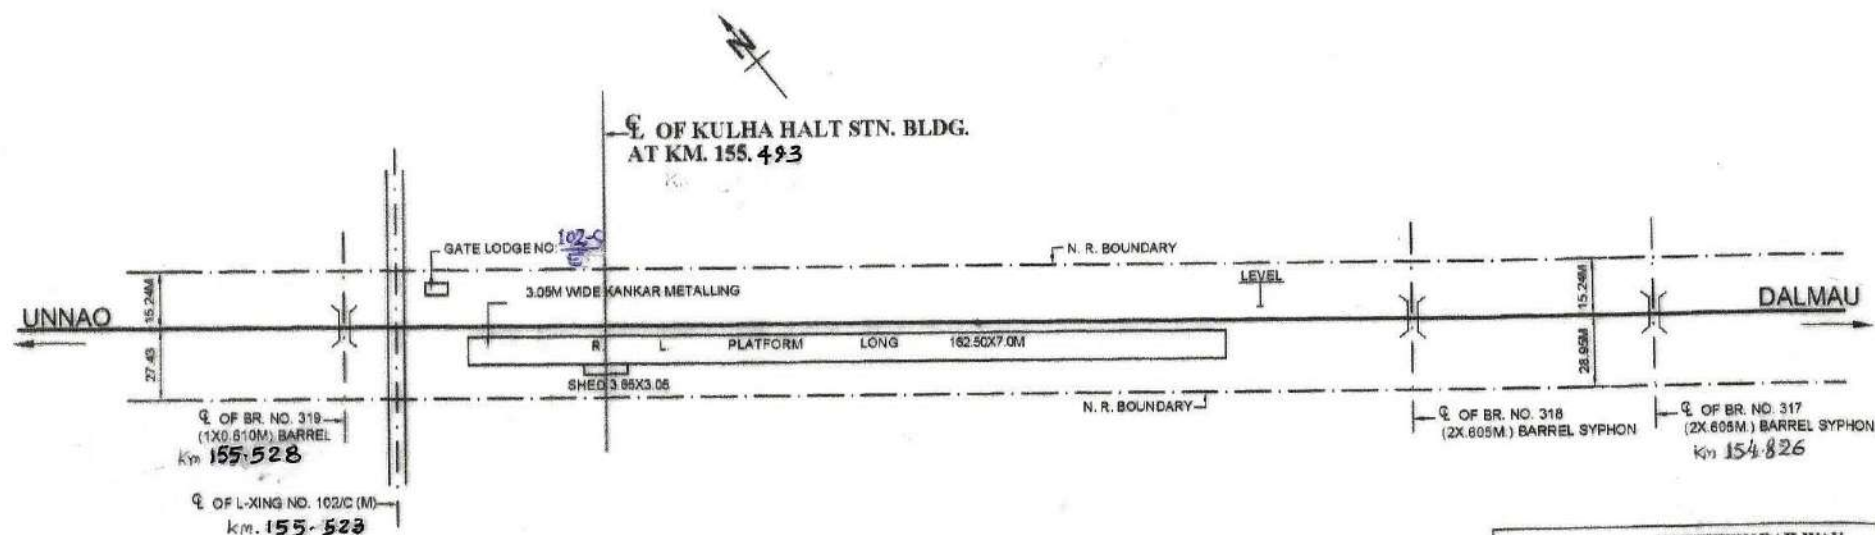

CHECKED BY	3.3.16
DRAWN BY	DAKSH

Sr. D.E.N.(II)						
ADEN/RBL	Musub	Musub	Musub	Musub	Musub	Musub
CORRECTED UPTO	31-03-12	31-03-13	31-03-14	31-3-15	31-3-2016	31-3-2018


NORTHERN RAILWAY LUCKNOW DIVISION	
PFM-UCR-ON SECTION	
DIAGRAM OF KULHA HALT STN: YARD	
R.L./M.S.L.	NOT TO SCALE
N.R. DIV L SKETCH NO.	M-126/LKO/2012

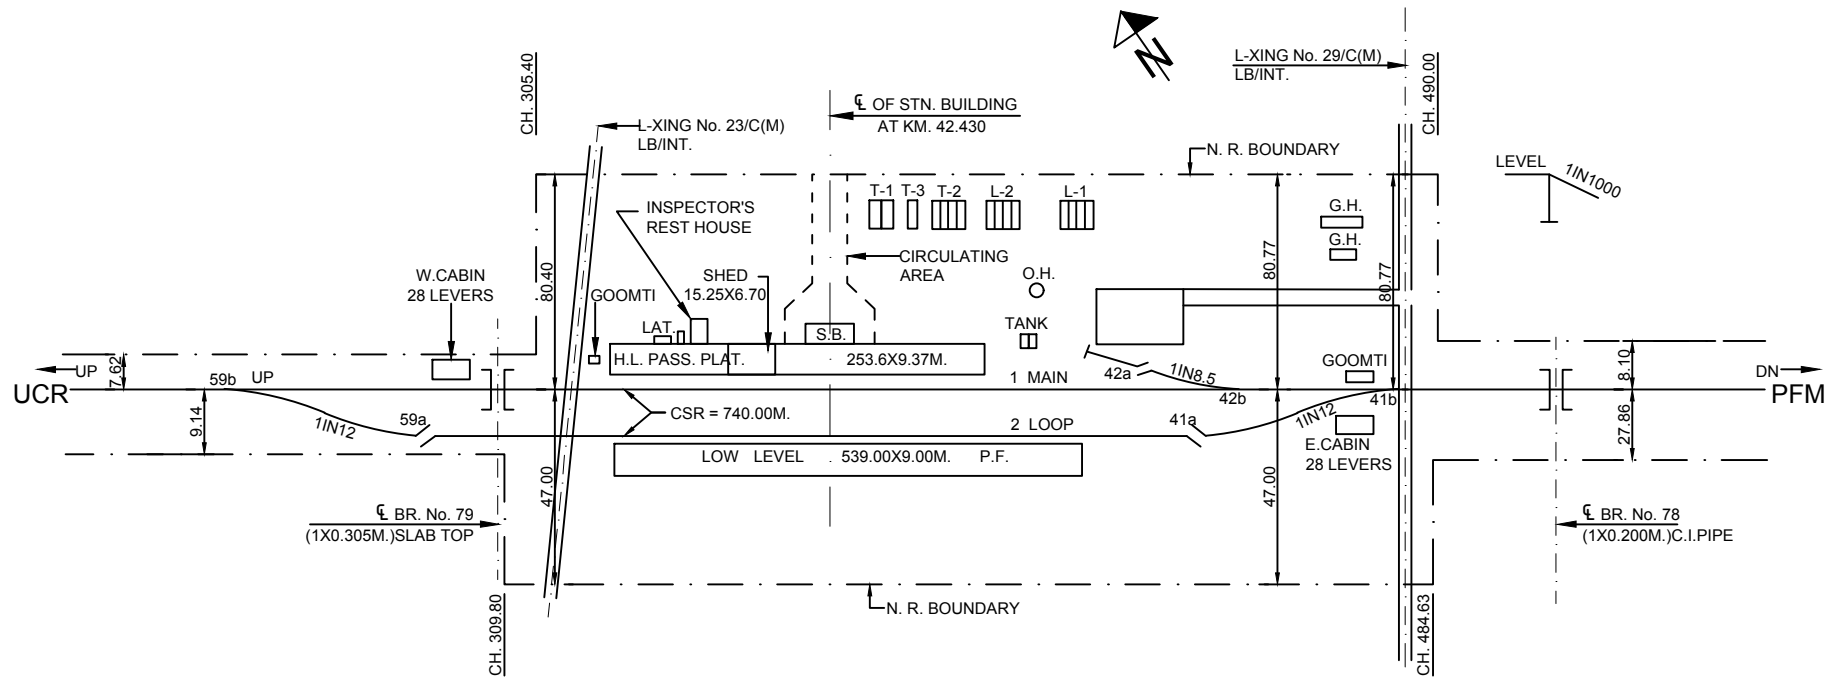

NORTHERN RAILWAY	
LUCKNOW DIVISION	
PFM-UCR-ON SECTION	
DIAGRAM OF	
KUNDA HARNAMGANJ STN. YARD	
R.L./M.S.L.	NOT TO SCALE
N.R. D.R.M. LKO. SKETCH NO. 306-06	

CHECKED BY		Sr. DEN/(IV)					
DRAWN BY		ADEN/PRG					
		CORRECTED UPTO	18-02-2020				

KUNDAN GANJ STATION BLD. AT KM. 1016.450

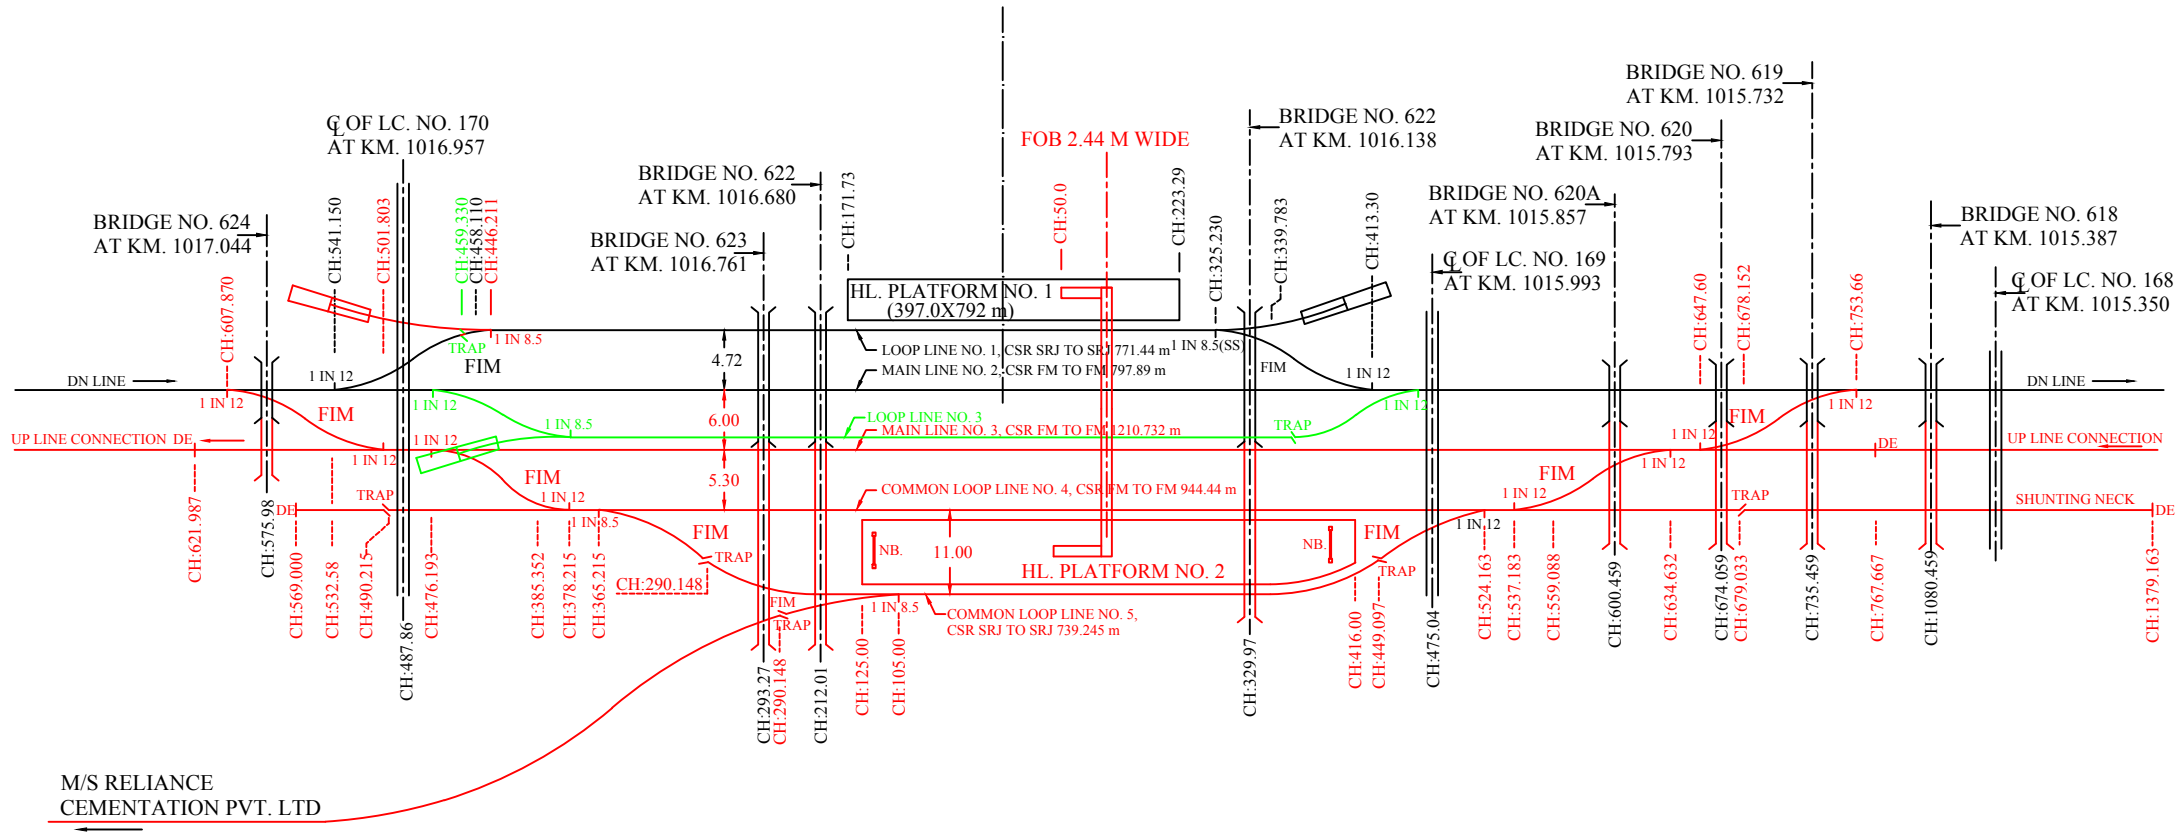


M/S RELIANCE
CEMENTATION PVT. LTD

LEGEND:-

1. EXISTING WORK SHOWN THUS —
2. PROPOSED WORK SHOWN THUS —
3. DISMENTLING WORK SHOWN THUS —
4. THIS DRAWING IS NOT TO SCALE



KUNDAN GANJ STATION YARD

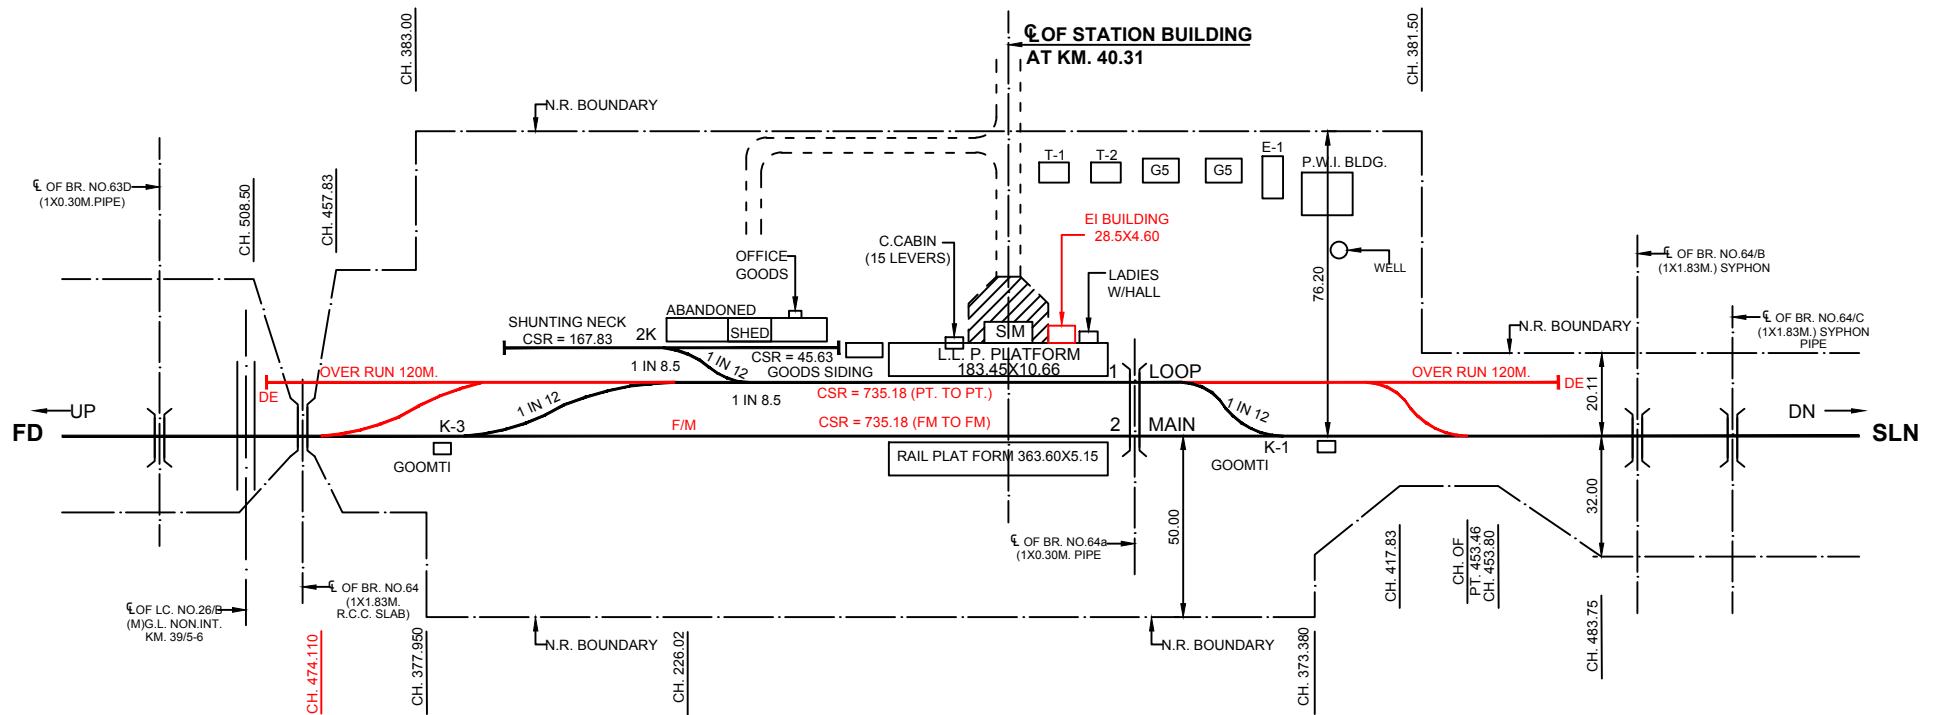

NORTHERN RAILWAY
LUCKNOW DIVISION

FD-SLN-FM SECTION

DIAGRAM OF

KUREBHAR STN. YARD

CHECKED BY

DRAWN BY

ADEN/PRG

CORRECTED UPTO

18-02-2020


Sr.DEN/(IV)


R.L./M.S.L.

NOT TO SCALE

N.R. D.R.M. LKO. SKETCH NO.


321-06

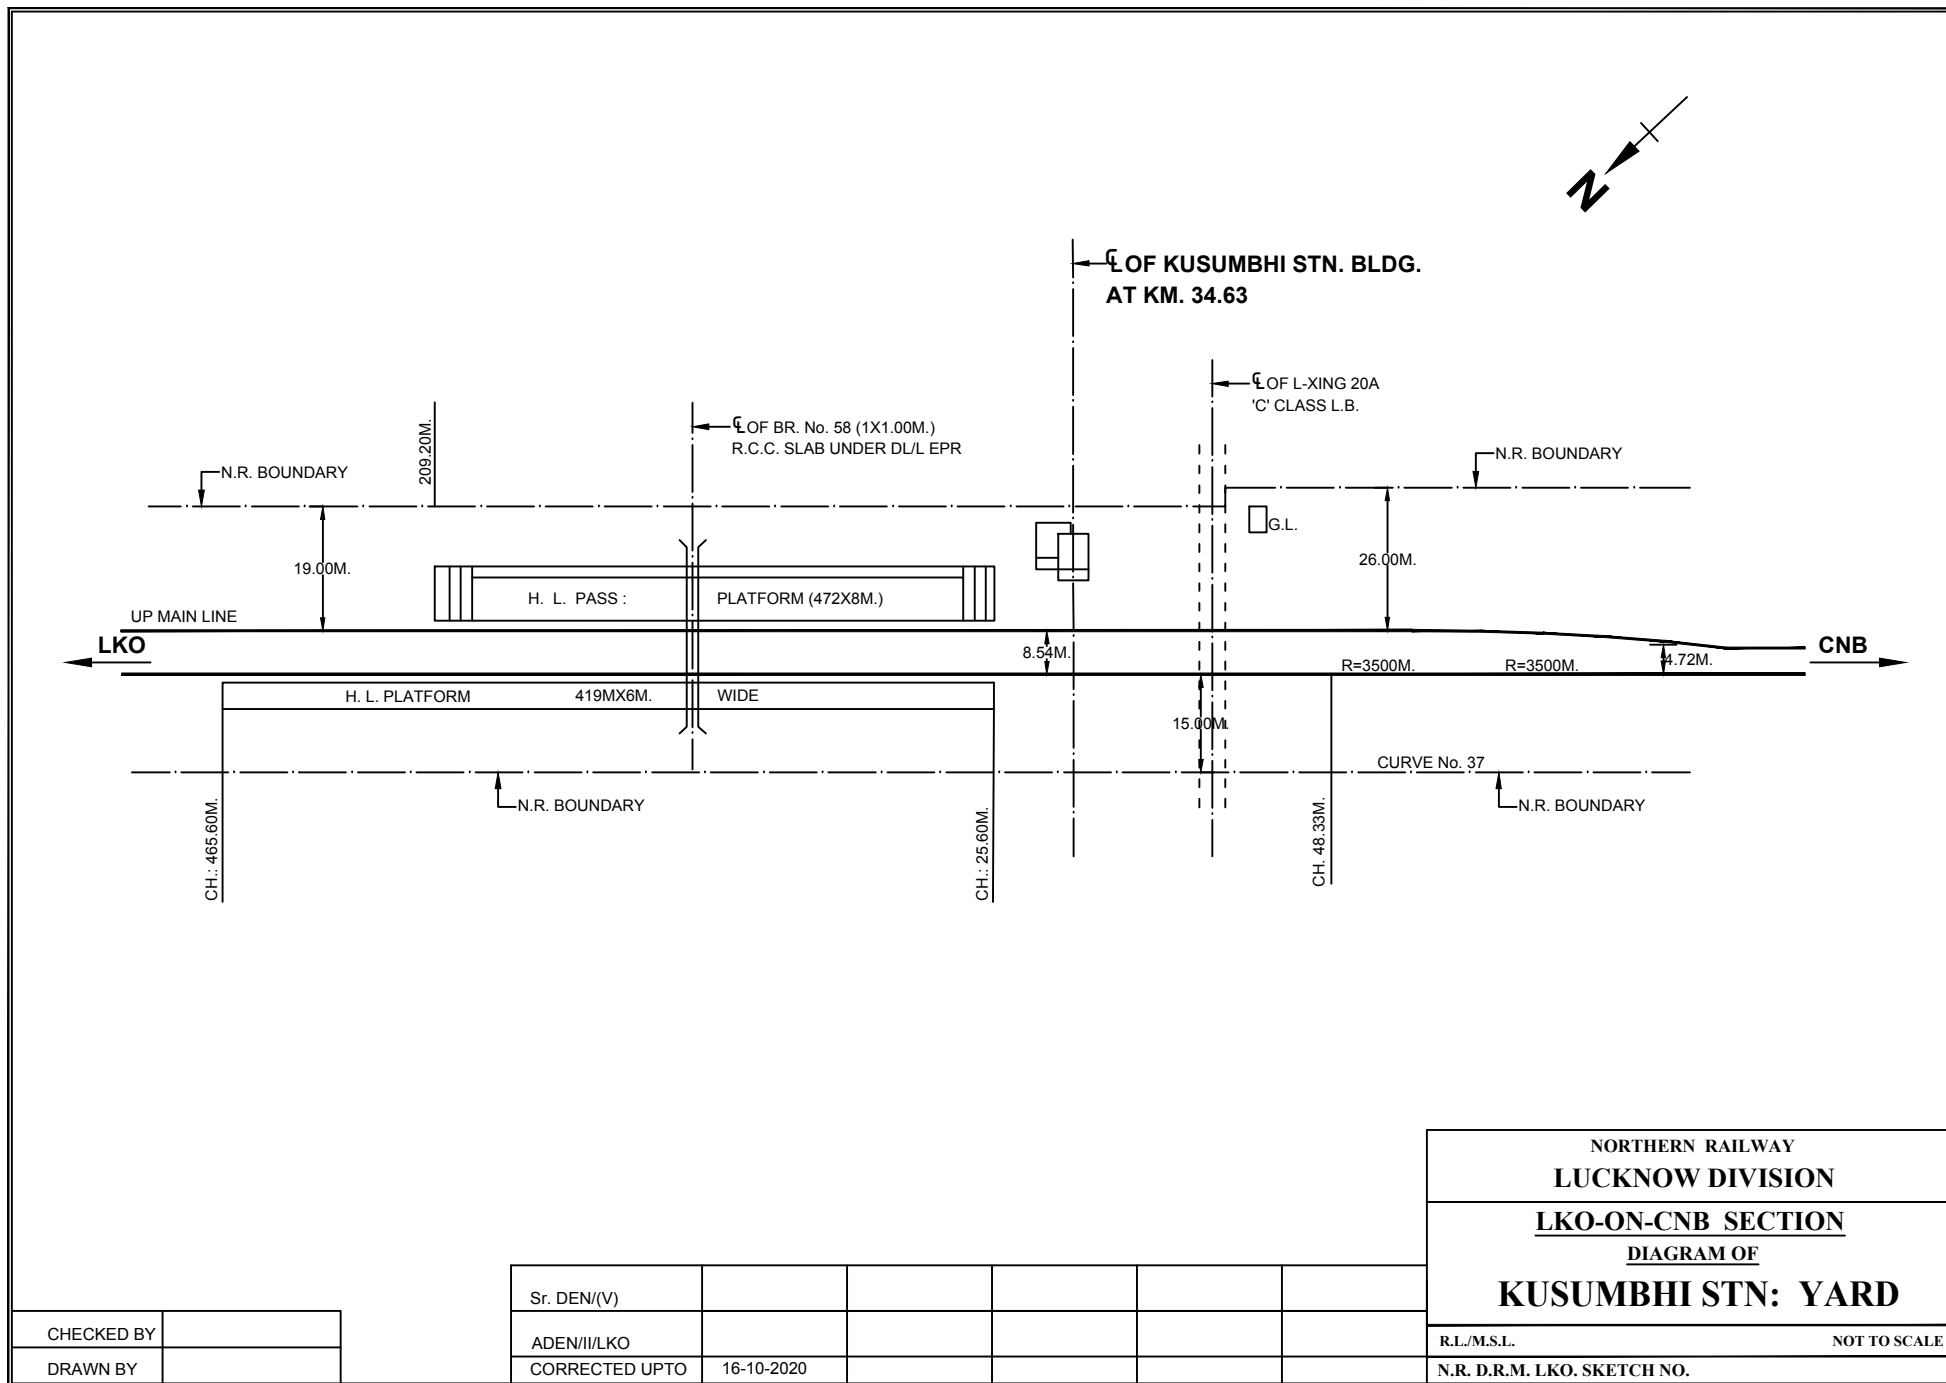

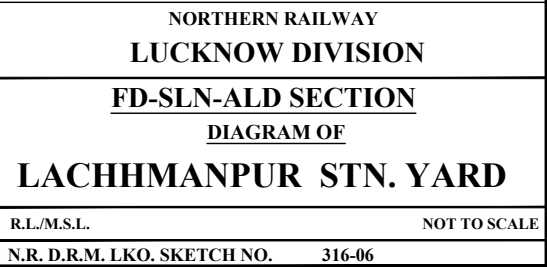

CHECKED BY	
DRAWN BY	

ADEN/PRG		Sr.DEN/(IV)		
CORRECTED UPTO	18-02-2020			

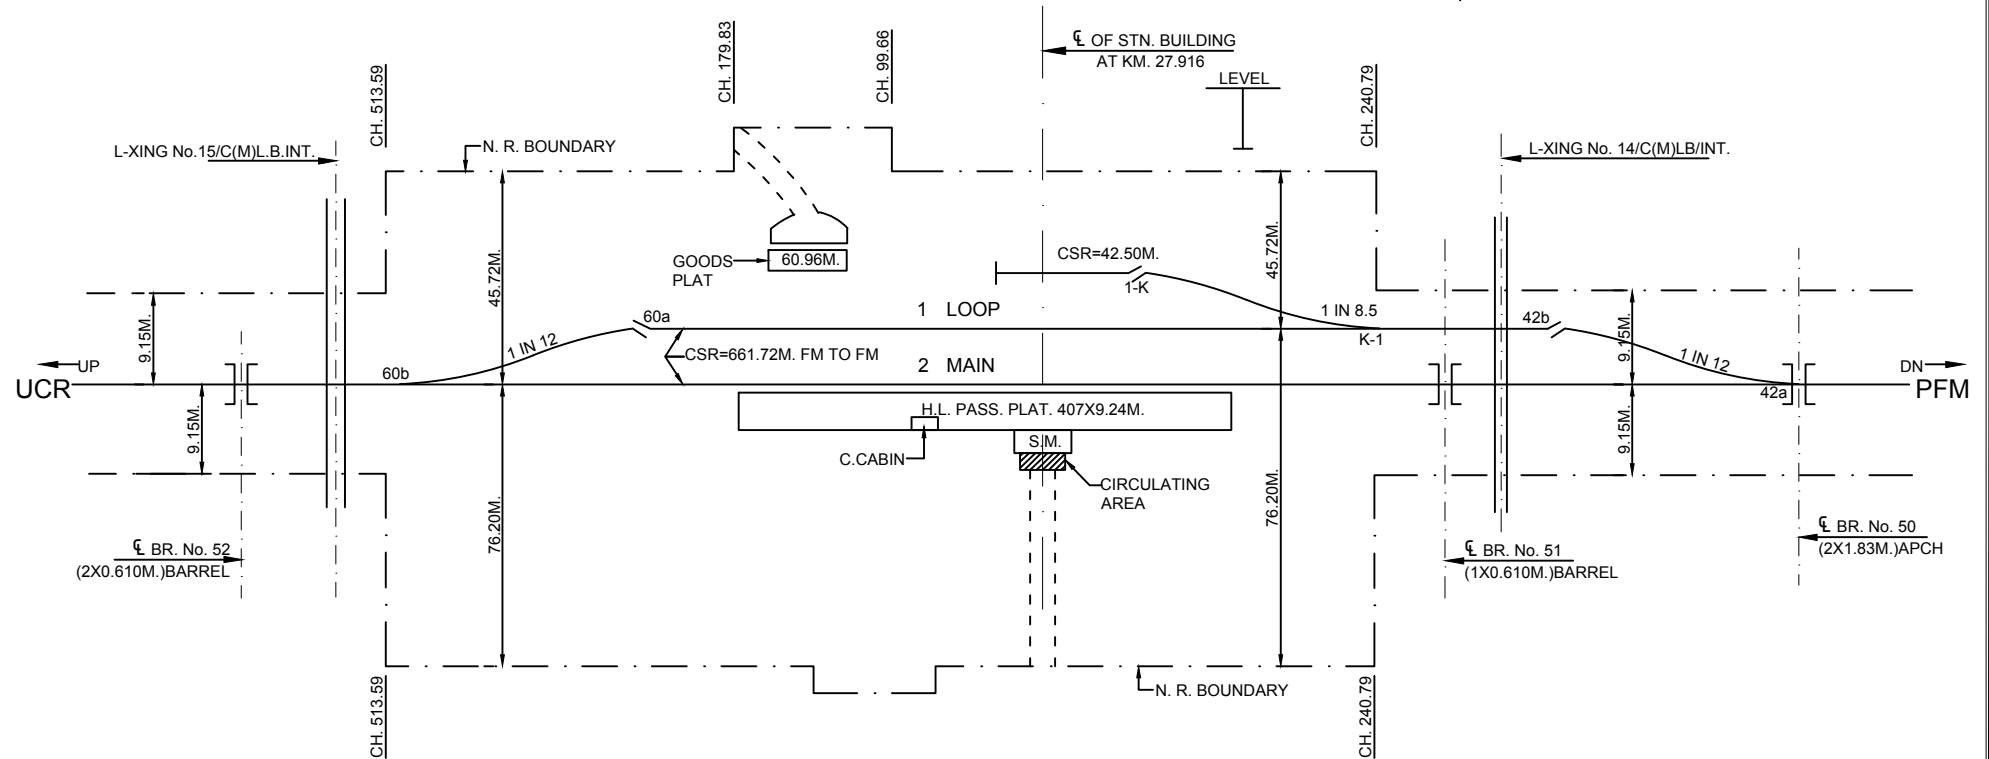

NORTHERN RAILWAY	
LUCKNOW DIVISION	
PFM-UCR-ON SECTION	
DIAGRAM OF	
LAL GOPALGANJ STN. YARD	
R.L./M.S.L.	NOT TO SCALE
N.R. D.R.M. LKO. SKETCH NO. 306-06	

CHECKED BY	
DRAWN BY	


Sr. DEN/(IV)					
ADEN/PRG					
CORRECTED UPTO	18-02-2020				

S.No.	DESCRIPTION	REMARKS		
1	LAVATORIES		LAV.	URINAL
		LADIES	4	2
		GENTS	-	
2	NO OF WATER TAPS/ HAND PUMPS ON EACH PLATFORM	P/F No.	TAPS	H.P.
		1	-	3
		2&3		3
	SOURCE OF WATER SUPPLY		-	
3	YEAR OF CONSTRUCTION OF STATION BUILDING	-		
4	BOOKING OFFICE NO. OF WINDOWS	ADV. RES.	CURRENT RES.	
		-1-		
5	NO. OF SEATS	P/F No.1	P/F No.2	
		189	30	
6	WHETHER ENQUIRY OFFICE PROVIDED OR NOT	-		

S. No.	DESCRIPTION	AREA (Sq.m.)
1.	AREA OF PLATFORM SHELTER	140
	P/F No.1	252
2.	TOTAL AREA OF PLATFORM	5545.38
	PLATFORM NO. 1	5457.50
3.	AREA OF WAITING ROOM	-
	I- UPPER CLASS WAITING ROOM	-
	II - AREA OF WAITING ROOM	-
	a- LADIES	-
	b- GENTS	-
	III- WAITING HALL	217
4.	CIRCULATING AREA	1000

REF.	FENCING	KUTCHA PUCCA	----
	ROAD	METALLED UNMETALLED	=====


Ref: Red show dismantling
Green shows new proposed.

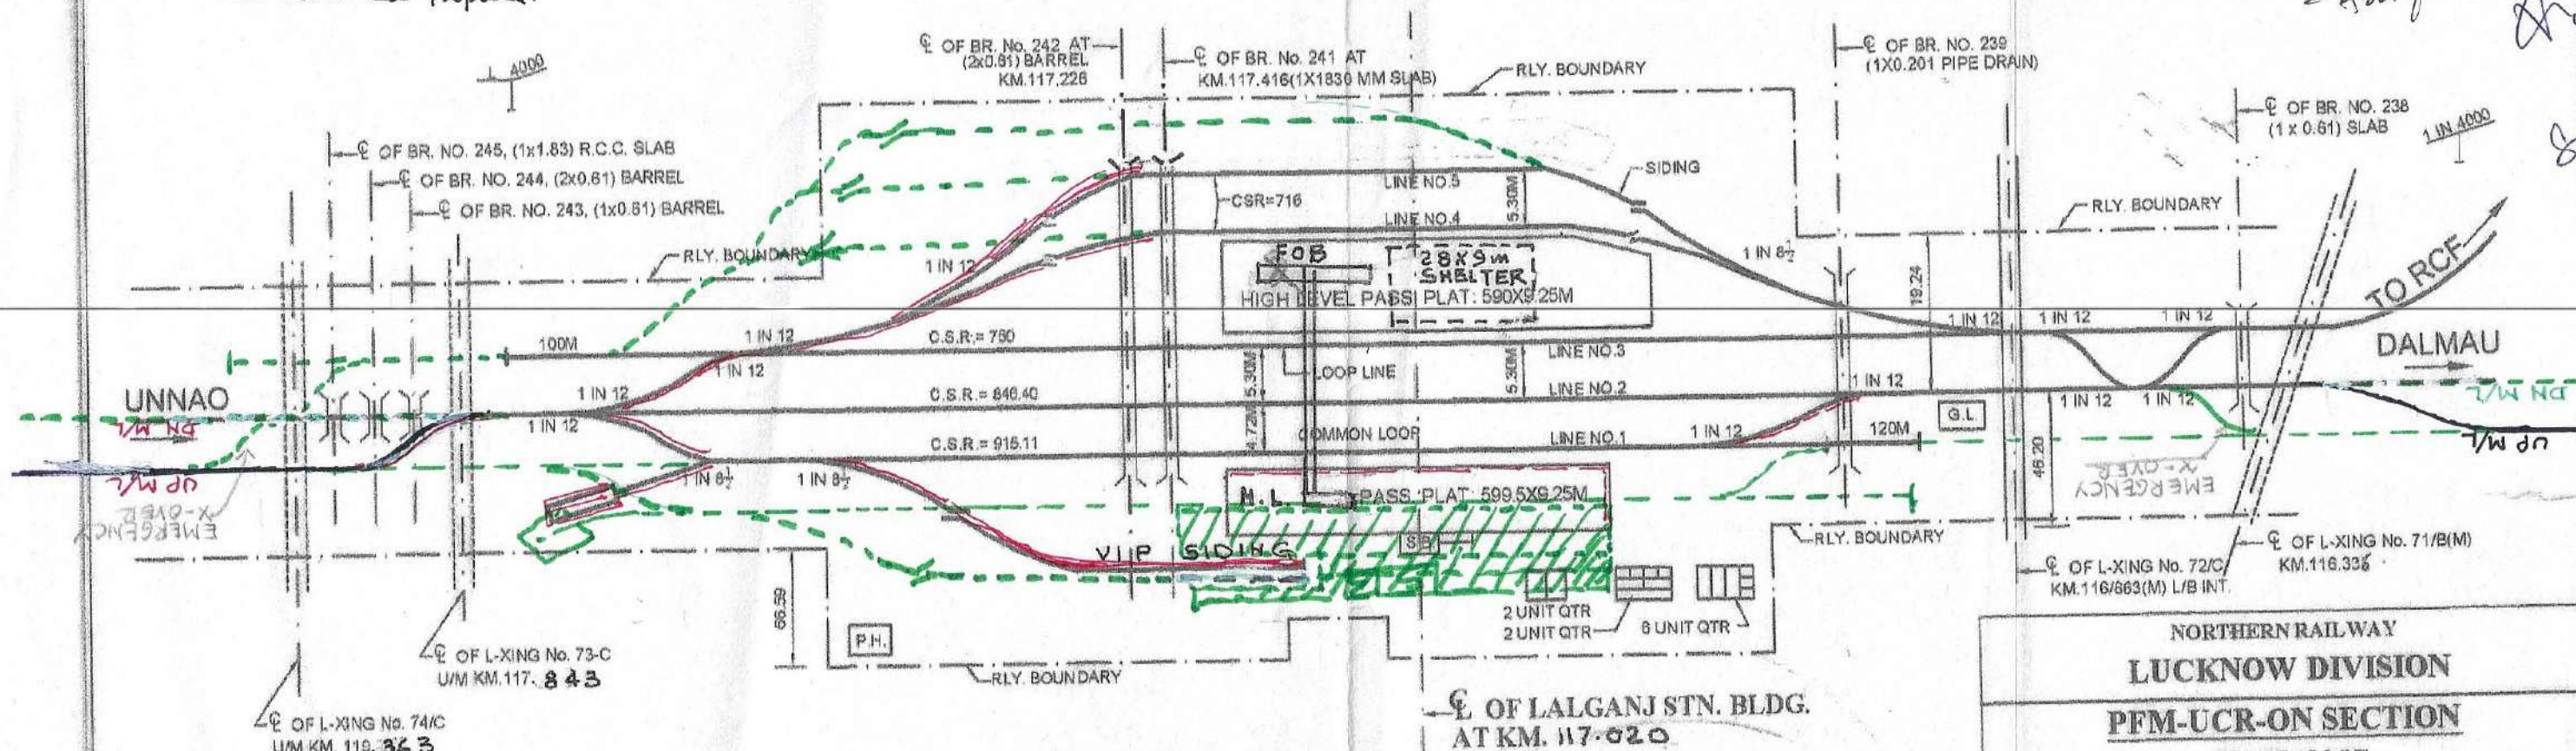

CHECKED BY *S.S.E. PWD MW*
DRAWN BY *DANISH*
255, 2ND FLOOR, LUCKNOW DIVISION, FAIZABAD ROAD, LKO-2012

Sr. D.E.N.(II)							
ADEN/RBL	<i>ADEN/RBL</i>	<i>ADEN/RBL</i>	<i>ADEN/RBL</i>	<i>ADEN/RBL</i>	<i>ADEN/RBL</i>	<i>ADEN/RBL</i>	<i>ADEN/RBL</i>
CORRECTED UPTO	31-03-12	31-03-13	31-03-2014	31-03-2015	31-03-2016	31-03-18	

NORTHERN RAILWAY LUCKNOW DIVISION	
PFM-UCR-ON SECTION DIAGRAM OF LALGANJ STN: YARD	
R.L./M.S.L.	NOT TO SCALE
N.R. DIV L. SKETCH NO.	M-132/LKO/2012

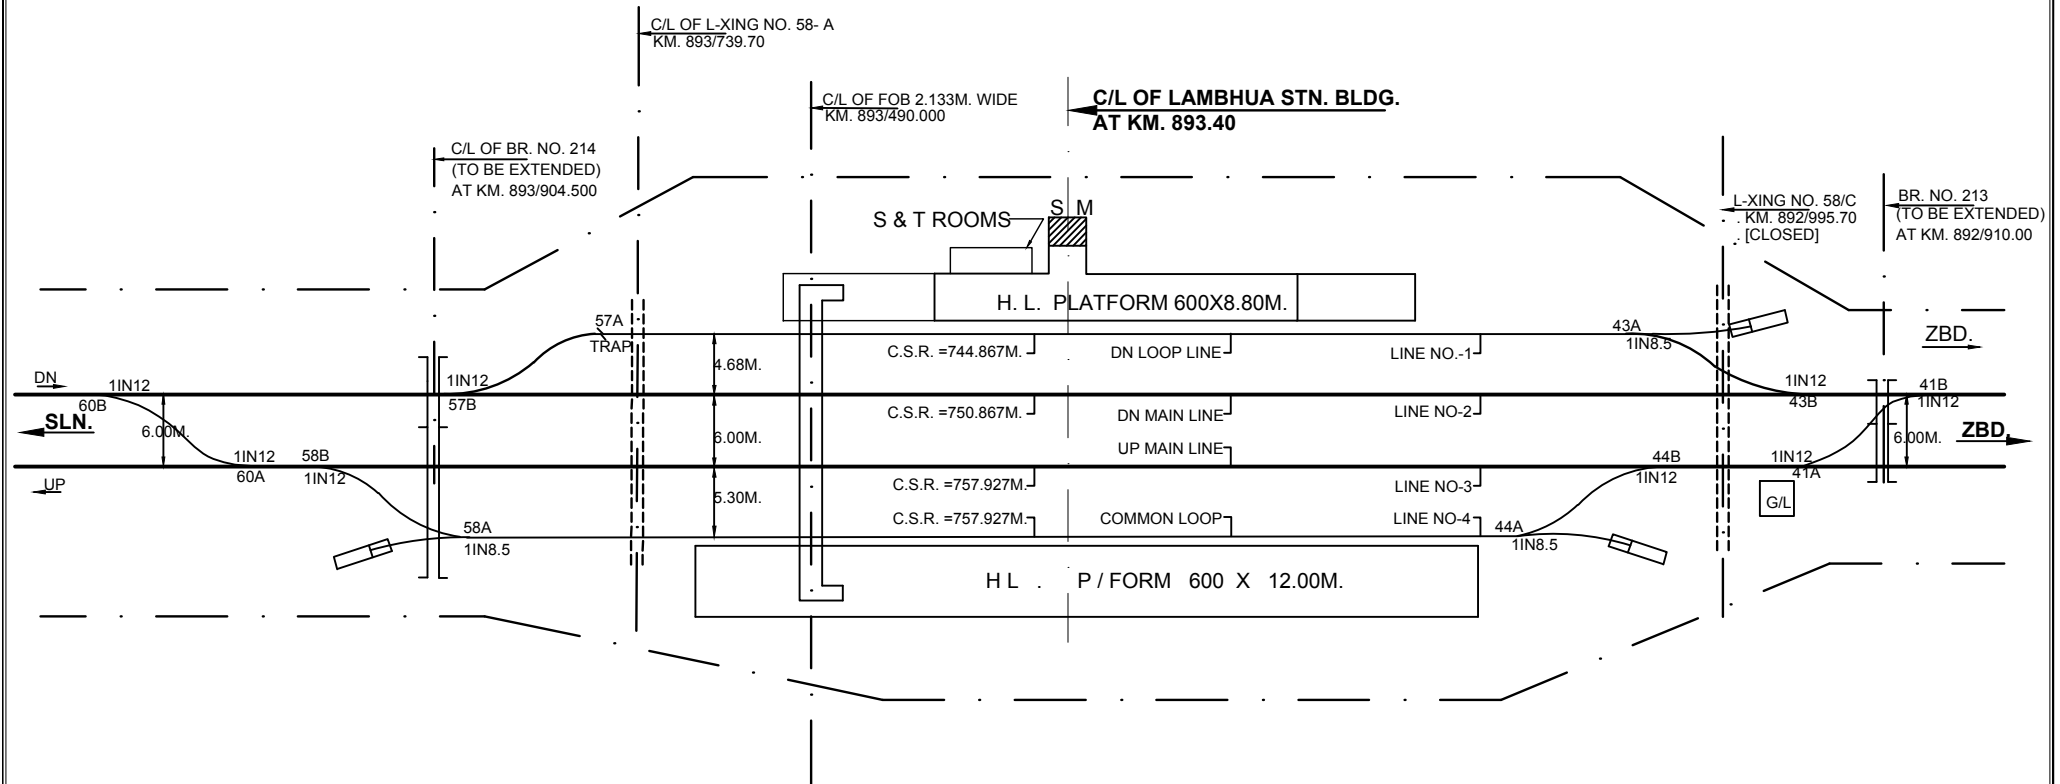

NORTHERN RAILWAY
LUCKNOW DIVISION

LKO -SLN-ZBD SECTION
DIAGRAM OF

LAMBHUA STN. YARD.

CHECKED BY

DRAWN BY

Sr. DEN(IV)

ADEN/SLN-II

CORRECTED UPTO

18-02-2020


R.L./M.S.L. 107.665m


NOT TO SCALE

N.R. D.R.M. LKO. SKETCH NO.

278 - 06

LOHTA STATION.
NOT TO SCALE

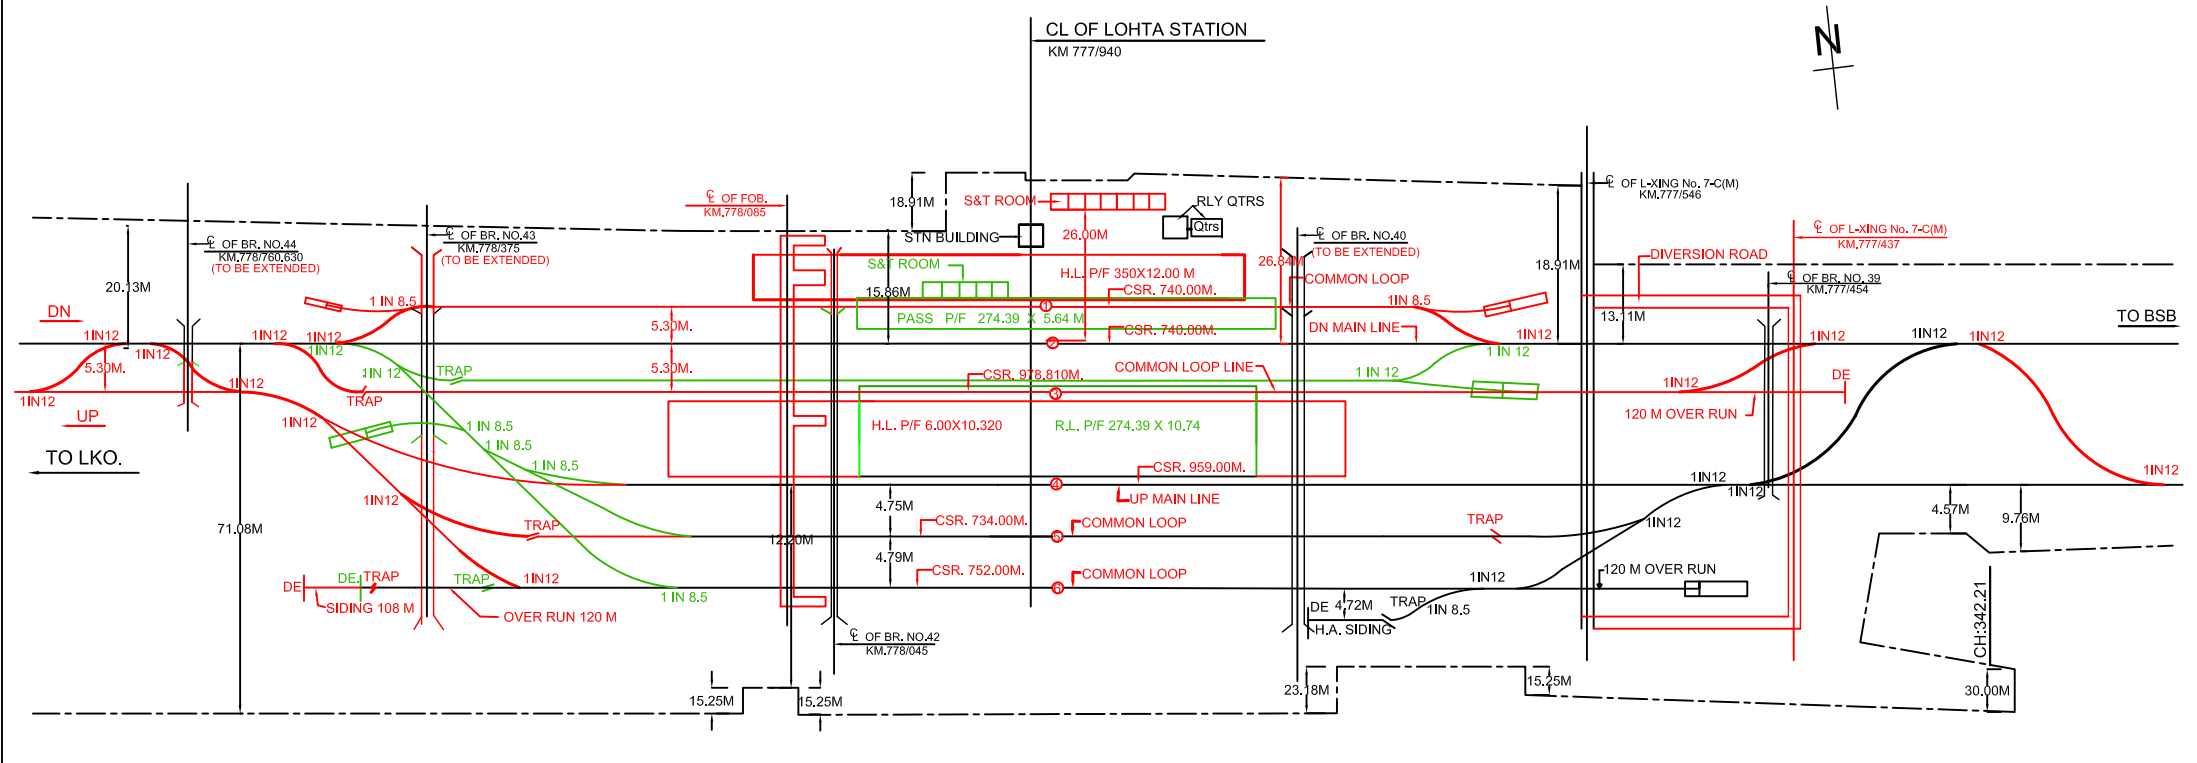


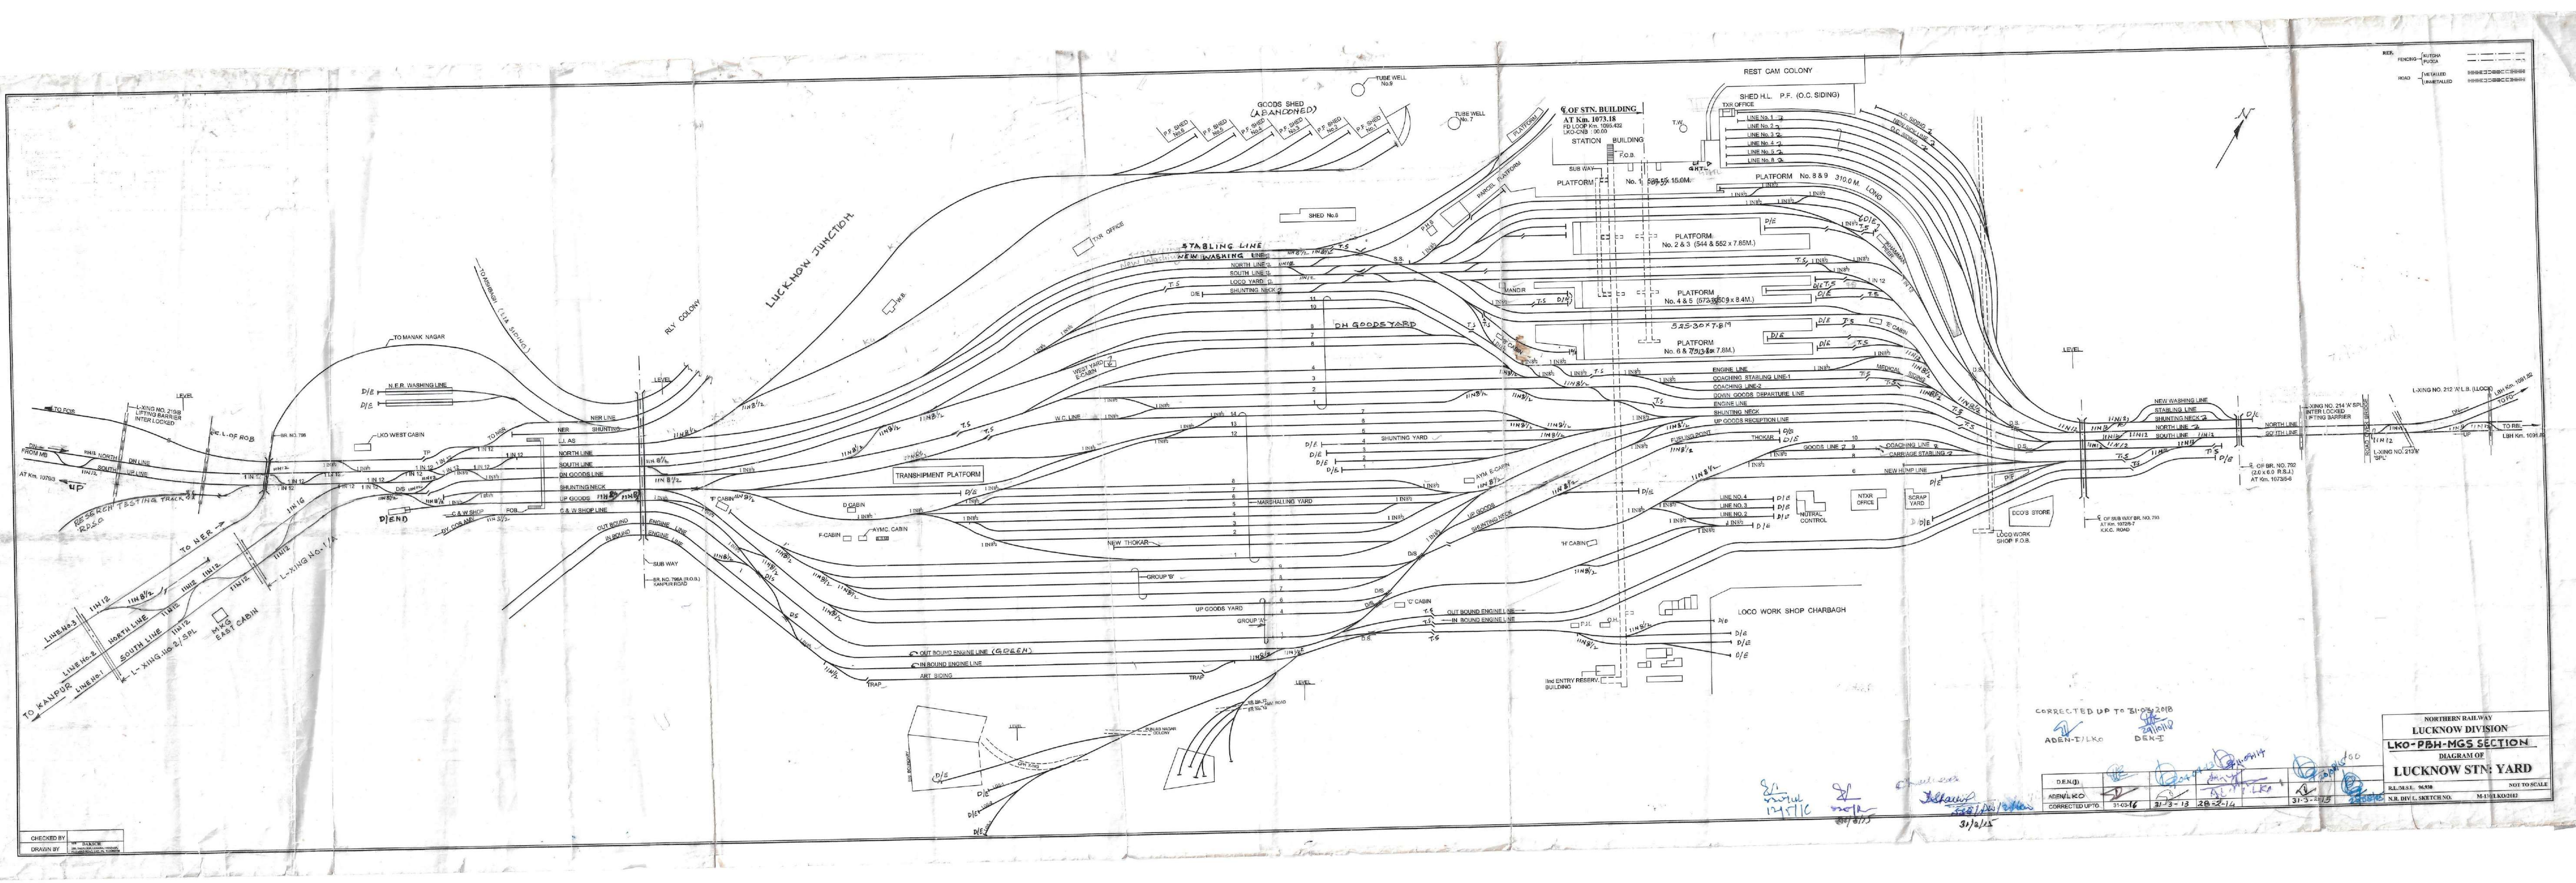

NORTHERN RAILWAY
LUCKNOW DIVISION
LKO-PBH-MGS SECTION
DIAGRAM OF
LUCKNOW STN. YARD


DEN-1	31-03-16	31-03-13	28-02-14	31-03-2015	31-03-2015
ADEN-1					
CORRECTED UP TO	31-03-16	31-03-13	28-02-14	31-03-2015	31-03-2015

CHECKED BY
DRAWN BY

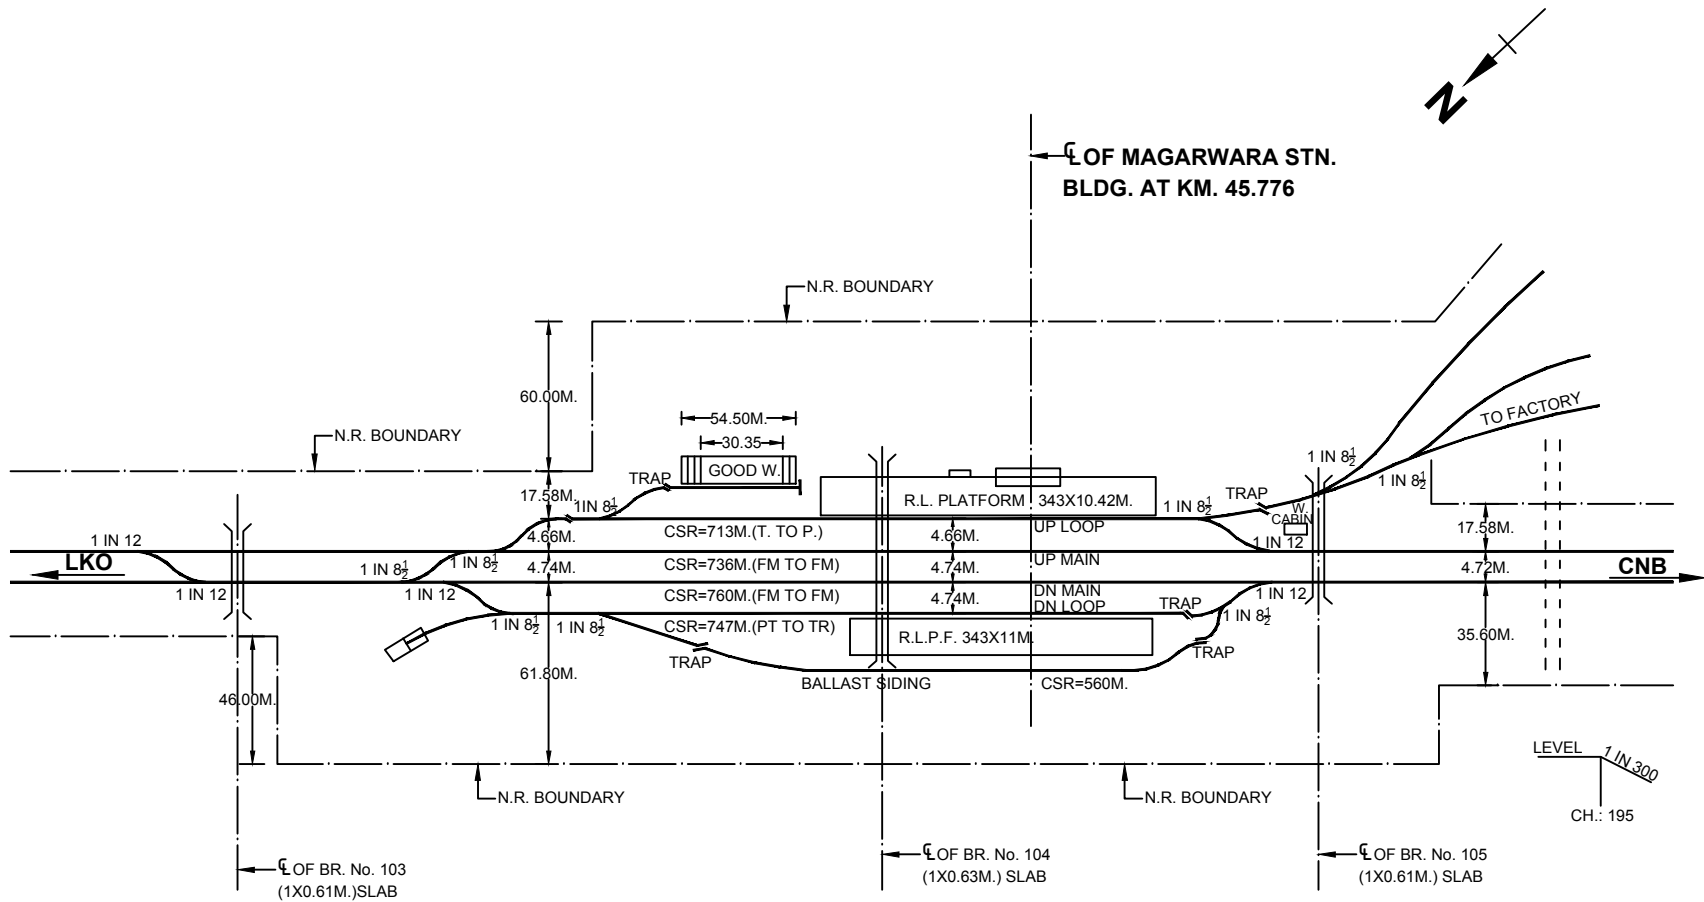

NORTHERN RAILWAY	
LUCKNOW DIVISION	
<u>LKO-ON-CNB SECTION</u>	
<u>DIAGRAM OF</u>	
MAGARWARA STN: YARD	
R.L./M.S.L.	NOT TO SCALE
N.R. D.R.M. LKO. SKETCH NO.	

CHECKED BY		Sr. DEN(V)							
DRAWN BY		ADEN/III/LKO							
		CORRECTED UPTO	16-10-2020						

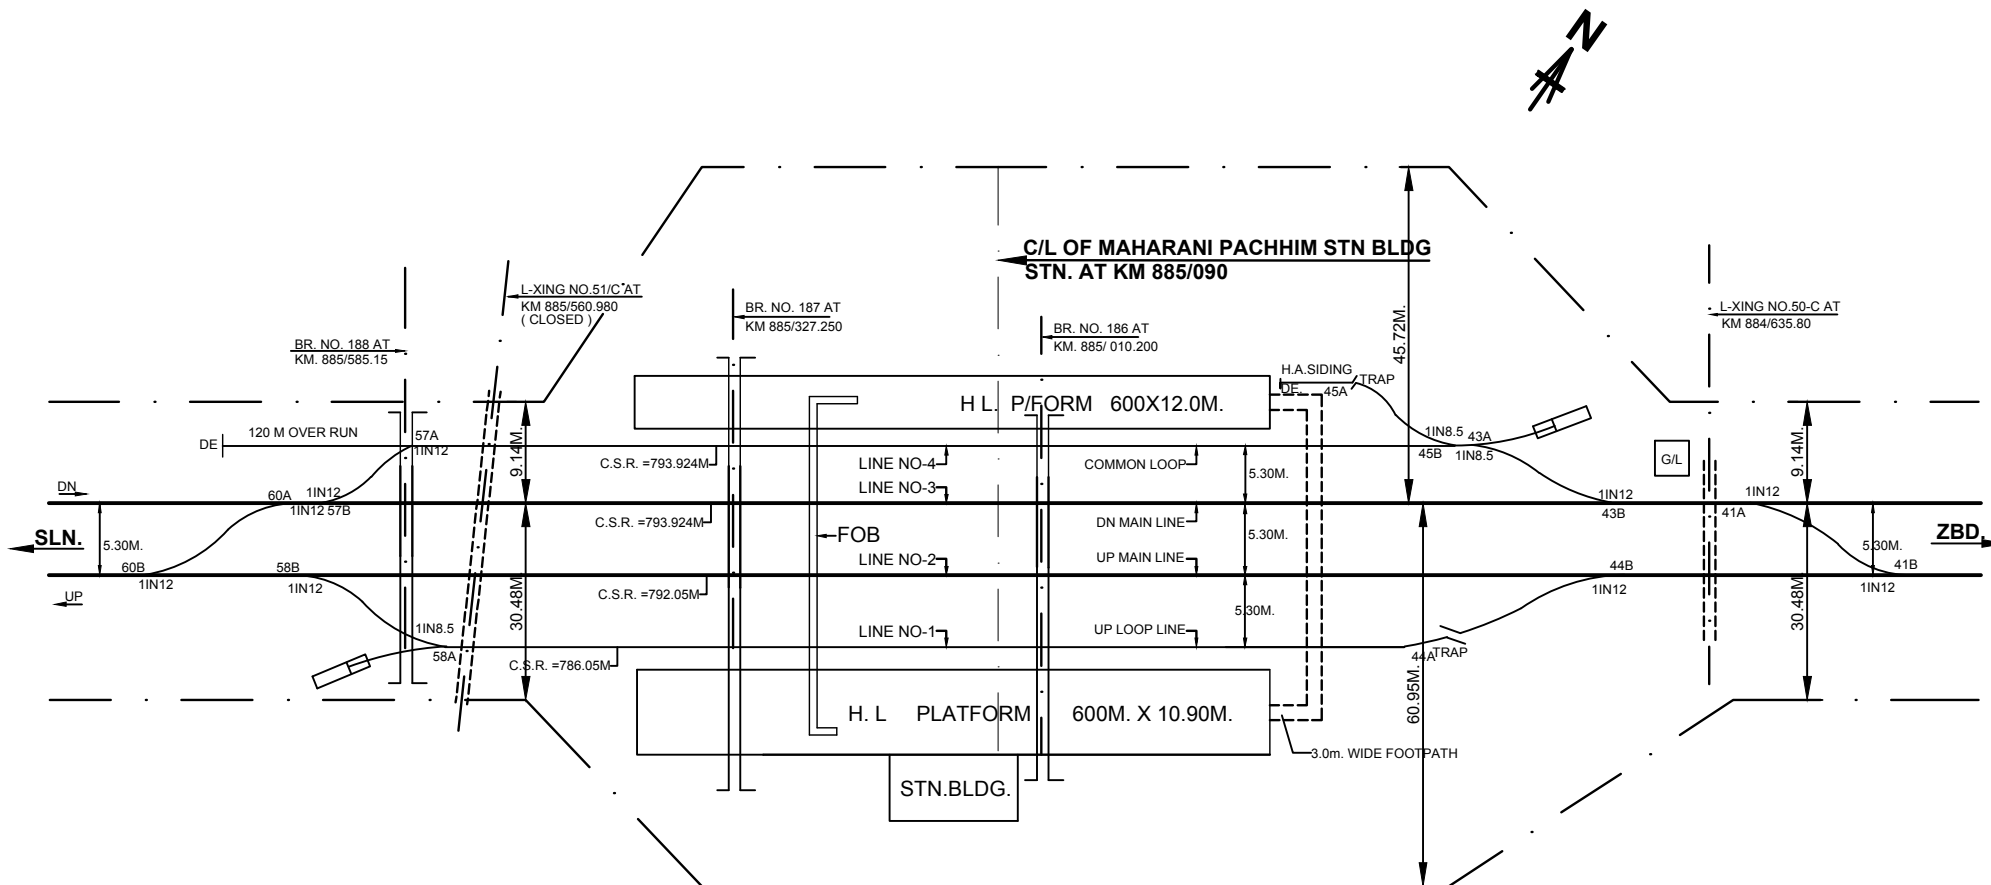


NORTHERN RAILWAY LUCKNOW DIVISION	
LKO -SLN-ZBD SECTION	
DIAGRAM OF	
MAHARANI PACHHIM STN. YARD.	
R.L./M.S.L. 107.665m	NOT TO SCALE
N.R. D.R.M. LKO. SKETCH NO.	278 - 06

CHECKED BY		Sr. DEN/(IV)					
DRAWN BY		ADEN/SLN-II					
		CORRECTED UPTO	18-02-2020				

S. No.	DESCRIPTION	REMARKS	S. No.	DESCRIPTION	AREA (Sq.m.)
1	LAVATORIES	LAV. URINAL	1	AREA OF PLATFORM SHELTER	-
		LADIES 1		P/F No.1	-
		GENTS 1		P/F No.2	-
2	NO OF WATER TAPS/HAND PUMPS ON EACH PLATFORM	TAPS H.P.	2	TOTAL AREA OF PLATFORM	3325.0
		P/F No. 1 2		PLATFORM NO. 1	-
		P/F No. 2		PLATFORM NO. 2	-
3	SOURCE OF WATER SUPPLY	WELL	3	AREA OF WAITING ROOM	NIL
4	YEAR OF CONSTRUCTION OF STATION BUILDING	-		I - UPPER CLASS WAITING ROOM	-
5	BOOKING OFFICE NO. OF WINDOWS	ADV. RES. CURRENT RES.		II - AREA OF WAITING ROOM	-
		P/F No.1 P/F No.2		a - LADIES	-
6	NO. OF SEATS	26		b - GENTS	42.26
		-		III - WAITING HALL	-
7	WHETHER ENQUIRY OFFICE PROVIDED OR NOT	NIL	4	CIRCULATING AREA	-

REF.	FENCING	KUTCHA PUCCA
	ROAD	METALLED UNMETALLED

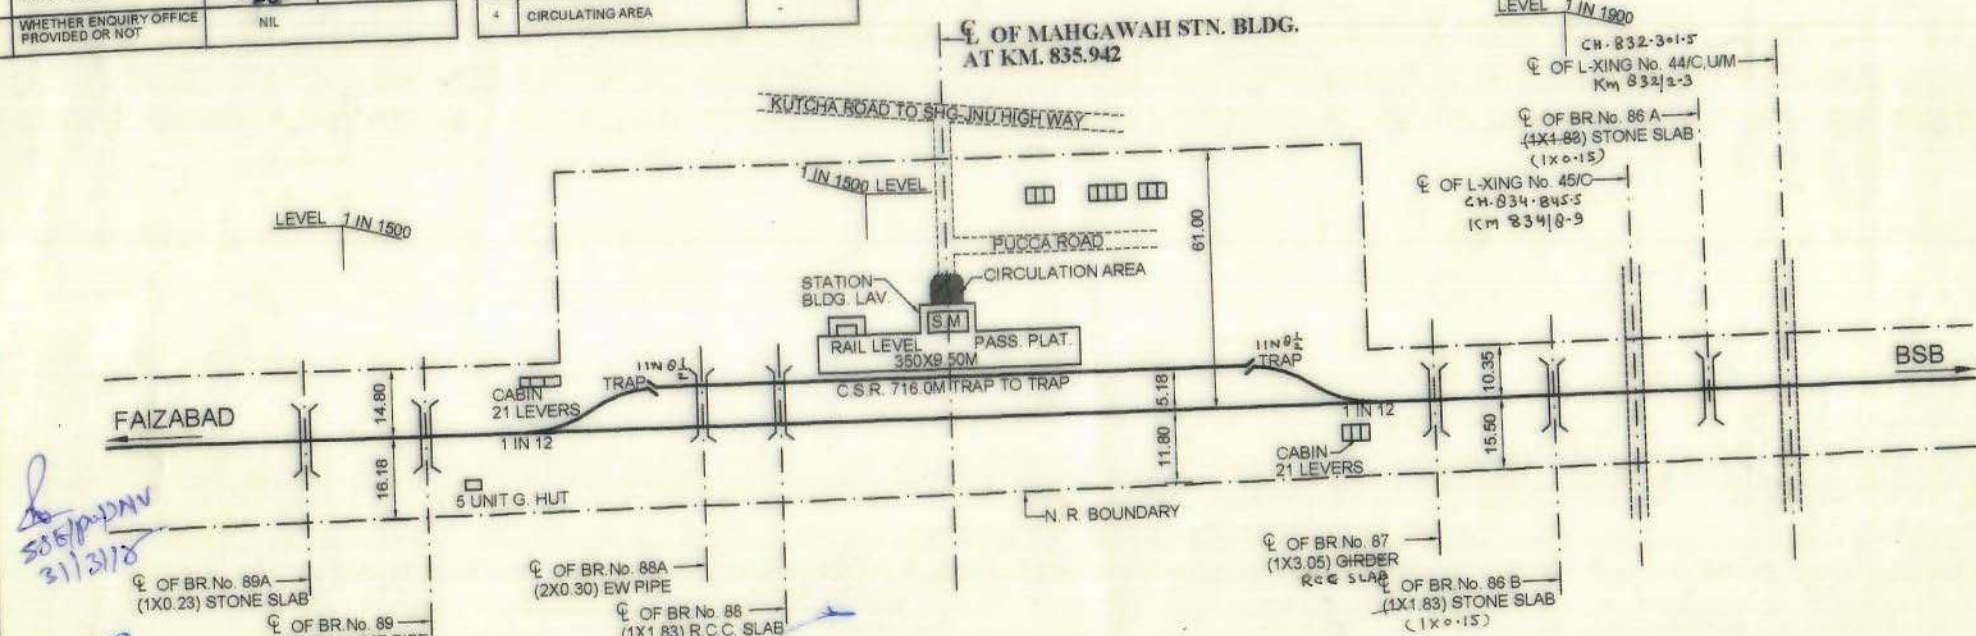


SSE/PWAY/JNU
 31-3-12
 corrected upto
 31-3-12
 31-03-2013

CHECKED BY	SSE/PWAY/JNU
DRAWN BY	DAKSH

Sr. D.E.N (III)	ADEN/JNU	CORRECTED UPTO
31-03-12	31-3-13	31-3-14
31-3-15	31-3-2016	31-03-2018


NORTHERN RAILWAY LUCKNOW DIVISION LKO-FD-BSB SECTION DIAGRAM OF MAHGAWAH STN: YARD
NOT TO SCALE
R.L. M.S.L.
N.R. DIVL. SKETCH NO: M 197/LKO/2012

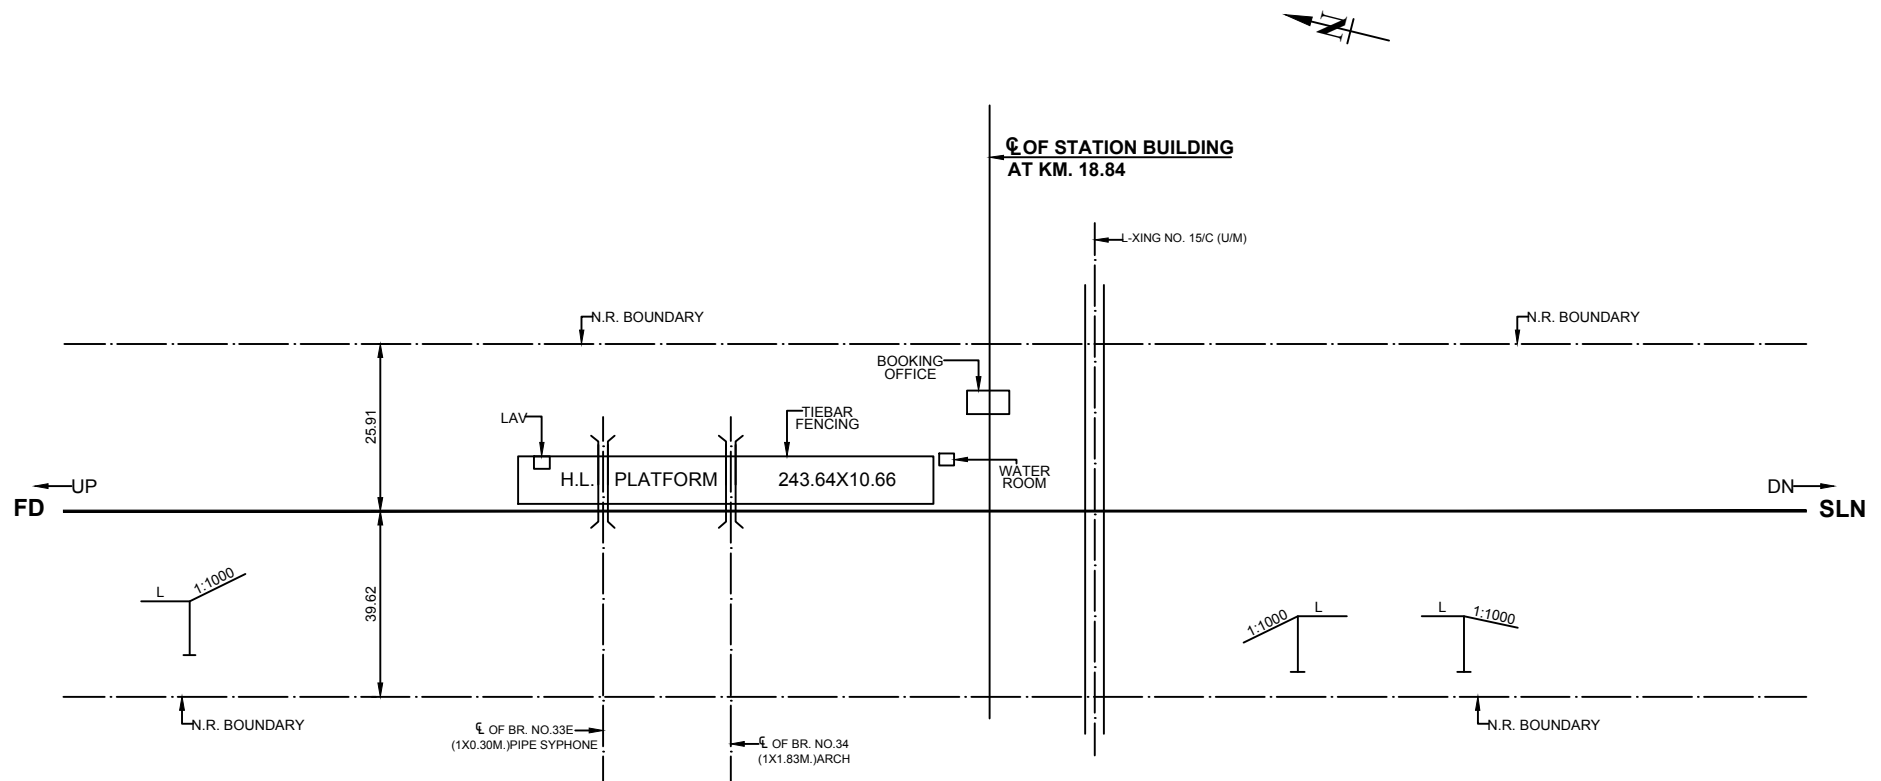

NORTHERN RAILWAY	
LUCKNOW DIVISION	
FD-SLN-ALD SECTION	
DIAGRAM OF	
MALETHUKANAK STN. YARD	
R.L./M.S.L.	NOT TO SCALE
N.R. D.R.M. LKO. SKETCH NO.	318-06

CHECKED BY	
DRAWN BY	

ADEN/PRG		Sr.DEN/(IV)			
CORRECTED UPTO	18-02-2020				

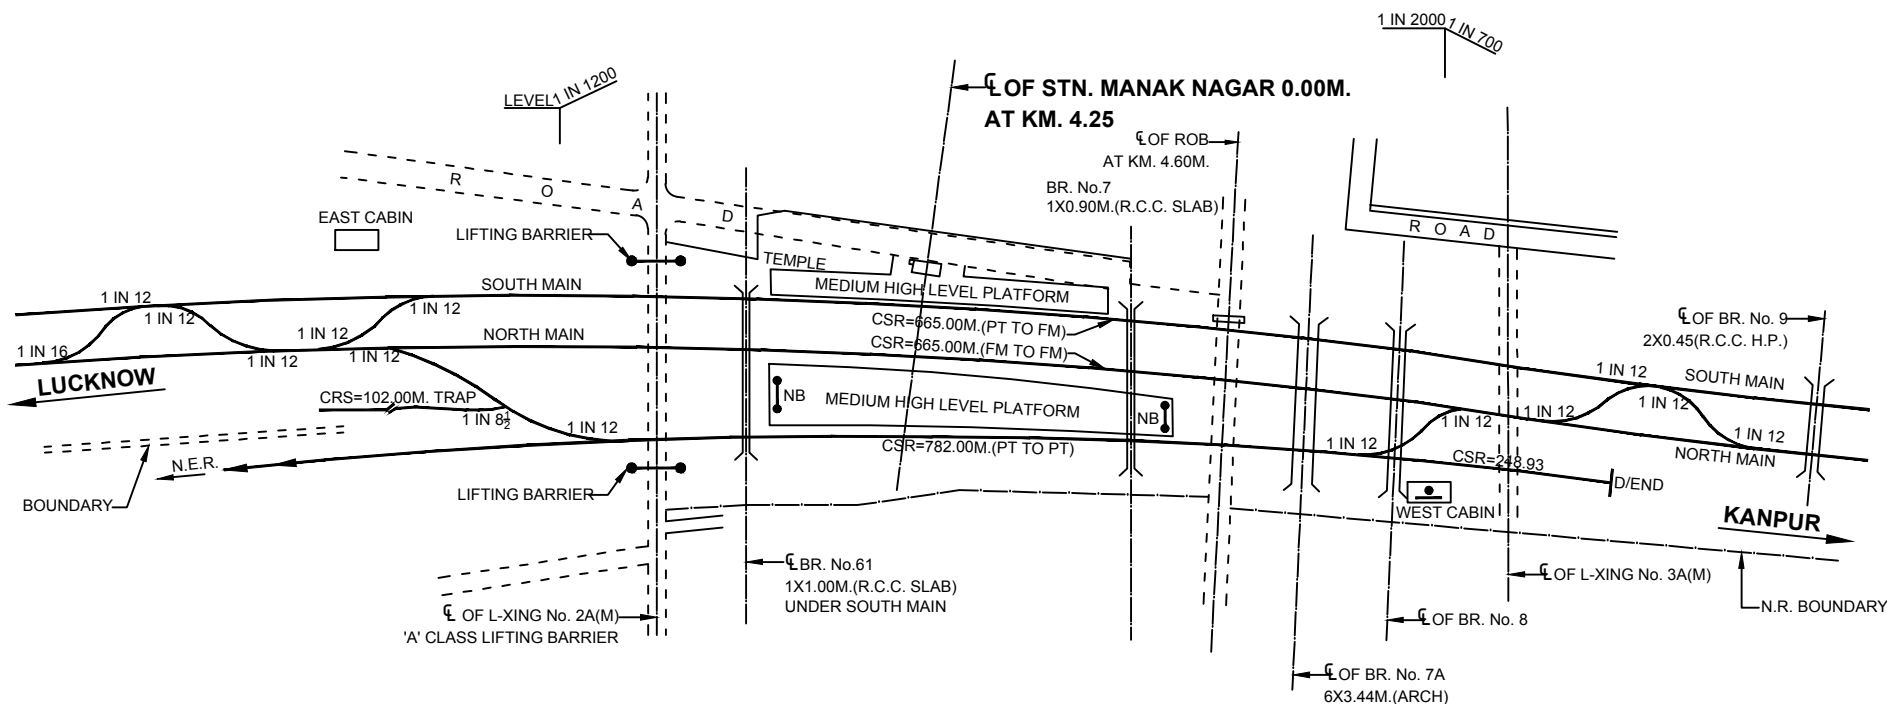


NORTHERN RAILWAY	
LUCKNOW DIVISION	
LKO-ON-CNB SECTION	
DIAGRAM OF	
MANAK NAGAR YARD	
R.L./M.S.L.	NOT TO SCALE
N.R. D.R.M. LKO. SKETCH NO.	

CHECKED BY		Sr. DEN/(V)					
		ADEN/III/LKO					
		CORRECTED UPTO	16-10-2020				
DRAWN BY							

S. No.	DESCRIPTION	REMARKS	S. No.	DESCRIPTION	AREA (Sq. M.)
1	LAVATORIES	LAV URINAL	1	AREA OF PLATFORM SHELTER	3
		LADIES		PF No.1	
		GENTS		PF No.2	
2	NO OF WATER TAPS/HAND PUMPS ON EACH PLATFORM	PF No. TAPS H.P.	2	TOTAL AREA OF PLATFORM PLATFORM NO. 1 PLATFORM NO. 2	812.00
	SOURCE OF WATER SUPPLY		3	AREA OF WAITING ROOM 1-UPPER CLASS WAITING ROOM 2-AREA OF WAITING ROOM 3-LADIES 4-GENTS 5-WAITING HALL	10.00
	YEAR OF CONSTRUCTION OF STATION BLDG.		4	CIRCULATING AREA	
3	BOOKING OFFICE NO. OF WINDOWS	ADV. RES. CURRENT RES.			
4	NO. OF SEATS	PF No.1 PF No.2			
5	WHETHER ENQUIRY OFFICE PROVIDED OR NOT	YES			

REF. FENCING { KUTCHA
PUCCA
ROAD { METALLED
UNMETALLED

→ Z

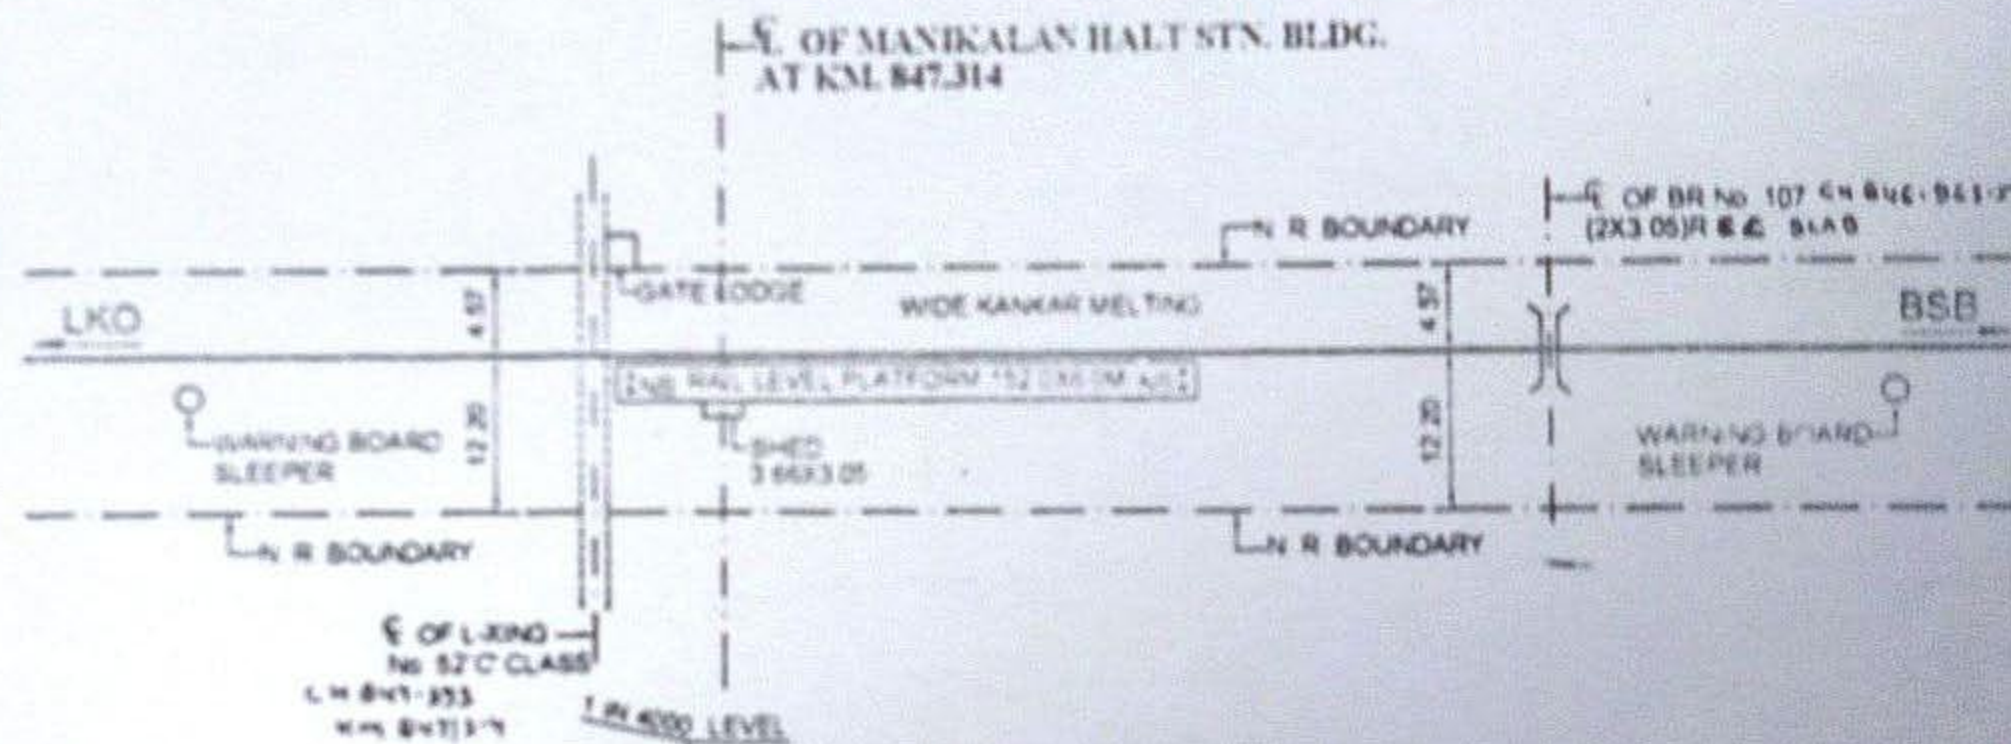

SSS/MDNU
31/3/12

SSS/MDNU

SSE(W)JNU
31.3.13

Vijay Kumar
SSE(W)JNU

VS:
31.3.2013


SSS/MDNU
21.3.13
SSS/MDNU

Si DEN (R)						
ADENJNU						
CORRECTED UPTO	31-03-12	31-3-13	31-3-14	31-3-15	31-3-16	

NORTHERN RAILWAY LUCKNOW DIVISION	
LKO-FD-BSB SECTION	
DIAGRAM OF MANIKALAN STN: YARD	
R.L. MAL	NOT TO SCALE
NR INVL. SKETCH NO. M. 192/KO-2011	



C/L OF MANJHLEPUR STN.
AT KM. 83.59

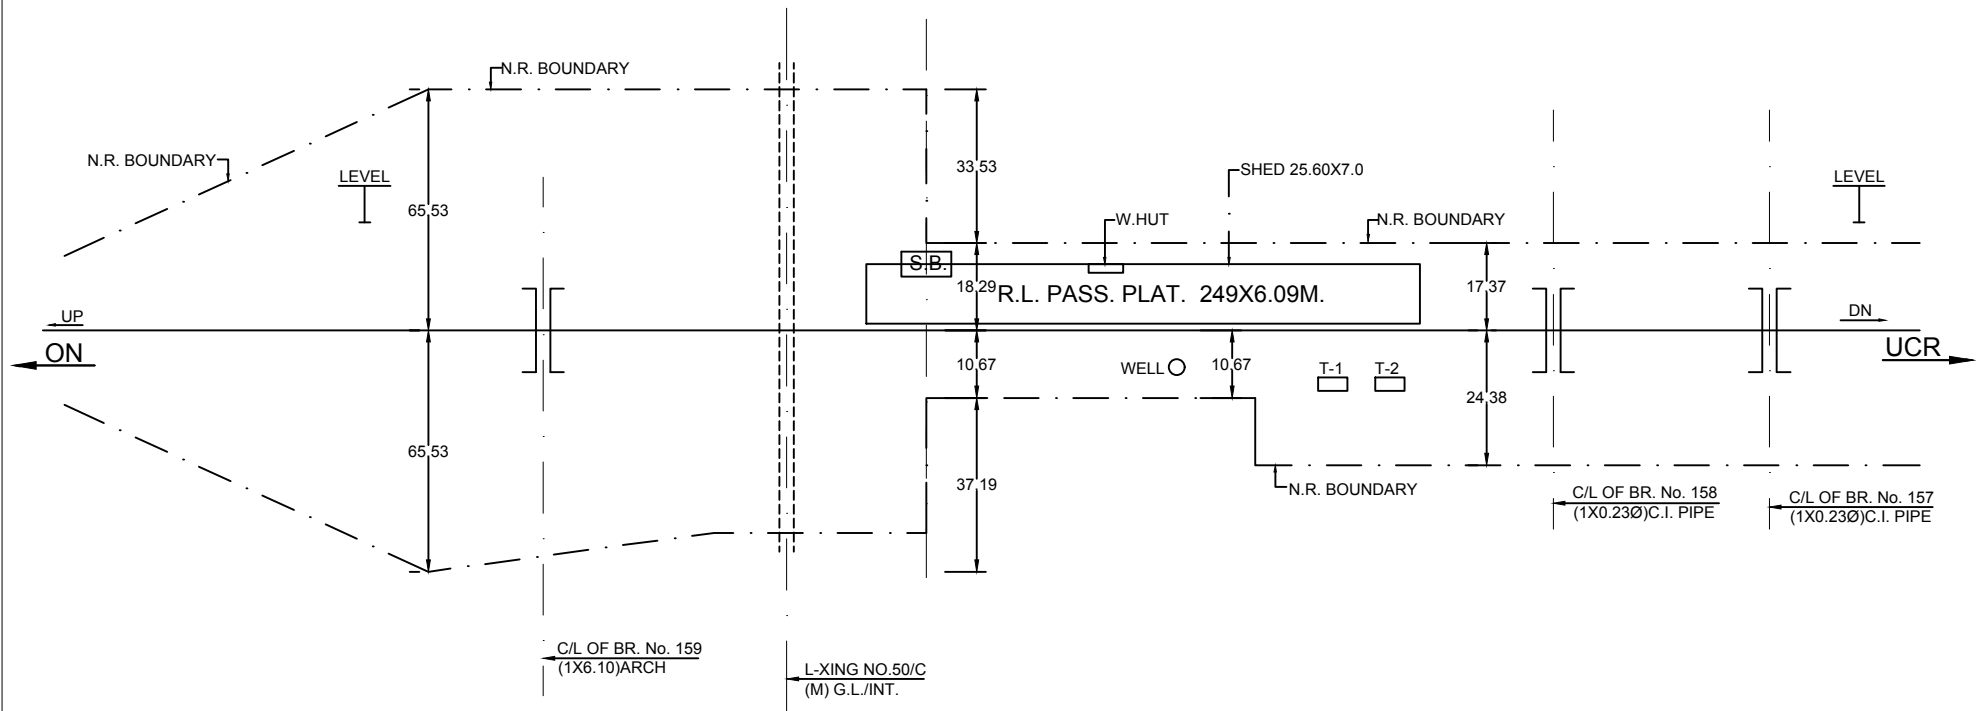


NORTHERN RAILWAY	
LUCKNOW DIVISION	
PFM-UCR-ON SECTION	
DIAGRAM OF	
MANJHLEPUR STN. YARD	
R.L./M.S.L. 107.500m	NOT TO SCALE
N.R. D.R.M. LKO. SKETCH NO.	312-06


CHECKED BY	
DRAWN BY	

Sr. DEN/(IV)					
ADEN/PRG					
CORRECTED UPTO	18-02-2020				

MARIAHU

CLASS- 'B'. STD.I MACL. Signalling.
WORKING RULE DIAGRAM

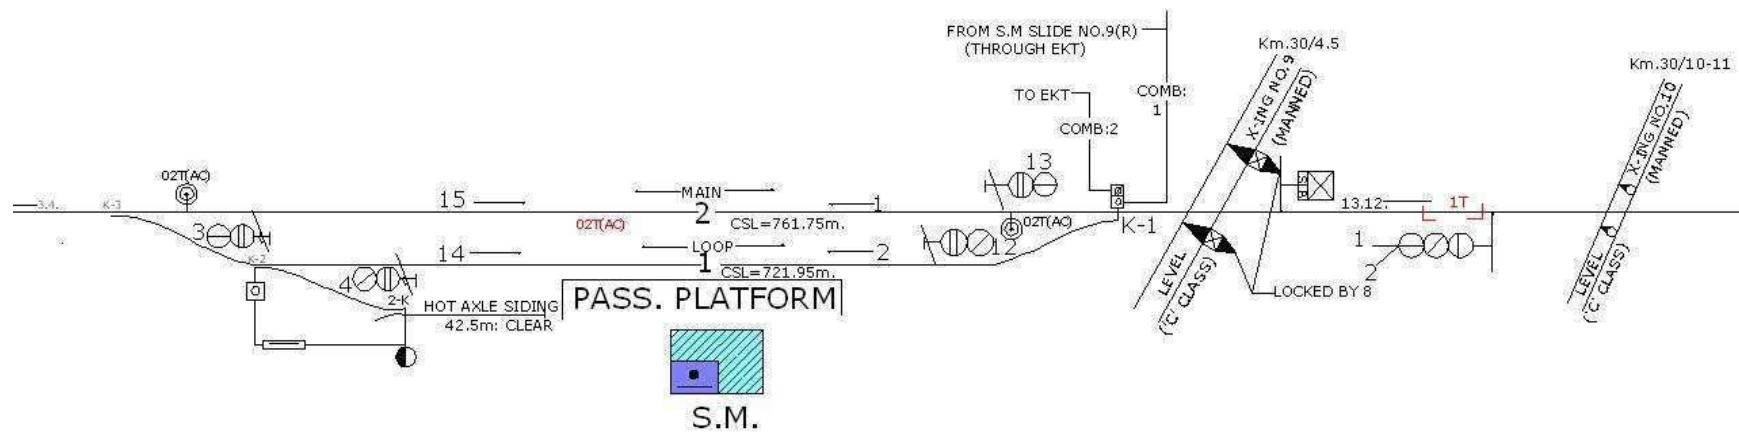

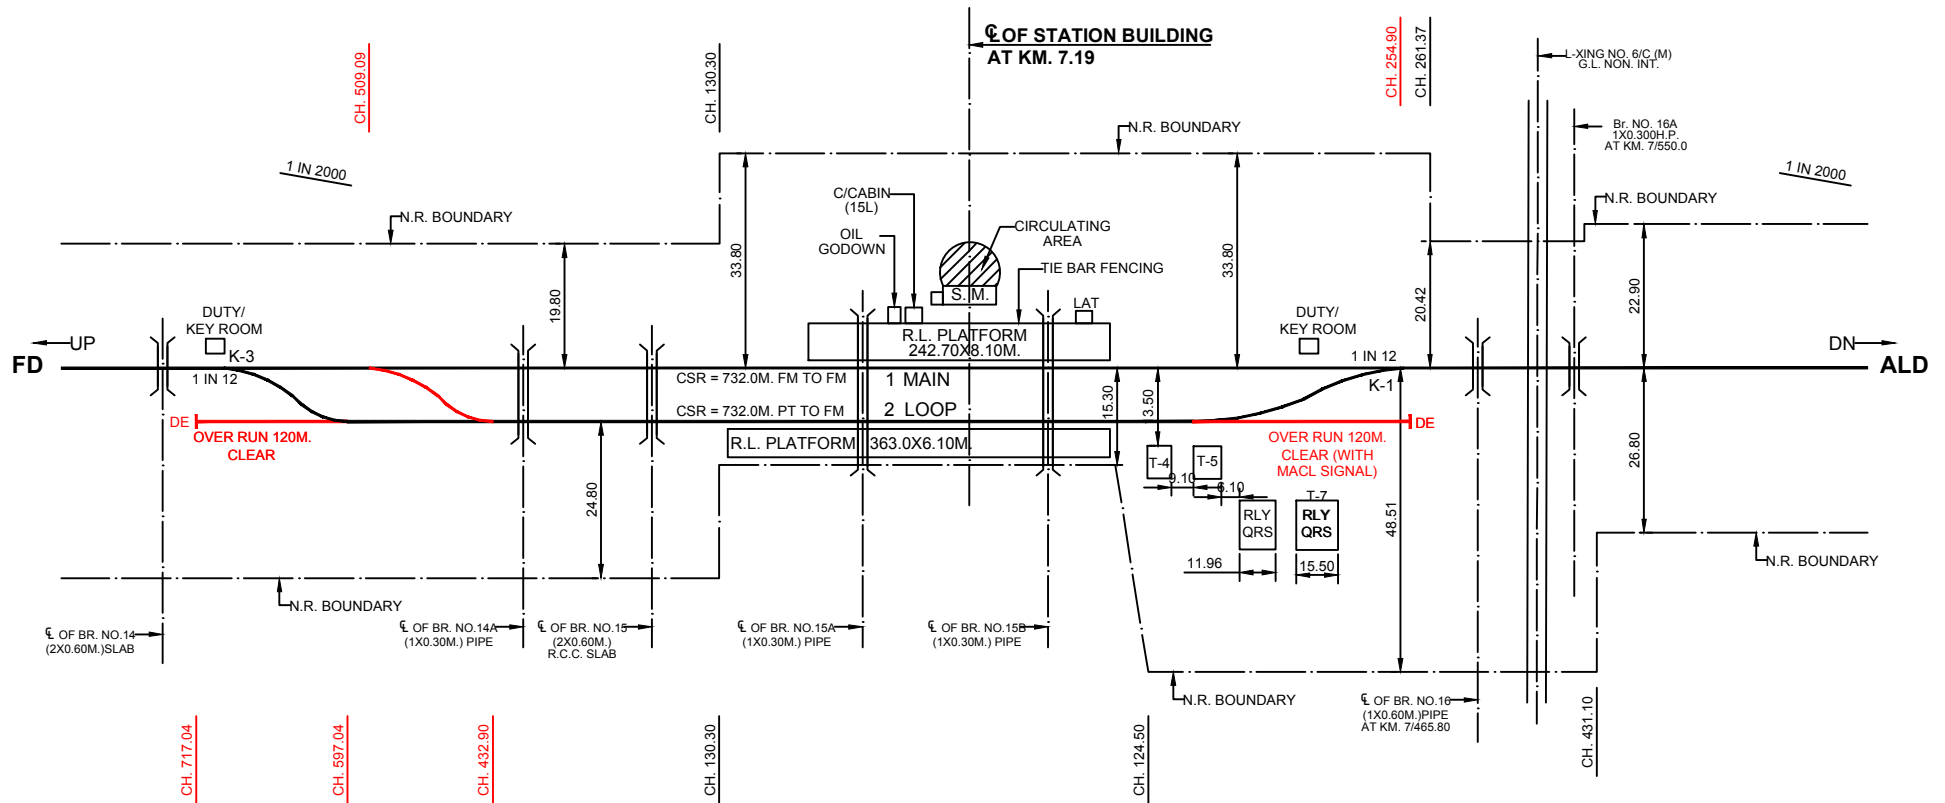

**NORTHERN RAILWAY
LUCKNOW DIVISION**

FD-SLN-ALD SECTION

**DIAGRAM OF
MASODHA STN. YARD**

CHECKED BY

DRAWN BY

ADEN/PRG

CORRECTED UPTO

18-02-2020


Sr.DEN/(IV)

R.L./M.S.L.

N.R. D.R.M. LKO. SKETCH NO.

NOT TO SCALE

316-06

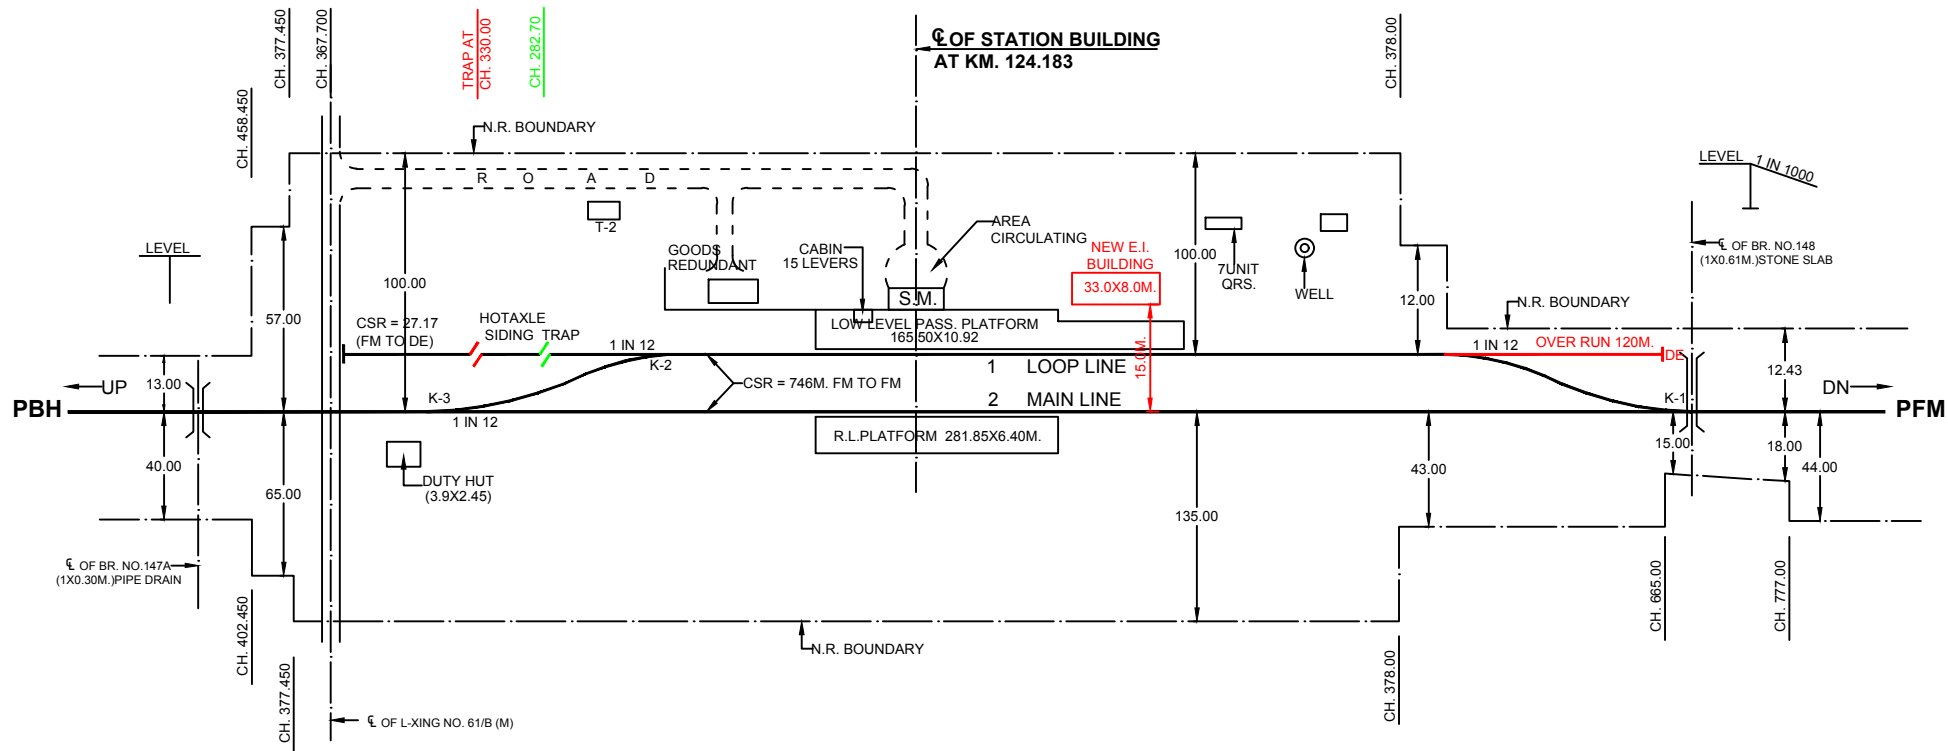

NORTHERN RAILWAY
LUCKNOW DIVISION
FD-SLN-FM SECTION
DIAGRAM OF
MAUAIMMA STN. YARD

CHECKED BY	
DRAWN BY	


ADEN/PRG		Sr.DEN/(IV)			
CORRECTED UPTO	18-02-2020				

R.L./M.S.L.	NOT TO SCALE
N.R. D.R.M. LKO. SKETCH NO.	329-06

S. No.	DESCRIPTION	AREA (Sq.m.)
1	AREA OF PLATFORM SHELTER	- -
	P/F No.1 P/F No.2	- -
	<u>TOTAL AREA OF PLATFORM</u>	
2	PLATFORM NO 1	3862.70
	PLATFORM NO 2	3494.30
3	AREA OF WAITING ROOM I- UPPER CLASS WAITING ROOM II - AREA OF WAITING ROOM a- LADIES b- GENTS III- WAITING HALL	NIL - - 120.00
4	CIRCULATING AREA	-

S. No.	DESCRIPTION	AREA (Sq.m.)
1	AREA OF PLATFORM SHELTER	- -
	P/F No.1 P/F No.2	- -
	<u>TOTAL AREA OF PLATFORM</u>	
2	PLATFORM NO 1	3862.70
	PLATFORM NO 2	3494.30
3	AREA OF WAITING ROOM I- UPPER CLASS WAITING ROOM II - AREA OF WAITING ROOM a- LADIES b- GENTS III- WAITING HALL	NIL - - 120.00
4	CIRCULATING AREA	-

ROAD { METALLED
UNMETALLED

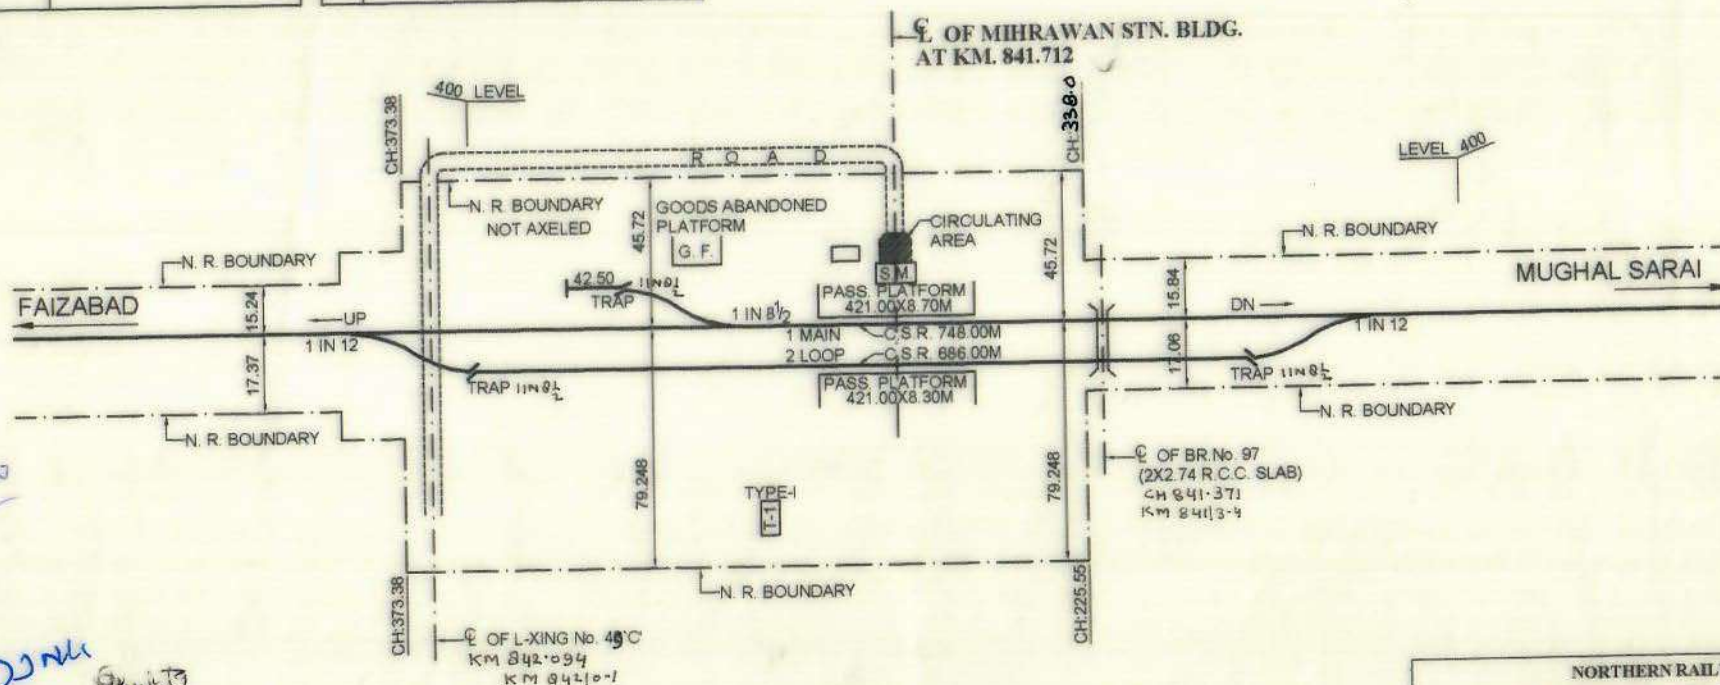

885/PM/DMW
3/13/18

HP
SSE(W) 2nd
31.3.13
WS
31.3.2013
RKS

5/11/20

V. Singh
S.S.W. / N.W.

Sr. D.E.N.(III)						
ADEN/JNU	31-03-12	31-3-13	31-3-14	31-3-15	31-3-2016	31-03-2018
CORRECTED UPTO	31-03-12	31-3-13	31-3-14	31-3-15	31-3-2016	31-03-2018

NORTHERN RAILWAY
LUCKNOW DIVISION
LKO-FD-BSB SECTION
DIAGRAM OF
MIHRAWAN STN: YARD


R.L./M.S.L.	NOT TO SCALE
N.R. DIVL. SKETCH NO: M-198/LKO/2012	

MISRAULI STATION YARD



LEGEND:-

EXISTING WORK	—
PROPOSED WORK	—
DISMANTLED WORK	—
FUTURE WORK	—

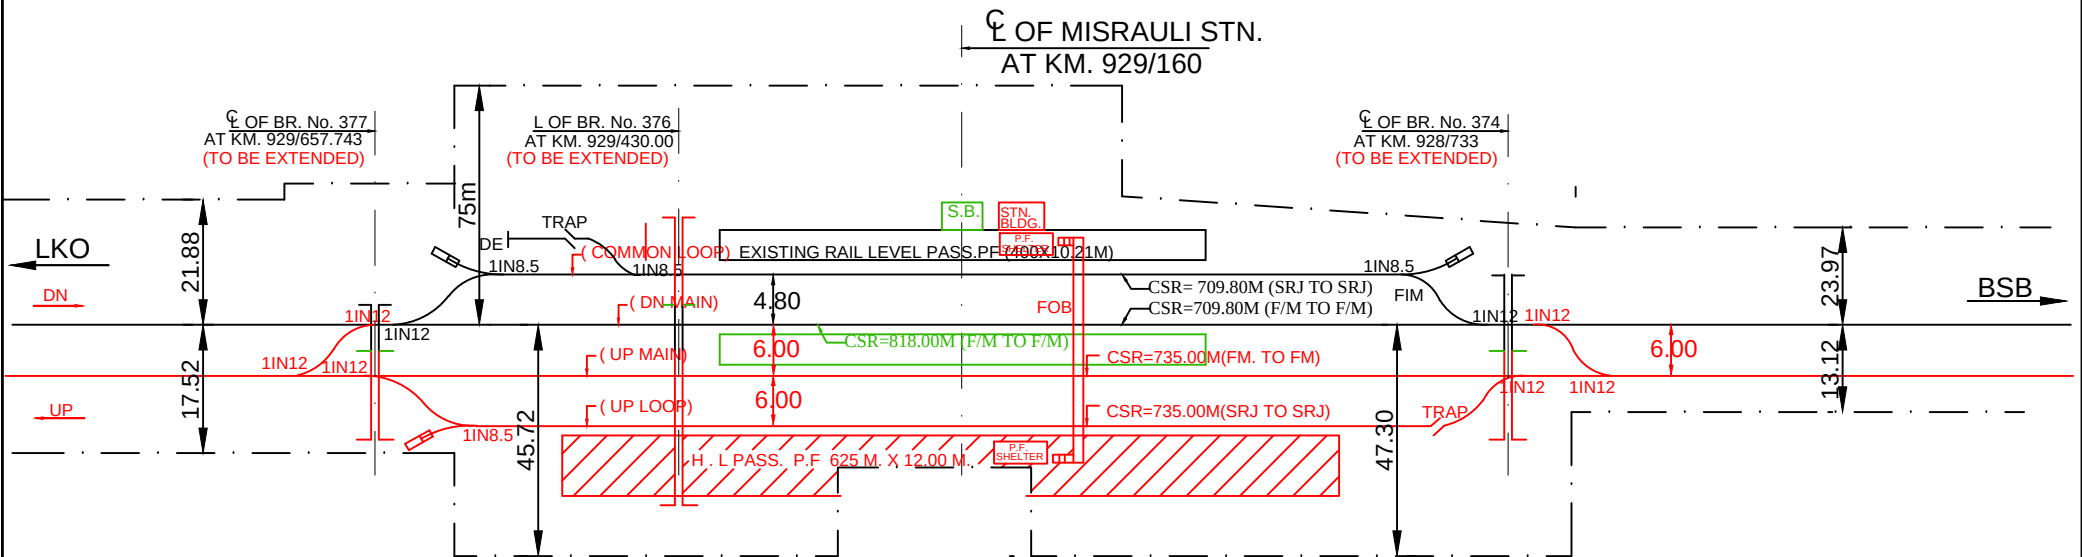

P.way work:

Sr.NO.	Name of Item	To be Dismantled	To be laid
1.	1 in 12 T/out	00	06
2.	1 in 8.5 T/out	00	01
3.	Trap	00	01
4.	Double Dimond	00	00
5.	Dead End	00	00
6.	Sand Hump	00	01
7.	Track (in KM)	00	0.80

(Except Main line)

Facility to be provided:

Sr.NO.	Facility
1.	New H.L. End PF no.2 (625mX12.00)
2.	New F.O.B 3m wide (To cover PF 1 to PF 2)
3.	One new line as line no. 1 with CSR 749.10m
4.	One 350m long Machine siding at Lucknow end.


Detail of traffic movement:

Sr.NO.	Movement	To Line no.
1.	From Lucknow	3 & 4
2.	From Varanasi	1 & 2

NORTHERN RAILWAY
LUCKNOW DIVISION
MISRAULI STATION YARD
AMETHI-JANGHAI DOUBLING (87 KM)

CL OF MOHANLALGANJ STN. BLDG. Km: 1052.546

CH: 0.00

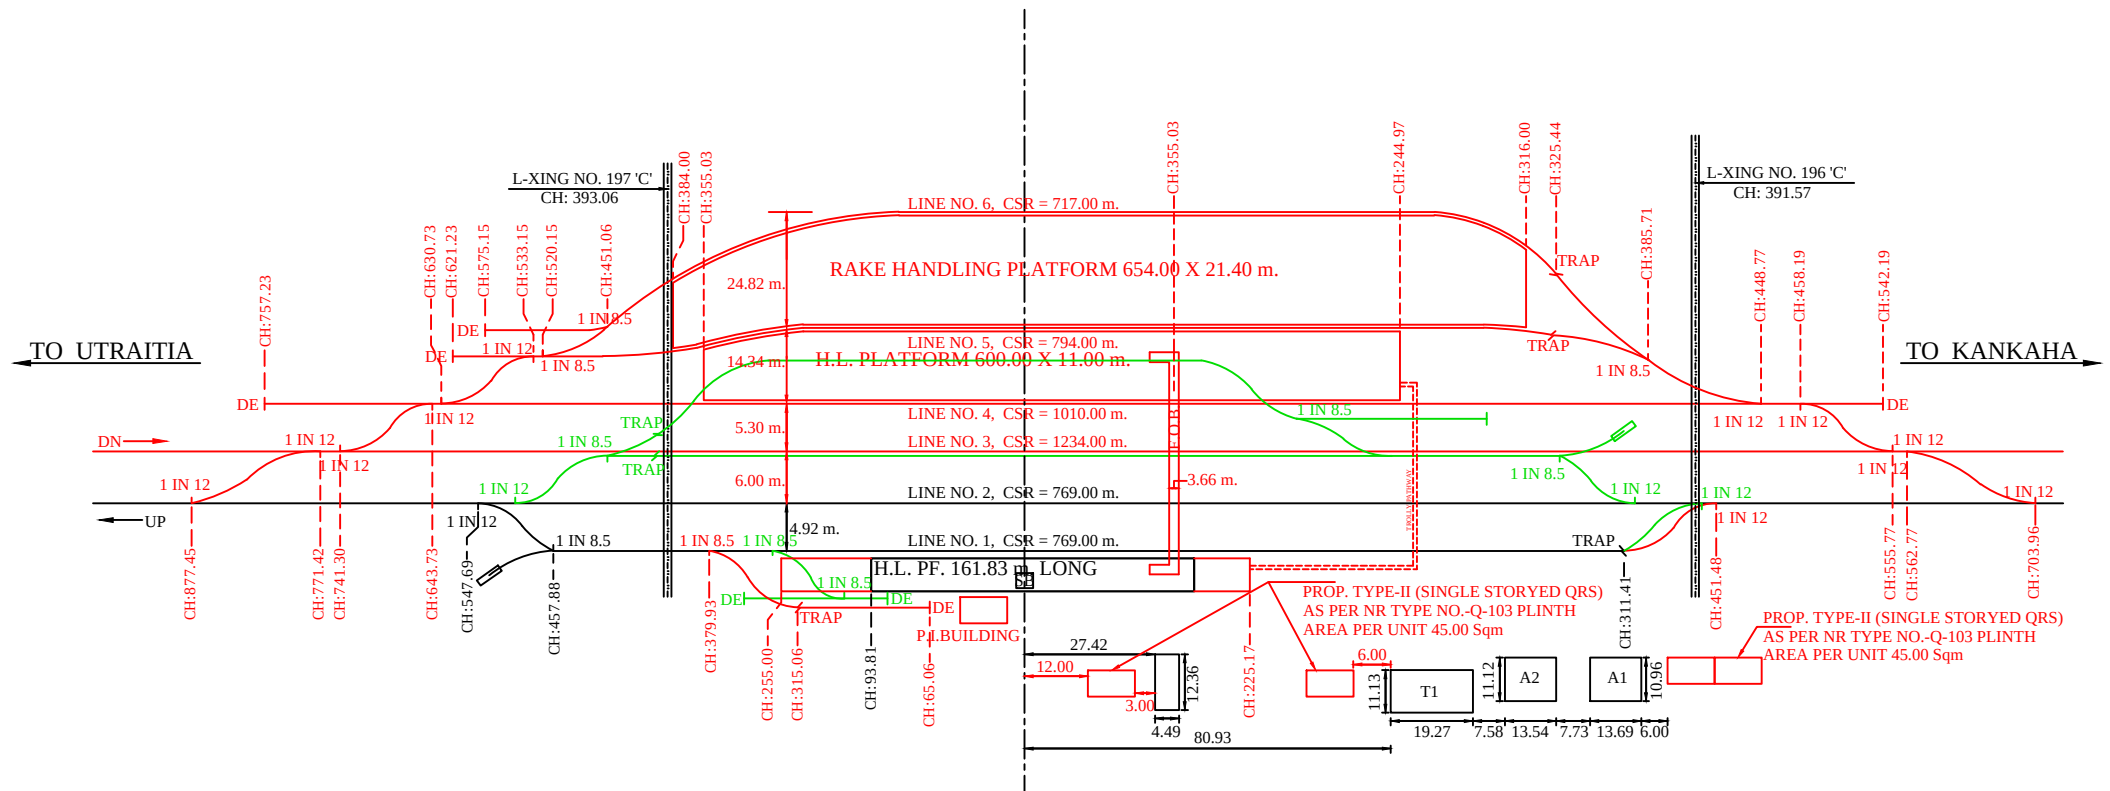

LEGEND:-


1. EXISTING WORK SHOWN THUS _____
2. PROPOSED WORK SHOWN THUS _____
3. DISMENTLING WORK SHOWN THUS _____
4. THIS DRAWING IS NOT TO SCALE _____

S.No	DESCRIPTION	1 in 12	1 in 8½	TRAP
1.	DISMANTLING OF TURN OUT	3	5	2
2.	INSERTION OF TURN OUT	11	4	3



MOHANLALGANJ STATION YARD

MONDH STATION
NOT TO SCALE

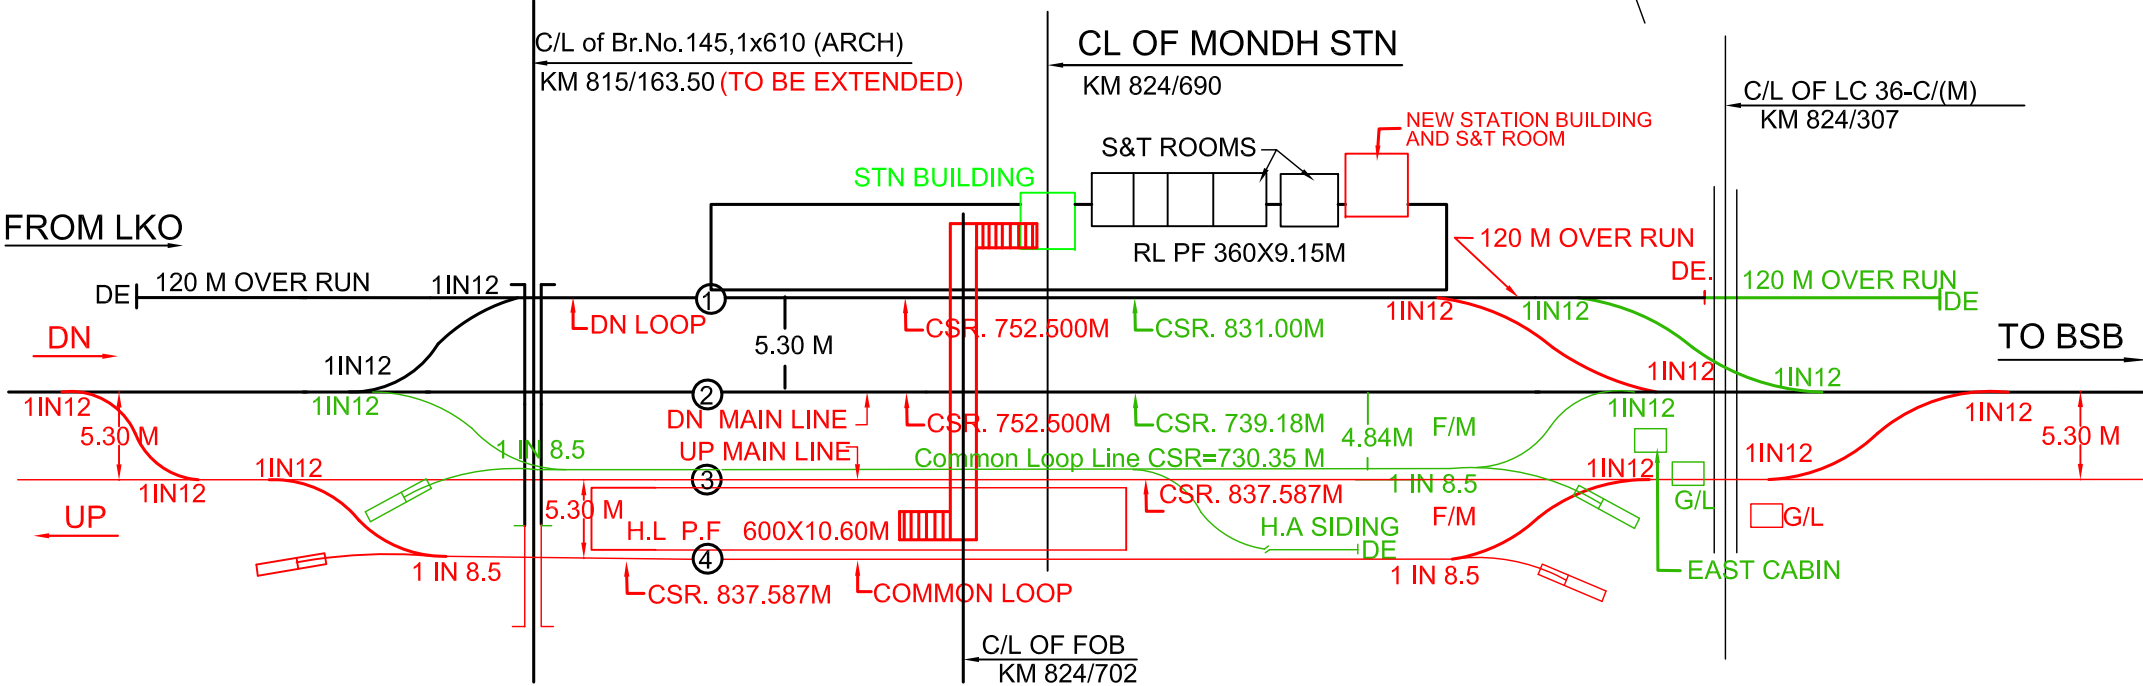


NIBHAPUR STATION YARD



LEGEND:-

EXISTING WORK	—
PROPOSED WORK	—
DISMANTLED WORK	—
FUTURE WORK	—

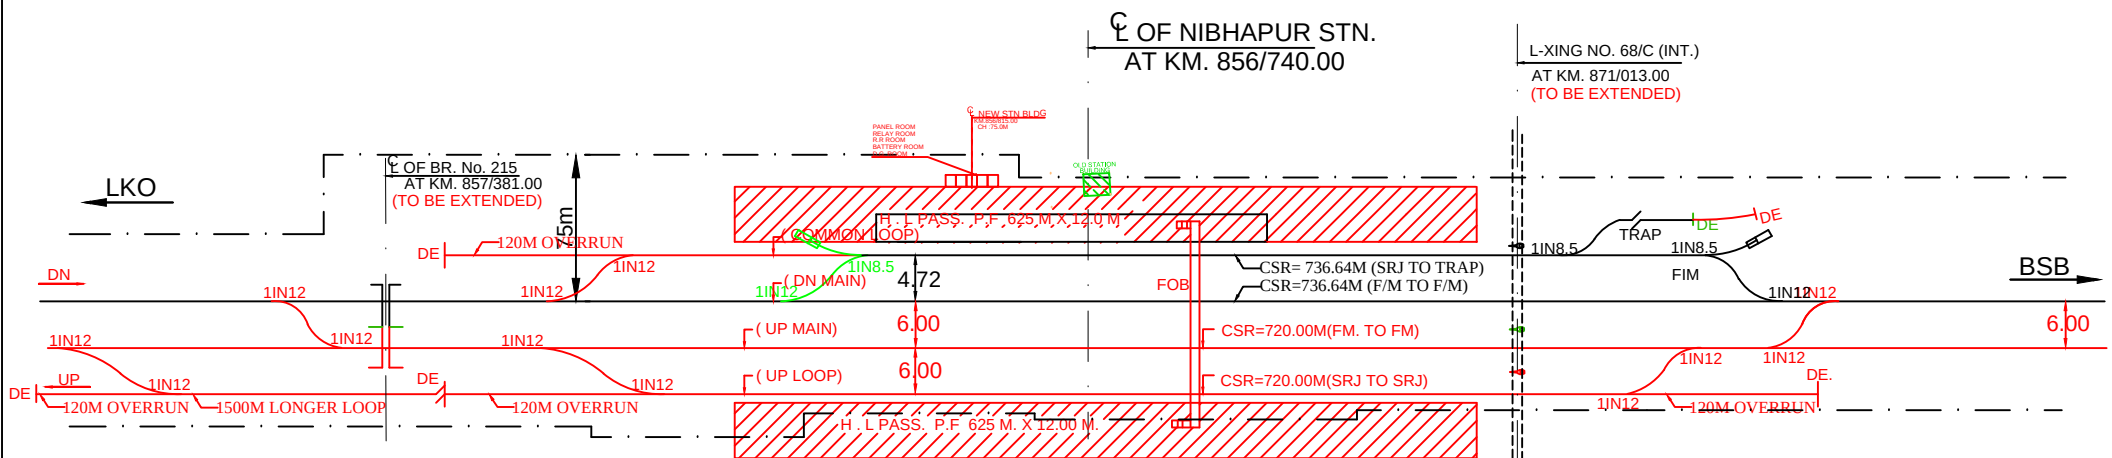

P.way work:

Sr.NO.	Name of Item	To be Dismantled	To be laid
1.	1 in 12 T/out	01	10
2.	1 in 8.5 T/out	01	01
3.	Trap	00	01
4.	Double Dimond	00	00
5.	Dead End	01	04
6.	Sand Hump	01	01
7.	Track (in KM)	1.50	2.0

Facility to be provided:

Sr.NO.	Facility
1.	New H.L. End PF no.1 (625mX12.00)
2.	New H.L. End PF no.2 (625mX12.00)
3.	New F.O.B 3m wide (To cover PF 1 to PF 2)

Detail of traffic movement:

Sr.NO.	Movement	To Line no.
1.	From Lucknow	1 to 4
2.	From Varanasi	3 to 4


NORTHERN RAILWAY
LUCKNOW DIVISION
NIBHAPUR STATION YARD
AMETHI-JANGHAI DOUBLING (87 KM)



- | S.No | DESCRIPTION | 1 in 12 | 1 in $8\frac{1}{2}$ | TRAP |
|------|-------------------------|---------|---------------------|------|
| 1. | DISMANTLING OF TURN OUT | 2 | 2 | 2 |
| 2. | INSERTION OF TURN OUT | 5 | 1 | 2 |
| | | | | |



NIGOHAN STATION YARD

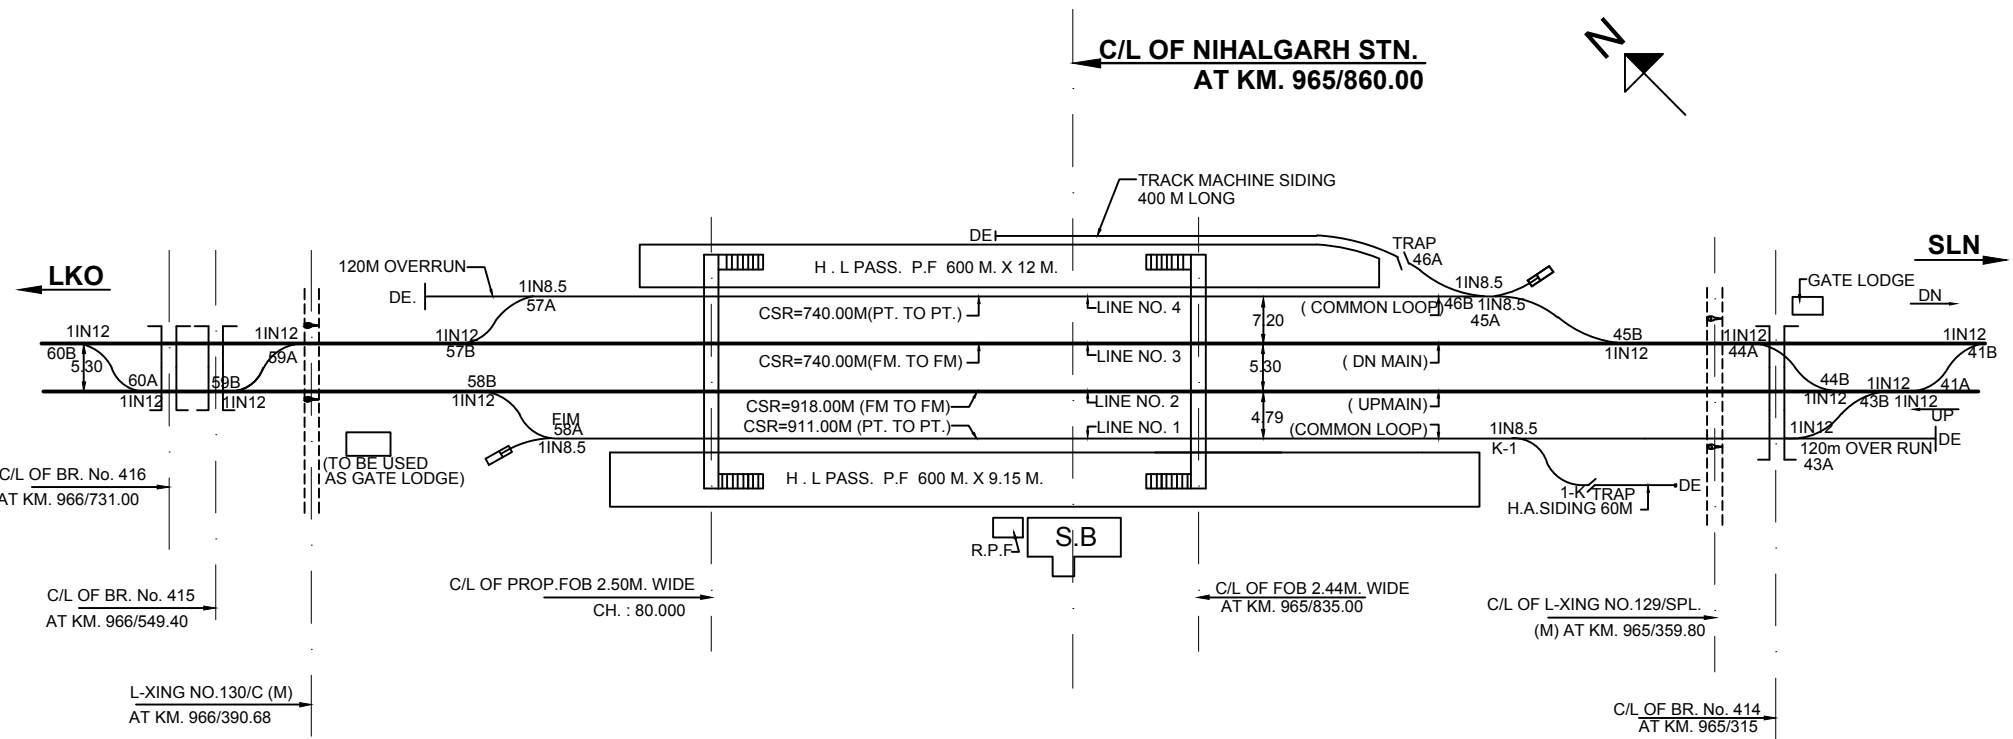

NORTHERN RAILWAY LUCKNOW DIVISION	
LKO -SLN-ZBD SECTION	
DIAGRAM OF	
NIHALGARH STN. YARD	
R.L./M.S.L. 105.530m	NOT TO SCALE
N.R. D.R.M. LKO. SKETCH NO.	277- 06

CHECKED BY	
DRAWN BY	

Sr. DEN(IV)					
ADEN/SLN-I					
CORRECTED UPTO	18-02-2020				


S. No.	DESCRIPTION	REMARKS		
1	LAVATORIES		LAV.	URINAL
		LADIES	-	
		GENTS	-	
2	NO OF WATER TAPS/ HAND PUMPS ON EACH PLATFORM	P/F No.	TAPS	H.P.
		1	-	1
	SOURCE OF WATER SUPPLY	-		
3	YEAR OF CONSTRUCTION OF STATION BUILDING	-		
4	BOOKING OFFICE NO. OF WINDOWS	ADV. RES. -1-	CURRENT RES.	
5	NO. OF SEATS	P/F No.1		
		24		
6	WHETHER ENQUIRY OFFICE PROVIDED OR NOT	-		

S. No.	DESCRIPTION	AREA (Sq.m.)
1.	AREA OF PLATFORM SHELTER P/F No.1	-
2.	TOTAL AREA OF PLATFORM PLATFORM NO. 1	1668.00
3.	AREA OF WAITING ROOM I- UPPER CLASS WAITING ROOM II - AREA OF WAITING ROOM a- LADIES b- GENTS III- WAITING HALL	- - - 1267
4.	CIRCULATING AREA	-

REF.	FENCING	KUTCHA PUCCA	-----
	ROAD	METALLED UNMETALLED	=====




CHECKED BY <i>S. S. L.</i>		Sr. D.E.N.(I)						NORTHERN RAILWAY LUCKNOW DIVISION	
DRAWN BY <i>DAKSH</i>		ADEN/RBL						PFM-UCR-ON SECTION	
		CORRECTED UPTO						DIAGRAM OF	
								NIHASTA HALT STN: YARD	
								R.L./M.S.L.	
								NOT TO SCALE	
								N.R. DIV L. SKETCH NO.	
								M-131/LKO/2012	

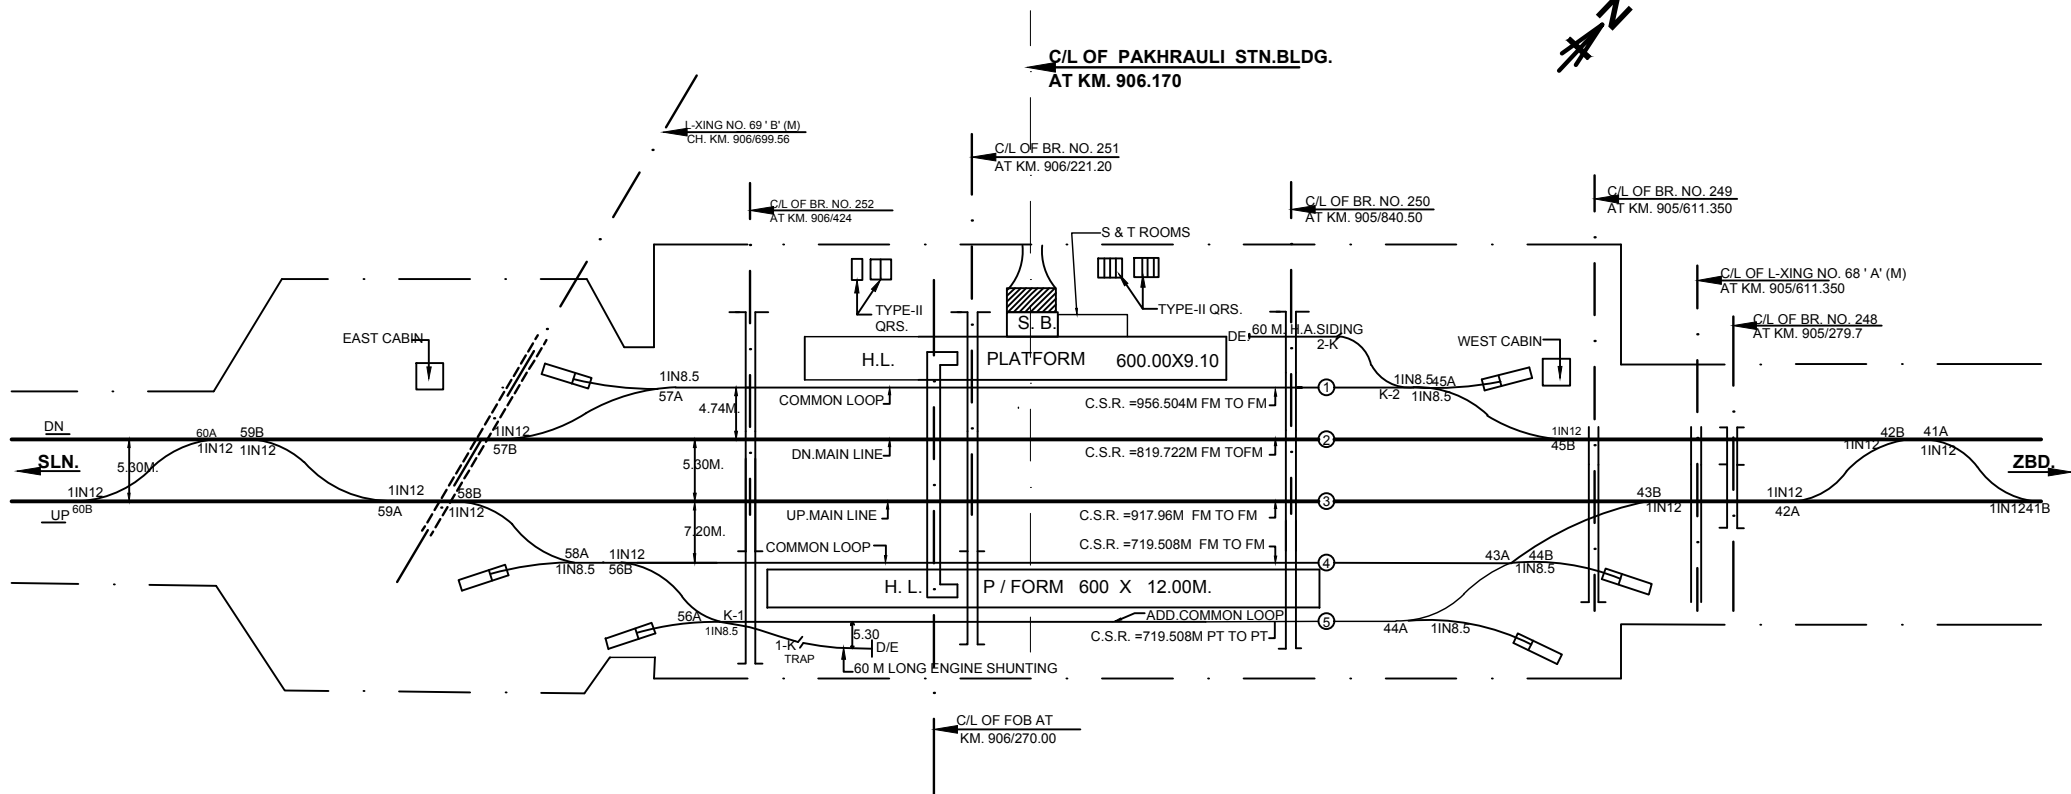

CHECKED BY	
DRAWN BY	

Sr. DEN/(IV)					
ADEN/SLN-II					
CORRECTED UPTO	18-02-2020				

NORTHERN RAILWAY	
LUCKNOW DIVISION	
LKO -SLN-ZBD SECTION	
DIAGRAM OF	
PAKHRAULI STN. YARD.	
R.L./M.S.L. 107.665m	NOT TO SCALE
N.R. D.R.M. LKO. SKETCH NO.	278 - 06

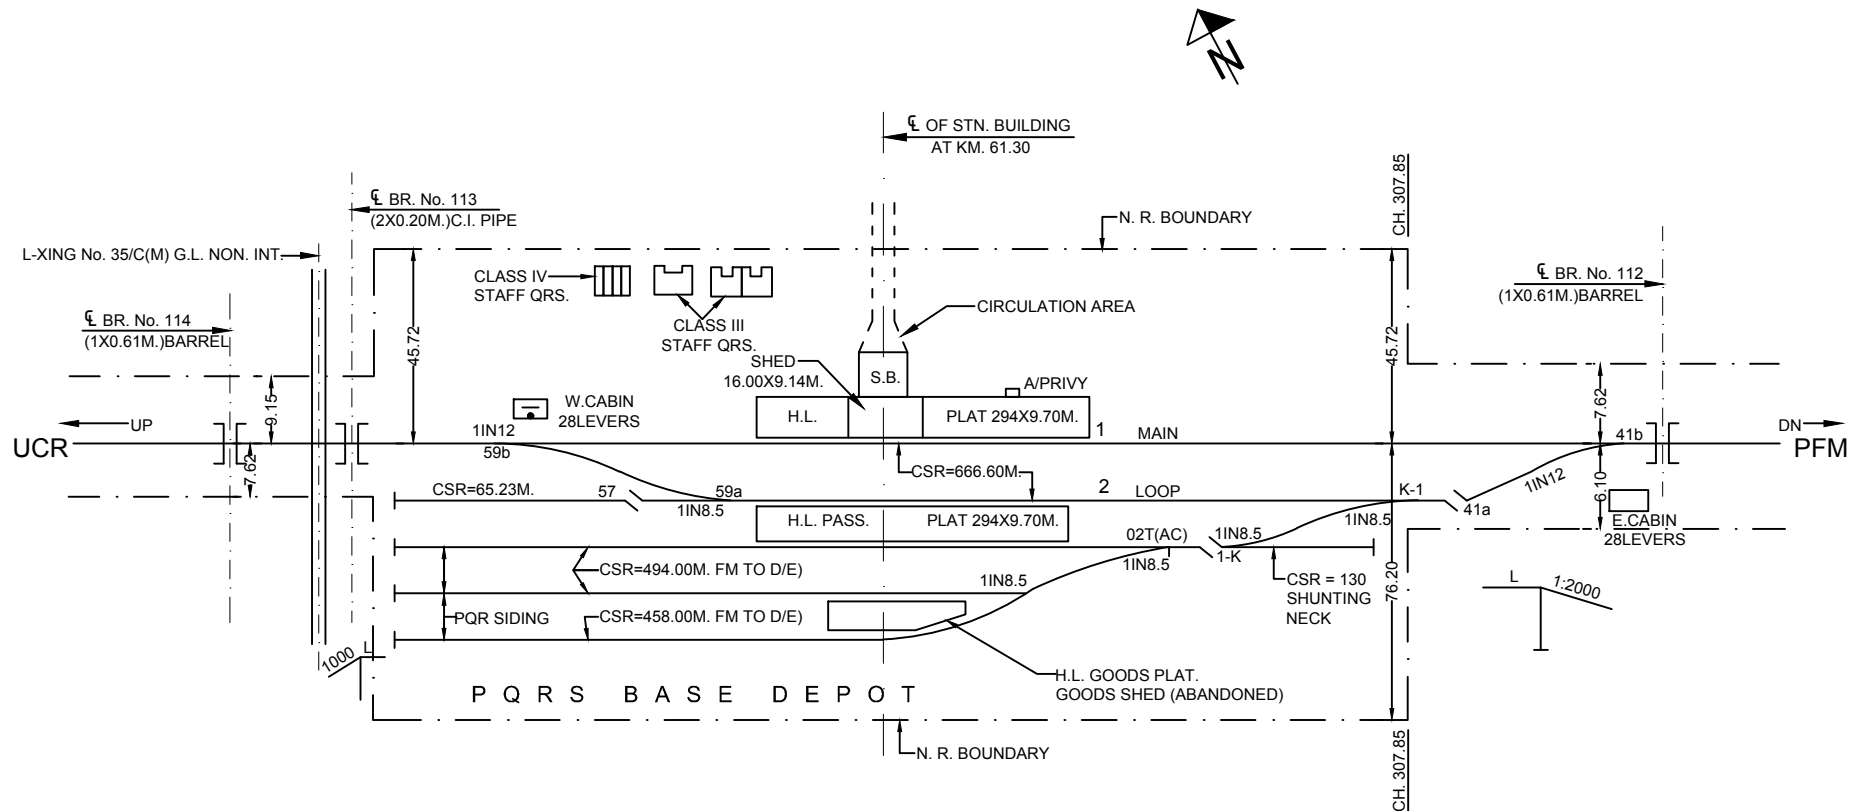


NORTHERN RAILWAY	
LUCKNOW DIVISION	
PFM-UCR-ON SECTION	
DIAGRAM OF	
PARIWAN KALA KANKAR ROAD YARD	
R.L./M.S.L.	NOT TO SCALE
N.R. D.R.M. LKO. SKETCH NO. 308-06	


CHECKED BY	
DRAWN BY	


Sr. DEN/(IV)					
ADEN/PRG					
CORRECTED UPTO	18-02-2020				

PARSIPUR STATION
NOT TO SCALE

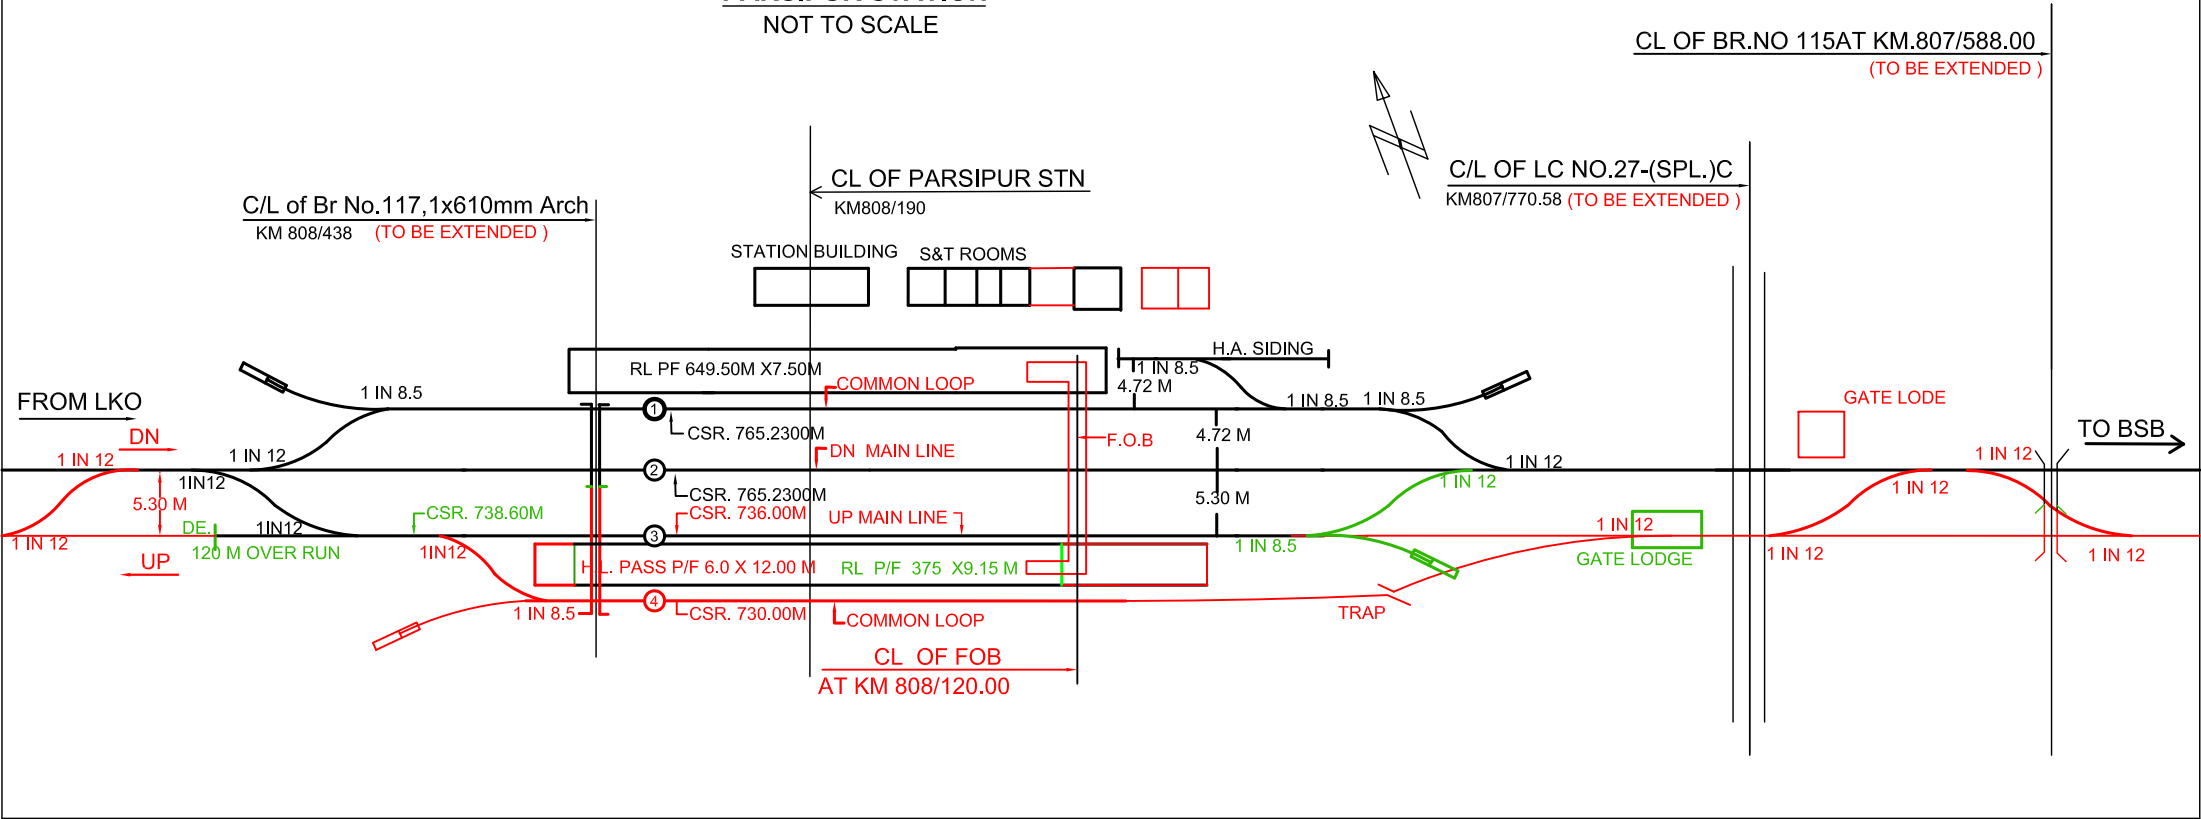

PATRANGA STATION YARD

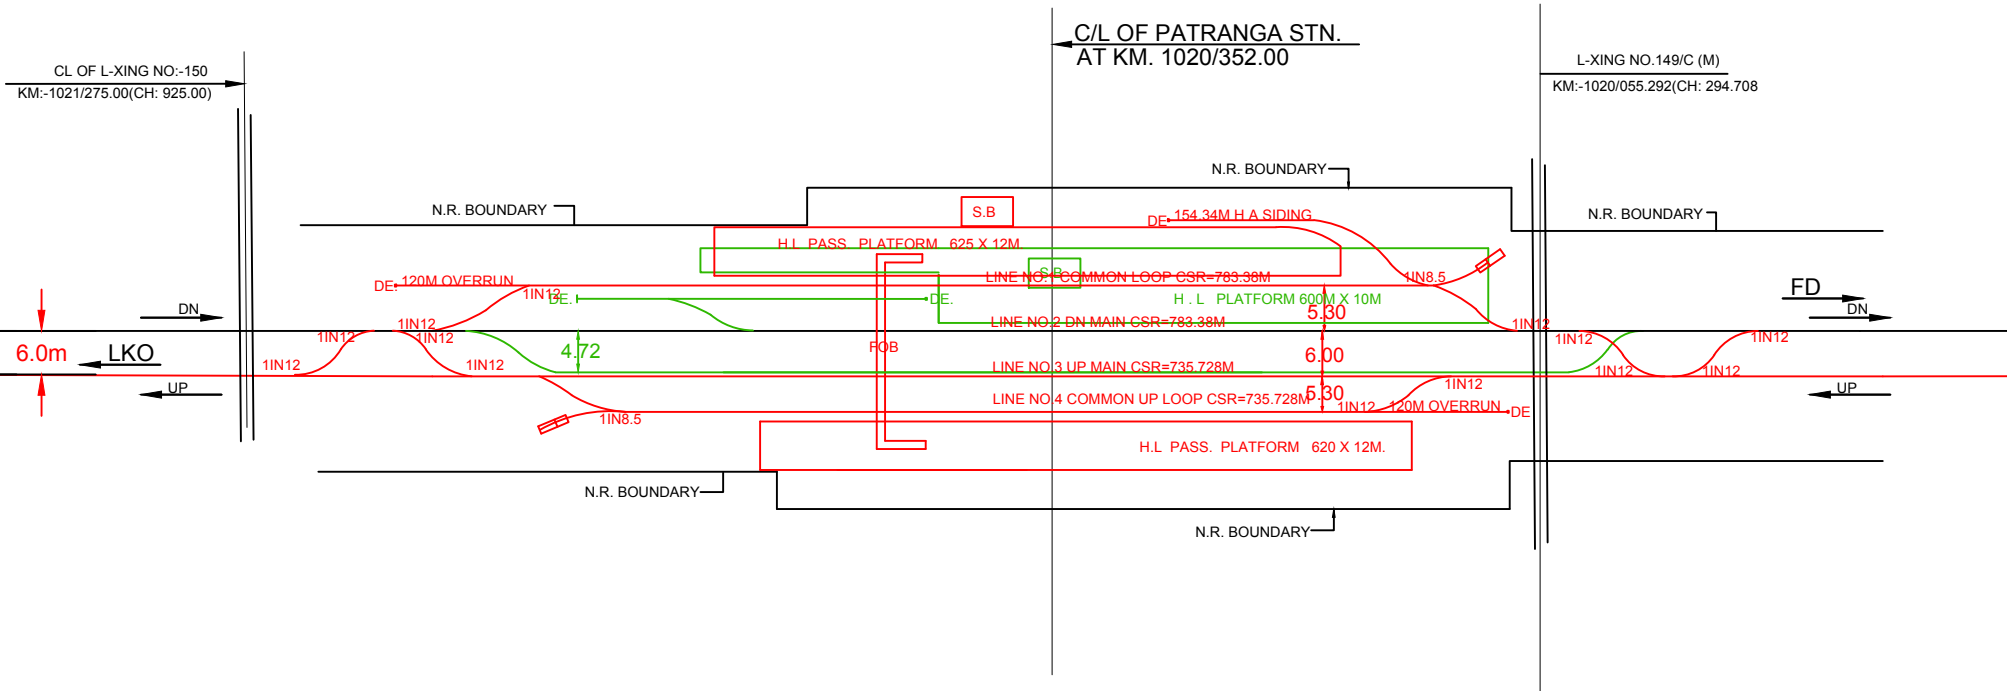

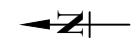

CHECKED BY	
DRAWN BY	


ADEN/PRG		Sr.DEN/(IV)			
CORRECTED UPTO	18-02-2020				

S. No.	DESCRIPTION	REMARKS				S. No.	DESCRIPTION	AREA (Sq.m.)
1	LAVATORIES	LADIES	LAV.	URINAL		1	AREA OF PLATFORM SHELTER	P/F No.1 P/F No.2 5.0 -
2	NO OF WATER TAPS/HAND PUMPS ON EACH PLATFORM	P/F No.	TAPS	H.P.		2	TOTAL AREA OF PLATFORM	
	SOURCE OF WATER SUPPLY						PLATFORM NO 1	823.5
3	YEAR OF CONSTRUCTION OF STATION BUILDING						PLATFORM NO 2	823.5
4	BOOKING OFFICE	ADV. RES.		CURRENT RES.		3	AREA OF WAITING ROOM	
5	NO. OF WINDOWS	P/F No.1		P/F No.2			I- UPPER CLASS WAITING ROOM	NIL
6	NO. OF SEATS						II - AREA OF WAITING ROOM	
	WHETHER ENQUIRY OFFICE PROVIDED OR NOT						a- LADIES	-
							b- GENTS	-
							III- WAITING HALL	80.0
						4	CIRCULATING AREA	NIL

REF. FENCING { KUTCHA
PUCCA
ROAD { METALLED
UNMETALLED



E OF PINDRA ROAD HALT STN. BLDG.
AT KM. 795.570

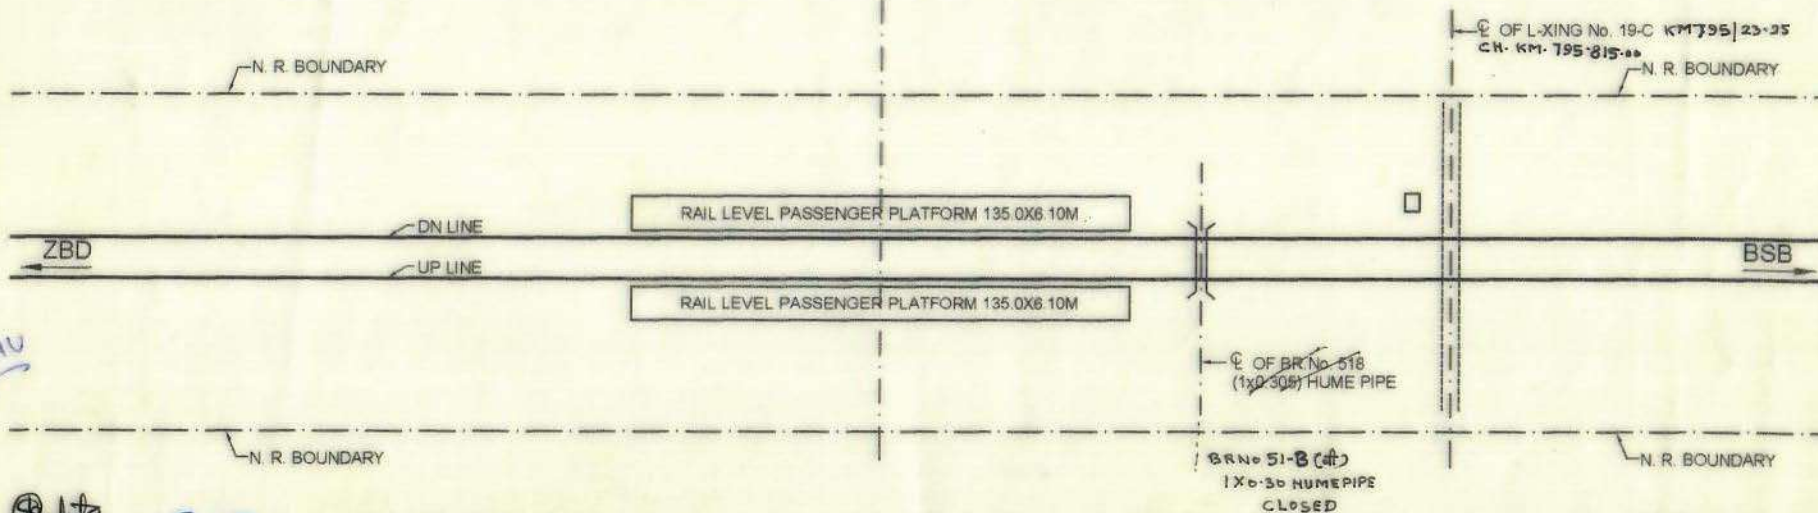

31.3.13

31.03.2013

JE(W)/JNU

31.3.13

Corrected upto


CHECKED BY SSE/P.WAY/JNU

DRAWN BY

Sr. D.E.N. (III)							
ADEN/JNU	27.12.12						
CORRECTED UPTO	31-03-12	31-3-13	31-3-14	31-3-15	31-3-2016	31.03.2018	

NORTHERN RAILWAY LUCKNOW DIVISION	
LKO-FD-BSB SECTION	
DIAGRAM OF	
PINDRA ROAD HALT STN: YARD	
R.L. M.S.L.	NOT TO SCALE
N.R. DIVL. SKETCH NO: M-170/KO-2012	

123

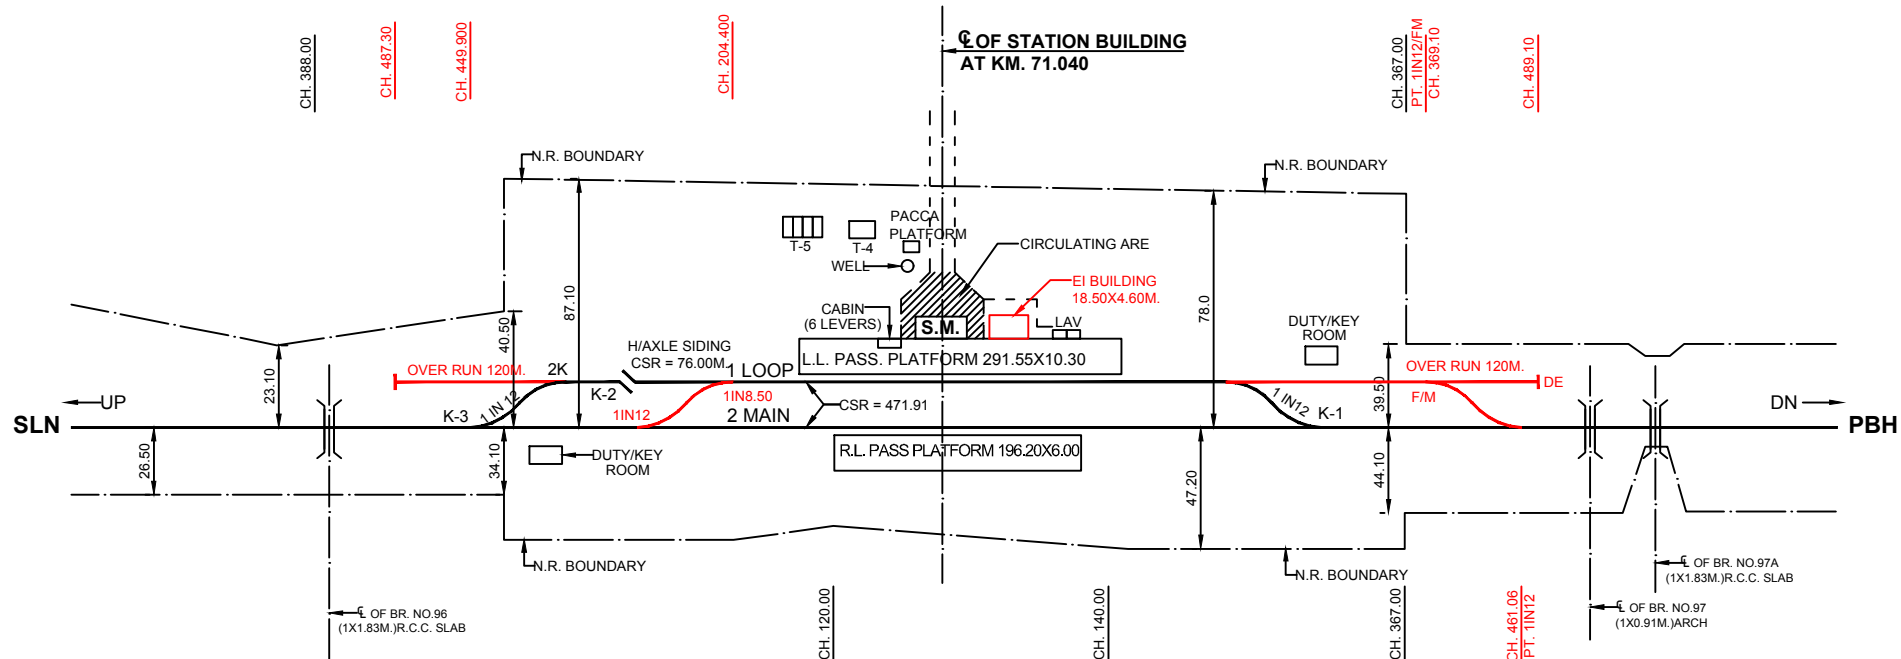

NORTHERN RAILWAY
LUCKNOW DIVISION

FD-SLN-FM SECTION
DIAGRAM OF

PIPARPUR STN. YARD

CHECKED BY

DRAWN BY

ADEN/PRG

CORRECTED UPTO

18-02-2020


Sr.DEN/(IV)

R.L./M.S.L.

N.R. D.R.M. LKO. SKETCH NO.


NOT TO SCALE

325-06

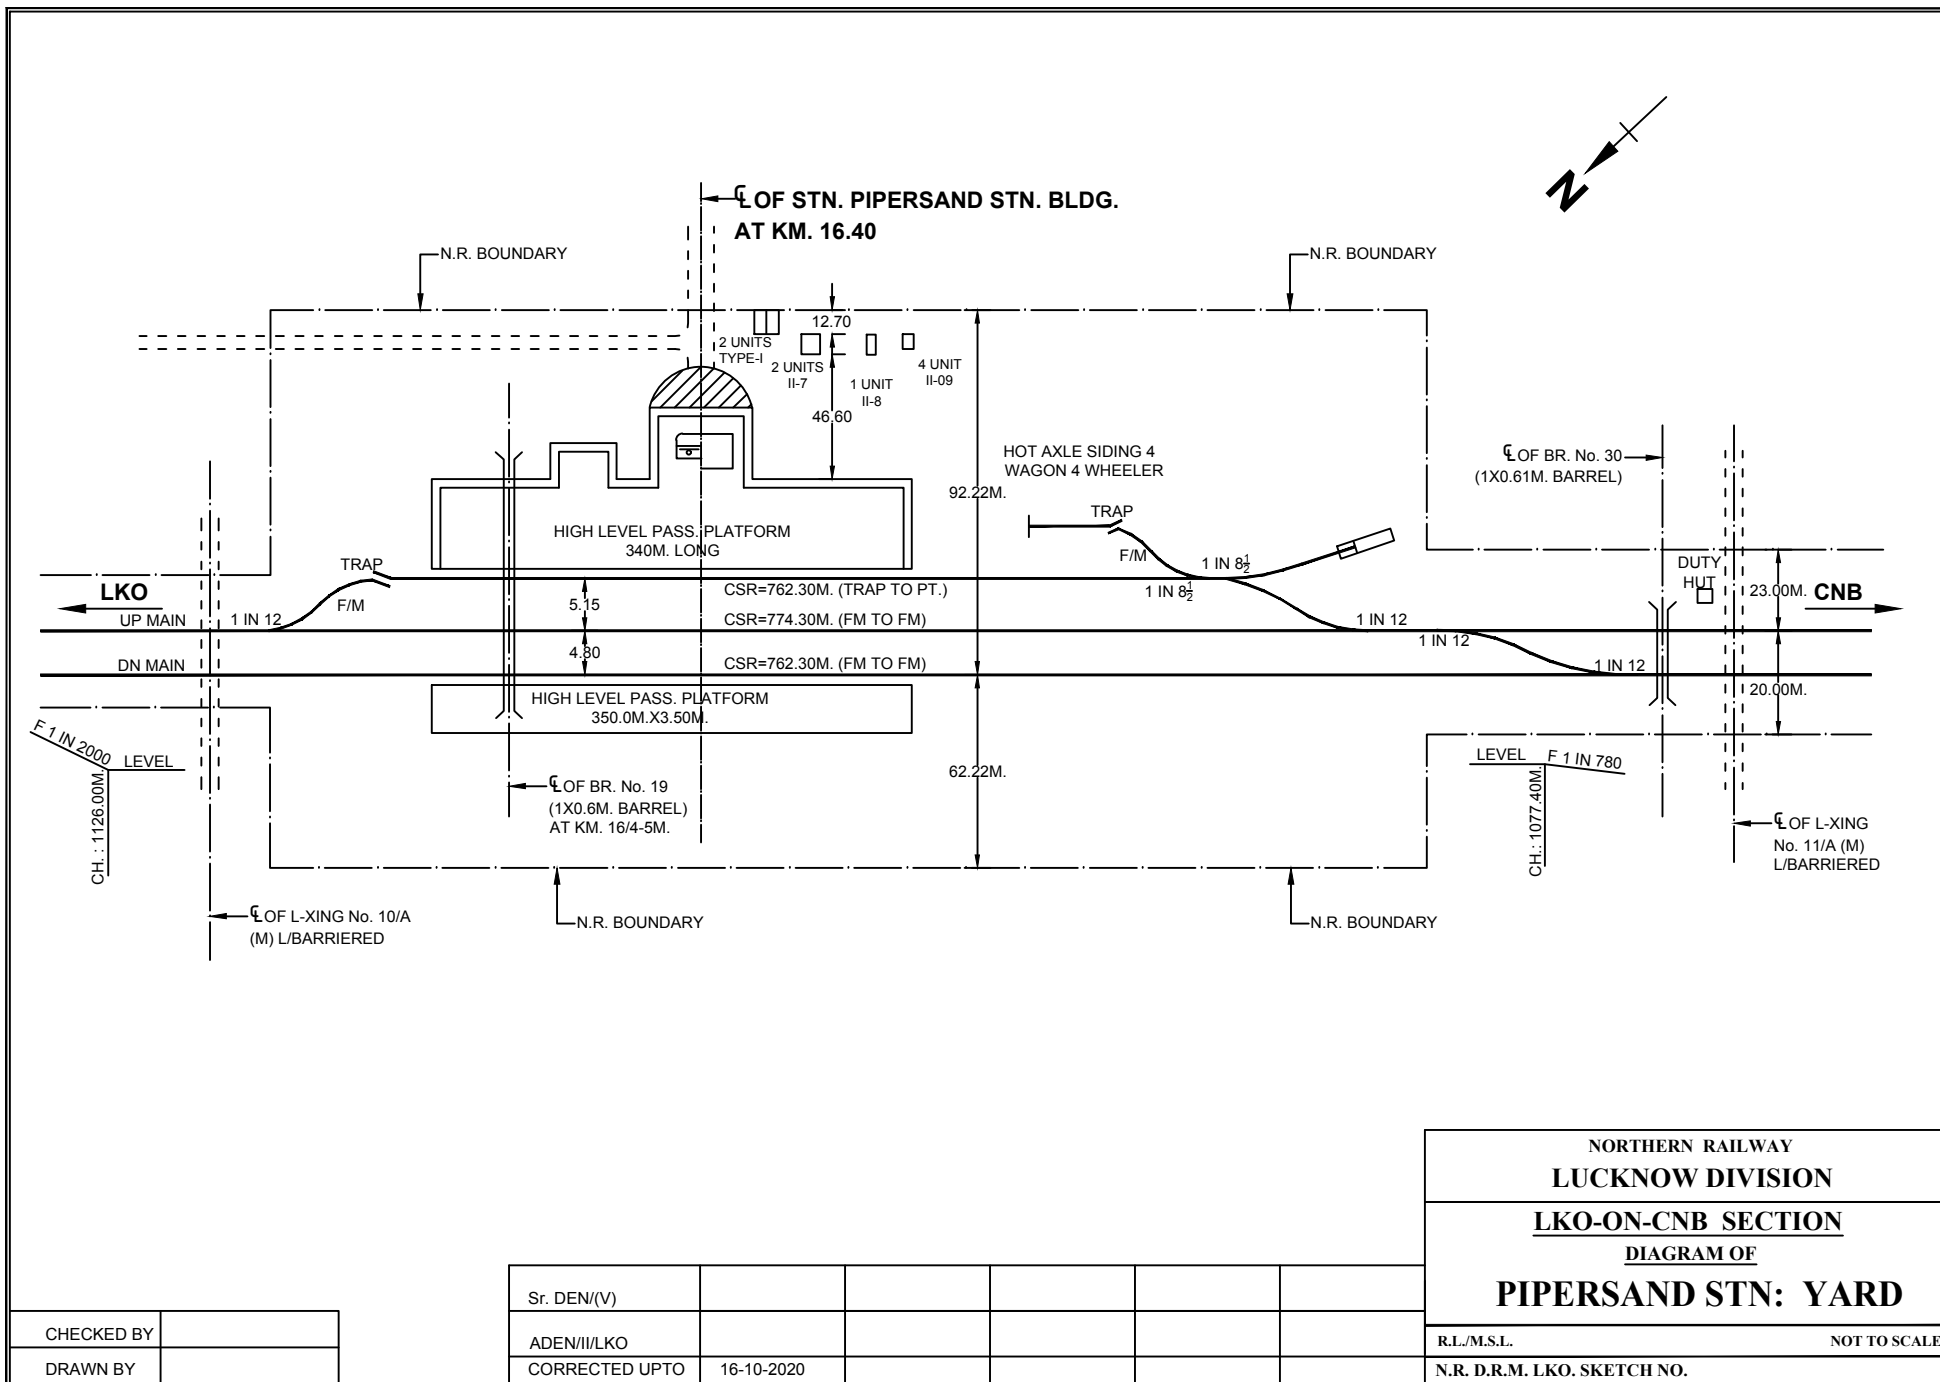

LEGEND:-

EXISTING WORK	—
PROPOSED WORK	—
DISMANTLED WORK	—
FUTURE WORK	—

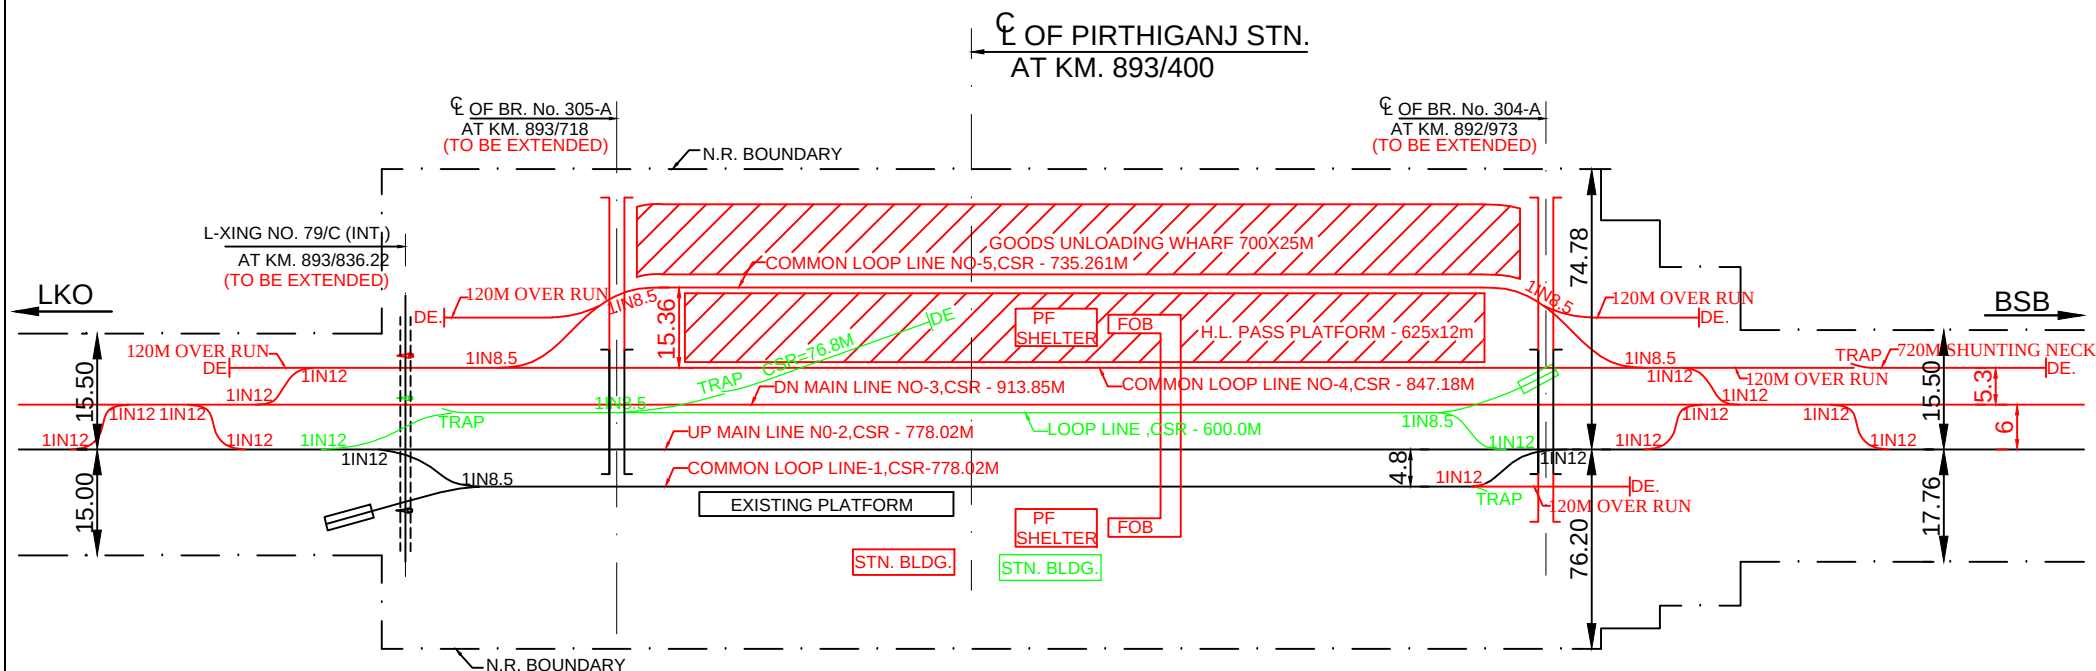

Detail of traffic movement:

Sr.NO.	Movement	To Line no.
1.	From Lucknow	1 to 5
2.	From Varanasi	1 to 5

Track (in KM)
(Except Main line)



NORTHERN RAILWAY
LUCKNOW DIVISION
PIRTHIGANJ STATION YARD
AMETHI-JANGHAI DOUBLING (87 KM)

YARD REMODELING AT PRATAPGARH RAILWAY STATION

LEGEND

DISMANTLING WORK
PROPOSED WORK
EXISTING WORK

NOT TO SCALE

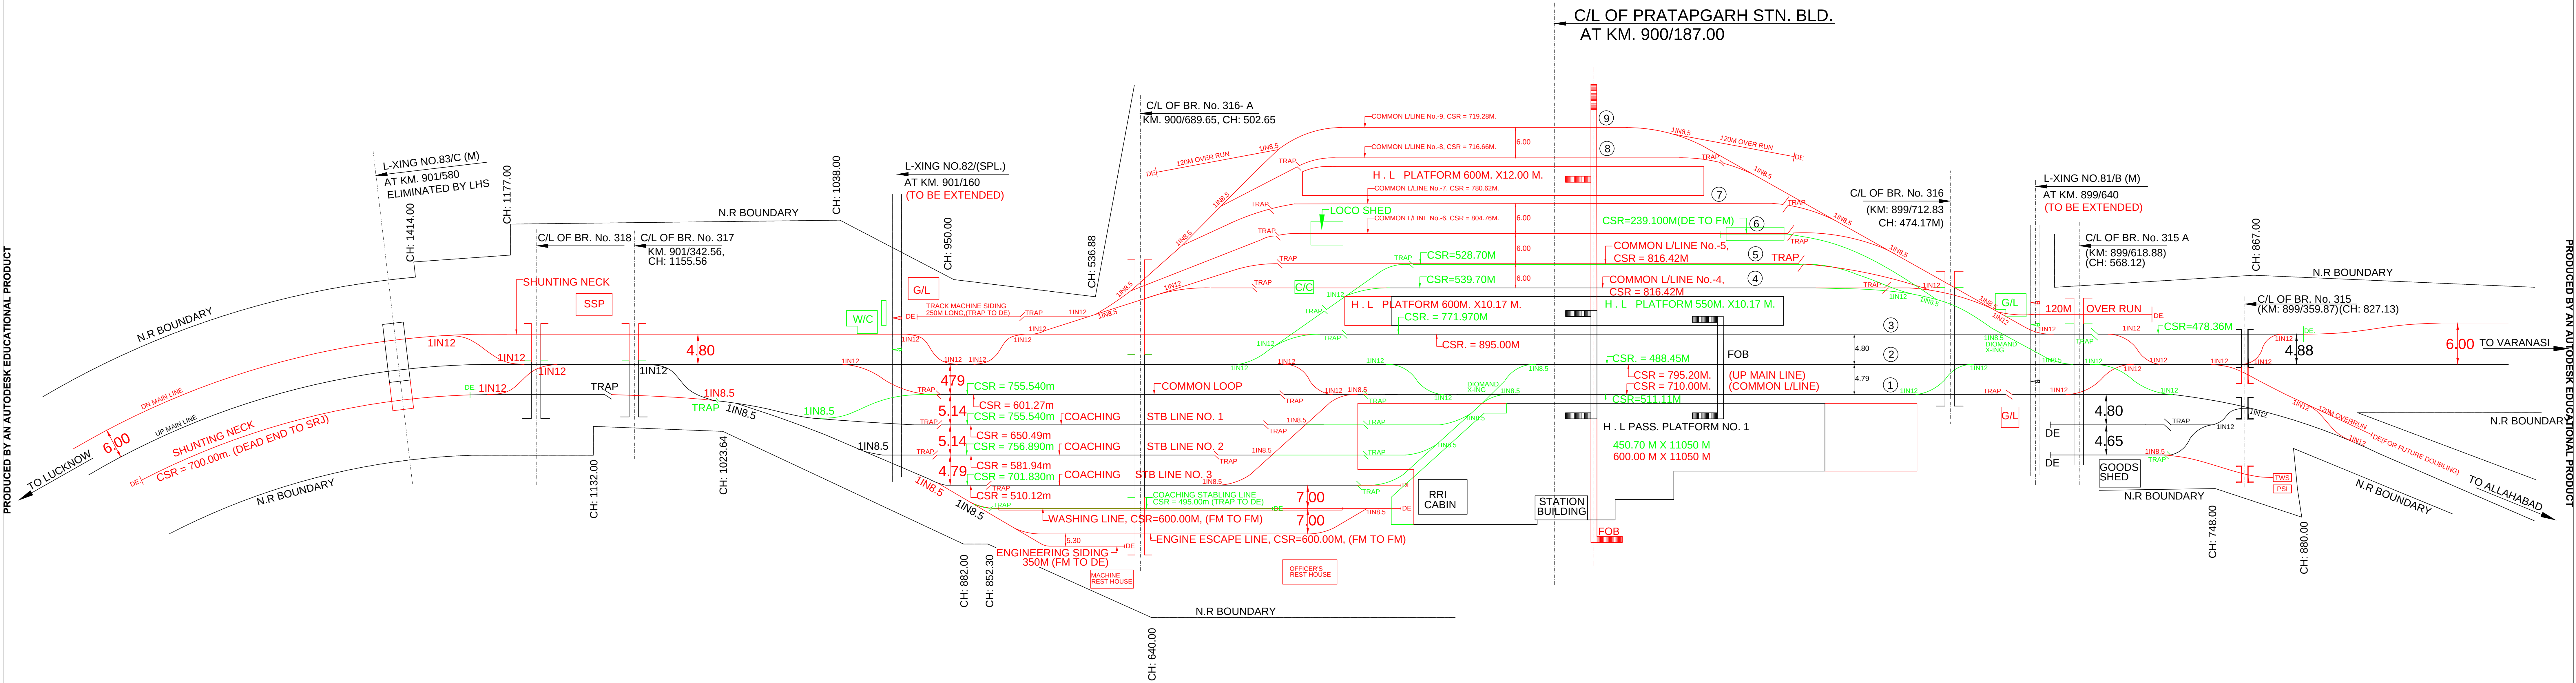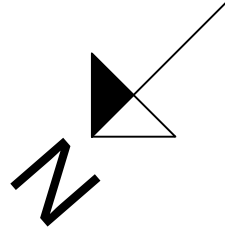

P.way work:

Sr.NO.	Name of Item	To be Dismantled	To be laid
1.	1 in 12 T/out	12	26
2.	1 in 8.5 T/out	05	17
3.	Trap	08	19
4.	Double Dimond	02	00
5.	Dead End	03	10
6.	Sand Hump	00	00
7.	Track (in KM)	1.60	6.60

Facility to be provided:


Sr.NO.	Facility
1.	New H.L. Island PF no.4 &5
2.	Extension of existing PF no.1 (42.76m at BSB end & 150.92m at LKO end)
3.	Extension of existing PF no.2 & 3 (24.80m at LKO end)
4.	Extension of F.O.B (To cover PF 1 to PF 5)
5.	Washable apron at line no. 7 & 8.
6.	Four new line as line no. 6, 7, 8 & 9.
7.	One 250m long track machine siding at Lucknow end.
8.	One 700m CSR Shunting neck at Lucknow end.
9.	One new washing line with CSR 600m and Engine escape line with CSR 600m
10.	One new Officers rest house and One new Track machine staff rest house.
11.	One 350m long engineering siding at LKO end.

Detail of traffic movement:

Sr.NO.	Movement	To Line no.
1.	From Lucknow	1 to 9
2.	From Varanasi	1 to 9
3.	From Allahabad	1 to 9

NORTHERN RAILWAY
LUCKNOW DIVISION

PRATAPGARH STATION
YARD REMODELING

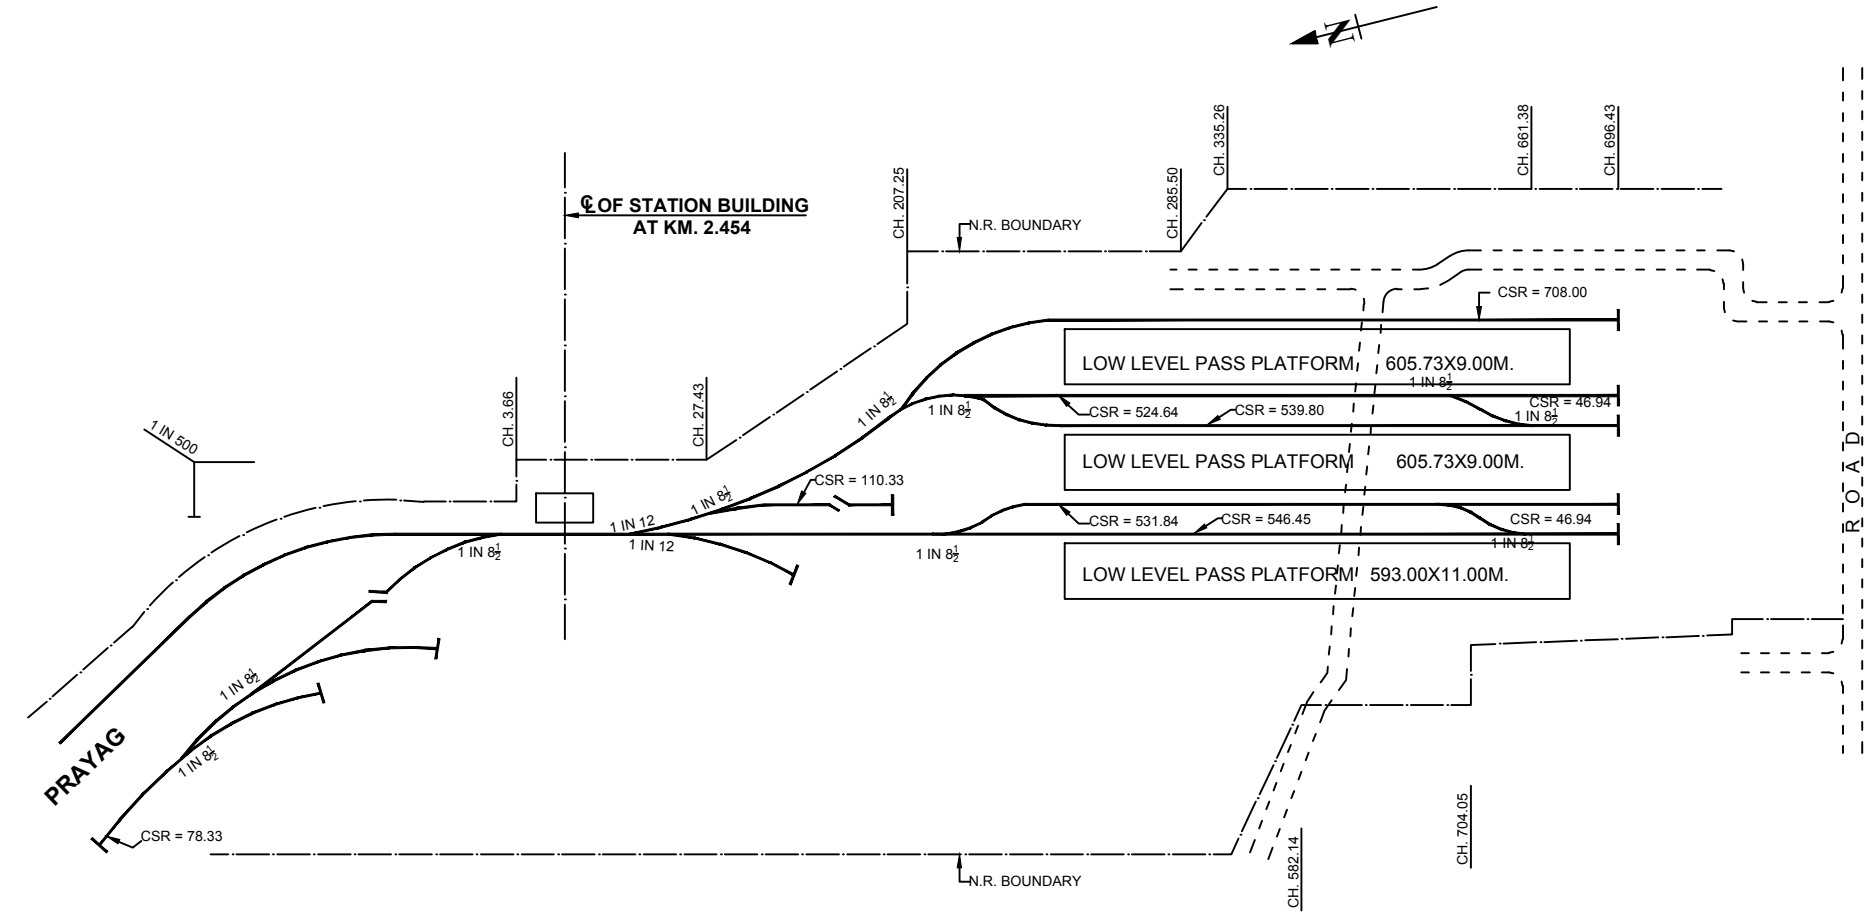

NORTHERN RAILWAY	
LUCKNOW DIVISION	
PRG - PYG SECTION	
DIAGRAM OF	
PRAYAG GHAT STN. YARD	
R.L./M.S.L.	NOT TO SCALE
N.R. D.R.M. LKO. SKETCH NO.	334-06


CHECKED BY	
DRAWN BY	

ADEN/PRG		Sr.DEN/(IV)			
CORRECTED UPTO	18-02-2020				

S. No.	DESCRIPTION	REMARKS		
1	LAVATORIES		LAV.	URINAL
		LADIES	-	
		GENTS	-	
2	NO OF WATER TAPS/HAND PUMPS ON EACH PLATFORM	P/F No.	TAPS	H.P.
		1	-	1
		-	-	
	SOURCE OF WATER SUPPLY	Reqd. 1M 24/PUMP		
3	YEAR OF CONSTRUCTION OF STATION BUILDING	1976		
4	BOOKING OFFICE NO. OF WINDOWS	ADV. RES. 1	CURRENT RES.	
5	NO. OF SEATS	P/F No 1 6	P/F No.2	
6	WHETHER ENQUIRY OFFICE PROVIDED OR NOT	NO 1		

S. No.	DESCRIPTION	AREA (Sq.m.)
1	AREA OF PLATFORM SHELTER	P/F No.1 P/F No.2 NIL
2	TOTAL AREA OF PLATFORM	
	PLATFORM NO. 1	1218.00
	PLATFORM NO. 2	NIL
3	AREA OF WAITING ROOM	
	I - UPPER CLASS WAITING ROOM	-
	II - AREA OF WAITING ROOM	-
	a - LADIES	NIL
	b - GENTS	-
	III - WAITING HALL	NIL
4	CIRCULATING AREA	-

REF.	FENCING	KUTCHA PUCCA	-----
ROAD	METALLED UNMETALLED	=====	=====

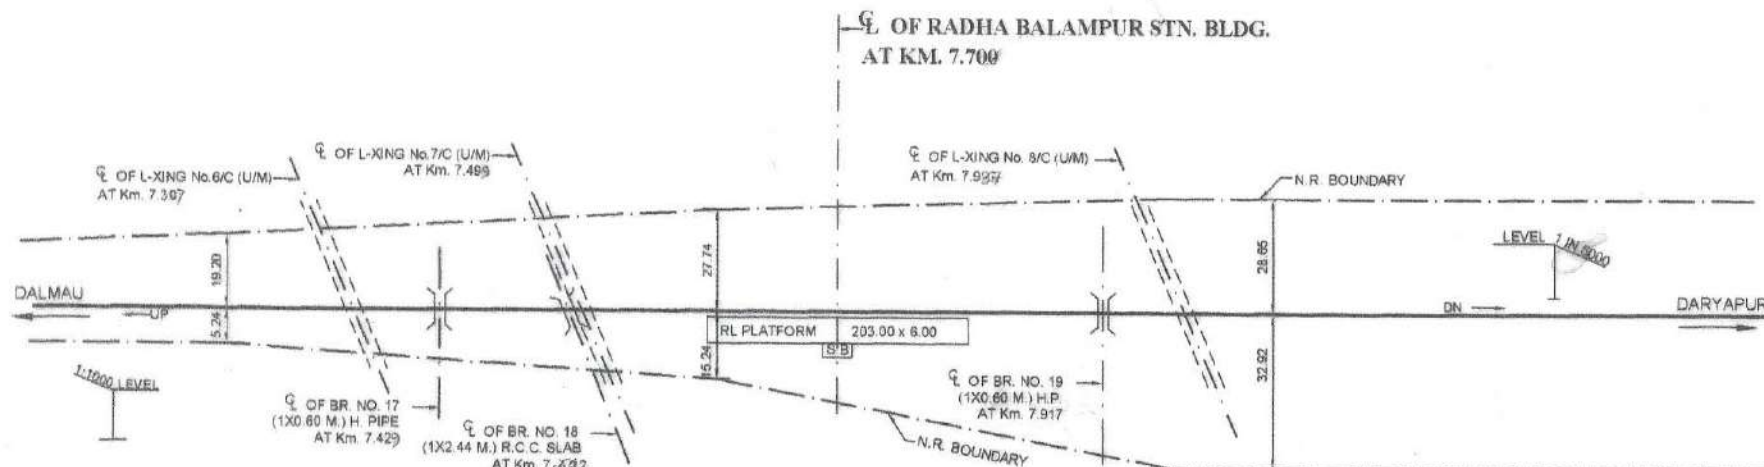


CHECKED BY	S. S. L.
DRAWN BY	DAKSH

Sr. D.E.N.(II)						
ADEN/RBL	ADEN/RBL	ADEN/RBL	ADEN/RBL	ADEN/RBL	ADEN/RBL	ADEN/RBL
CORRECTED UPTO	31-03-12	31-3-13	31-03-14	31-03-15	31-3-16	31-03-2018

NORTHERN RAILWAY LUCKNOW DIVISION	
DMW-DYP SECTION	
DIAGRAM OF	
RADHA BALAMPUR STN: YARD	
R.L./M.S.L.	NOT TO SCALE
N.R. DIV L. SKETCH NO.	M-135/LKO/2012



C/L OF RAHMATNAGAR STN.
AT KM. 1023.027

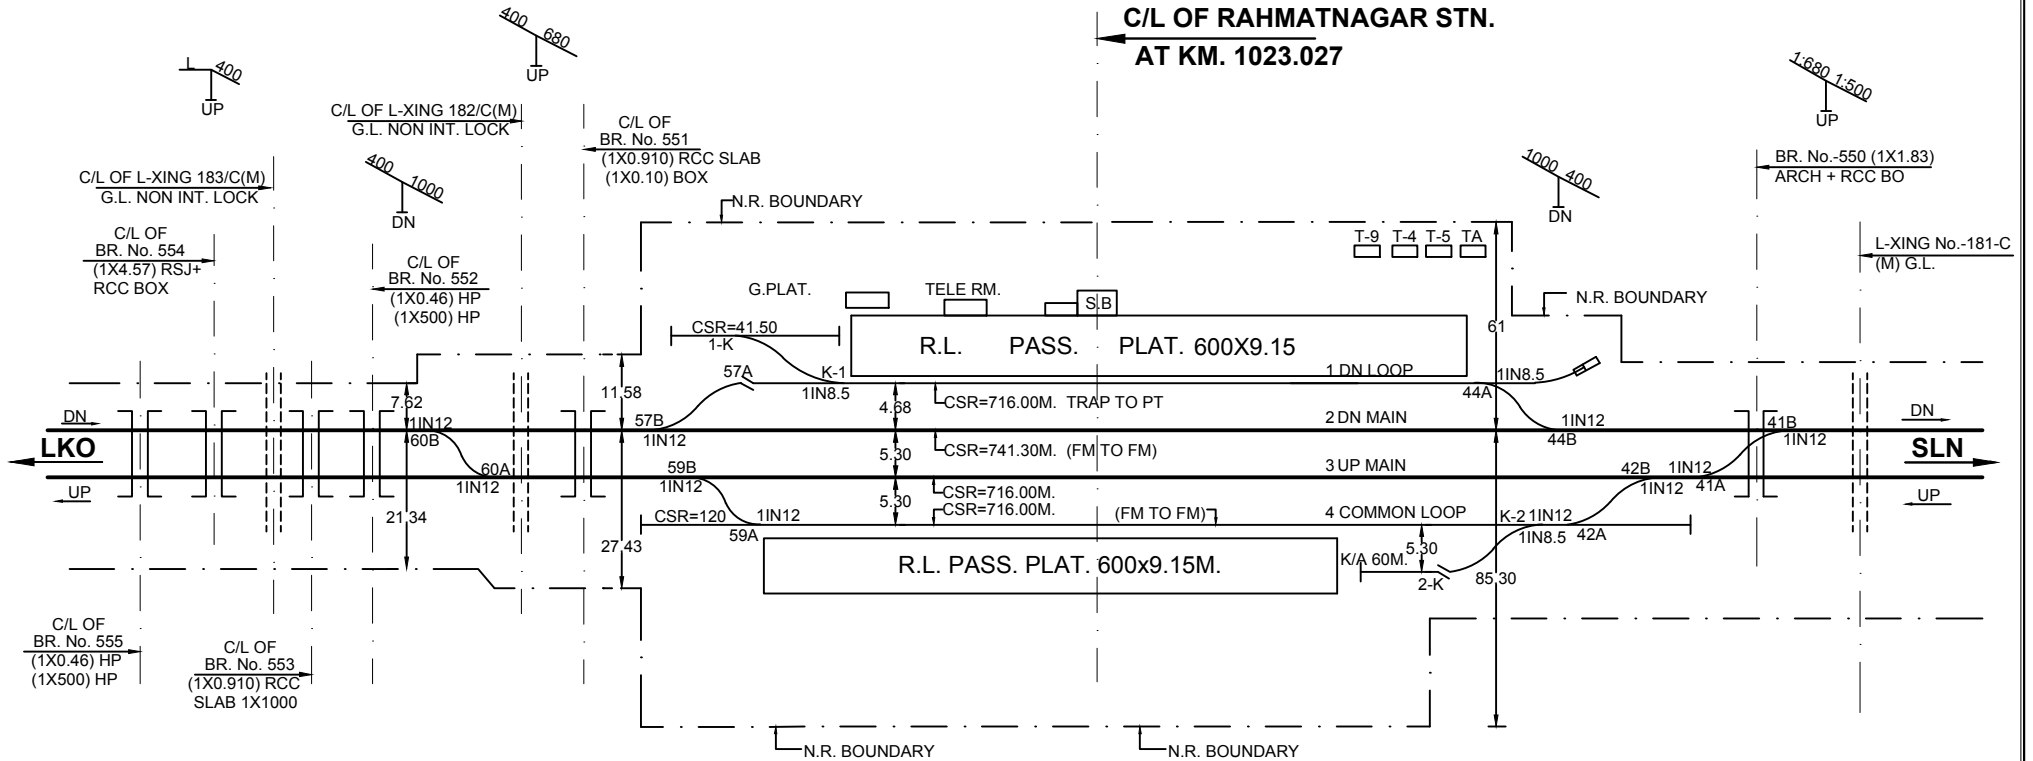


NORTHERN RAILWAY LUCKNOW DIVISION	
LKO -SLN-ZBD SECTION	
DIAGRAM OF	
RAHMATNAGAR STN. YARD	
R.L./M.S.L. 118.800m	NOT TO SCALE
N.R. D.R.M. LKO. SKETCH NO. 285 - 06	

CHECKED BY	
DRAWN BY	

Sr. DEN/(IV)					
ADEN/SLN-I					
CORRECTED UPTO	18-02-2020				

RAE BARELI STATION

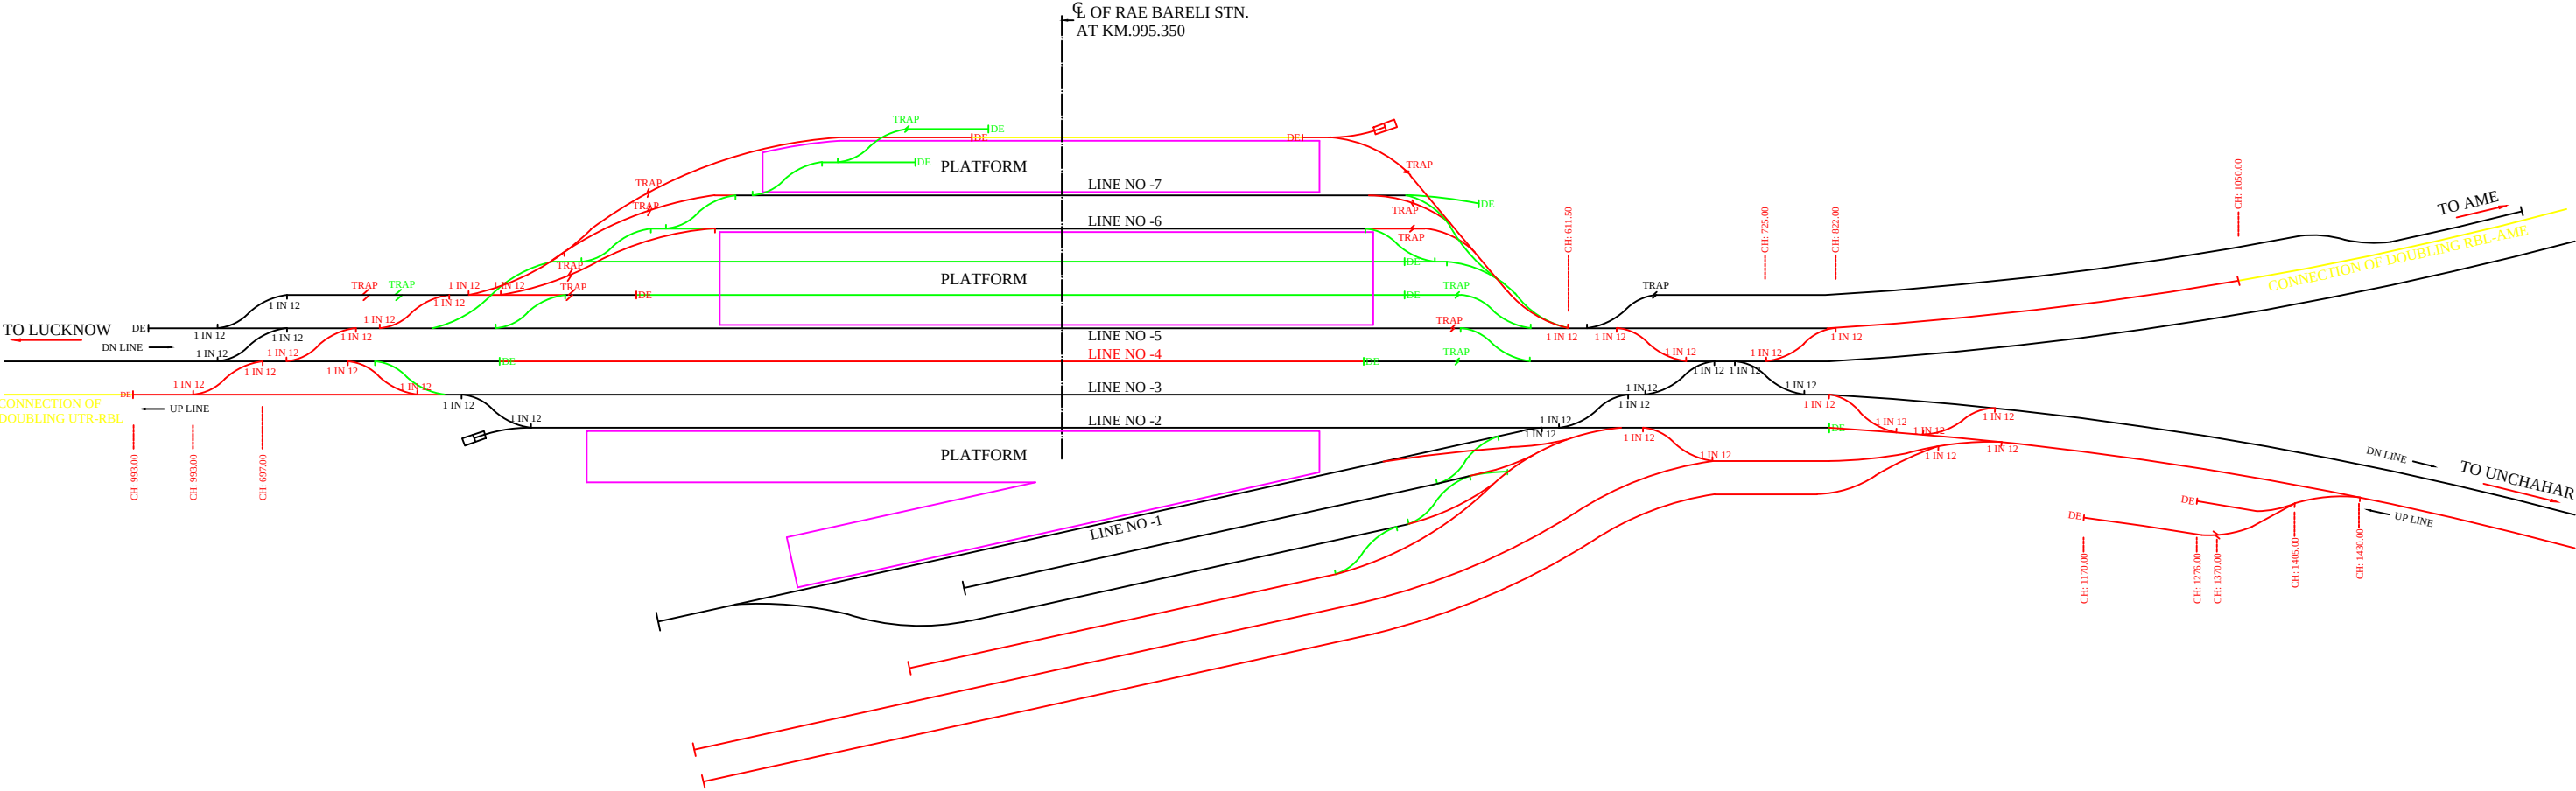


LEGEND:-

- 1. EXISTING WORK SHOWN THUS
- 2. PROPOSED WORK SHOWN THUS
- 3. DISMENTLING WORK SHOWN THUS
- 4. THIS DRAWING IS NOT TO SCALE



REA BARELI STATION YARD

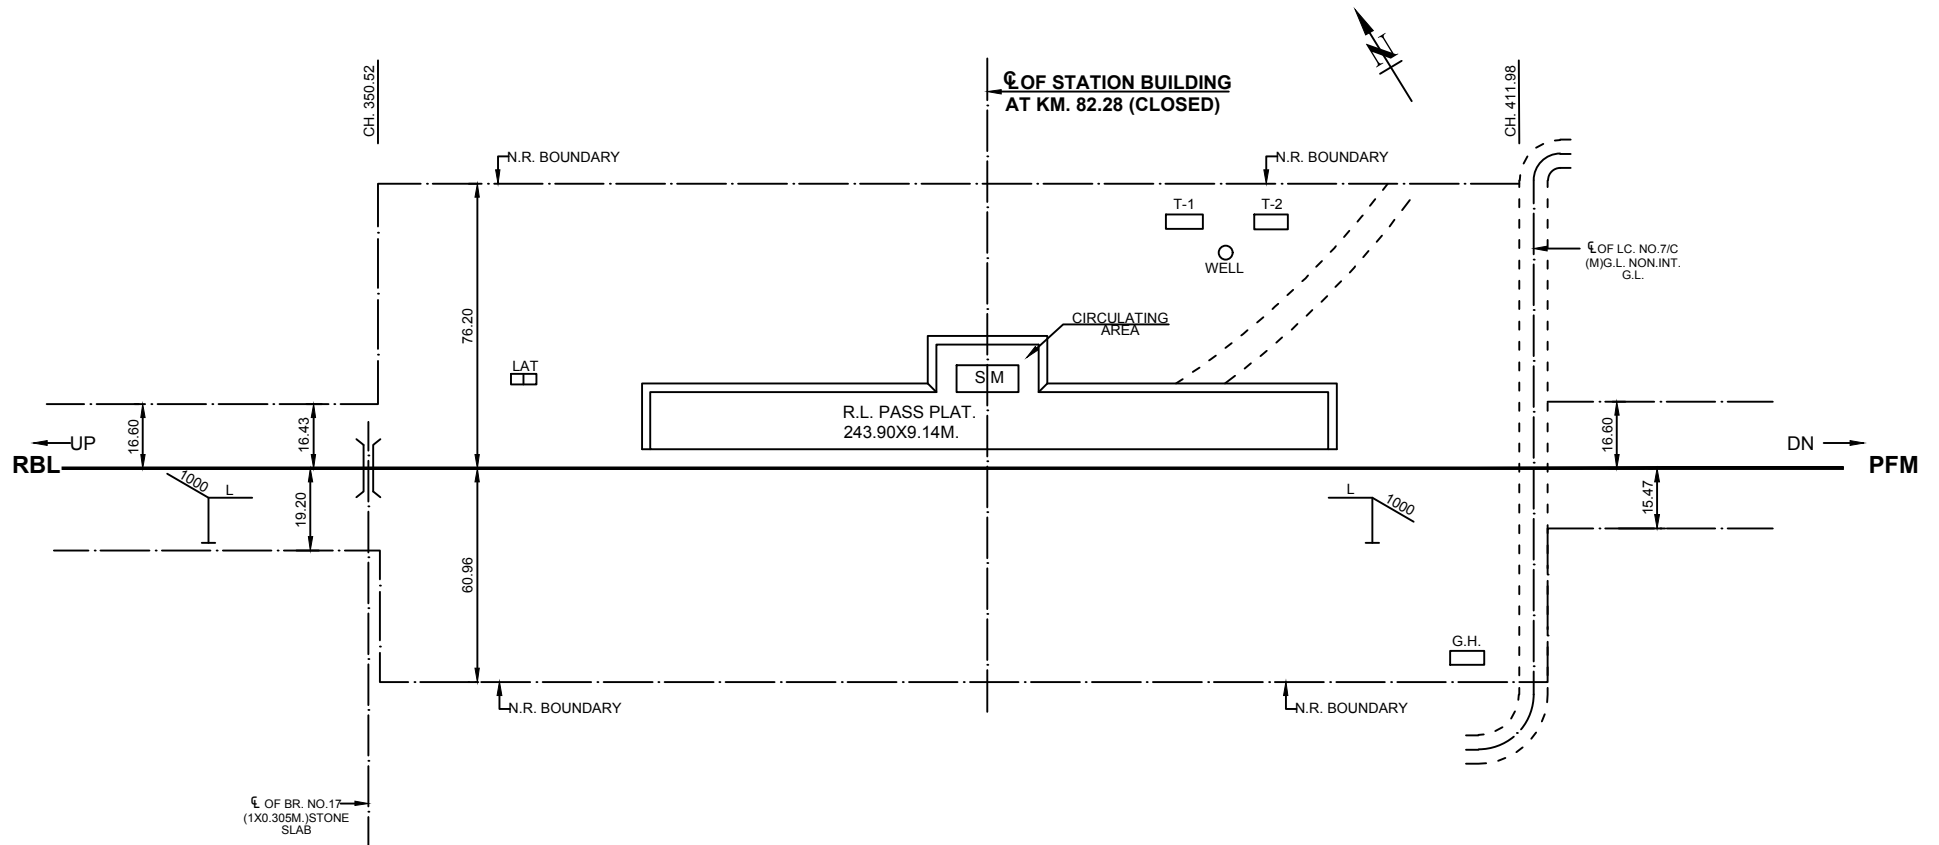


NORTHERN RAILWAY	
LUCKNOW DIVISION	
FD-SLN-ALD SECTION	
DIAGRAM OF	
RAM CHANDRAPUR STN. YARD	
R.L./M.S.L.	NOT TO SCALE
N.R. D.R.M. LKO. SKETCH NO.	316-06

CHECKED BY	
DRAWN BY	

ADEN/PRG		Sr.DEN/(IV)			
CORRECTED UPTO	18-02-2020				



CL OF STN. BUILDING
AT KM. 20.970

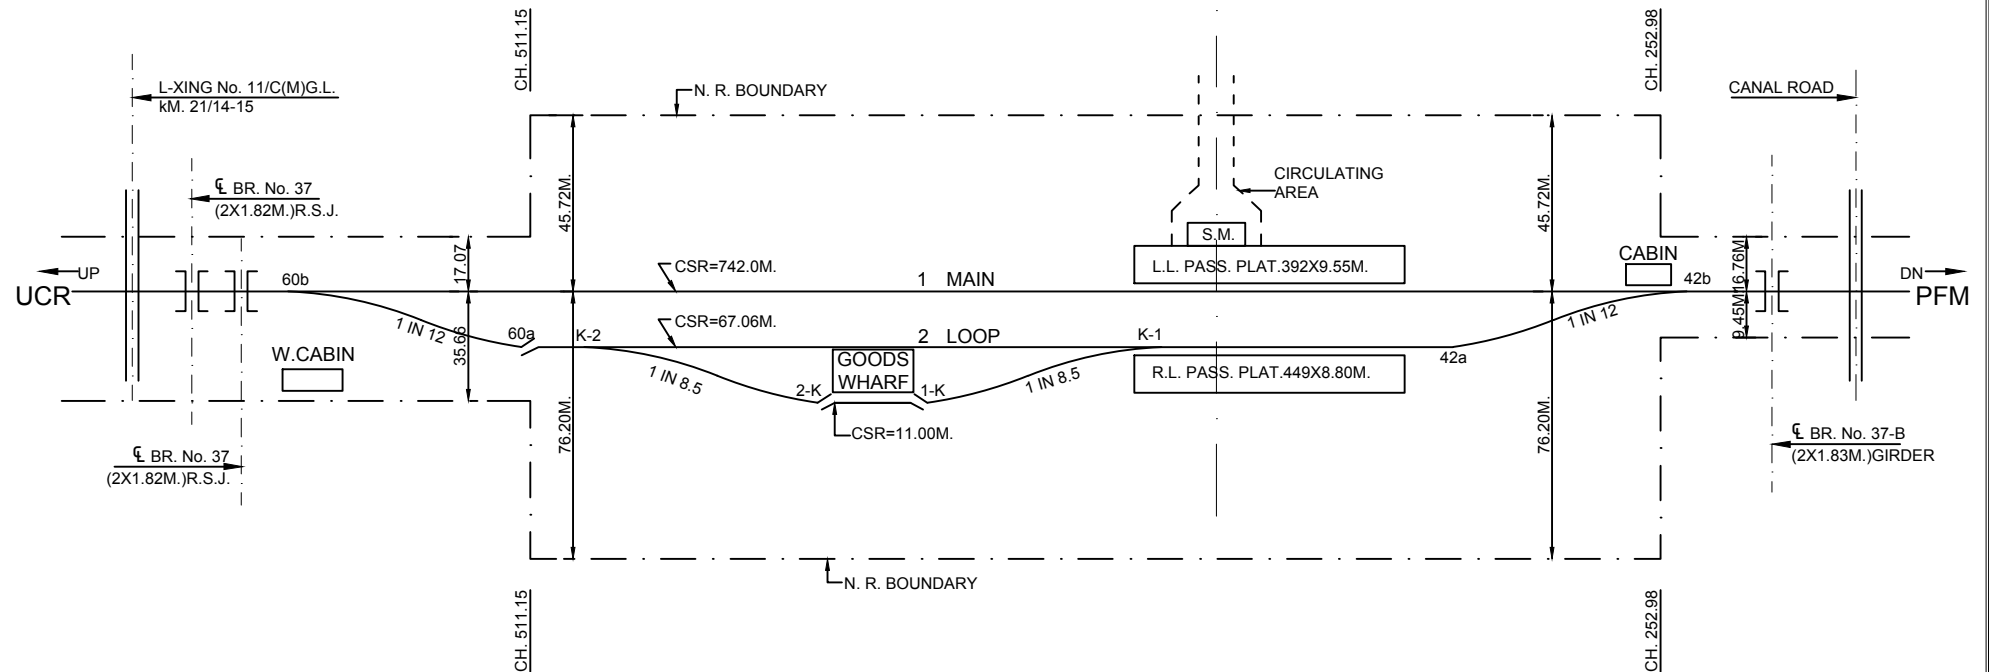

NORTHERN RAILWAY
LUCKNOW DIVISION

PFM-UCR-ON SECTION
DIAGRAM OF

RAM CHAURA ROAD STN. YARD

CHECKED BY

DRAWN BY

Sr. DEN/(IV)

ADEN/PRG

CORRECTED UPTO



18-02-2020

R.L./M.S.L.


NOT TO SCALE

N.R. D.R.M. LKO. SKETCH NO. 303-06

RASAULI STATION YARD

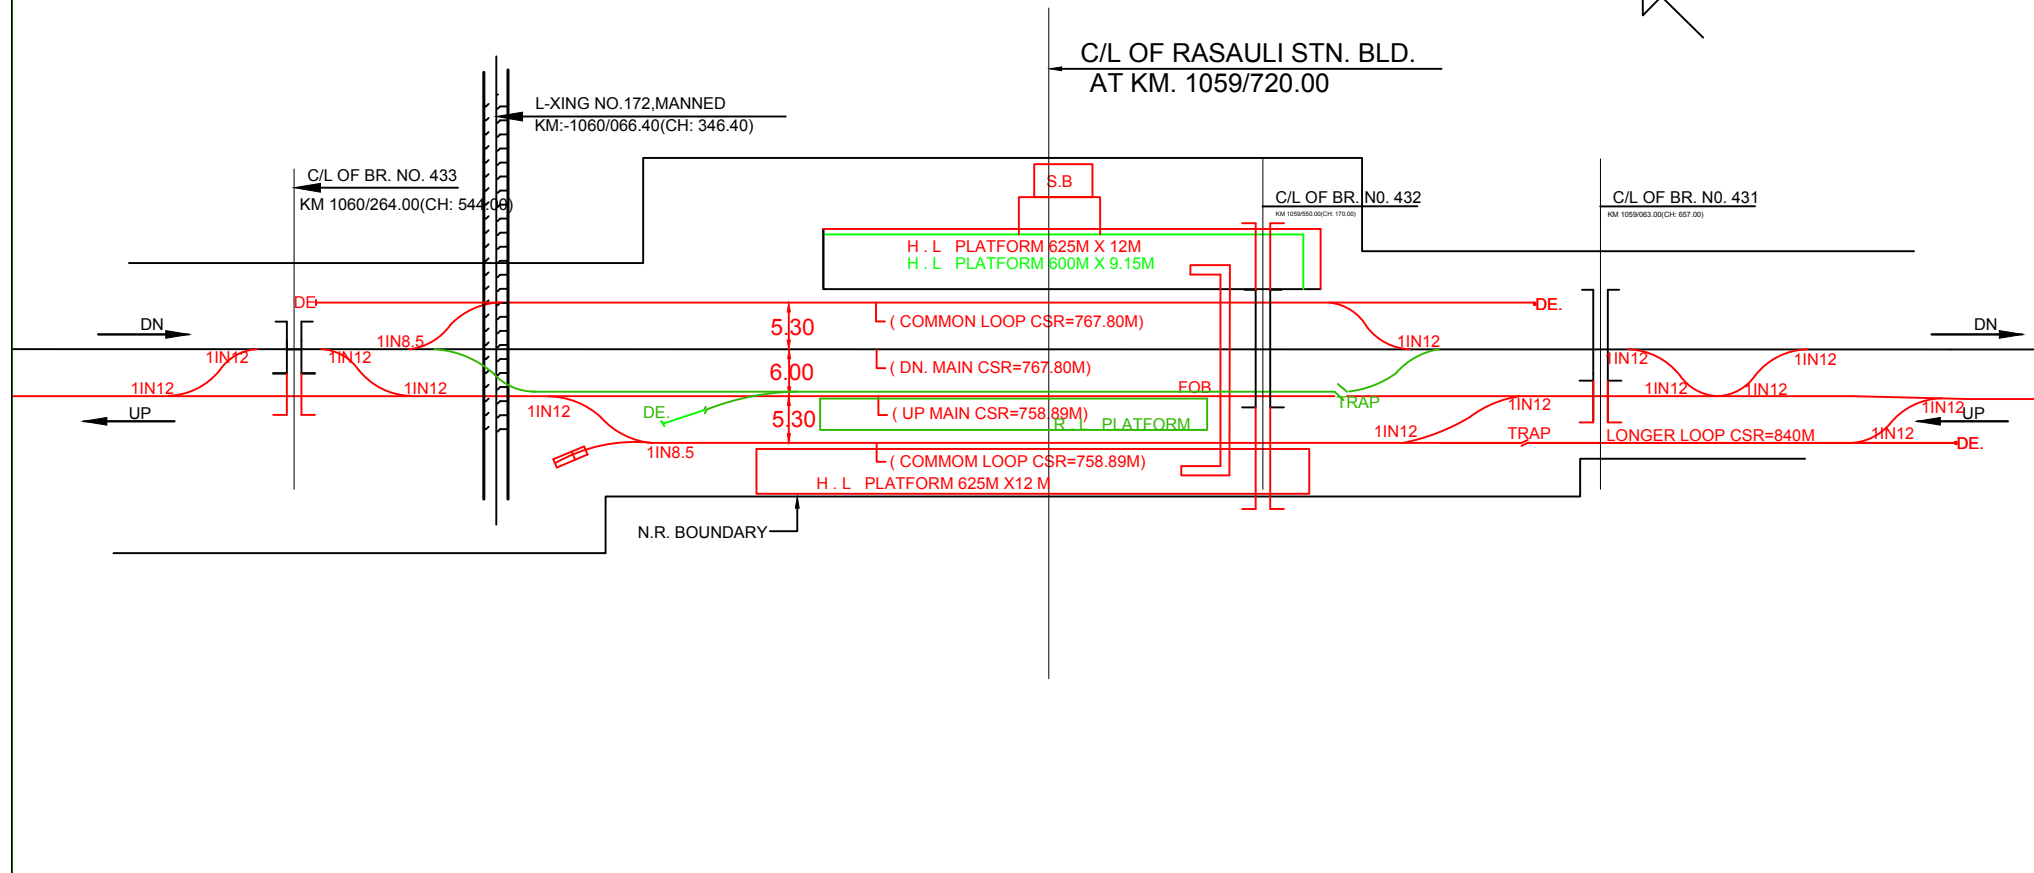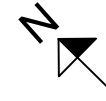

RAUZAGAON STATION YARD

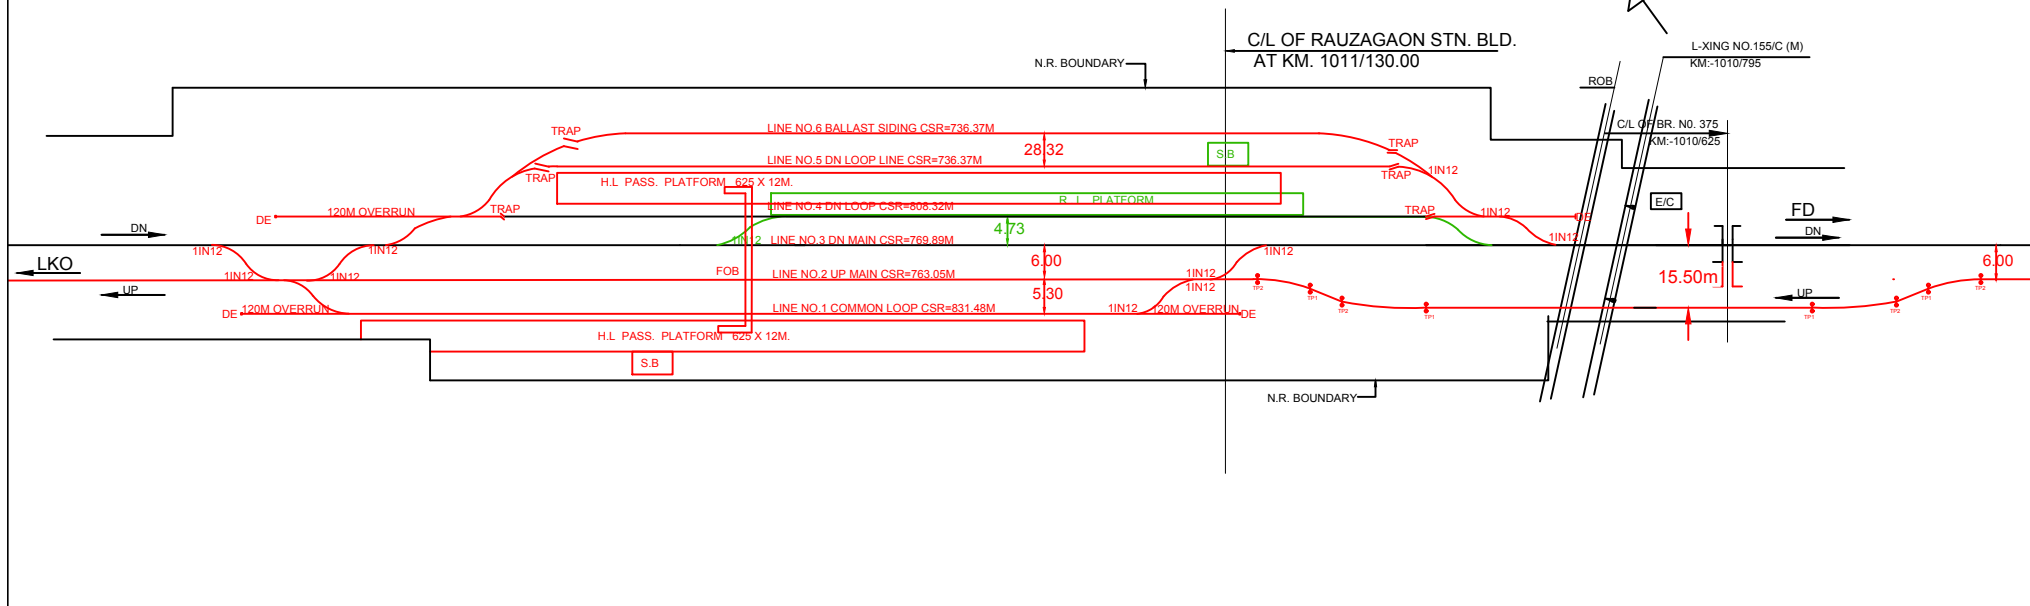

RUDAULI STATION YARD




C/L OF RUDAULI STN. BLD.
AT KM. 1005/847.00

L-XING NO.143/B
KM. 1006/143.000


N.R. BOUNDARY


C/L OF BR. NO. 369
AT KM. 1005/100.00

L-XING NO.142/C (M)
KM:-1004/273.00

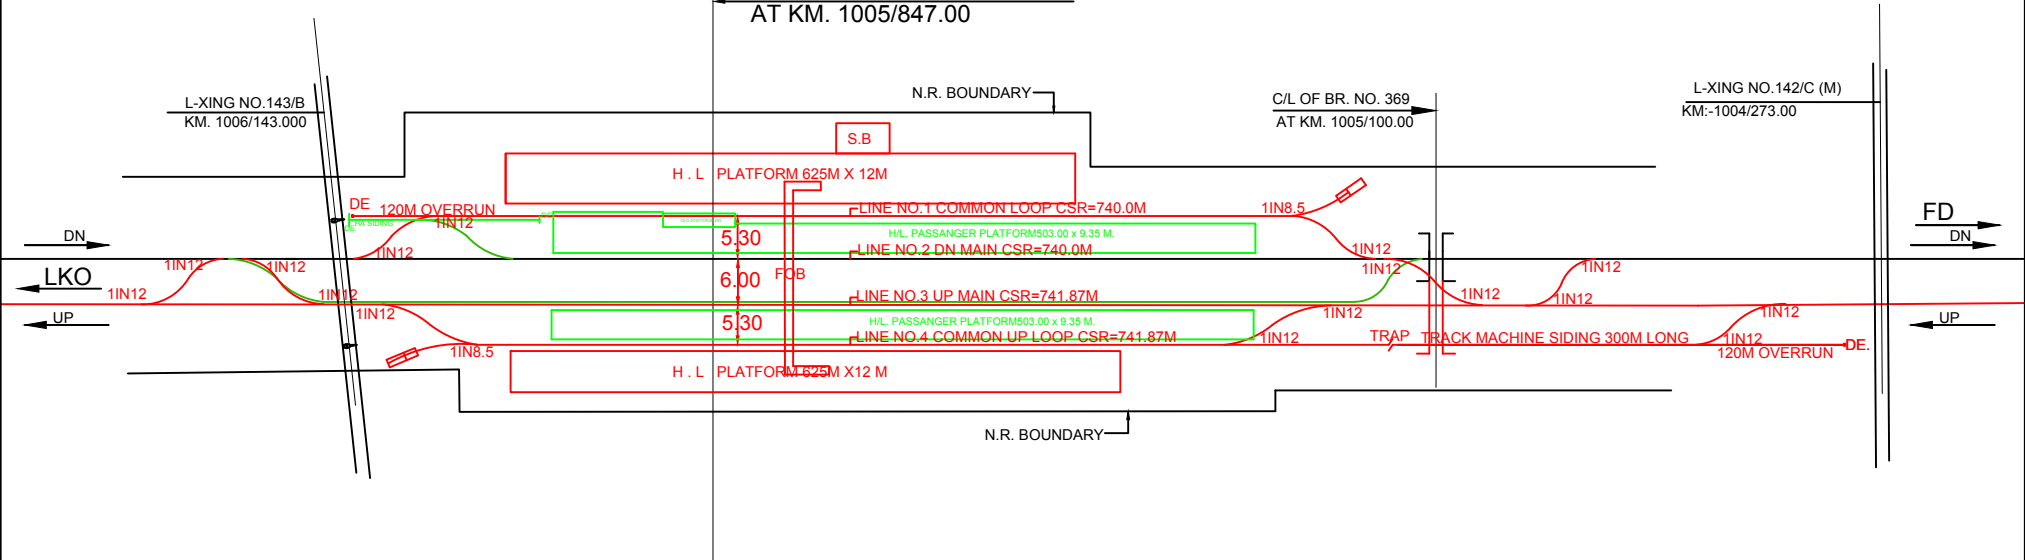

1. EXISTING WORK SHOWN THUS
2. PROPOSED WORK SHOWN THUS
3. DISMENTLING WORK SHOWN THUS

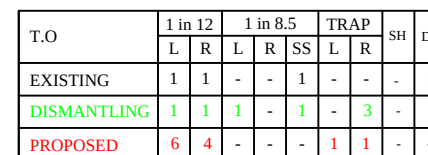

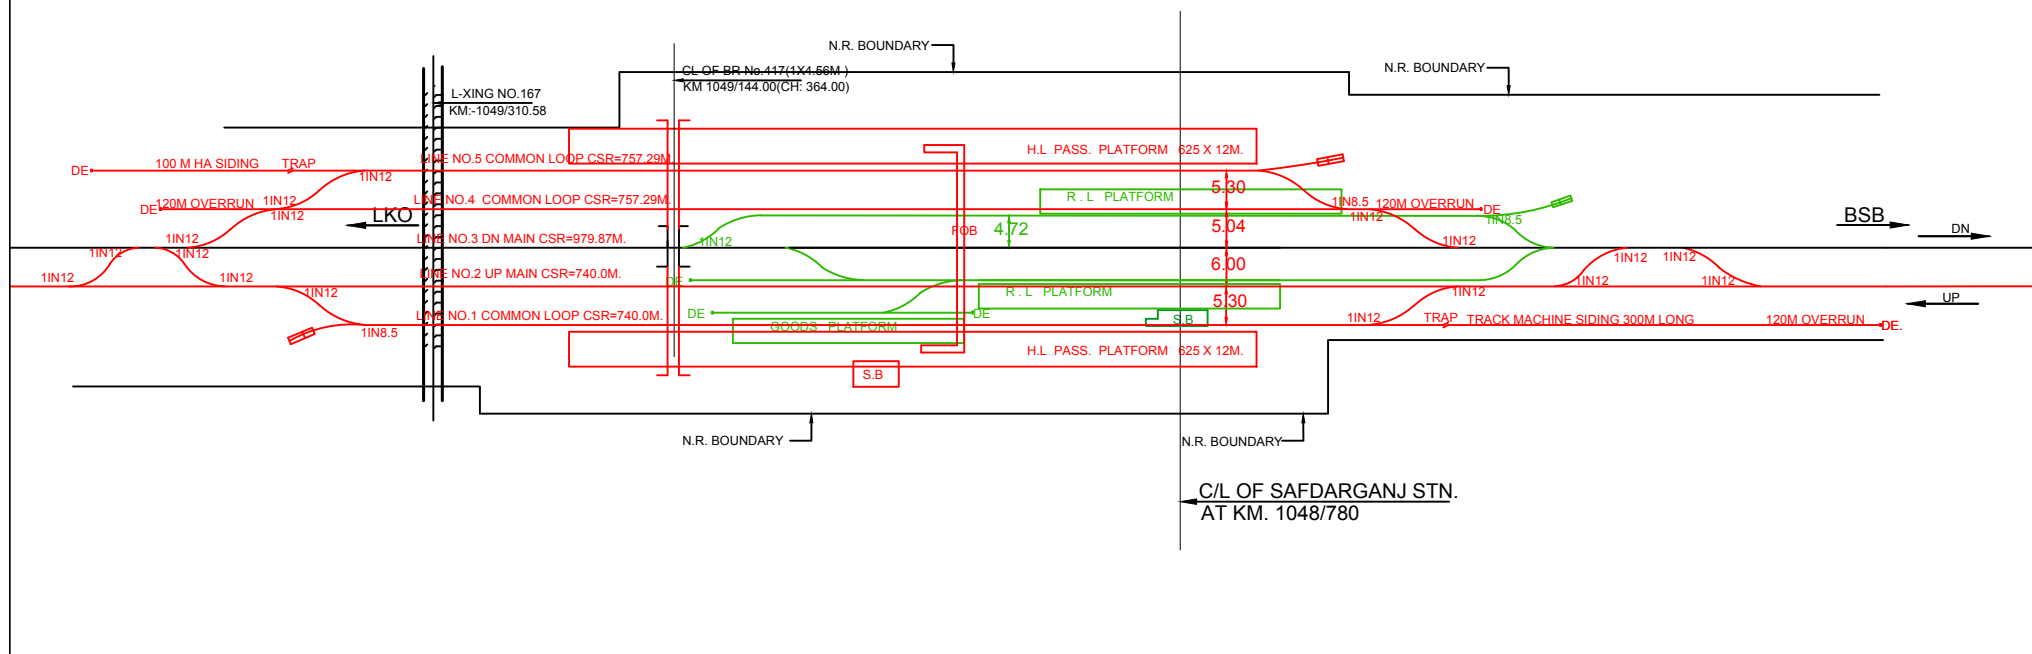

NOTE:-

1. LAVATORIES:-

a) No. of SEATS (LADIES & GENTS FLUSHED OR DRY -

2. No. of WATER TAPS/HAND PUMPS ON EACH PLATFORM

AND SOURCE OF WATER SUPPLY FOR COLONY

3. YEAR OF CONSTRUCTION OF THE STATION BUILDING :- 1976

4. BOOKING OFFICE

a) No. of WINDOWS

5. WHETHER ENQUIRY OFFICE PROVIDED OR NOT

AQUA PRIVY

MAND PUMPS

PF 1 & 2 H.P.

PF 2 & 1 H.P.

WELL

IND.

NOT

S.N.	DESCRIPTION	SQM
1.	AREA OF PLATFORM SHELTERS:- I. ON P.F. NO. 1 II. ON P.F. NO. 2	137.68 137.68
2.	TOTAL AREA OF PLATFORM I. PLATFORM NO. 1 II. PLATFORM NO. 2	4485.00 3141.00
3.	AREA OF WAITING ROOM I. UPPER CLASS (LADIES) (GENTS) II. WAITING HALL	- 50.00 63.21
4.	CIRCULATING AREA	

REF:-	
FENCING	KUTCHA PUCCA
ROAD	METALLED UNMETALLED


N.R.D.R.M LKO SKETCH No 57-2000

CORRECTED UP TO 31-3-2000

DEN-III / N.R.LKO

CORRECTED UP TO 31-3-2002

DEN-III

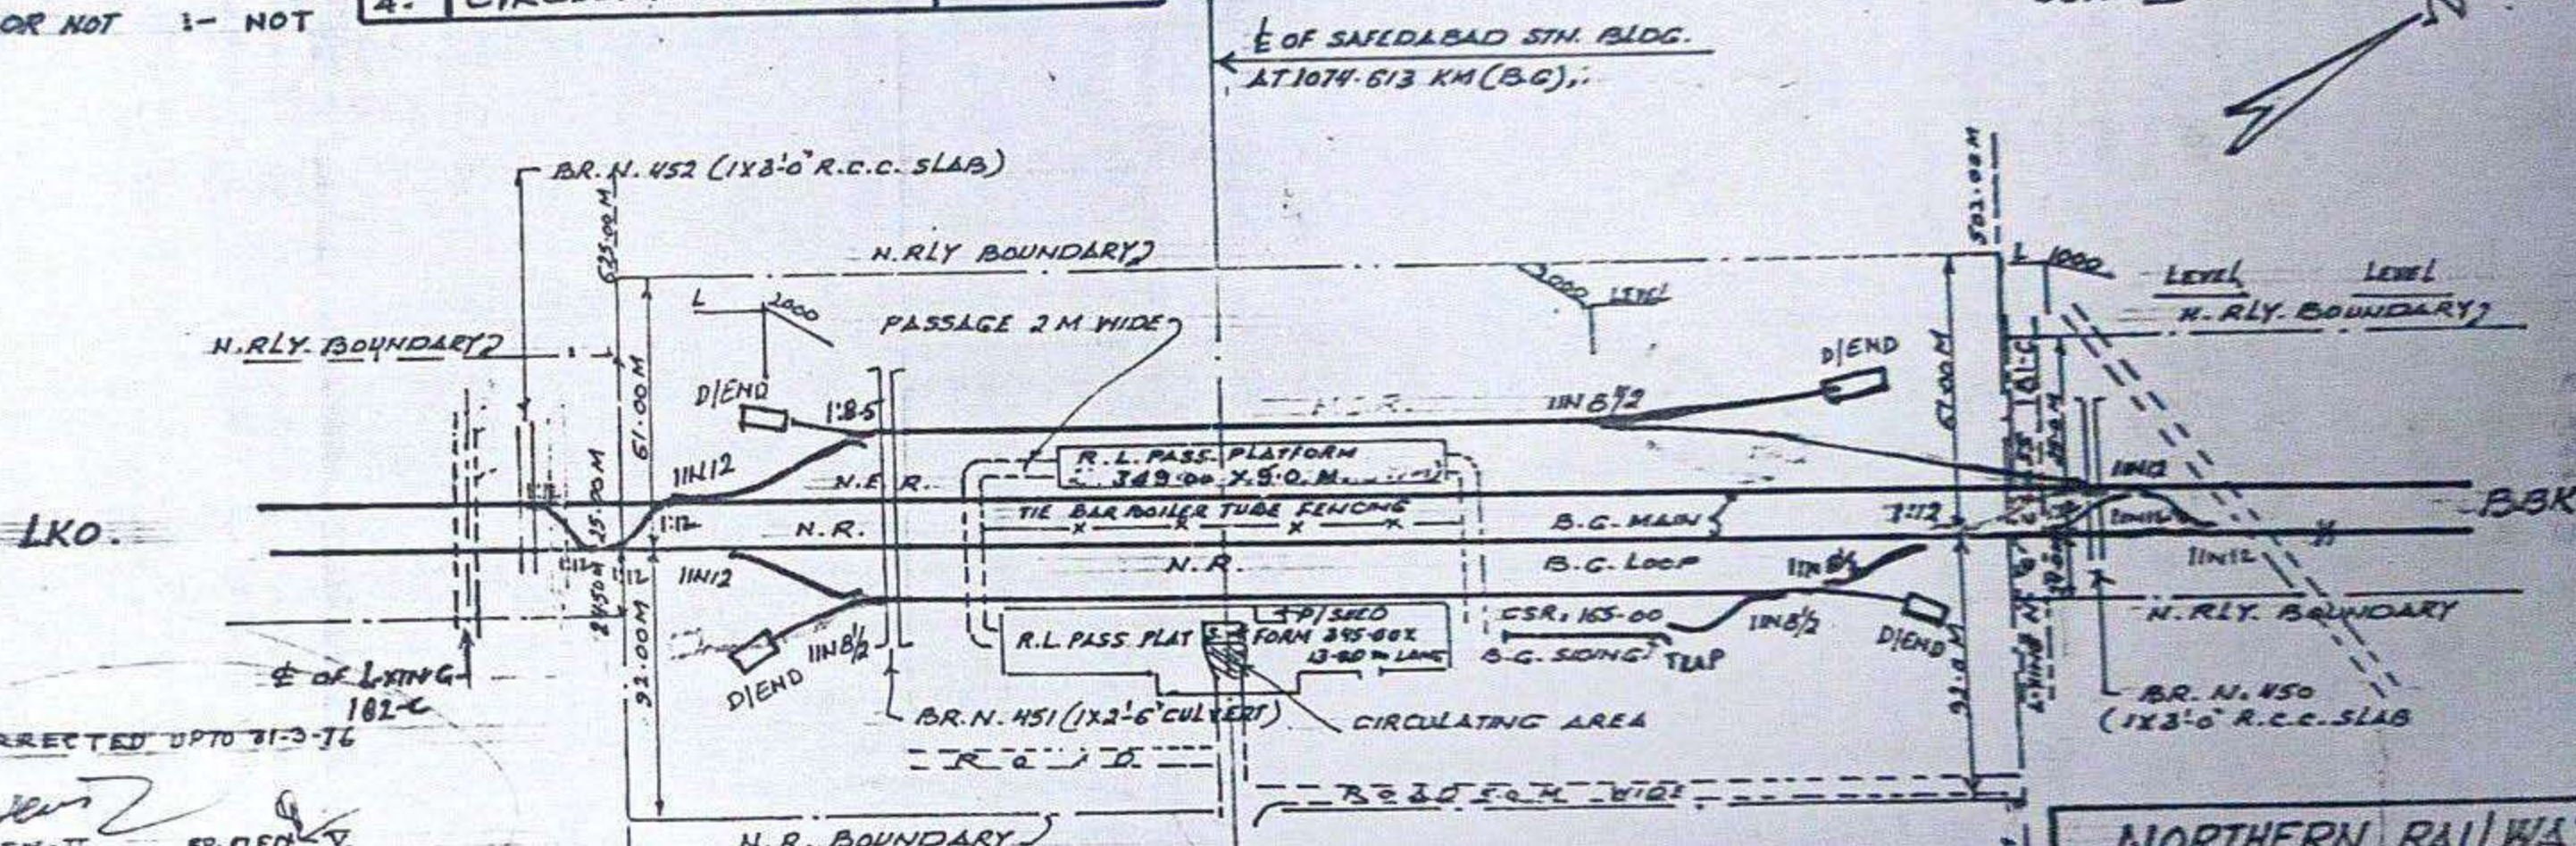

CORRECTED UP TO
31-3-12

ADEN-II

CORRECTED UP TO 31-3-16

ADEN-II

CORRECTED UP TO 31-3-13

ADEN-R

CORRECTED UP TO 31-3-14

ADEN-II DEN-V

CORRECTED UP TO 31-3-2015

ADEN-II DEN-V

CORRECTED UP TO 31-3-2009

DEN-III / NR / LKO

DRAWN	TRACED	CHECKED	DATE	BY	DATE	BY	DATE	BY
+	+	+	31-3-2003	DEN-III	31-3-2005	DEN-III	31-3-2006	SR.DEN (X)
							31-3-2007	SR.DEN (V)
							31-3-2008	DEN (V)

DEN-V	31-3-2009
DEN-V	31-3-2010
DEN-2	31-3-11


NORTHERN RAILWAY
LUCKNOW DIVISION
LKO-FD-BSB SECTION
DIAGRAM OF
SAFEDABAD STATION YARD

R.L. 113-75m
M.S.L.


NOT TO SCALE

147

SAIDKHANPUR STATION YARD

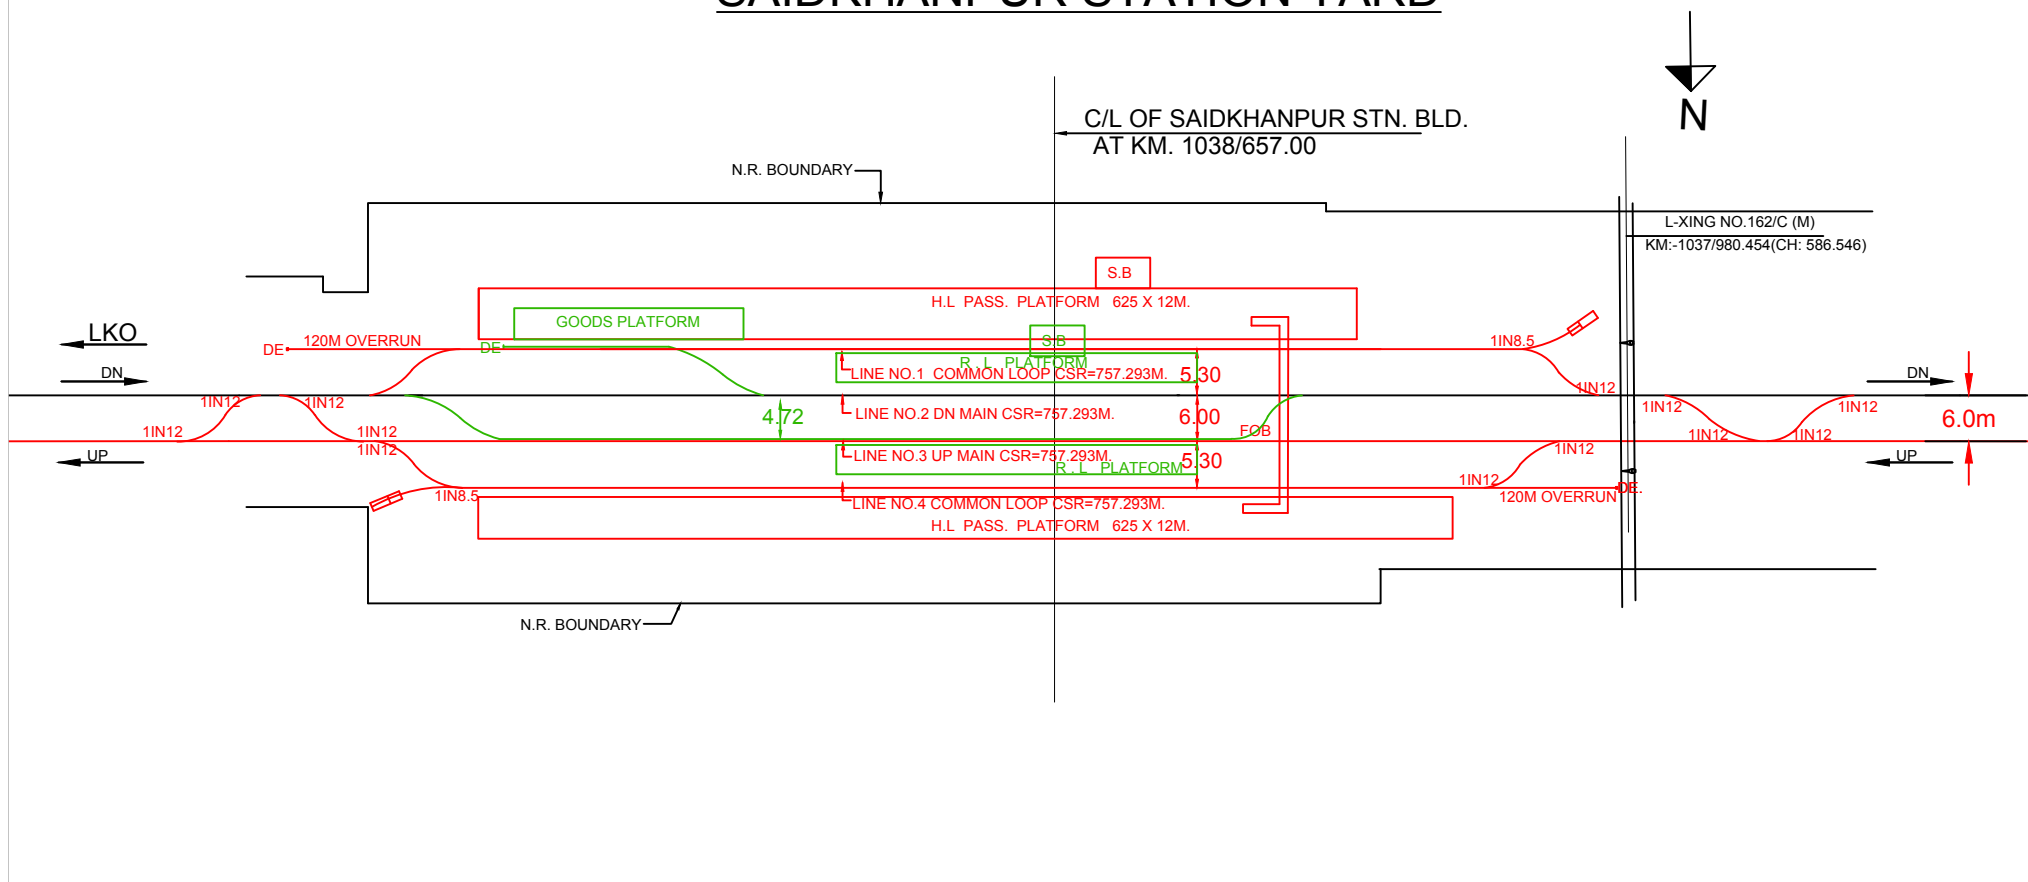


SALARPUR STATION YARD

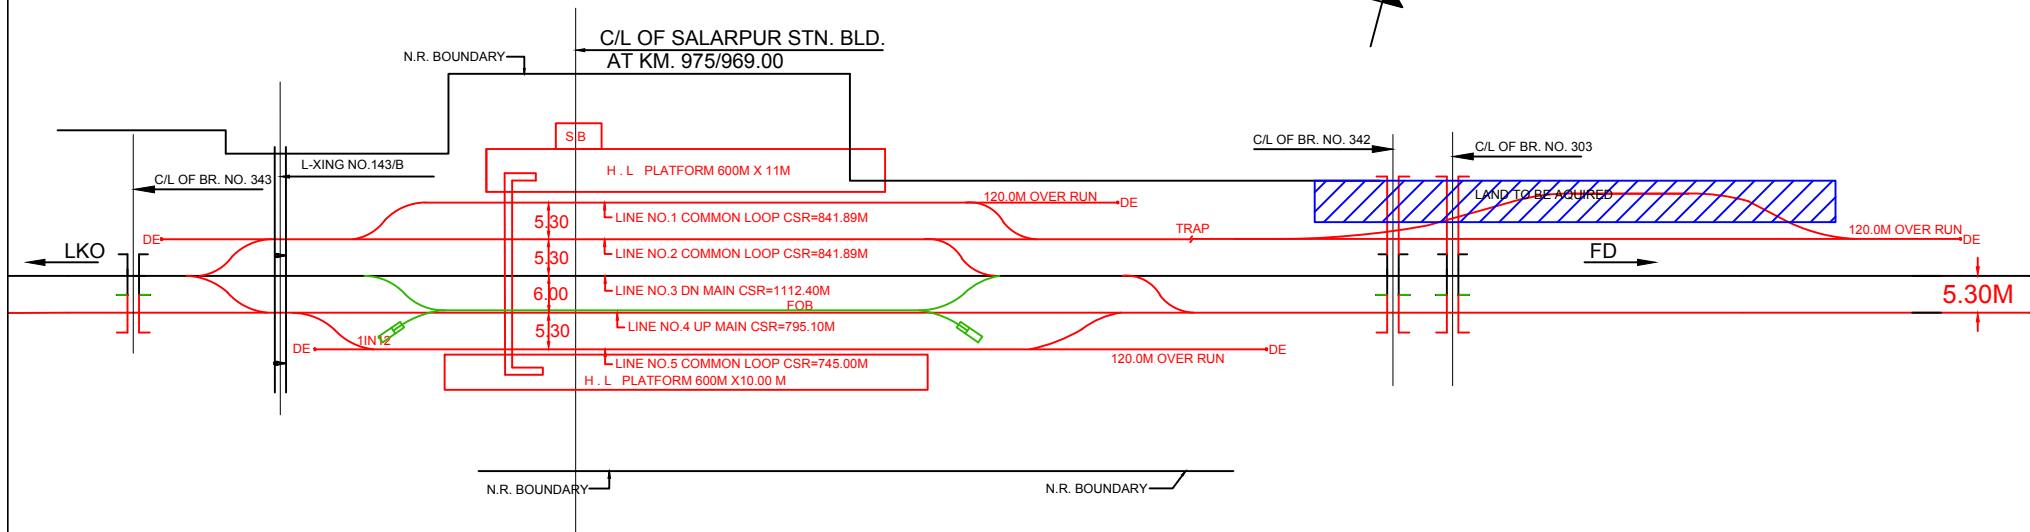

S. No.	DESCRIPTION	REMARKS
1	LAVATORIES	LAV. URINAL
2	NO OF WATER TAPS/HAND PUMPS ON EACH PLATFORM	LADIES GENTS TAPS H.P.
3	SOURCE OF WATER SUPPLY	
4	YEAR OF CONSTRUCTION OF STATION BUILDING	
5	BOOKING OFFICE NO. OF WINDOWS	ADV. RES. CURRENT RES.
6	NO. OF SEATS	P.F. No.1 P.F. No.2
7	WHETHER ENQUIRY OFFICE PROVIDED OR NOT	NOT

S. No.	DESCRIPTION	AREA (Sq.m.)
1	AREA OF PLATFORM SHELTER	P.F. No.1 NIL P.F. No.2 NIL
2	TOTAL AREA OF PLATFORM PLATFORM NO. 1 PLATFORM NO. 2	2292
3	AREA OF WAITING ROOM I- UPPER CLASS WAITING ROOM II- AREA OF WAITING ROOM a- LADIES b- GENTS III- WAITING HALL	NIL NIL NIL 2083
4	CIRCULATING AREA	69.61

REF.
FENCING { KUTCHA PUGGA
ROAD { METALLED UNMETALLED

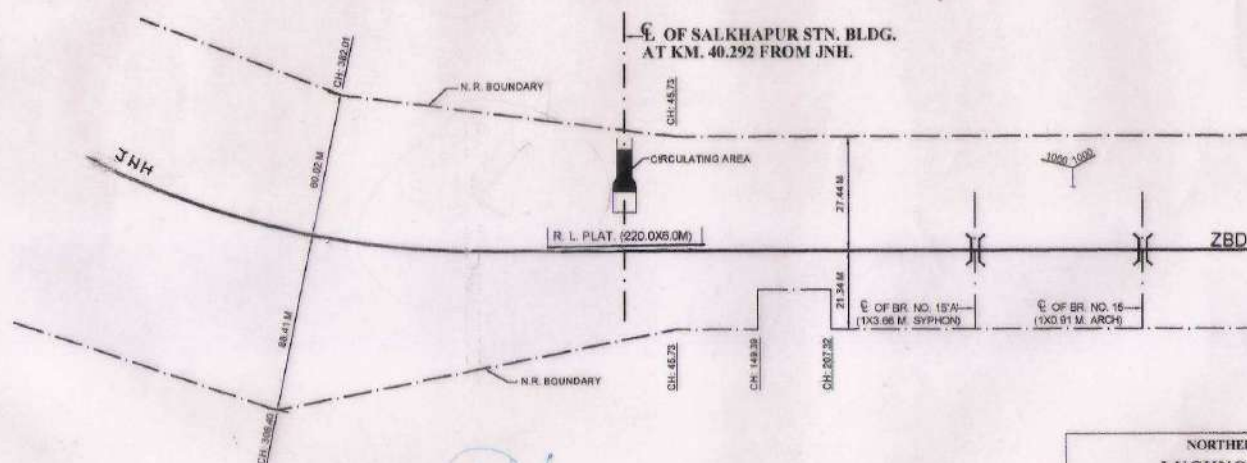


ADEN/PBH FEASIBILITY CHECKED

CHECKED BY
DRAWN BY

ADEN/PBH

Sr. DEN (II)	31-3-2010	31-3-2011	31-3-12
CORRECTED UPTO			

NORTHERN RAILWAY	
LUCKNOW DIVISION	
<u>ALD-JNH-JNU SECTION</u>	
<u>DIAGRAM OF</u>	
SALKHAPUR STN: YARD	
R.L./M.S.L.	NOT TO SCALE
N.R. D.R.M. LKO. SKETCH NO.	

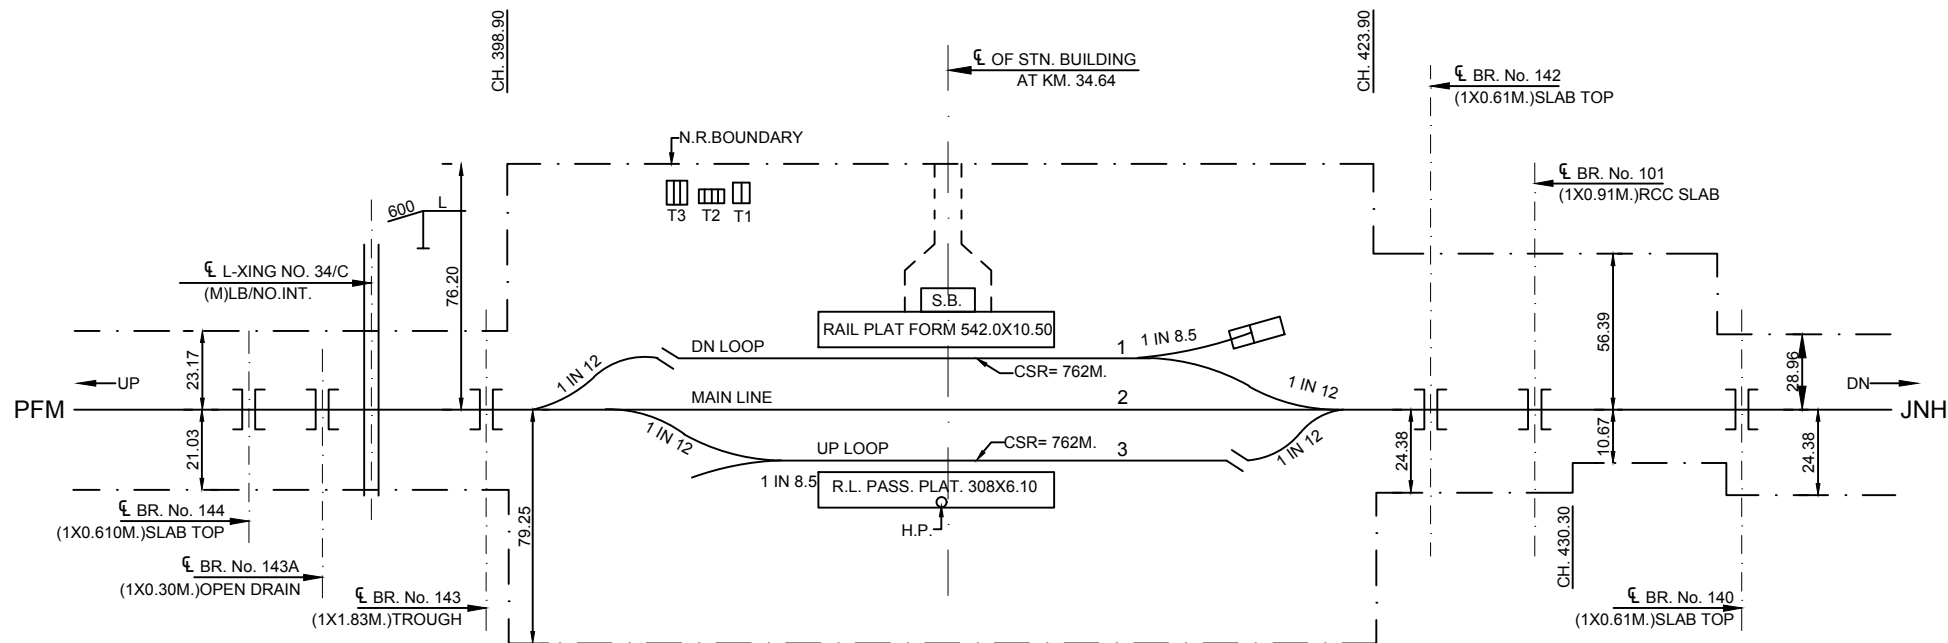

NORTHERN RAILWAY
LUCKNOW DIVISION

JNH-PFM SECTION
DIAGRAM OF
SARAI CHANDI STN. YARD

CHECKED BY

DRAWN BY

Sr. DEN/(IV)

ADEN/PRG

CORRECTED UPTO


18-02-2020

R.L./M.S.L.

NOT TO SCALE

N.R. D.R.M. LKO. SKETCH NO.

299-06

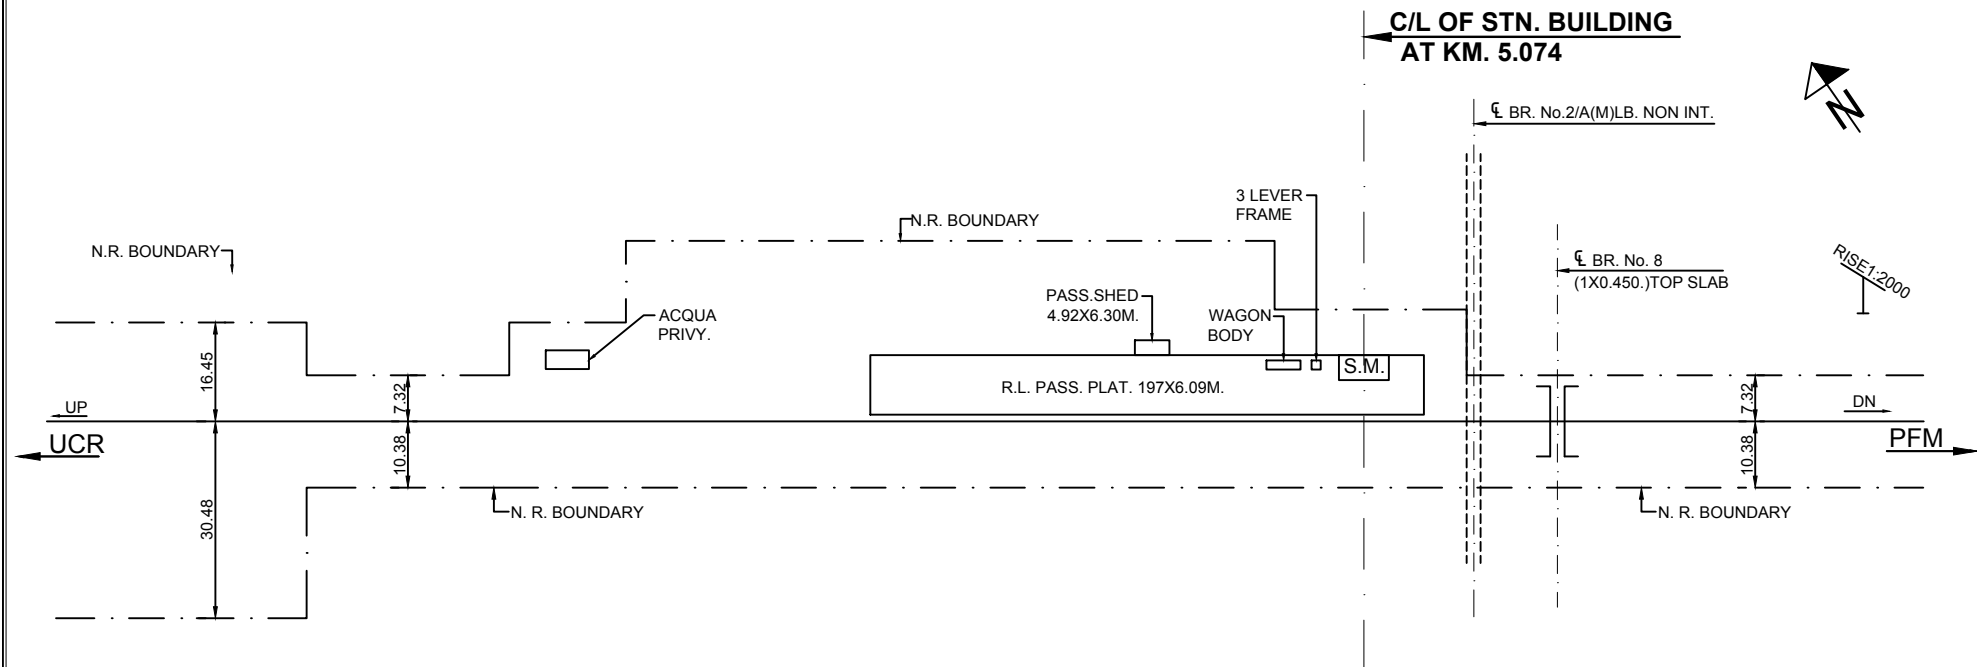


CHECKED BY	
DRAWN BY	

Sr. DEN/(IV)					
ADEN/PRG					
CORRECTED UPTO	18-02-2020				

NORTHERN RAILWAY	
LUCKNOW DIVISION	
PFM-UCR-ON SECTION	
DIAGRAM OF	
SARAI GOPAL STN. YARD	
R.L./M.S.L. 95.420m	NOT TO SCALE
N.R. D.R.M. LKO. SKETCH NO.	301-06




C/L OF SARAI HARKHU STN.
AT KM. 849/210

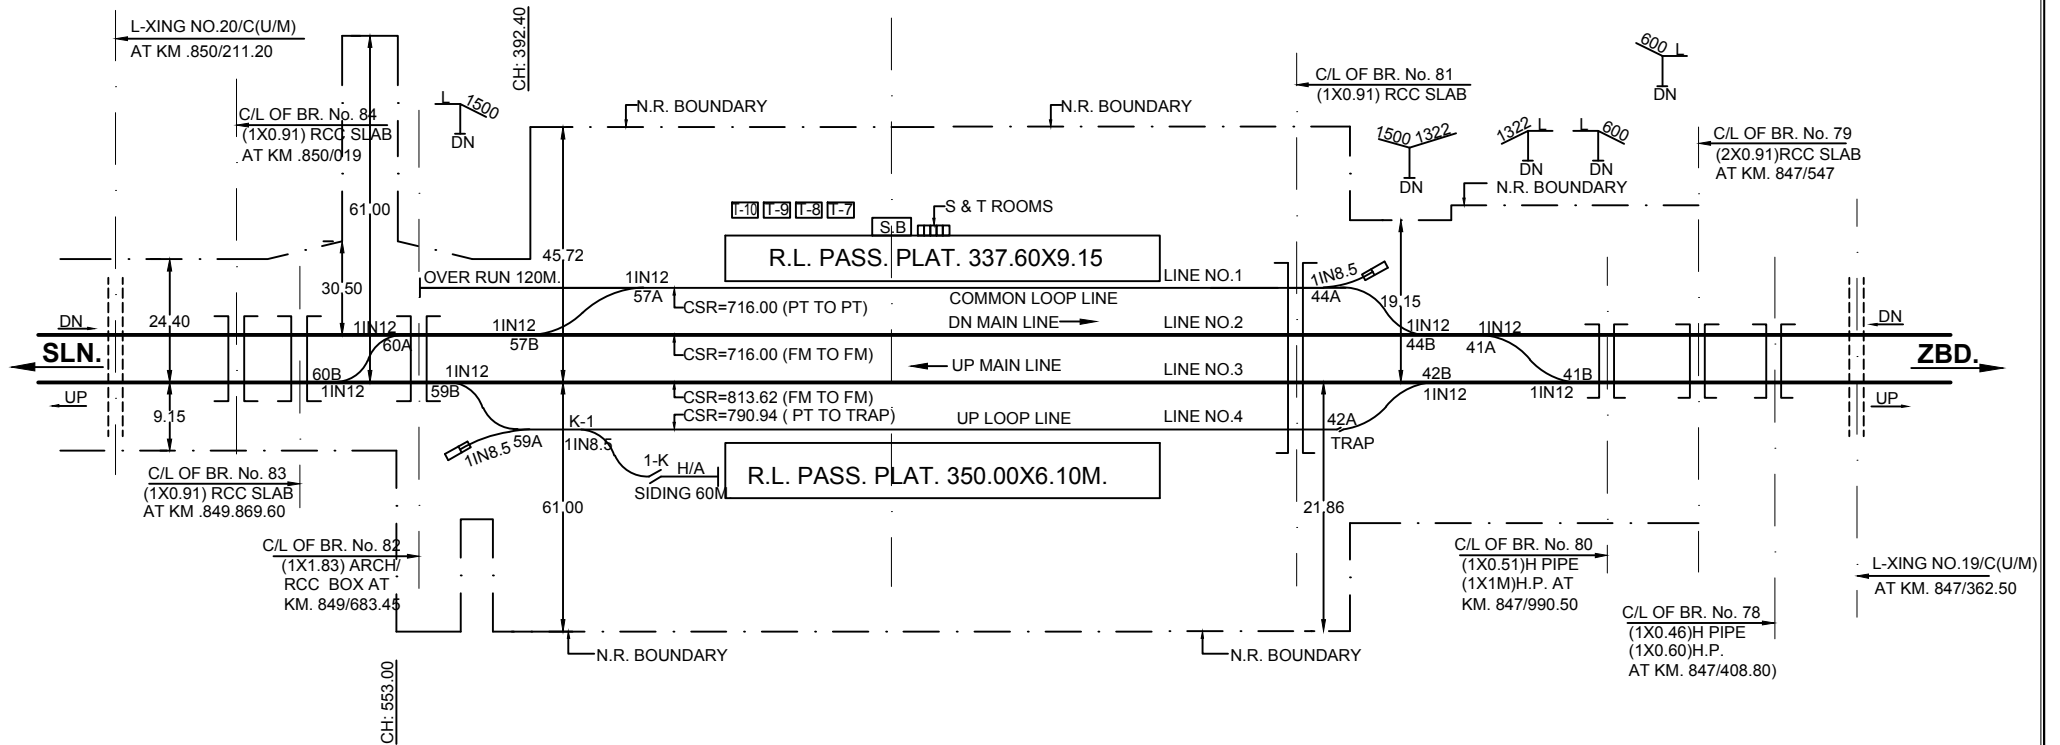

NORTHERN RAILWAY
LUCKNOW DIVISION
LKO -SLN-ZBD SECTION
DIAGRAM OF
SARAI HARKHU STN. YARD

R.L./M.S.L. 85.890m NOT TO SCALE
N.R. D.R.M. LKO. SKETCH NO. 263-06

CHECKED BY		Sr. DEN/(IV)					
DRAWN BY		ADEN/SLN-II					
		CORRECTED UPTO	18-02-2020				

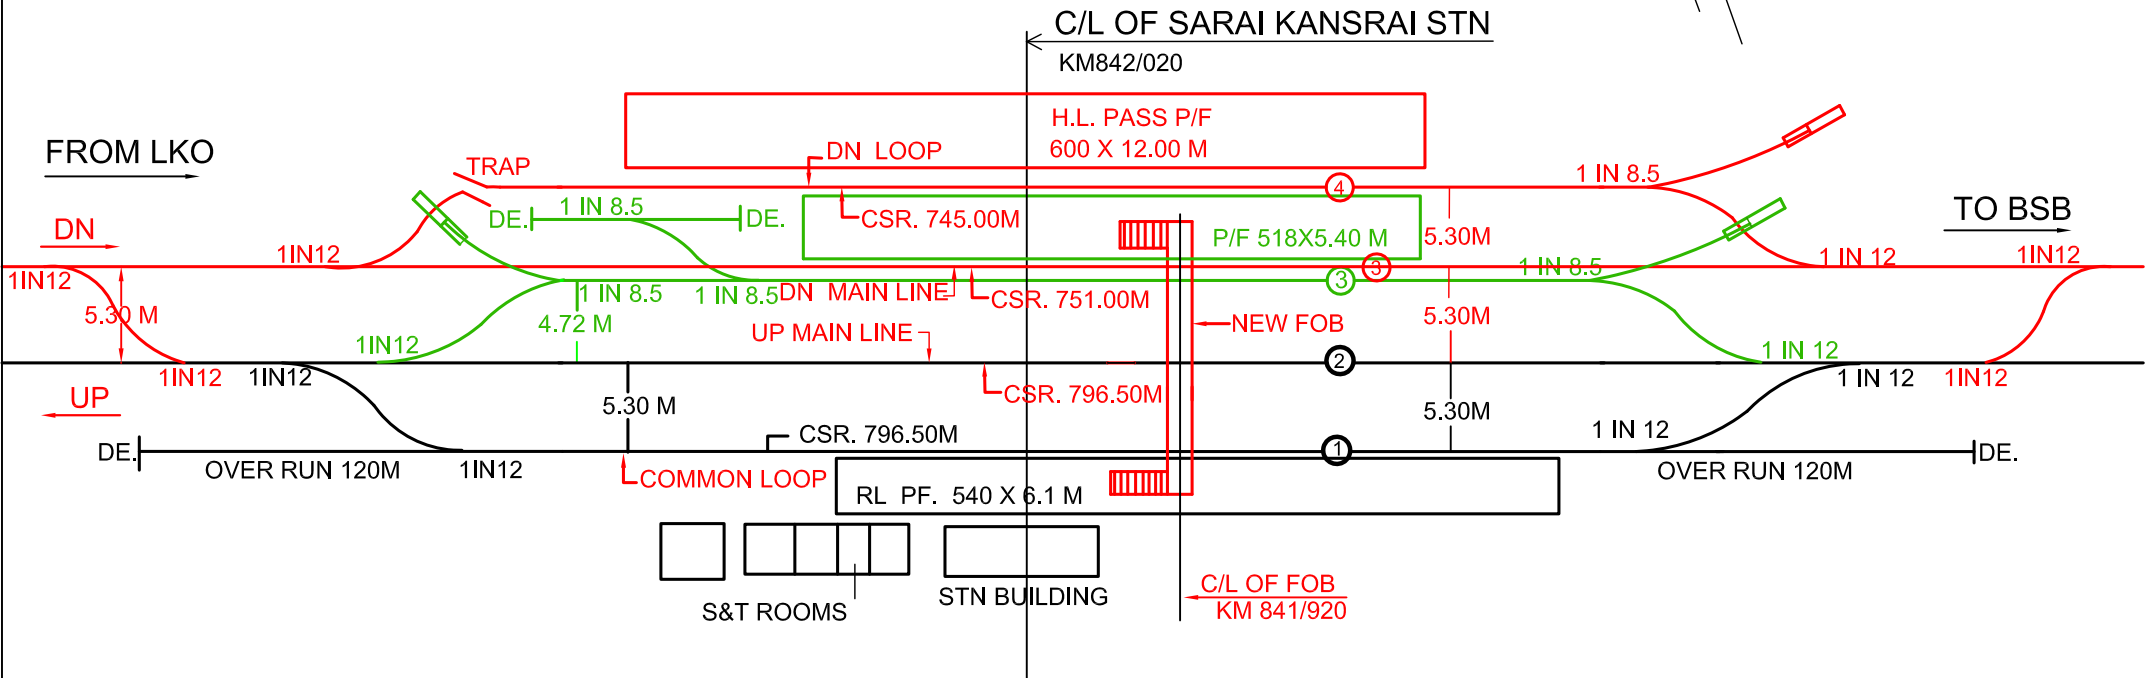


S. No.	DESCRIPTION	AREA (sq. m.)
1.	AREA OF PLATFORM SHELTER	P/F No.1 P/F No.2 NIL NIL
2.	<u>TOTAL AREA OF PLATFORM</u> PLATFORM NO. 1 PLATFORM NO. 2	 2513.20 1830.00
3.	AREA OF WAITING ROOM I- UPPER CLASS WAITING ROOM II - AREA OF WAITING ROOM a- LADIES b- GENTS III- WAITING HALL	NIL - - 21
4.	CIRCULATING AREA	69.00

S. No.	DESCRIPTION	AREA (sq. m.)
1.	AREA OF PLATFORM SHELTER	P/F No.1 P/F No.2 NIL NIL
2.	<u>TOTAL AREA OF PLATFORM</u> PLATFORM NO. 1 PLATFORM NO. 2	 2513.20 1830.00
3.	AREA OF WAITING ROOM I- UPPER CLASS WAITING ROOM II - AREA OF WAITING ROOM a- LADIES b- GENTS III- WAITING HALL	NIL - - 21
4.	CIRCULATING AREA	69.00


FENCING — { KUTCHA
PUCCA

ROAD — { METALLED
UNMETALLED

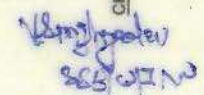





NORTHERN RAILWAY	
LUCKNOW DIVISION	
<u>LKO-FD-BSB SECTION</u>	
<u>DIAGRAM OF</u>	
SARKONI STN: YARD	
R.L./M.S.L.	81.13M
NOT TO SCALE	
N.R. DIVL. SKETCH NO: M-194/LKO-2012	


SEWAPURI STATION
NOT TO SCALE

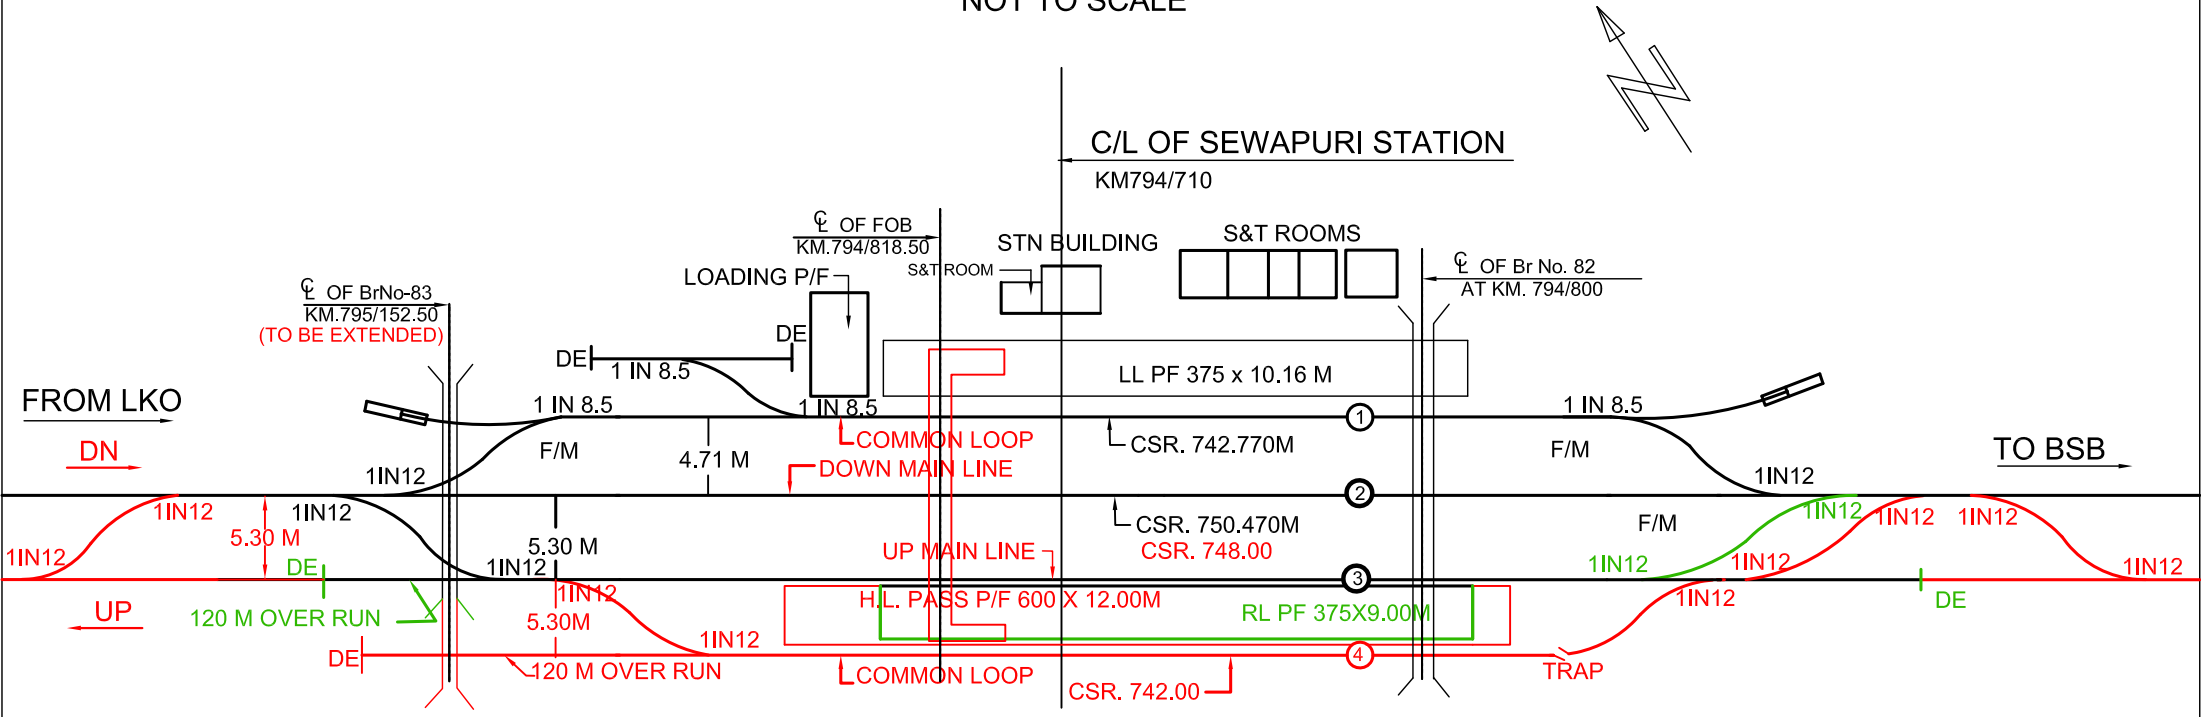

S. No.	DESCRIPTION	REMARKS		S. No.	DESCRIPTION	AREA (Sq.m.)
1	LAVATORIES	LAV.	URINAL	1	AREA OF PLATFORM SHELTER	P/F No.1 1236.00 P/F No.2 -
		LADIES 6	10			
		GENTS 8				
2	NO OF WATER TAPS/HAND PUMPS ON EACH PLATFORM	P/F No. TAPS 1 TO 4 49	H P 4	2	TOTAL AREA OF PLATFORM	
	SOURCE OF WATER SUPPLY	TUBE WELL 6			PLATFORM NO 1	4785.00
3	YEAR OF CONSTRUCTION OF STATION BUILDING	-			PLATFORM NO 2 & 3	5500.00
4	BOOKING OFFICE NO. OF WINDOWS	ADV. RES. 1	CURRENT RES.		PLATFORM NO 4	5438.40
5	NO. OF SEATS	P/F No. 1 2 3 & 4	SEATS 378	3	AREA OF WAITING ROOM	
					I- UPPER CLASS WAITING ROOM	NIL
					II - AREA OF WAITING ROOM	
					a- LADIES	46.36
					b- GENTS	15.08
					III- WAITING HALL	329.00
6	WHETHER ENQUIRY OFFICE PROVIDED OR NOT	YES		4	CIRCULATING AREA	1308.0

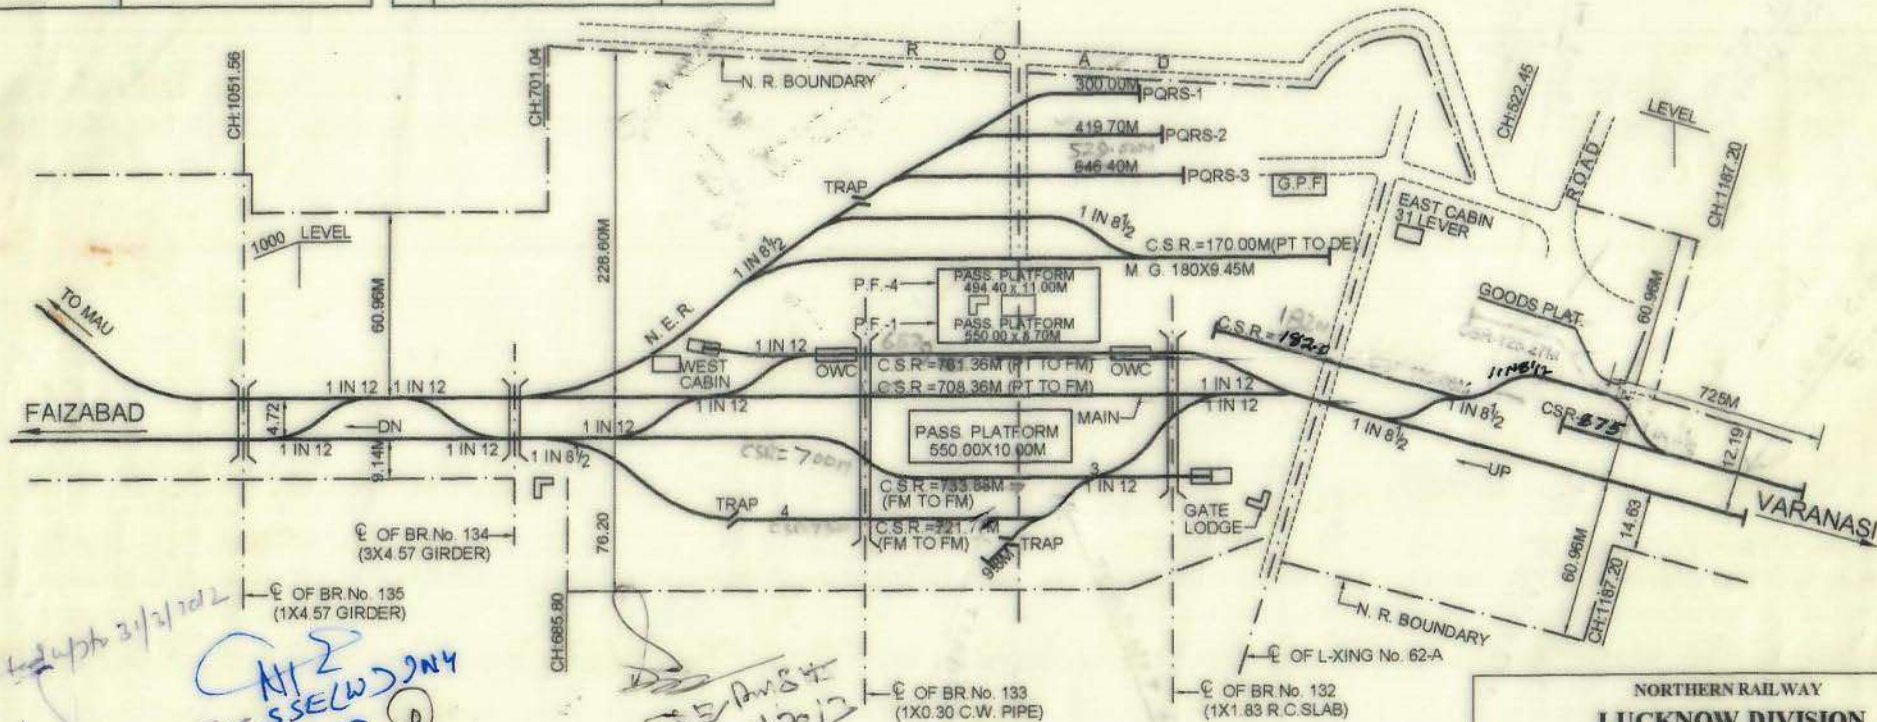

   Sr. D.E.N. (III)					
ADEN/JNU	29.12.12	20/11/13		20/11/13	20/11/13
CORRECTED UPTO	31-03-12	31-3-13	31-3-14	31-3-15	31-3-2016

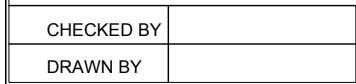

NORTHERN RAILWAY LUCKNOW DIVISION	
<u>LKO -SLN-ZBD SECTION</u> <u>DIAGRAM OF</u> SHIVNAGAR STN. YARD	
R.L./M.S.L. 102.266m	NOT TO SCALE
N.R. D.R.M. LKO. SKETCH NO.	274 - 06

S. No.	DESCRIPTION	REMARKS		
1	LAVATORIES		LAV.	URINAL
		LADIES	2	-
		GENTS	2	1
2	NO OF WATER TAPS/HAND PUMPS ON EACH PLATFORM	P/F No.	TAPS	H.P.
		1	4	1
		2	16	
	SOURCE OF WATER SUPPLY			
3	YEAR OF CONSTRUCTION OF STATION BUILDING	-		
4	BOOKING OFFICE NO. OF WINDOWS	ADV. RES. 1	CURRENT RES.	
5	NO. OF SEATS	P/F No.1 45	P/F No.2 55	
6	WHETHER ENQUIRY OFFICE PROVIDED OR NOT			


S. No.	DESCRIPTION	AREA (Sq.m.)
1	AREA OF PLATFORM SHELTER	P/F No.1 NIL P/F No.2 NIL
2	TOTAL AREA OF PLATFORM	
	PLATFORM NO. 1	3147.80
	PLATFORM NO. 2	4442.85
3	AREA OF WAITING ROOM	
	I- UPPER CLASS WAITING ROOM	NIL
	II- AREA OF WAITING ROOM	
	a- LADIES	
	b- GENTS	
	III- WAITING HALL	120.6
4	CIRCULATING AREA	1377.0

REF. FENCING - KUTCHA PUGGA
ROAD - METALLED UNMETALLED

CORRECTED UP TO 31-03-2013

ADEN/BSB

SR-DEN-III

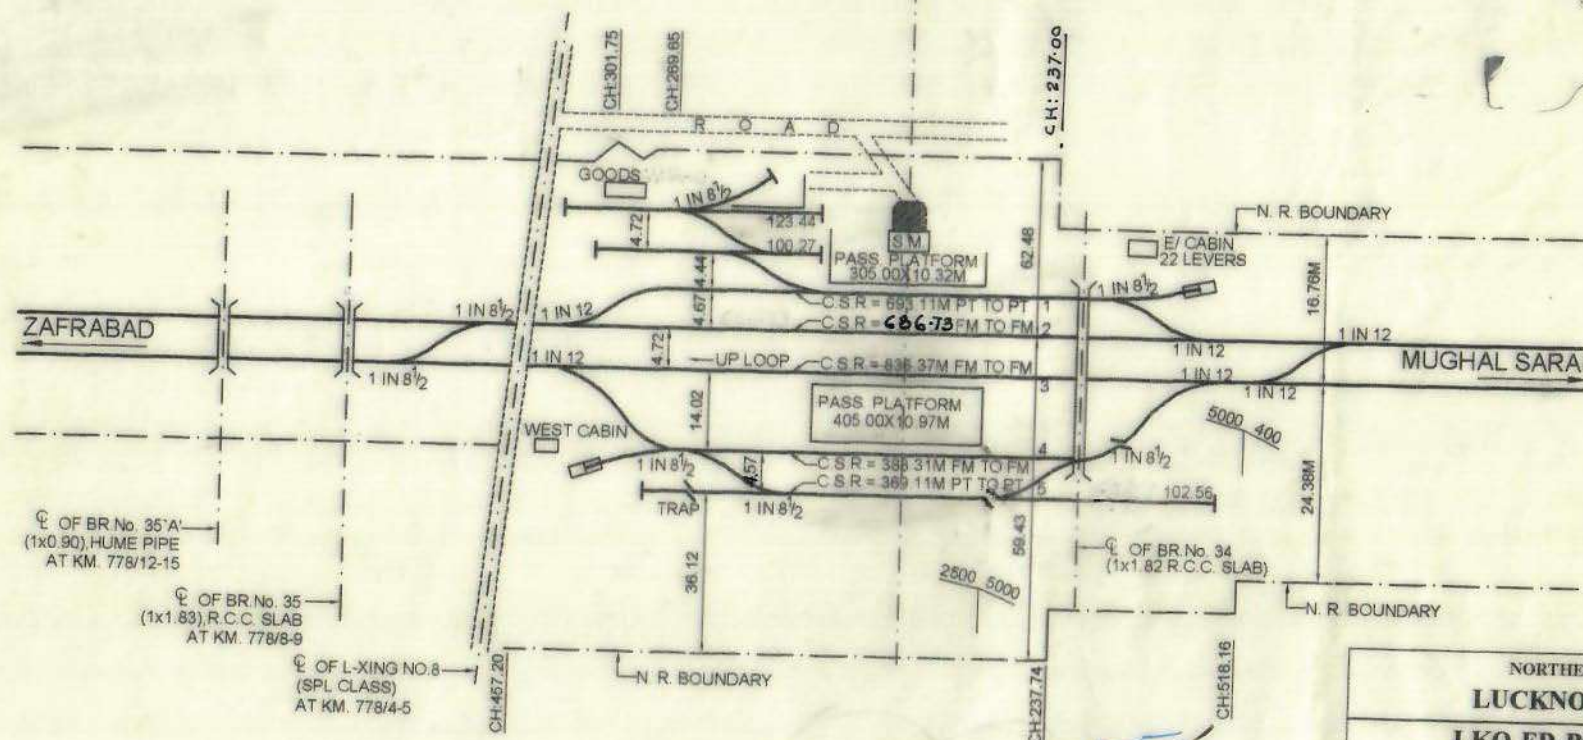

☐ OF BR No. 35'A' (1x0.90) HUME PIPE AT KM. 778/12-15

☐ OF BR No. 35 (1x1.83) R.C.C. SLAB AT KM. 778/8-9

☐ OF L-XING NO. 8 (SPL CLASS) AT KM. 778/4-5

CHECKED BY
DRAWN BY

D.E.N. (III)

ADEN/BSB

CORRECTED UPTO

31-03-12

31-3-2013

31-3-14


31-03-15

31-3-2016

NORTHERN RAILWAY
LUCKNOW DIVISION
LKO-FD-BSB SECTION
DIAGRAM OF
SHIVPUR STN: YARD
R.L./M.S.L. 99.50M
NOT TO SCALE
N.R. DIVL. SKETCH NO: M.187/LKO/2012

160

S. No.	DESCRIPTION	REMARKS	S. No.	DESCRIPTION	AREA (Sq.m.)
1	LAVATORIES	LAV. URINAL	1	AREA OF PLATFORM SHELTER	RIF No.1 RIF No.2 NIL
		LADIES			
		GENTS			
2	NO OF WATER TAPS/ HAND PUMPS ON EACH PLATFORM	RIF No. TAPS H.P.	2	TOTAL AREA OF PLATFORM	976
	SOURCE OF WATER SUPPLY			PLATFORM NO. 1	
				PLATFORM NO. 2	
3	YEAR OF CONSTRUCTION OF STATION BUILDING		3	AREA OF WAITING ROOM	NIL
				I- UPPER CLASS WAITING ROOM	
4	BOOKING OFFICE	ADV. RES. CURRENT RES.		II- AREA OF WAITING ROOM	
	NO. OF WINDOWS	-1-		a- LADIES	NIL
				b- GENTS	NIL
5	NO. OF SEATS	RIF No.1 RIF No.2		III- WAITING HALL	80.00
		15			
6	WHETHER ENQUIRY OFFICE PROVIDED OR NOT	NOT	4	CIRCULATING AREA	232.25

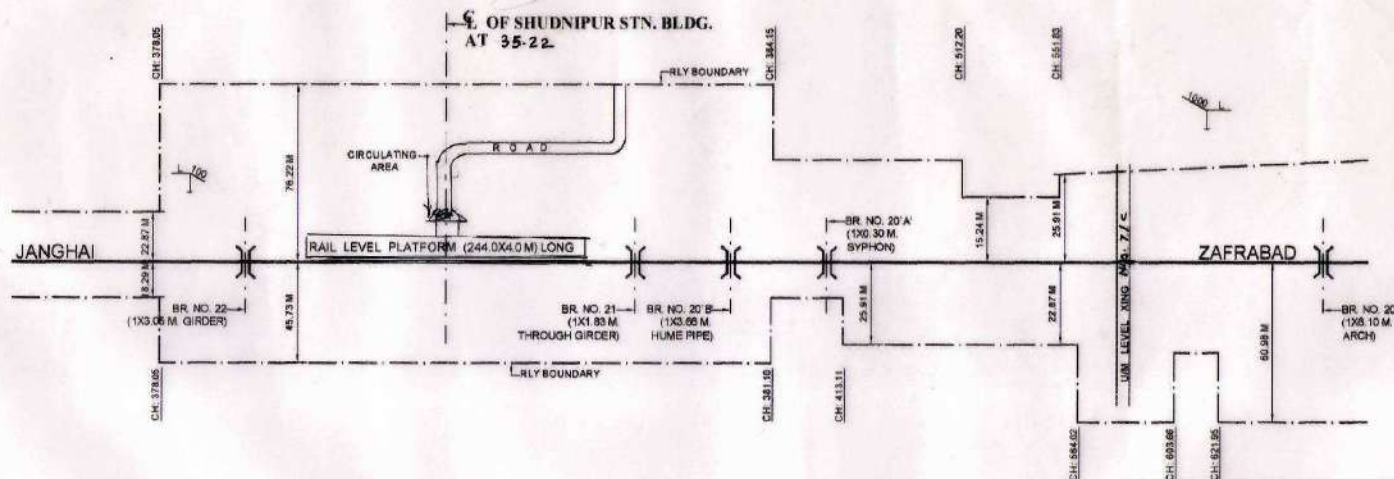

ADEN/PBH

FEASIBILITY CHECKED

CHECKED BY

DRAWN BY

DAKSH

ADEN/PBH

Sr. D.E.N.(II)

CORRECTED UPTO

31-7-2010

31-2-2011

31.3.12

ADEN-PBH

NORTHERN RAILWAY
LUCKNOW DIVISION

ALD-JNH-JNU SECTION


DIAGRAM OF

SHUDNIPUR STN. YARD

R.L./M.S.L.

NOT TO SCALE

N.R. D.R.M. I.K.O. SKETCH NO.

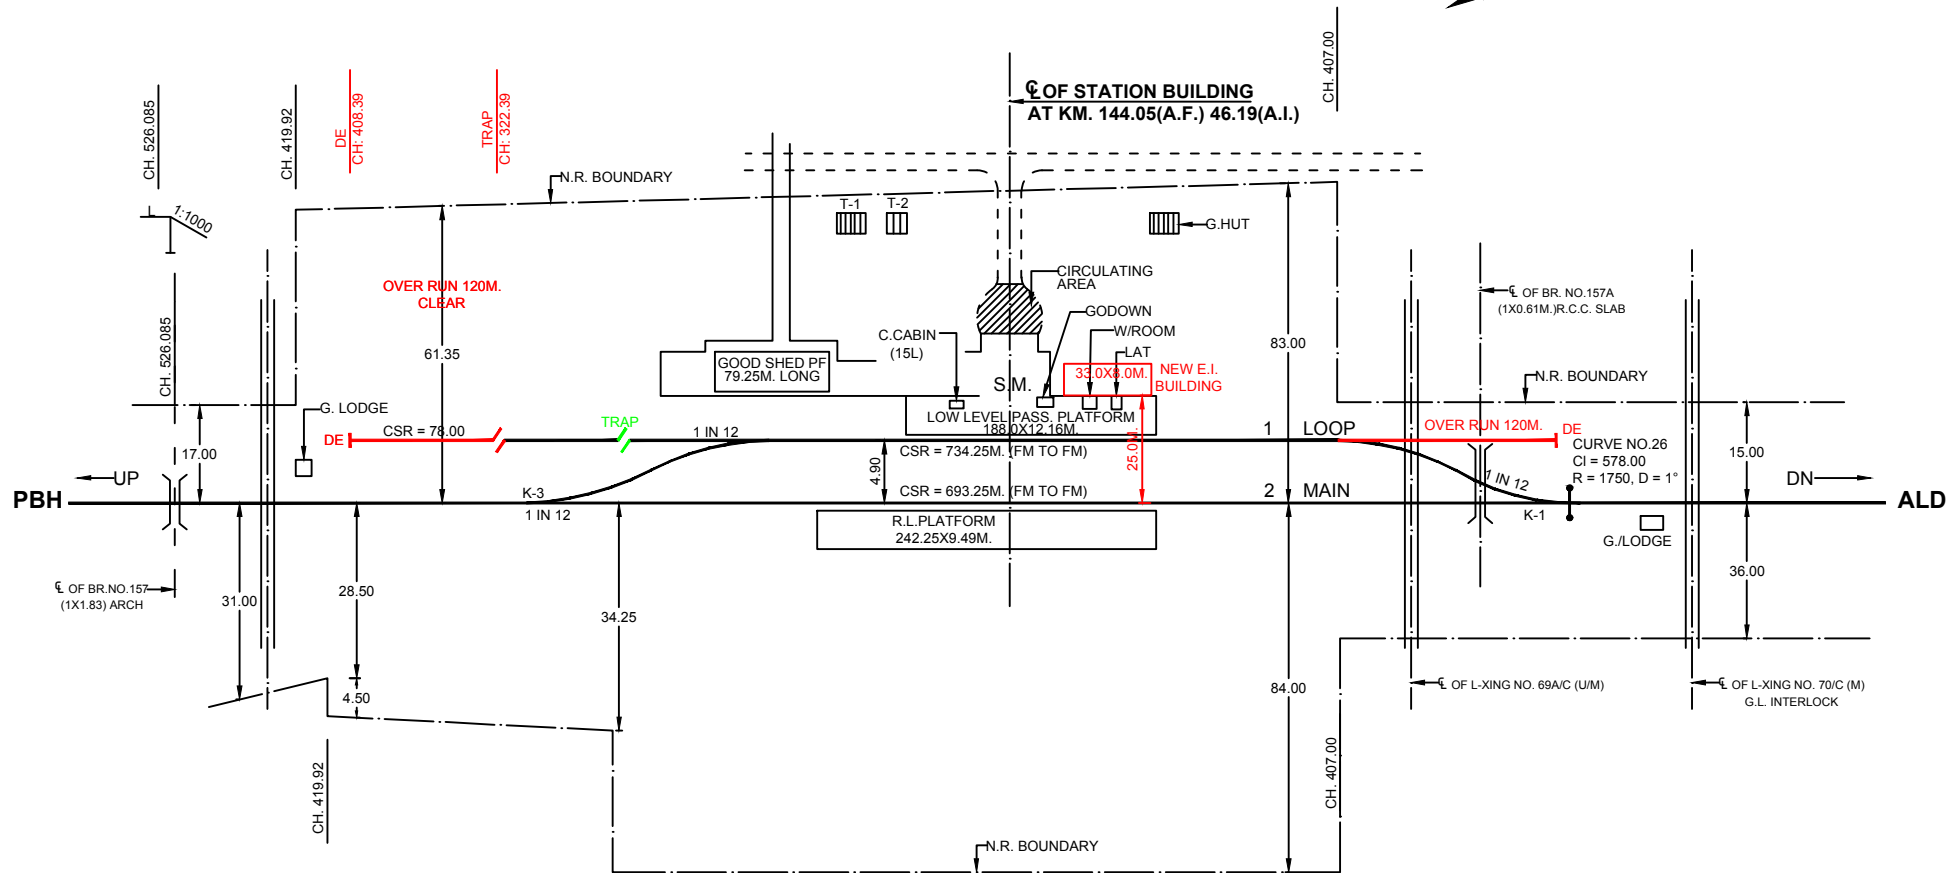




NORTHERN RAILWAY	
LUCKNOW DIVISION	
FD-SLN-FM SECTION	
DIAGRAM OF	
SIWAITH STN. YARD	
R.L./M.S.L. - 96.930M.	NOT TO SCALE
N.R. D.R.M. LKO. SKETCH NO.	331-06

CHECKED BY	
DRAWN BY	

ADEN/PRG		Sr.DEN/(IV)			
CORRECTED UPTO	18-02-2020				


SOHAWAL STATION YARD

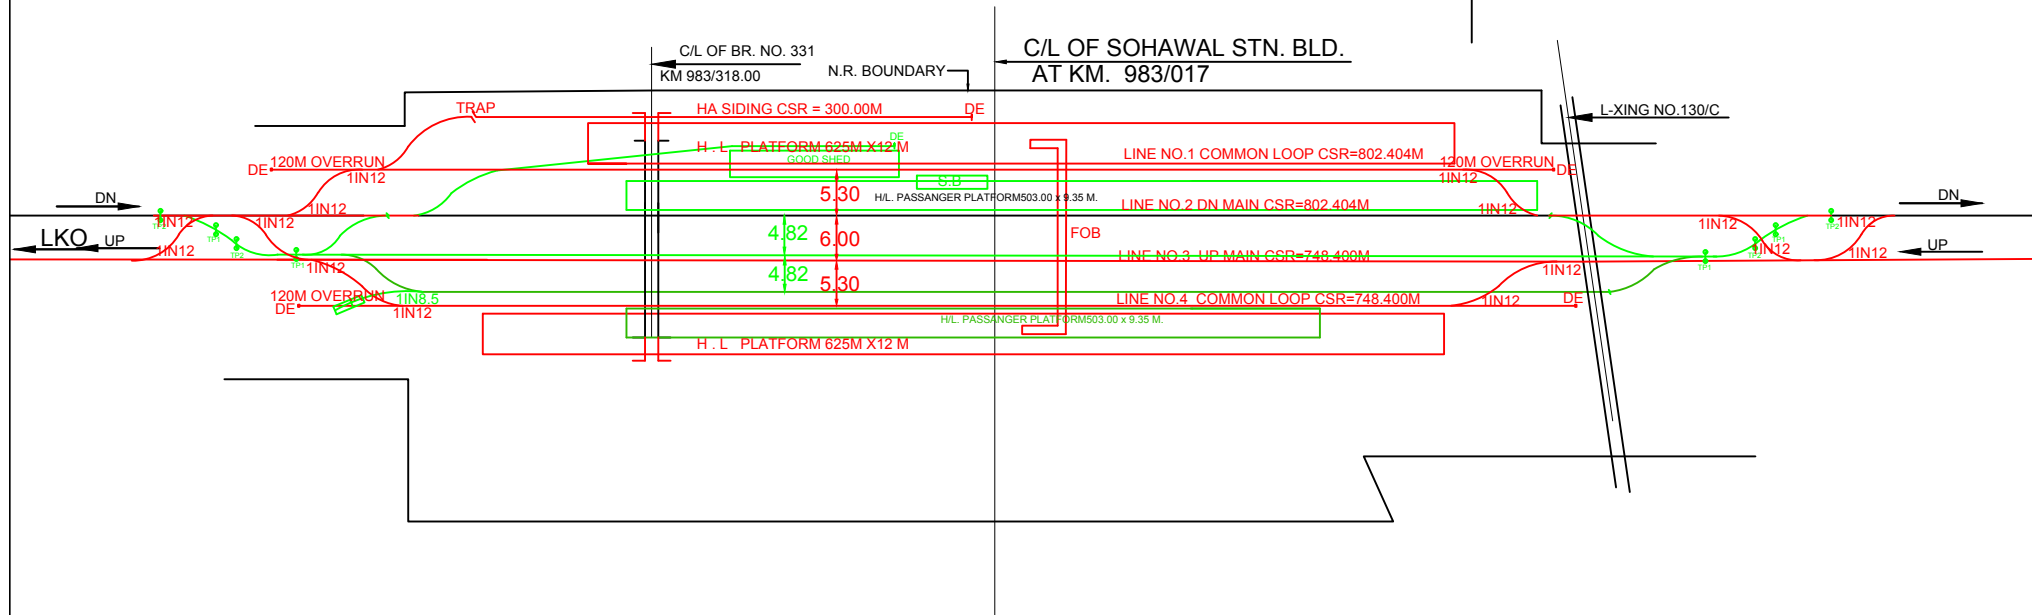

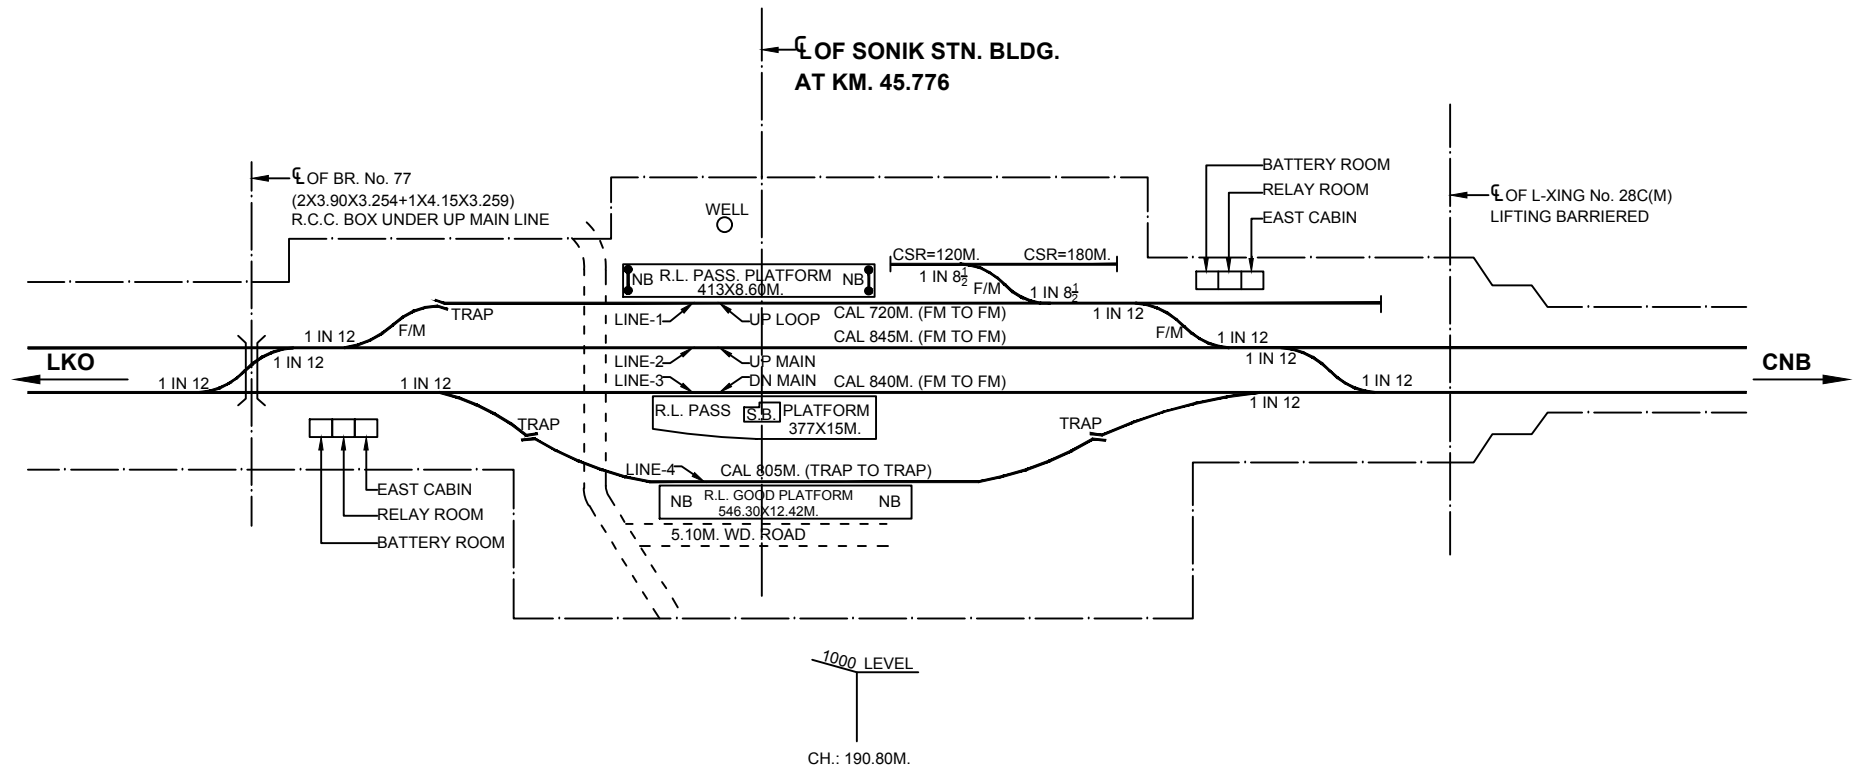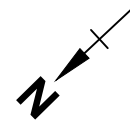


NORTHERN RAILWAY	
LUCKNOW DIVISION	
LKO-ON-CNB SECTION	
DIAGRAM OF	
SONIK STN: YARD	
R.L./M.S.L.	NOT TO SCALE
N.R. D.R.M. LKO. SKETCH NO.	

Sr. DEN(V)						
ADEN/III/LKO						
CORRECTED UPTO		16-10-2020				
CHECKED BY						
DRAWN BY						

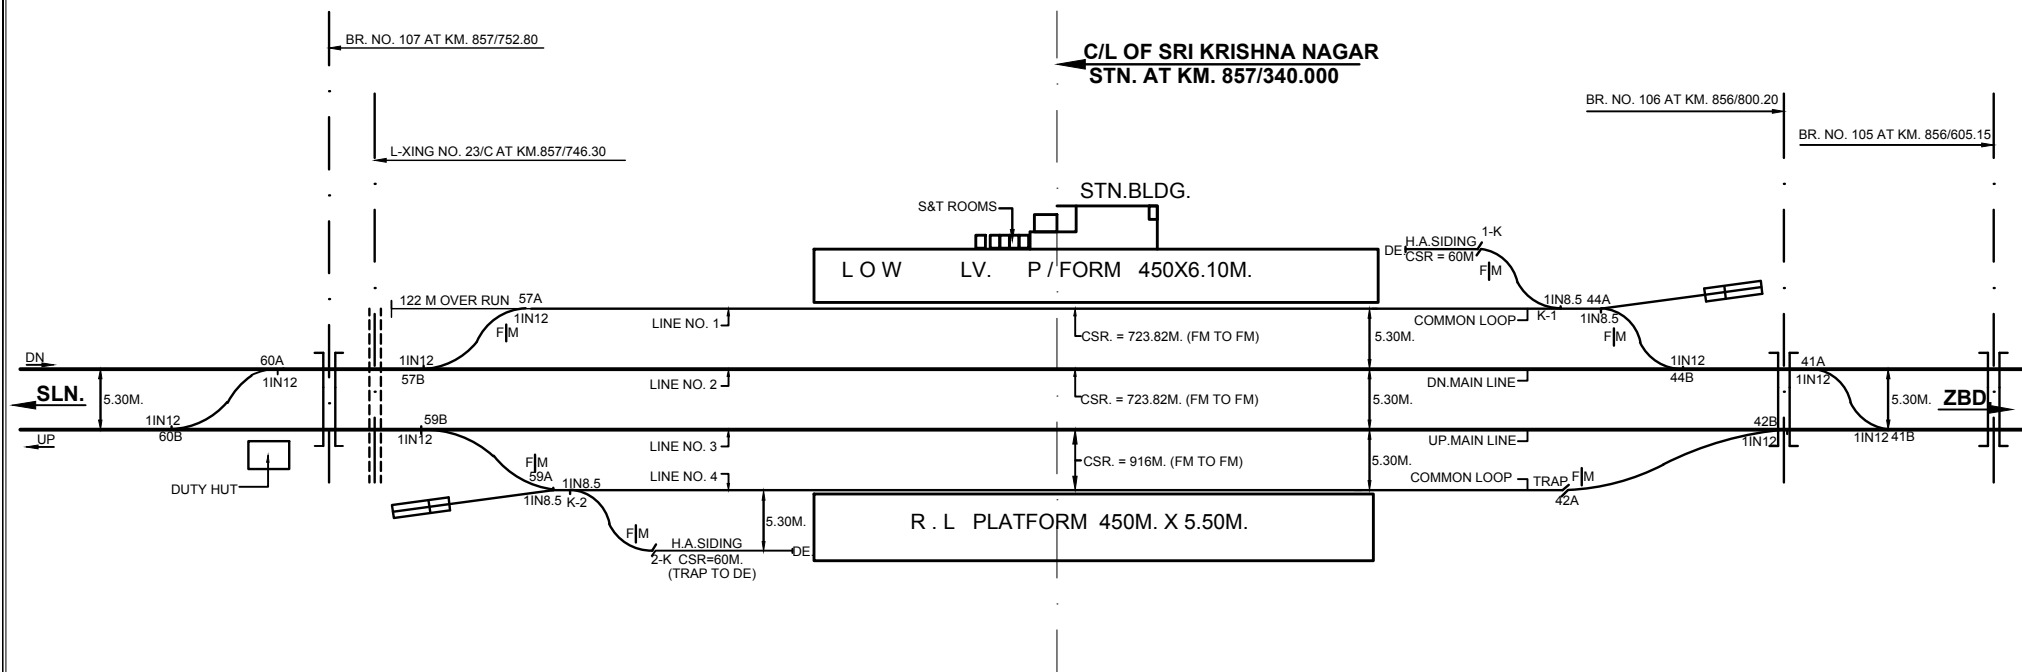


NORTHERN RAILWAY LUCKNOW DIVISION	
LKO -SLN-ZBD SECTION	
DIAGRAM OF	
SRI KRISHNA NAGAR STN. YARD.	
R.L./M.S.L. 87.190m	NOT TO SCALE
N.R. D.R.M. LKO. SKETCH NO.	264 - 06

CHECKED BY		Sr. DEN/(IV)					
		ADEN/SLN-II					
		CORRECTED UPTO	18-02-2020				

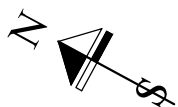

CL OF SRIRAJNAGAR STN. BLDG. Km:1031.690

CH: 0.00

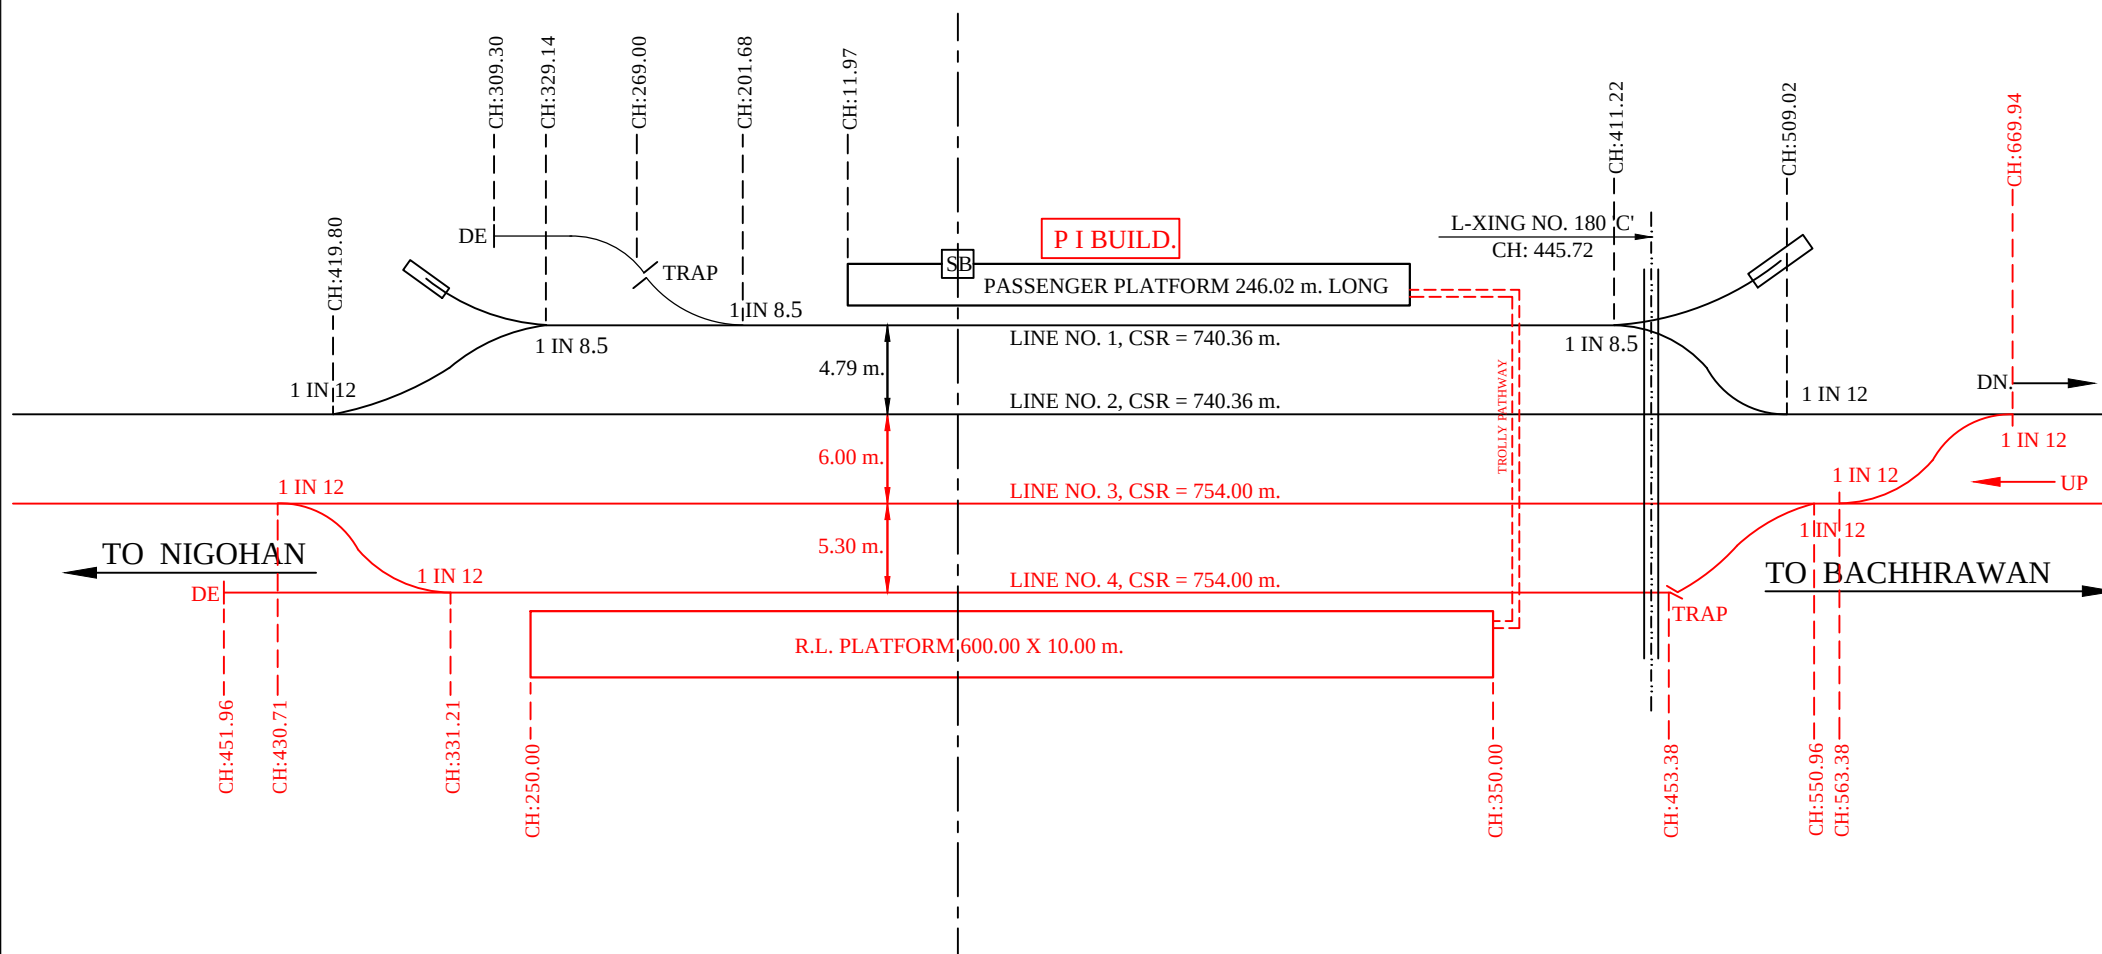



LEGEND:-

- EXISTING WORK SHOWN THUS
- PROPOSED WORK SHOWN THUS
- DISMENTLING WORK SHOWN THUS
- THIS DRAWING IS NOT TO SCALE

S.No	DESCRIPTION	1 in 12	1 in 8½	TRAP
1.	DISMANTLING OF TURN OUT	0	0	0
2.	INSERTION OF TURN OUT	5	0	2



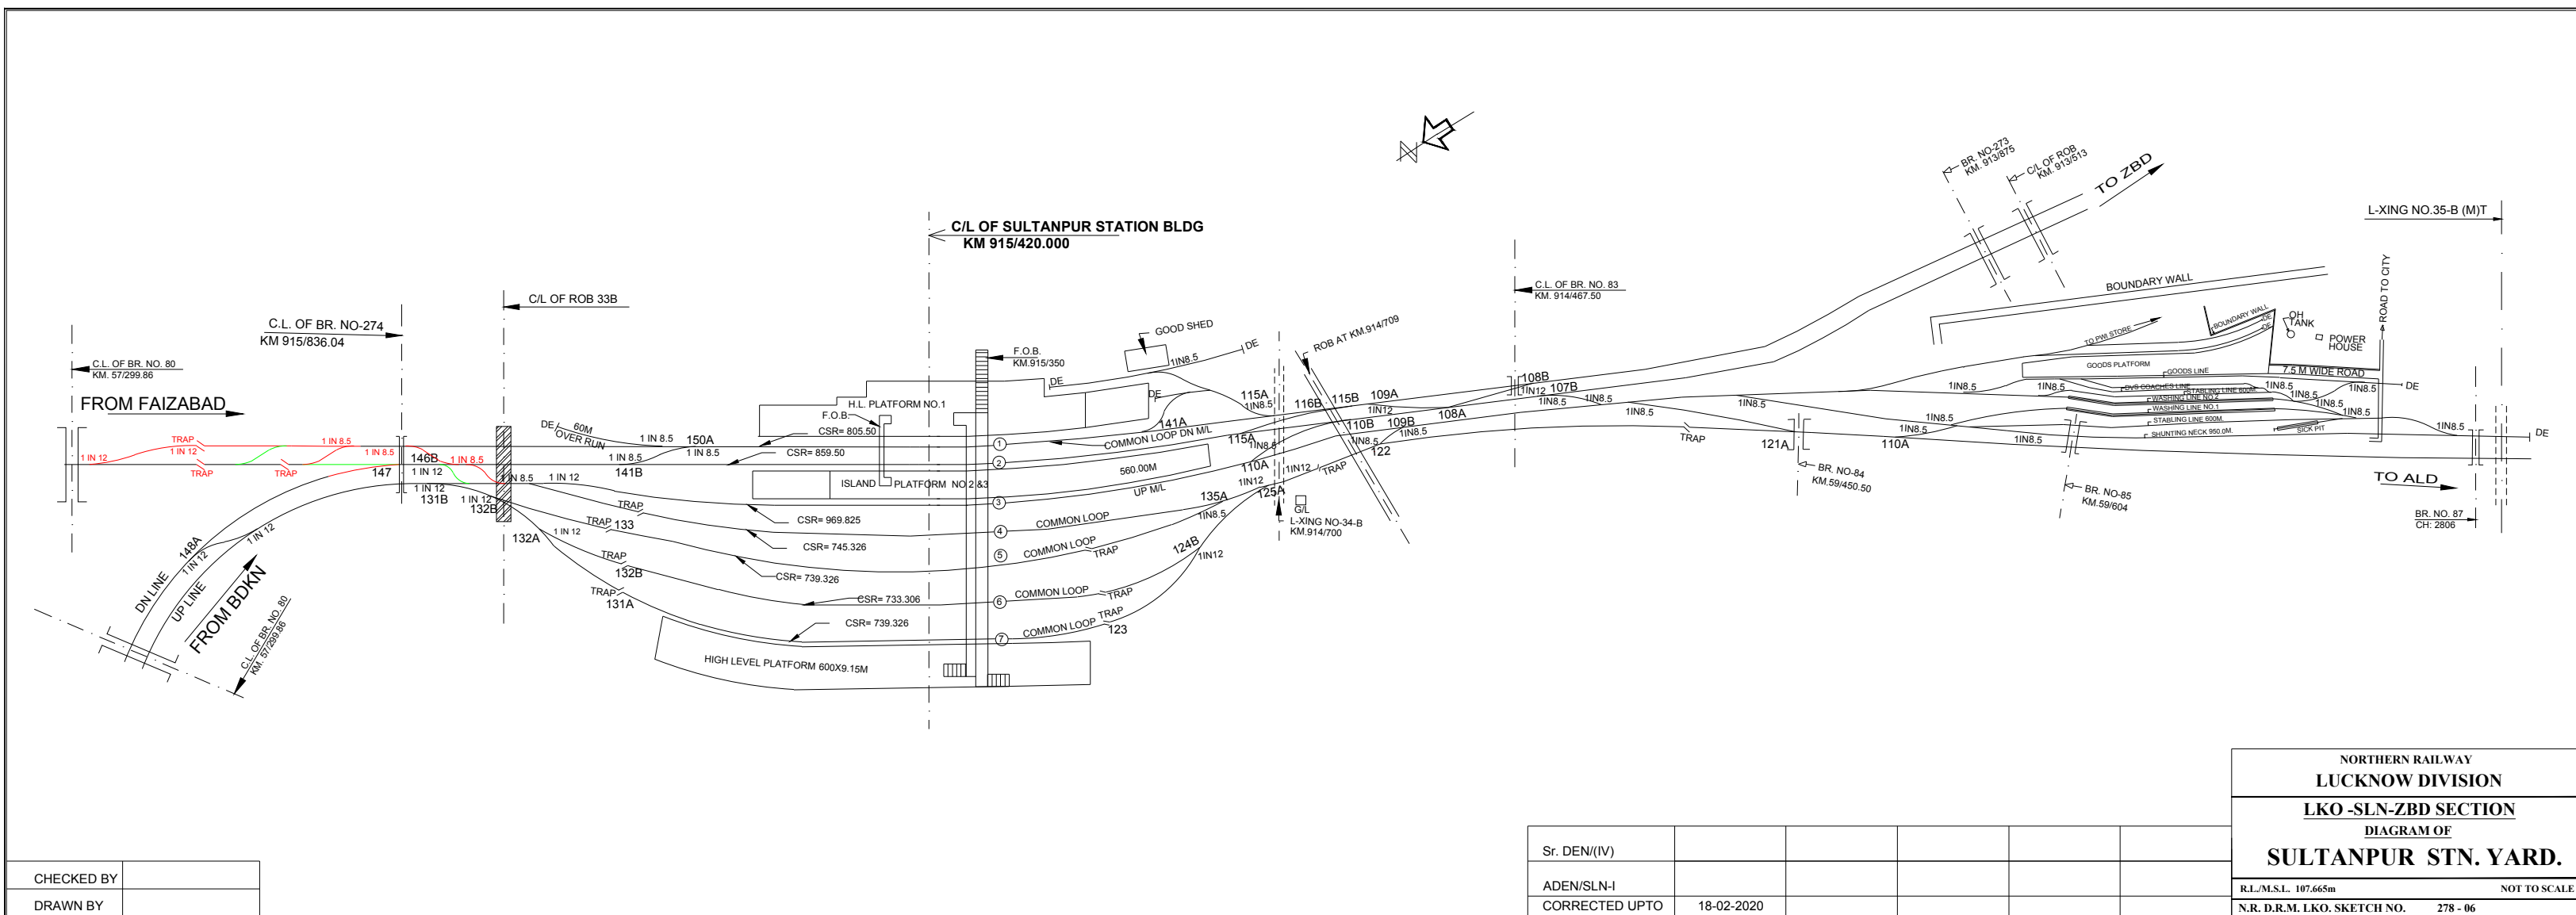

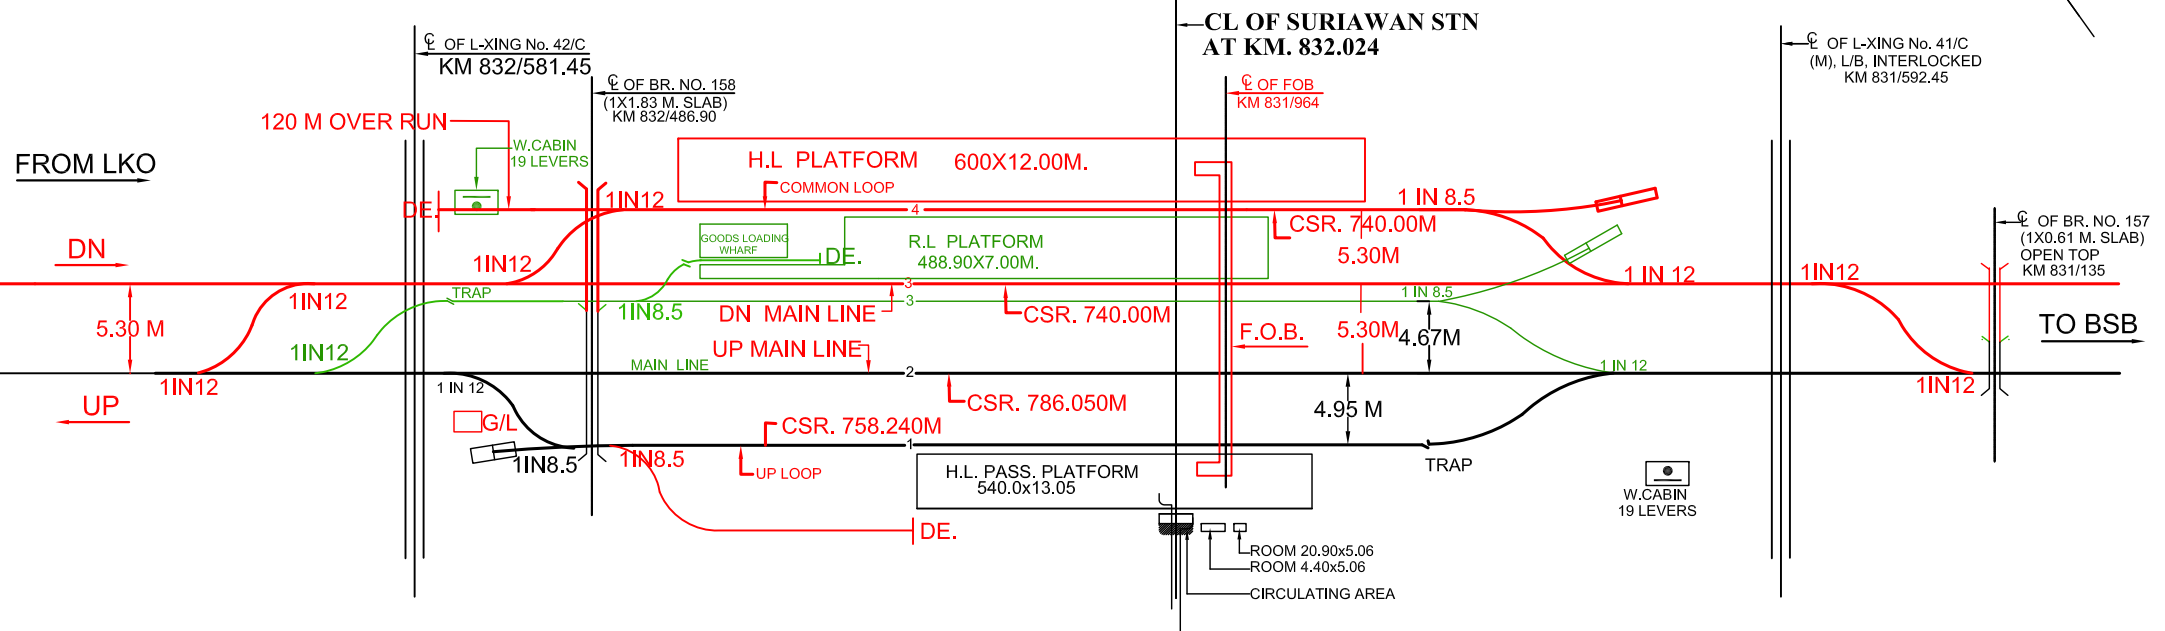


SUWANSA STATION YARD



LEGEND:-

EXISTING WORK	—
PROPOSED WORK	—
DISMANTLED WORK	—
FUTURE WORK	—

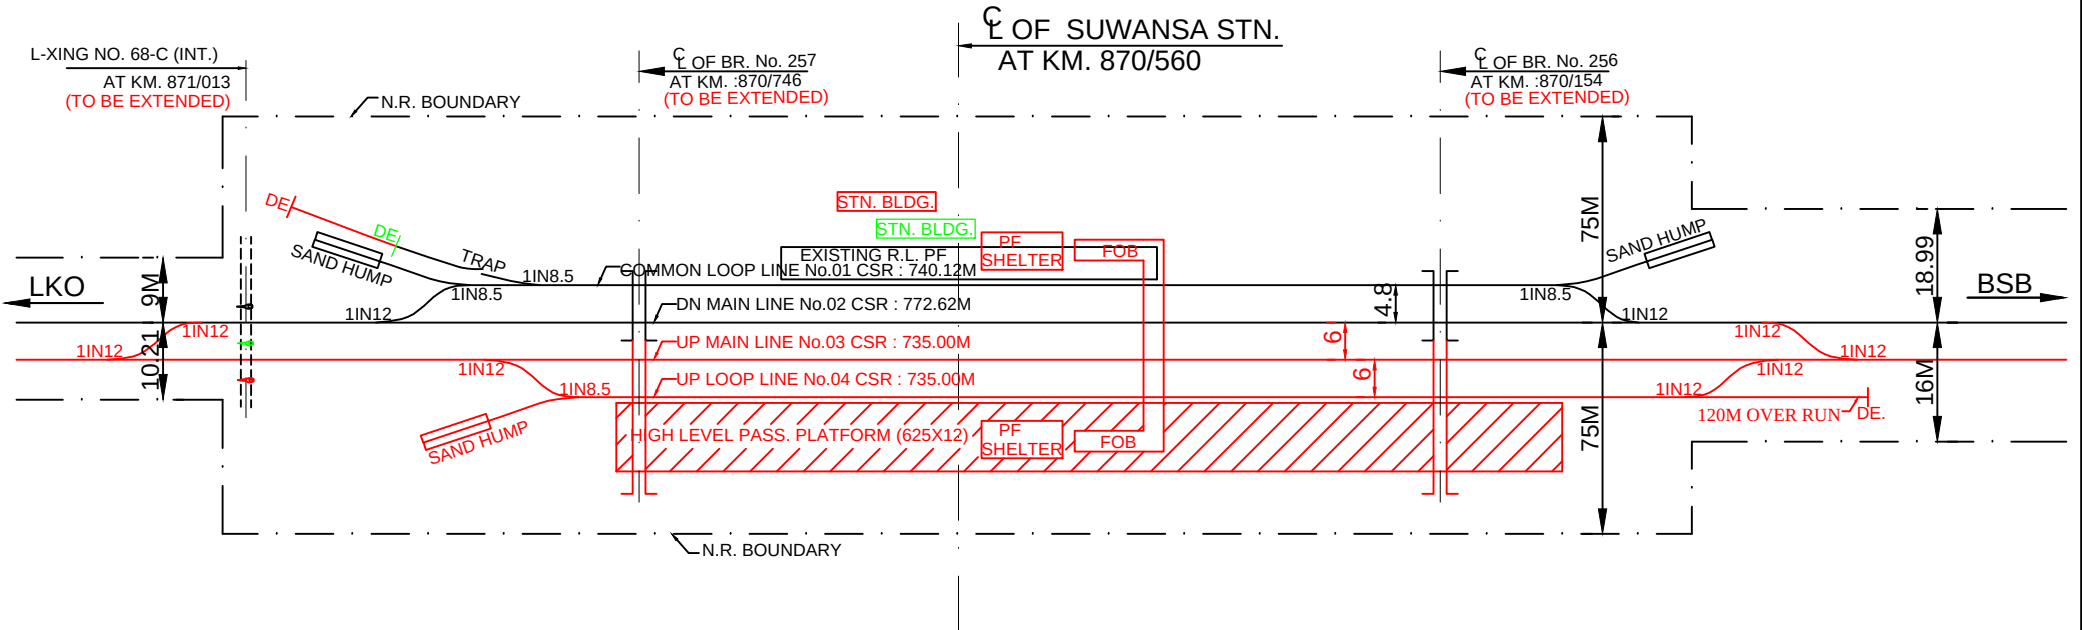

P.way work:

Sr.NO.	Name of Item	To be Dismantled	To be laid
1.	1 in 12 T/out	00	07
2.	1 in 8.5 T/out	00	01
3.	Trap	00	00
4.	Double Dimond	00	00
5.	Dead End	01	02
6.	Sand Hump	00	01
7.	Track (in KM) (Except Main line)	00	1.00

Facility to be provided:

Sr.NO.	Facility
1.	New H.L. End PF no.2 (625mX12.00)
2.	New F.O.B 3m wide (To cover PF 1 to PF 2)
3.	One new line as line no. 4 with CSR 735.0m

Detail of traffic movement:

Sr.NO.	Movement	To Line no.
1.	From Lucknow	1 & 2
2.	From Varanasi	1 to 4

NORTHERN RAILWAY
LUCKNOW DIVISION
SUWANSA STATION YARD
AMETHI-JANGHAI DOUBLING (87 KM)

S. No.	DESCRIPTION	REMARKS			S. No.	DESCRIPTION	AREA (Sq.m.)
1	LAVATORIES	LAV	URINAL		1	AREA OF PLATFORM SHELTER	295
		LADIES	2	1			
		GENTS			2	TOTAL AREA OF PLATFORM PLATFORM NO 1	2114.20
2	NO OF WATER TAPS/HAND PUMPS ON EACH PLATFORM	P/F No	TAPS	H P			
		1		2	3	AREA OF WAITING ROOM I- UPPER CLASS WAITING ROOM II- AREA OF WAITING ROOM a- LADIES b- GENTS III- WAITING HALL	80
3	YEAR OF CONSTRUCTION OF STATION BUILDING						
4	BOOKING OFFICE NO OF WINDOWS	ADV RES		CURRENT RES			
5	NO OF SEATS	P/F No 1			4	CIRCULATING AREA	
6	WHETHER ENQUIRY OFFICE PROVIDED OR NOT	34					

Sr DSTE-E


REF.

FENCING { KUTCHA
PUCCA

ROAD { METALLED
UNMETALLED

Ref: Red ink show dismantling of existing structure.
Green ink shows execution of new proposed work.

E OF TAKIA STN. BLDG.
AT KM. 141.981

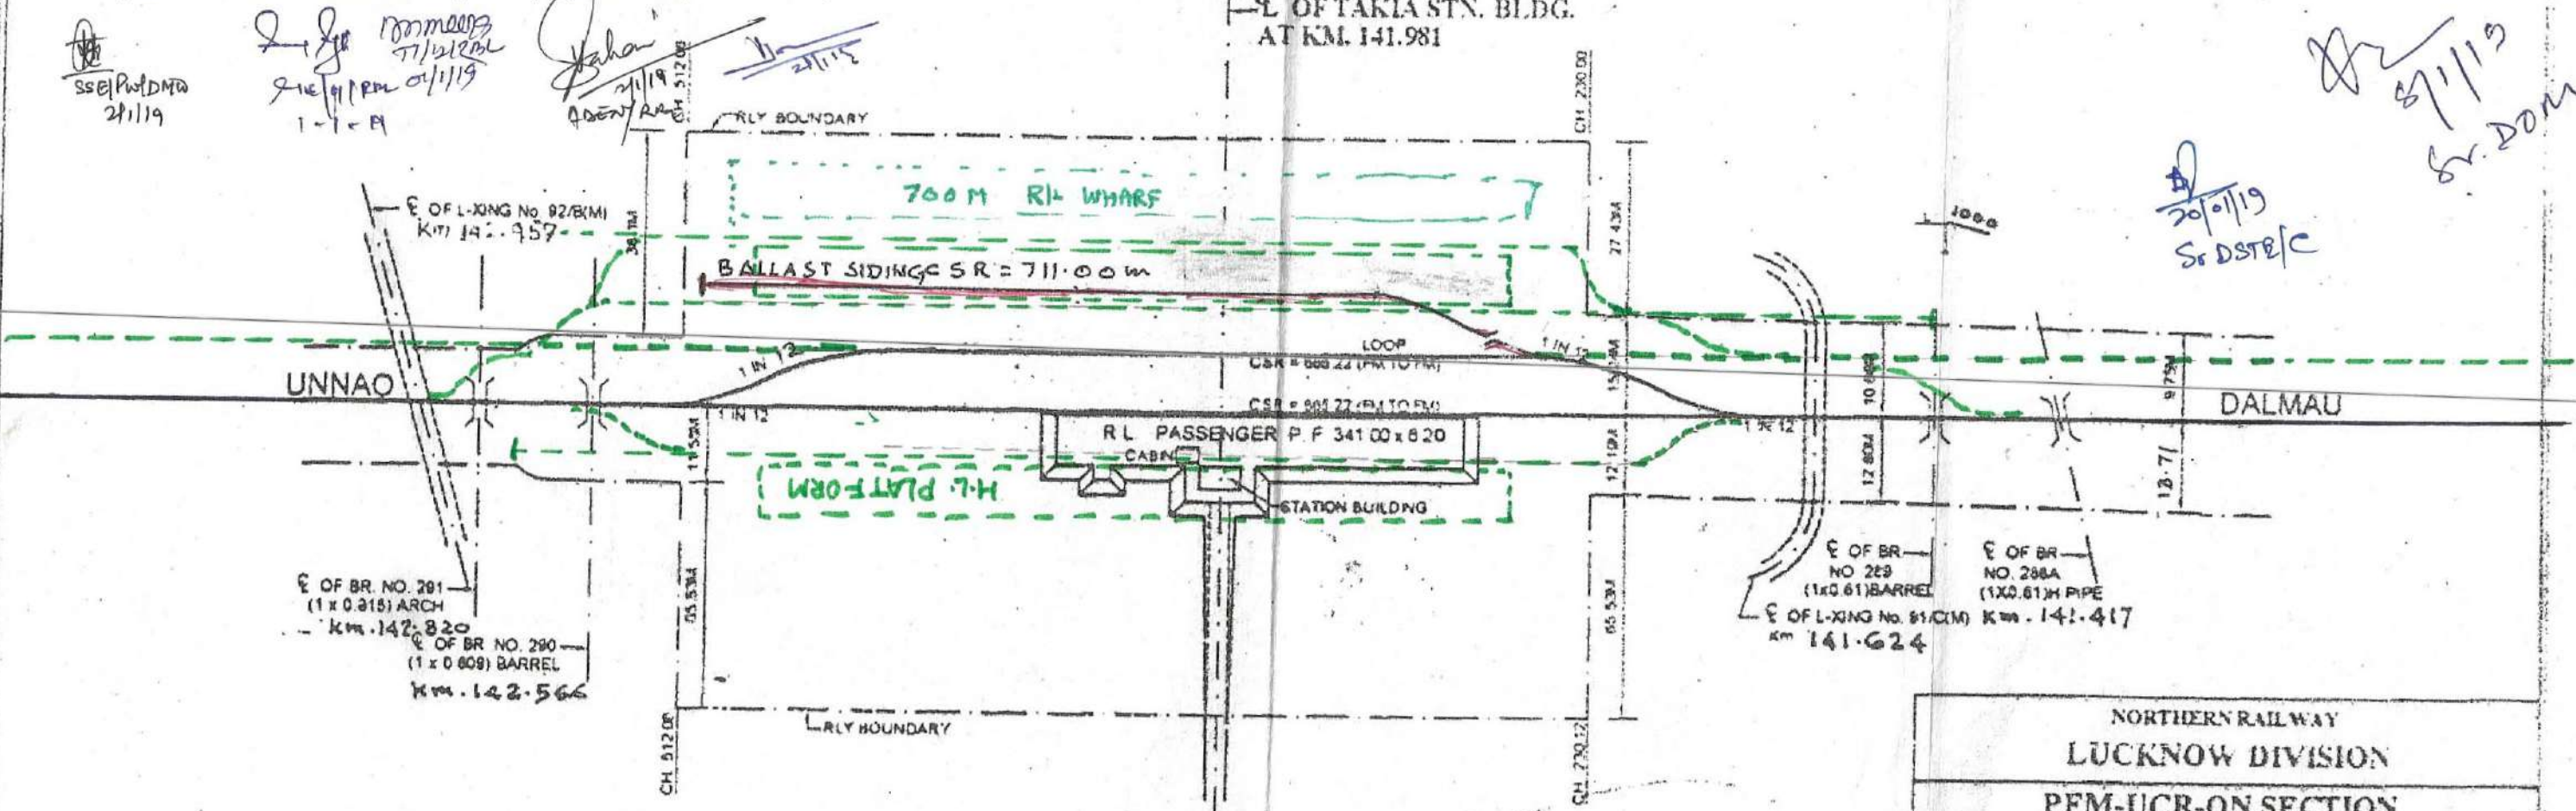

CHECKED BY	S. S. S.
DRAWN BY	BAKSHI
Sr DEN (H)	
ADENRBL	
CORRECTED UPTO	31-03-12


NORTHERN RAILWAY LUCKNOW DIVISION	
PFM-UCR-ON SECTION	
DIAGRAM OF	
TAKIA STN: YARD	
R.L. M.S.L.	NOT TO SCALE
N.R. DIV'L SKETCH NO.	M-1194/LNO/2012

Handwritten signatures and dates at the bottom of the page, including 'S. S. S.', 'BAKSHI', 'ADENRBL', and 'M-1194/LNO/2012'.

LEGEND:-

1. EXISTING WORK SHOWN THUS
2. PROPOSED WORK SHOWN THUS
3. DISMENTLING WORK SHOWN THUS

CL OF TALAKHAJURI STN. BLDG. AT KM. 942.728

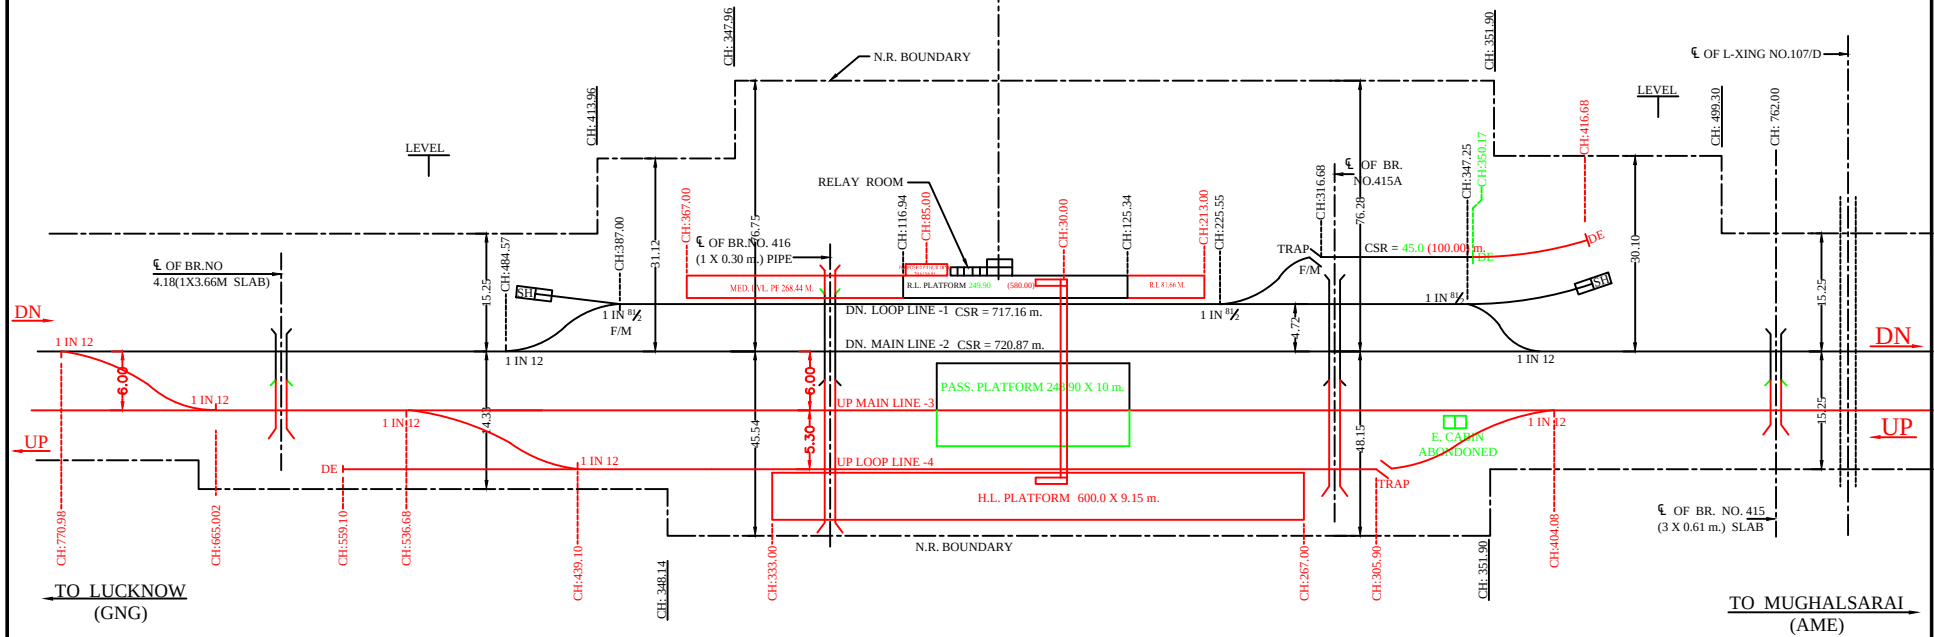



Sr.No.	LINE TYPE	CSR (FM-FM)
1	DN.L.L	717.16m
2	DN.M.L	720.87m
3	UP.M.L	745.0m
4	UP.L.L	745.0m
5	M/C SID.	(45)100.0m

T.O	1 in 12		1 in 8.5			TRAP		DE	SH
	L	R	L	R	SS	L	R		
EXISTING	1	1	1	-	2	-	1	-	2
DISMANTLING	-	-	-	-	-	-	-	1	-
PROPOSED	1	4	-	-	-	-	1	2	-

SCALE:- THIS DRAWING IS NOT TO SCALE



DESCRIPTION	REMARKS				S. No.	DESCRIPTION	AREA (Sq.m.)
LAVATORIES	LAV.	URINAL			1	AREA OF PLATFORM SHELTER	P/F No.1 P/F No.2
	LADIES	1					
	GENTS	1					
NO. OF WATER TAPS/HAND PUMPS ON EACH PLATFORM	P/F No.	TAPS	H.P.		2	TOTAL AREA OF PLATFORM	
	-	-	-			PLATFORM NO.1	1692.00
SOURCE OF WATER SUPPLY						PLATFORM NO.2	
YEAR OF CONSTRUCTION OF STATION BUILDING					3	AREA OF WAITING ROOM	
BOOKING OFFICE	ADV. RES.		CURRENT RES.			I- UPPER CLASS WAITING ROOM	
NO. OF WINDOWS	1					II- AREA OF WAITING ROOM	
NO. OF SEATS	P/F No.1		P/F No.2			a- LADIES	
WHETHER ENQUIRY OFFICE PROVIDED OR NOT						b- GENTS	
						III- WAITING HALL	84.00
					4	CIRCULATING AREA	132.00

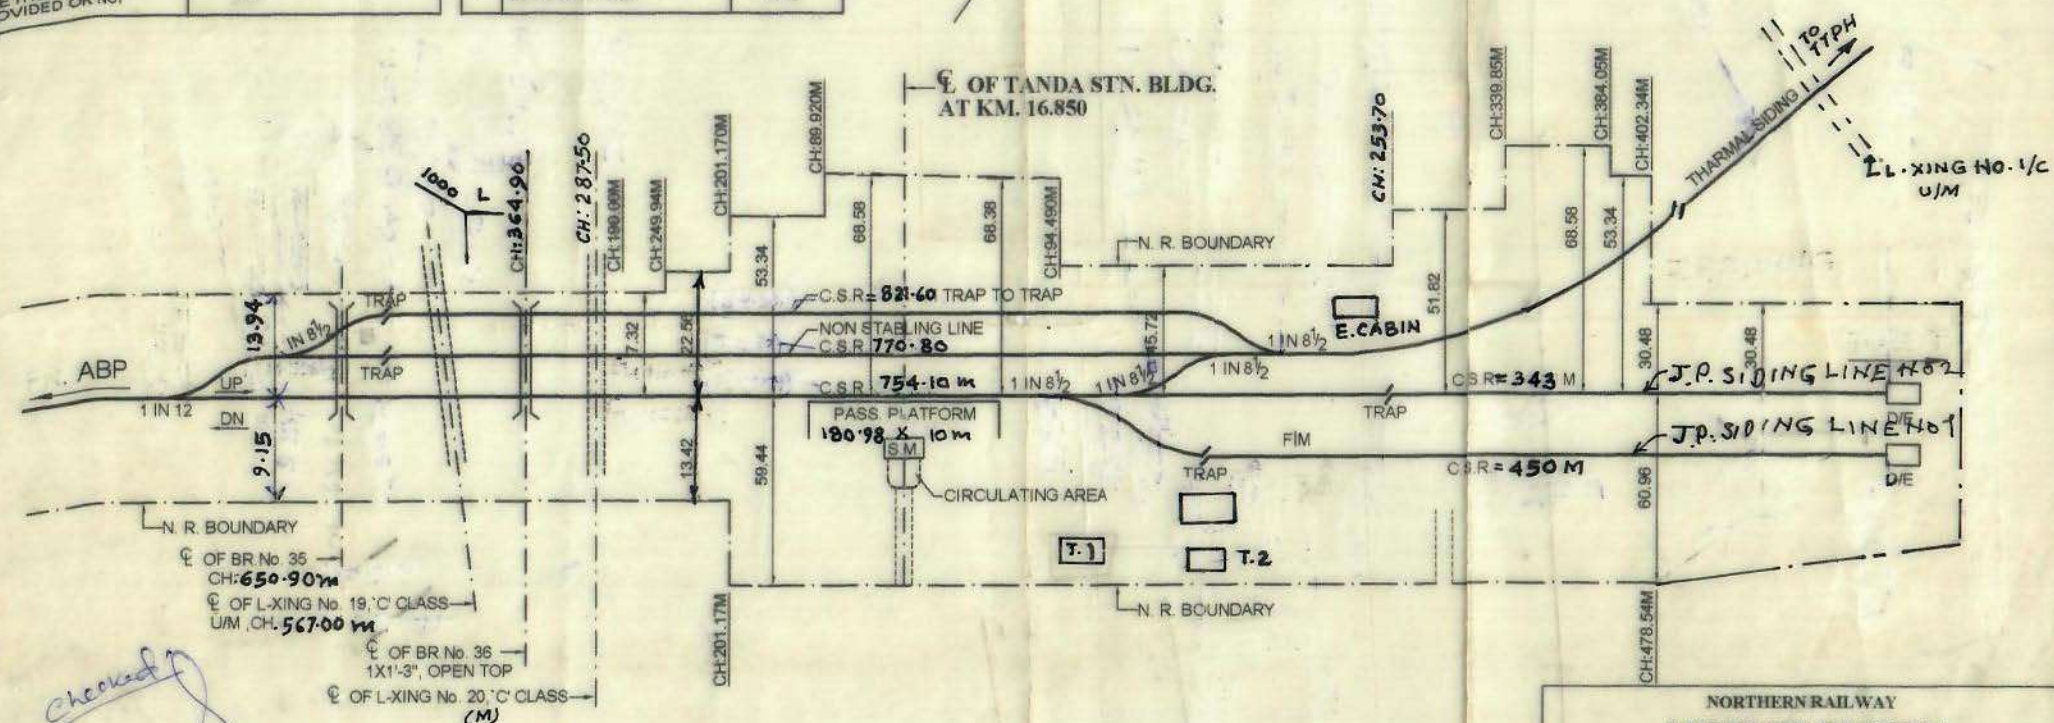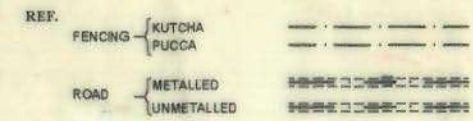

checked by
ADEN/JNU
14/4/13

SSB/MSAS
14/4/2013


171A

Sr. D.E.N. (III)							
ADEN/JNU							
CORRECTED UPTO	31-03-14	31-3-15	31-3-2016	31-03-2018			

NORTHERN RAILWAY
LUCKNOW DIVISION
ABP-TD SECTION
DIAGRAM OF
TANDA STN: YARD

R.L./M.S.L. NOT TO SCALE

N.R. DIVL. SKETCH NO: M-132/LKO/2012

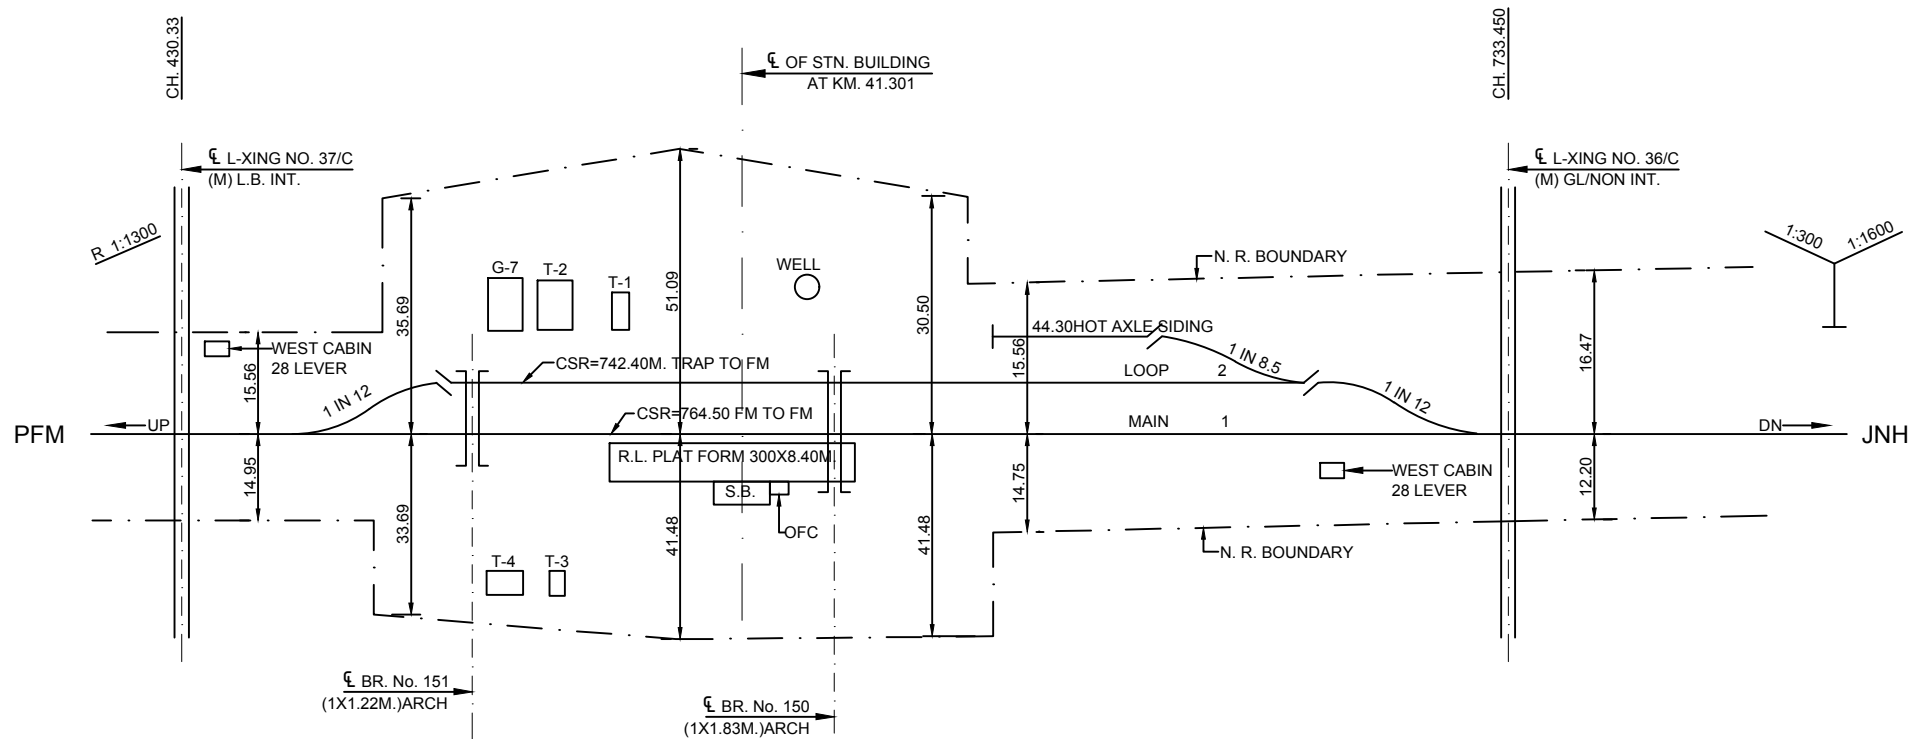

NORTHERN RAILWAY
LUCKNOW DIVISION

JNH-PFM SECTION
DIAGRAM OF
THARWAI STN. YARD

CHECKED BY

DRAWN BY

Sr. DEN/(IV)

ADEN/PRG

CORRECTED UPTO

18-02-2020

R.L./M.S.L.

NOT TO SCALE

N.R. D.R.M. LKO. SKETCH NO.

300-06

S. No.	DESCRIPTION	REMARKS		
1	LAVATORIES		LAV.	URINAL
		LADIES	-	
		GENTS	-	
2	NO OF WATER TAPS/ HAND PUMPS ON EACH PLATFORM	P/F No.	TAPS	H.P.
		1	-	1
	SOURCE OF WATER SUPPLY			
3	YEAR OF CONSTRUCTION OF STATION BUILDING	-		
4	BOOKING OFFICE NO. OF WINDOWS	ADV. RES. -1-	CURRENT RES.	
5	NO. OF SEATS	P/F No.1		
		15		
6	WHETHER ENQUIRY OFFICE PROVIDED OR NOT	NOT		

S. No.	DESCRIPTION	AREA (Sq.m.)
1.	AREA OF PLATFORM SHELTER	90.40
2.	TOTAL AREA OF PLATFORM	
	PLATFORM NO. 1	926.10
	PLATFORM NO. 2	-
3.	AREA OF WAITING ROOM	
	I- UPPER CLASS WAITING ROOM	-
	II - AREA OF WAITING ROOM	-
	a- LADIES	-
	b- GENTS	-
	III- WAITING HALL	21.0
4.	CIRCULATING AREA	1200

Sr.DSTE-I


REF.	FENCING	KUTCHA PUCCA	----
	ROAD	METALLED UNMETALLED	=====

NOTE: 1. LAND ACQUISITION WILL REQUIRE FOR THIS STATION
2. RED INK SHOWING NEW CONSTRUCTION
3. GREEN INK SHOWING DISMANTLE OF OLD STRUCTURE
4. AT THIS STATION, EXISTING MAIN LINE IS PROPOSED AS DN
MAIN LINE BY PROVIDING CUT AT KM 155/7-9 CURVE NO. 9

Sr.DSTE-I

Sr.DSTE-I

CL OF TIKULI-RAWAT PUR STN. BLDG.
AT KM. 161.431

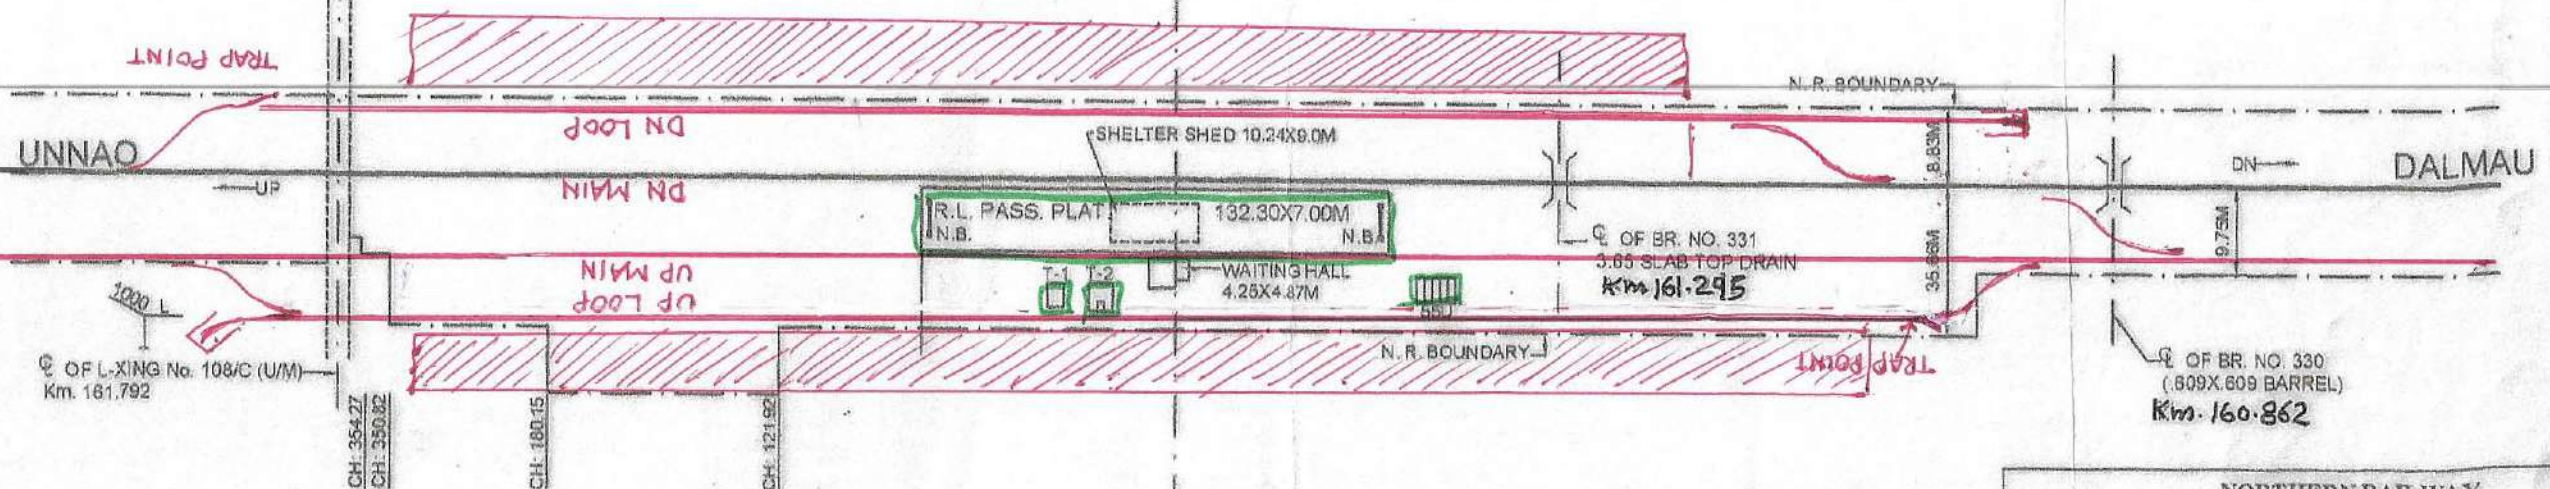

CHECKED BY *S.S.*
DRAWN BY *DAKSH*
205, 2nd FLOOR, LAKHNAO KANZARA,
FAIZABAD ROAD, LKO-20, UTTAR PRADESH

Sr. D.E.N.(II)						
ADEN/RBL	<i>Mushtaq</i>	<i>Mushtaq</i>	<i>Mushtaq</i>	<i>Mushtaq</i>	<i>Mushtaq</i>	<i>Mushtaq</i>
CORRECTED UPTO	31-03-12	31-03-13	31-03-2014	31-03-2015	31-03-2016	31-03-2018

NORTHERN RAILWAY LUCKNOW DIVISION	
PFM-UCR-ON SECTION	
DIAGRAM OF TIKULI-RAWAT PUR STN: YARD	
R.L./M.S.L.	NOT TO SCALE
N.R. DIV L. SKETCH NO.	M-125/L.KO/2012


174

Sr.DSTE-I
march 16

S. No.	DESCRIPTION	REMARKS			
1	LAVATORIES	LAV.	URINAL		
		LADIES			
		GENTS			
2	NO. OF WATER TAPS/ HAND PUMPS ON EACH PLATFORM	P/F No.	TAPS	H.P.	
		1		0	
	SOURCE OF WATER SUPPLY				
3	YEAR OF CONSTRUCTION OF STATION BUILDING				
4	BOOKING OFFICE NO. OF WINDOWS	ADV. RES.	CURRENT		
		0	0		
5	NO. OF SEATS	P.F. 1	W/ HALL	TOTAL	
6	WHETHER ENQUIRY OFFICE PROVIDED OR NOT	NOT			

S. No.	DESCRIPTION	AREA (Sq.m.)
1	AREA OF PLATFORM SHELTER	P/F No.1
2	TOTAL AREA OF PLATFORM PLATFORM NO. 1	
3	AREA OF WAITING ROOM I- UPPER CLASS WAITING ROOM II - AREA OF WAITING ROOM a- LADIES b- GENTS III- WAITING HALL	
4	CIRCULATING AREA	


C/L OF TRANSPORT NAGAR STN BLDG.
AT KM. 8.60

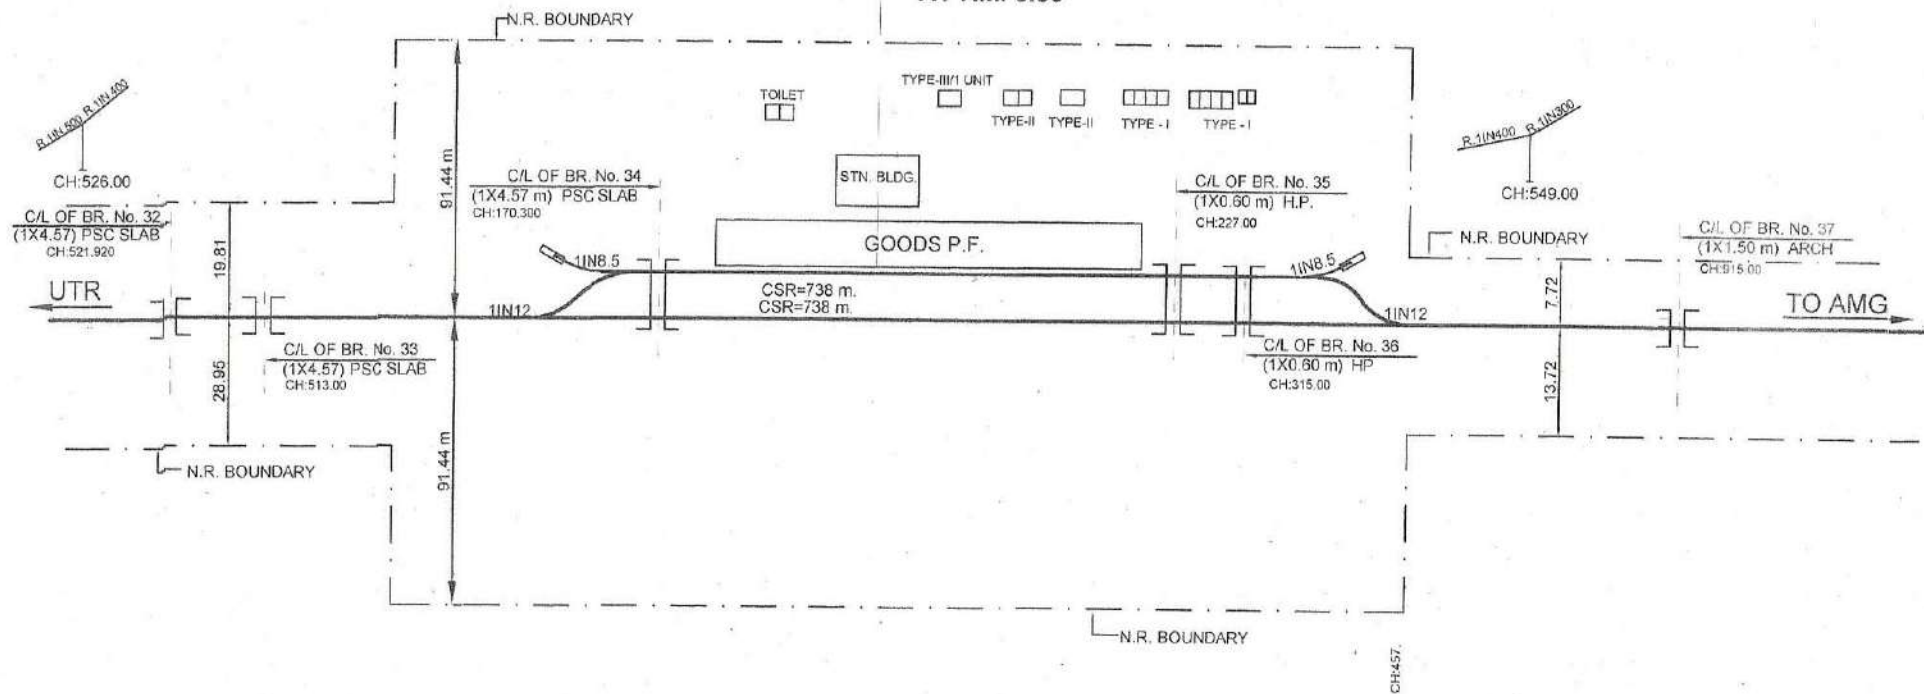

CHECKED BY	
DRAWN BY	

D.E.N.(I)					
ADEN-I/LKO					
CORRECTED UPTO	31-03-2018				

NORTHERN RAILWAY LUCKNOW DIVISION	
UTR -AMG BYE PASS SECTION	
DIAGRAM OF	
TRANSPORT NAGAR STN. YARD	
R.L./M.S.L.	NOT TO SCALE
N.R. DIVL. LKO. SKETCH NO. M-340/LKO/2018	

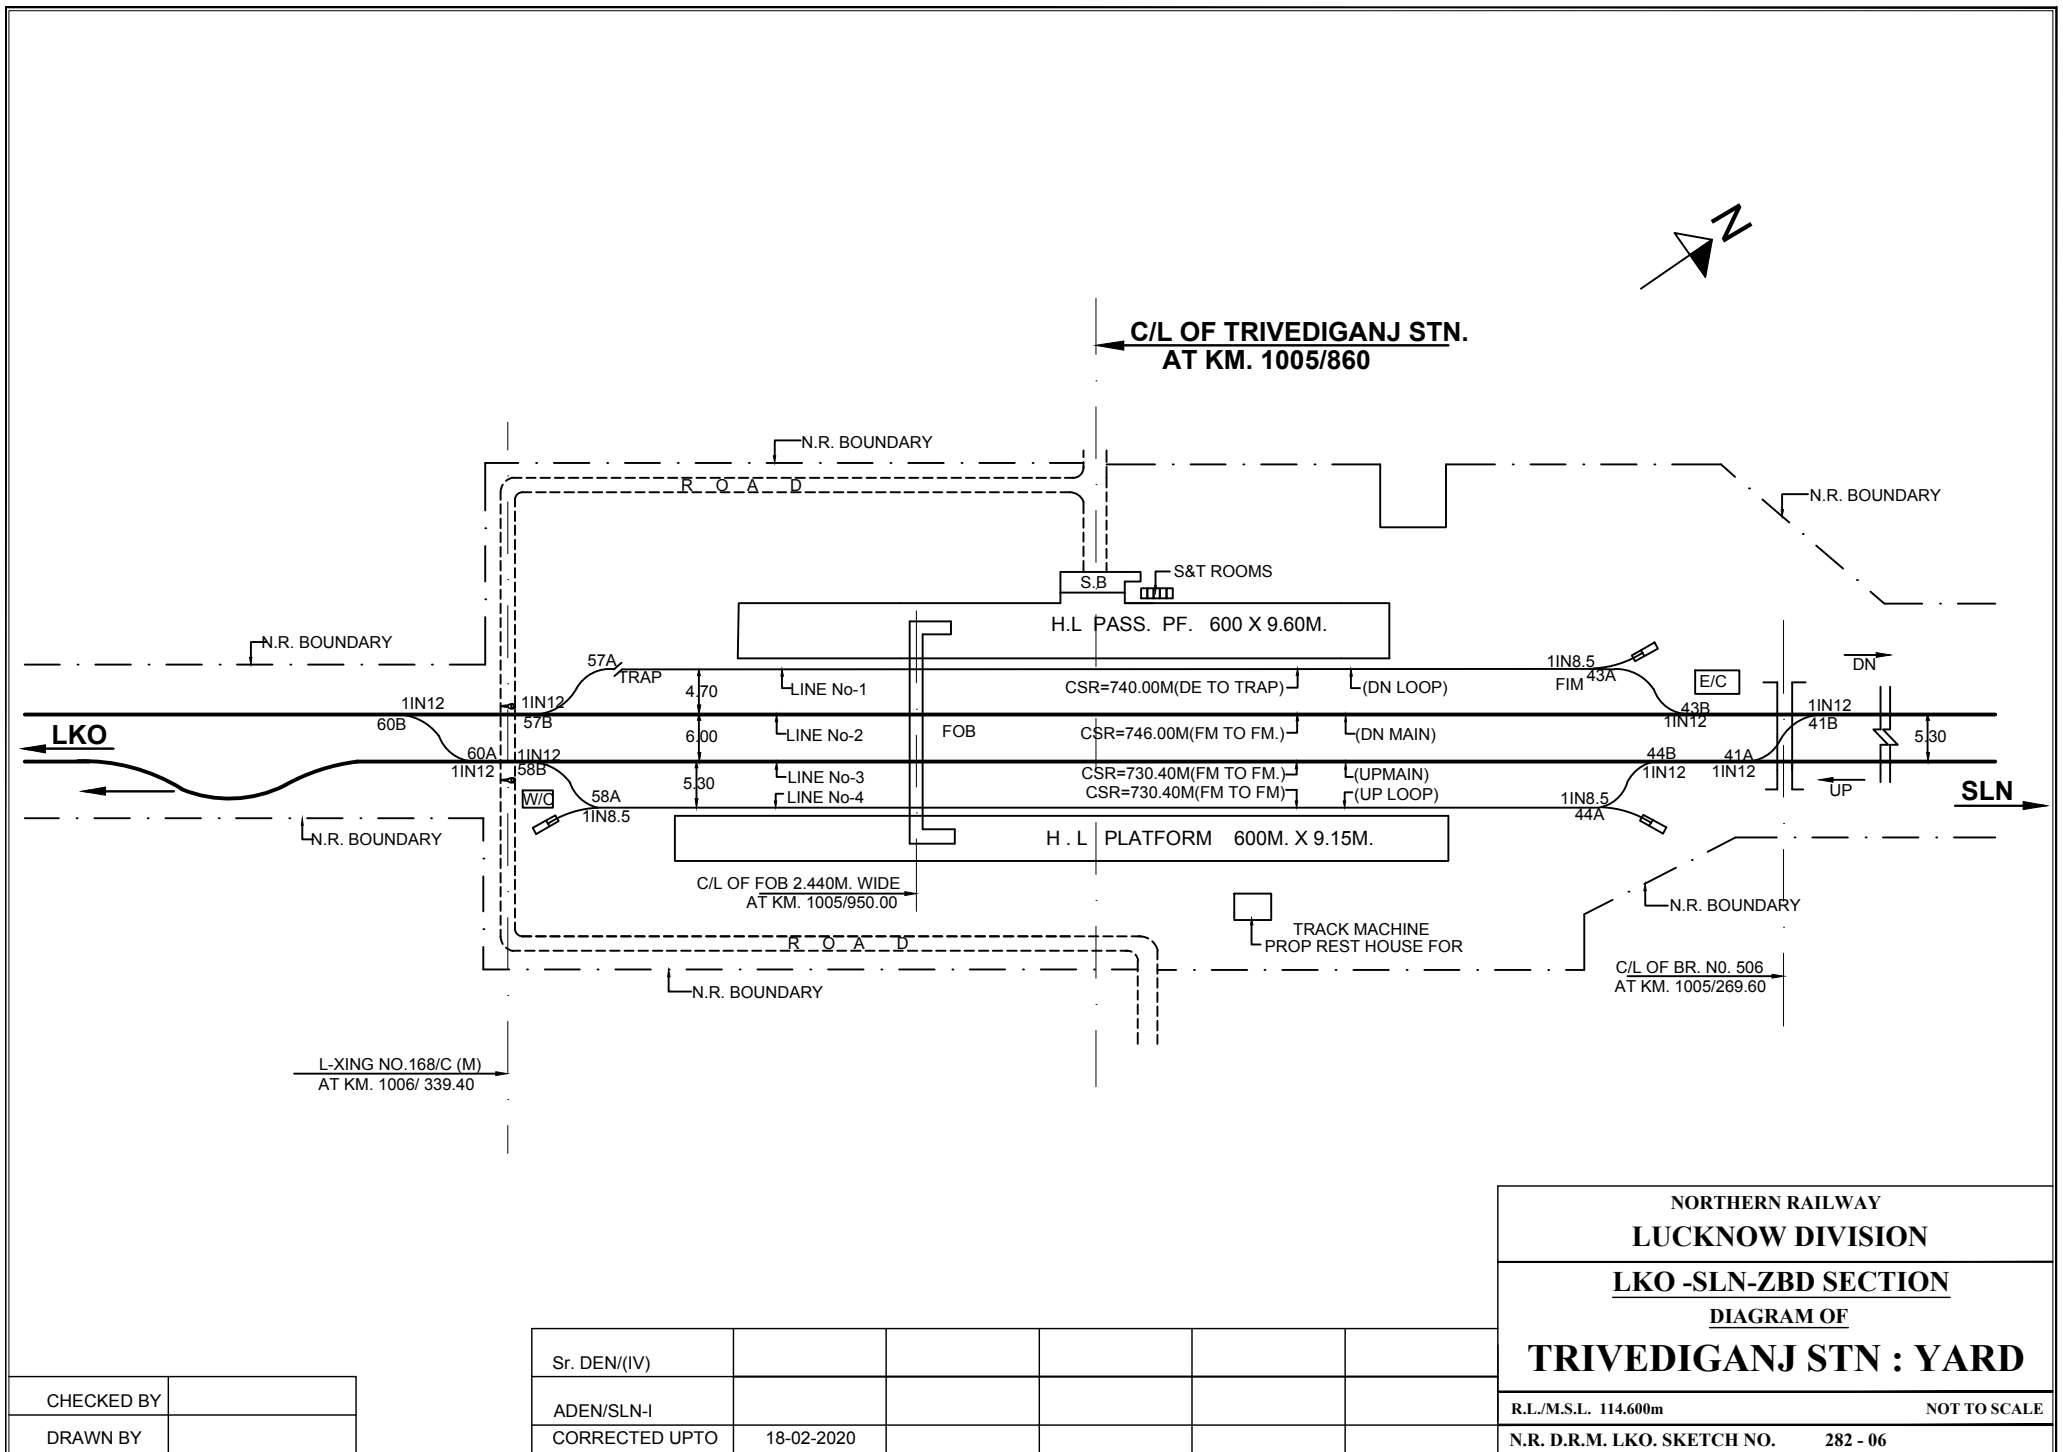


NORTHERN RAILWAY LUCKNOW DIVISION	
LKO -SLN-ZBD SECTION	
DIAGRAM OF	
TRIVEDIGANJ STN : YARD	
R.L./M.S.L. 114.600m	NOT TO SCALE
N.R. D.R.M. LKO. SKETCH NO.	282 - 06

CHECKED BY	
DRAWN BY	

Sr. DEN/(IV)					
ADEN/SLN-I					
CORRECTED UPTO	18-02-2020				

REF.		
FENCING	KUTCHA PUCCA	_____ _____
ROAD	METALLED UNMETALLED	===== =====

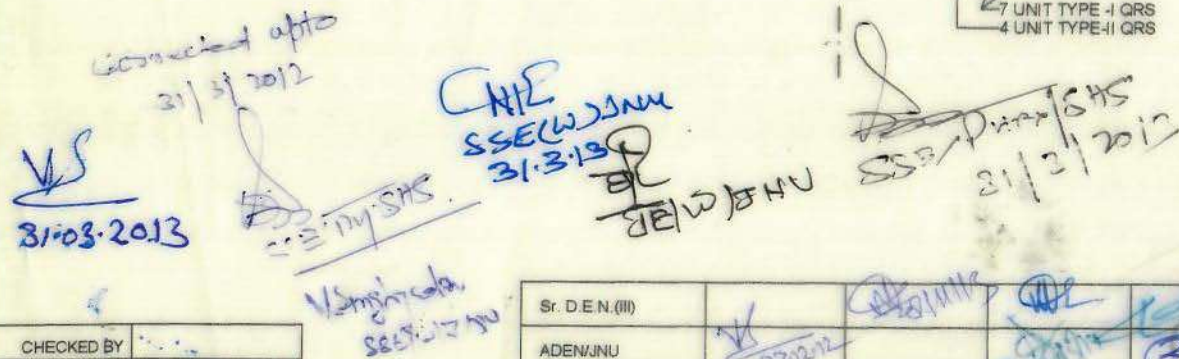


Sr. D.E.N.(III)						
ADEN/JNU						
CORRECTED UPTO	31-03-12	31-3-13	31.3.14	31-3-15	31-3-2016	31-03-2018

NORTHERN RAILWAY		
LUCKNOW DIVISION		
<u>LKO-FD-BSB SECTION</u>		
<u>DIAGRAM OF</u>		
TULSINAGAR STN: YARD		
R.L./M.S.L.	85.02M	NOT TO SCALE
N.R. DIVL. SKETCH NO: M 203 LKO-2012		

S. No.	DESCRIPTION	REMARKS		
		LAV	URINAL	
1	LAVATORIES	LADIES		
		GENTS		
2	NO OF WATER TAPS/ HAND PUMPS ON EACH PLATFORM	P/F No.	TAPS	H.P.
	SOURCE OF WATER SUPPLY			
3	YEAR OF CONSTRUCTION OF STATION BUILDING			
4	BOOKING OFFICE NO. OF WINDOWS	ADV. RES. 1	CURRENT RES.	
5	NO. OF SEATS	P/F No.1	P/F No.2	
6	WHETHER ENQUIRY OFFICE PROVIDED OR NOT	NOT		

S. No.	DESCRIPTION	AREA (Sq.m.)
1	AREA OF PLATFORM SHELTER	NIL
2	TOTAL AREA OF PLATFORM PLATFORM NO. 1	2420
3	AREA OF WAITING ROOM I- UPPER CLASS WAITING ROOM II- AREA OF WAITING ROOM a- LADIES b- GENTS III- WAITING HALL	- NIL 60.0
4	CIRCULATING AREA	150.0

REF.	FENCING	KUTCHA PUCCA	----
	ROAD	METALLED UNMETALLED	=====

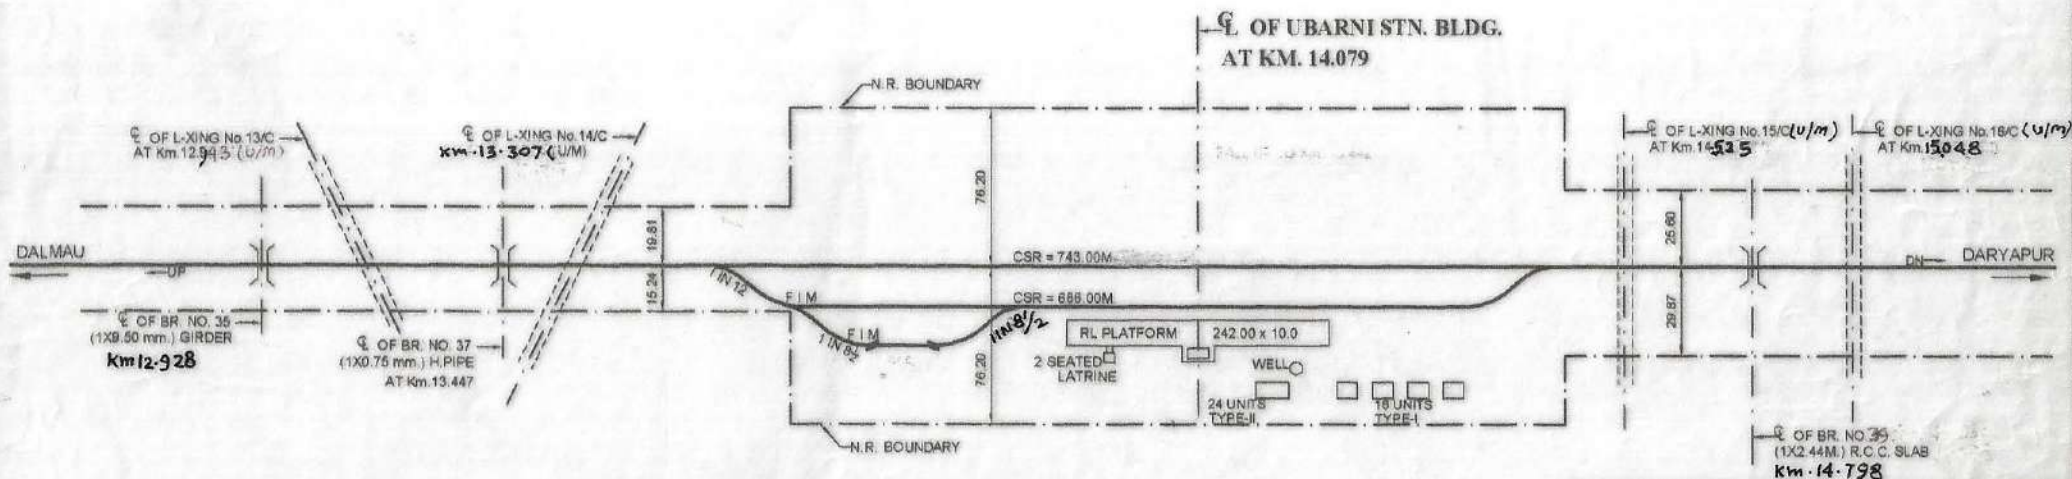

CHECKED BY	<i>[Signature]</i>
DRAWN BY	<i>[Signature]</i>

Sr. D.E.N.(II)	<i>[Signature]</i>	<i>[Signature]</i>	<i>[Signature]</i>	<i>[Signature]</i>	<i>[Signature]</i>	<i>[Signature]</i>
ADEN/RBL	<i>[Signature]</i>	<i>[Signature]</i>	<i>[Signature]</i>	<i>[Signature]</i>	<i>[Signature]</i>	<i>[Signature]</i>
CORRECTED UPTO	31-03-12	31-3-13	31-03-2014	31-3-15	31-3-2016	31-03-2018

NORTHERN RAILWAY LUCKNOW DIVISION DMW-DYP SECTION DIAGRAM OF UBARNI STN: YARD	
R.L./M.S.L.	NOT TO SCALE
N.R. DIV L. SKETCH NO.	M-134/LKO/2012

[Handwritten signature]


[Handwritten signature]

[Handwritten signature]

[Handwritten signature]

[Handwritten signature]

178


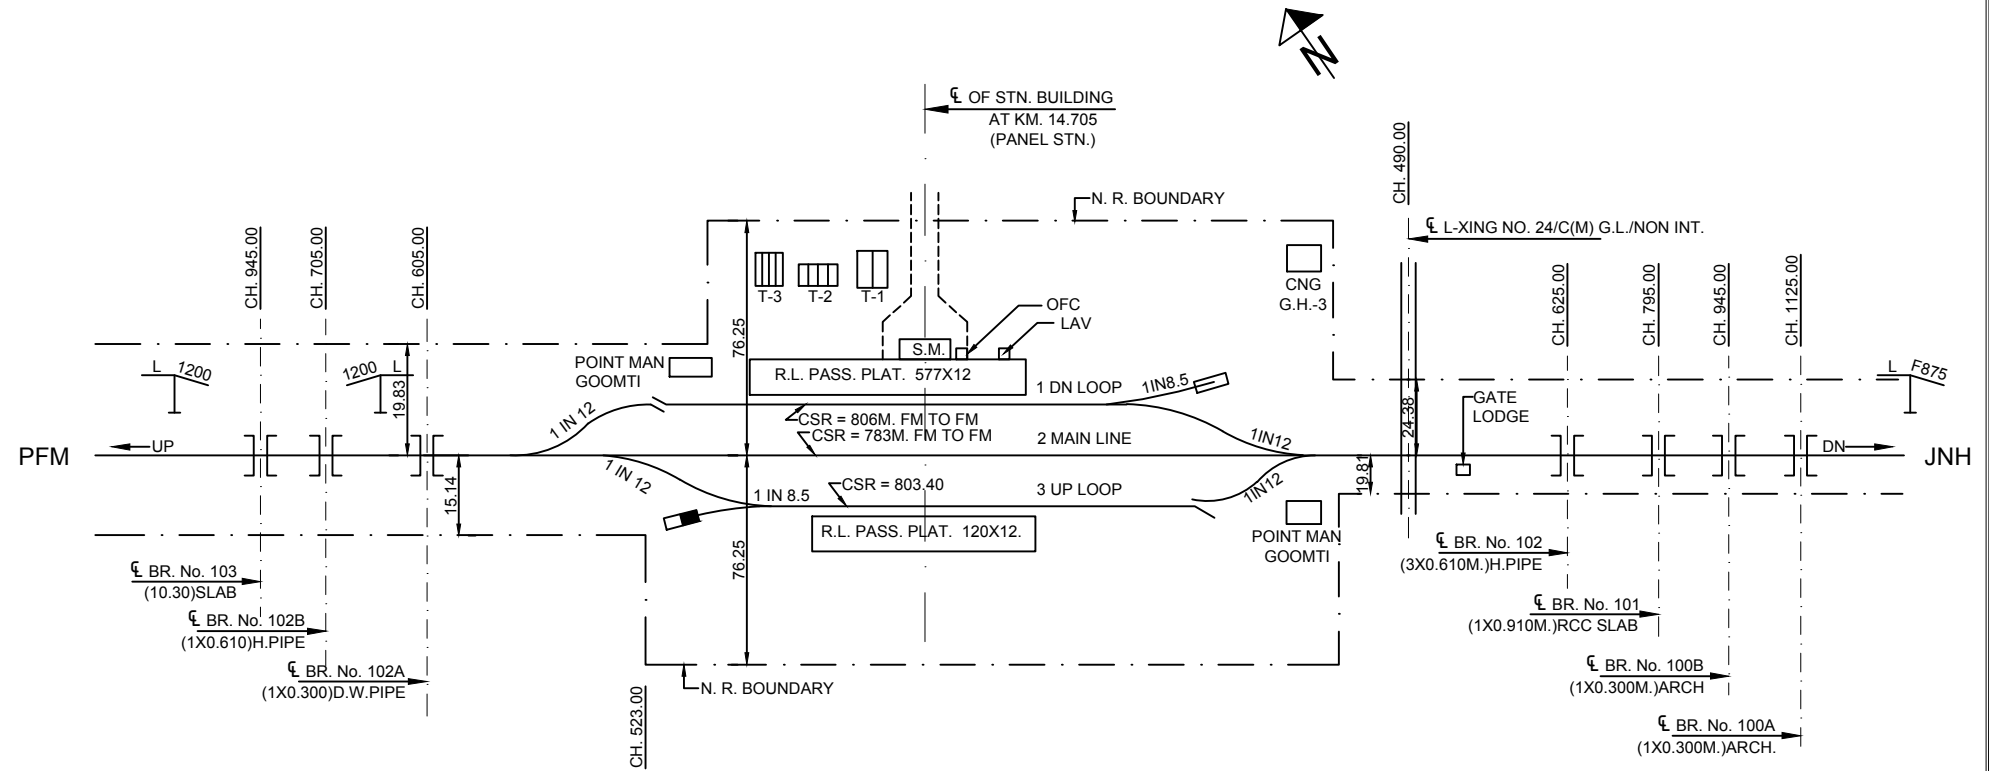




NORTHERN RAILWAY	
LUCKNOW DIVISION	
JNH-PFM SECTION	
DIAGRAM OF	
UGRASENPUR STN. YARD	
R.L./M.S.L.	NOT TO SCALE
N.R. D.R.M. LKO. SKETCH NO.	297-06

CHECKED BY	
DRAWN BY	

Sr. DEN/(IV)					
ADEN/PRG					
CORRECTED UPTO	18-02-2020				

ULNABHARI STATION YARD

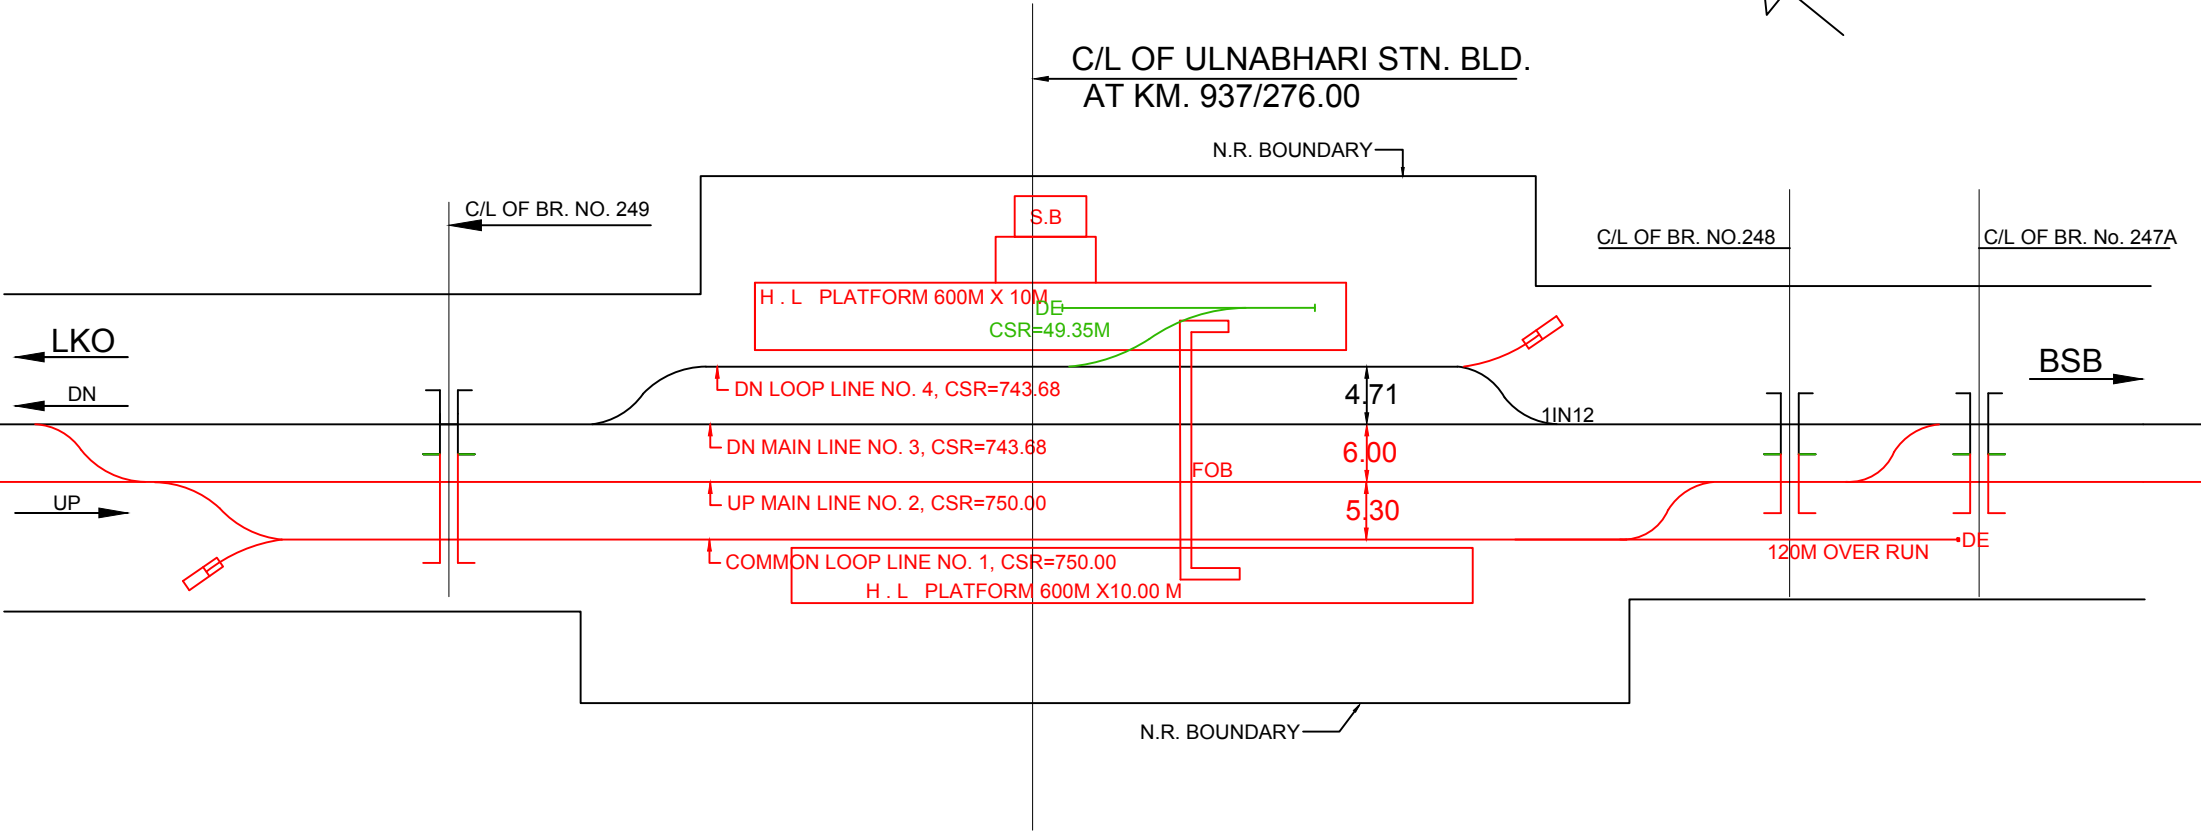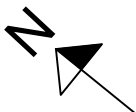

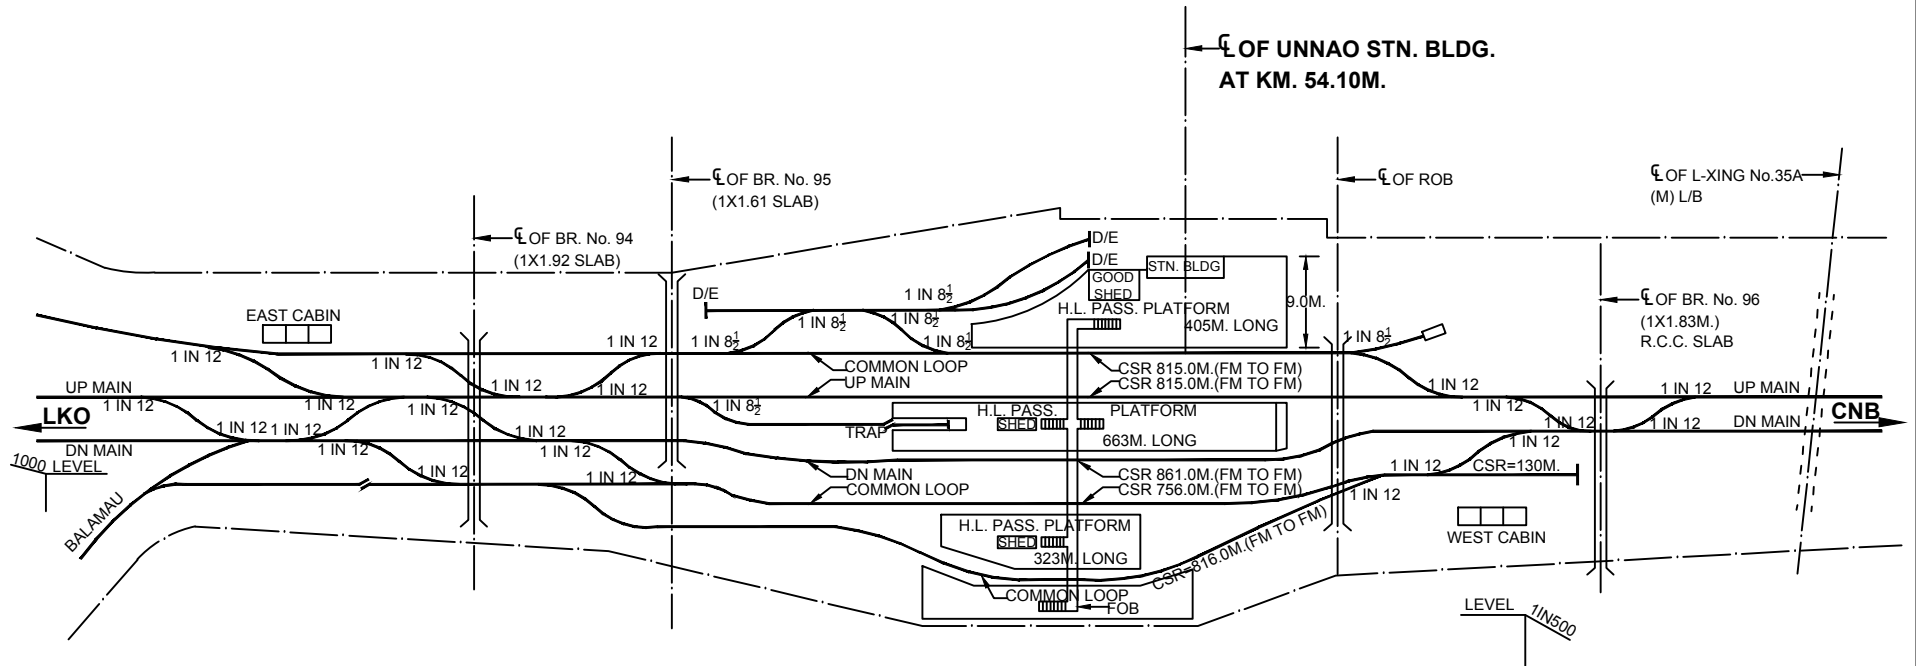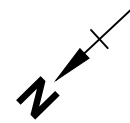


CHECKED BY	
DRAWN BY	

Sr. DEN/(V)						
ADEN/III/LKO						
CORRECTED UPTO	16-10-2020					

NORTHERN RAILWAY LUCKNOW DIVISION	
LKO-ON-CNB SECTION	
DIAGRAM OF	
UNNAO STN: YARD	
R.L./M.S.L.	NOT TO SCALE
N.R. D.R.M. LKO. SKETCH NO.	



℄ OF UTRAITIA STN. BLDG. Km: 1060.950

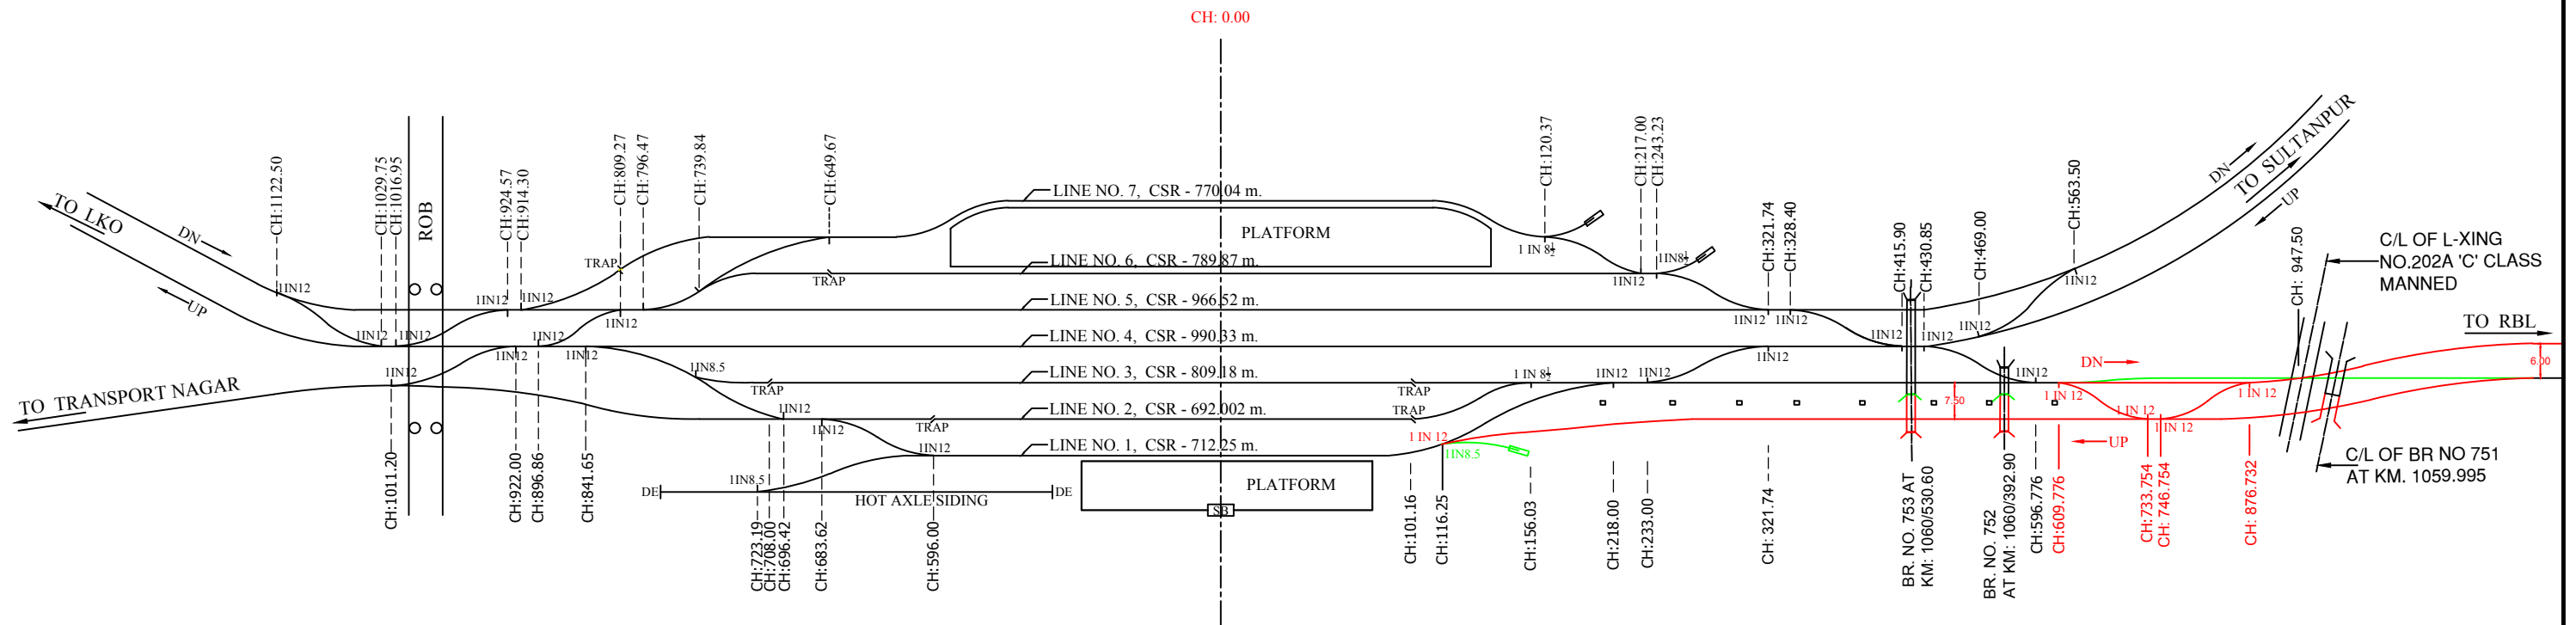


LEGEND:-

1. EXISTING WORK SHOWN THUS —
2. PROPOSED WORK SHOWN THUS —
3. DISMENTLING WORK SHOWN THUS —
4. THIS DRAWING IS NOT TO SCALE



UTRAITIA STATION YARD (PHASE-I)

DESCRIPTION	PLATFORM NO.										YATRA
	1	1A	2	3	4	5	6	7	8	9	
TYPE VIZ H.L. LOW LEVEL R.L.	H.L.	H.L.	H.L.	H.L.	H.L.	H.L.	H.L.	H.L.	H.L.	H.L.	LL
HEIGHT FROM RAIL LEVEL	0.84	0.84	0.84	0.84	0.84	0.84	0.84	0.84	0.84	0.84	0.80
LENGTH (IN METRES)	455.60	288	650	650	430.00	536.0	372	402	657.31	557.31	242
BREADTH (IN METRES)	9.50	16.60	3.05	3.05	15.50	8.82	5.35	5.35	5.15	5.15	8.50
AREA (IN SQ. METRES)	4328	1613	1764	1764	3357	4728	1990	2150	2738	2738	1513
COVERED SHED ON PLATFORM											
LENGTH IN METRES	245	80	240	1.80	290	290	240	240	265	265	59.20
BREADTH IN METRES	9.50	5.50	3.05	3.05	10.00	8.82	5.35	5.35	7.55	7.55	6.50
AREA IN SQ. METRES	2320	504	732	549	2900	2558	1284	1284	2006	2006	385
NO. OF LAVATORIES (AQUAPRIV)											
DO FLUSH OUT TYPES	-	-	-	-	-	-	-	-	-	-	-
DO URINAL	3	-	-	-	-	-	-	-	-	-	-
DO SEATS/BENCHES	25	20	24	20	18	18	18	18	18	18	18
DO TRAPS	25	20	24	20	18	18	18	18	18	18	18
DO WATER COOLER	2	-	-	-	-	-	-	-	-	-	-
DO HAND PUMPS	-	-	-	-	-	-	-	-	-	-	-
DO SHADY TREES	-	-	-	-	-	-	-	-	-	-	-
DO LAMPS	-	-	-	-	-	-	-	-	-	-	-
DO WATER TROLLEYS	-	-	-	-	-	-	-	-	-	-	-

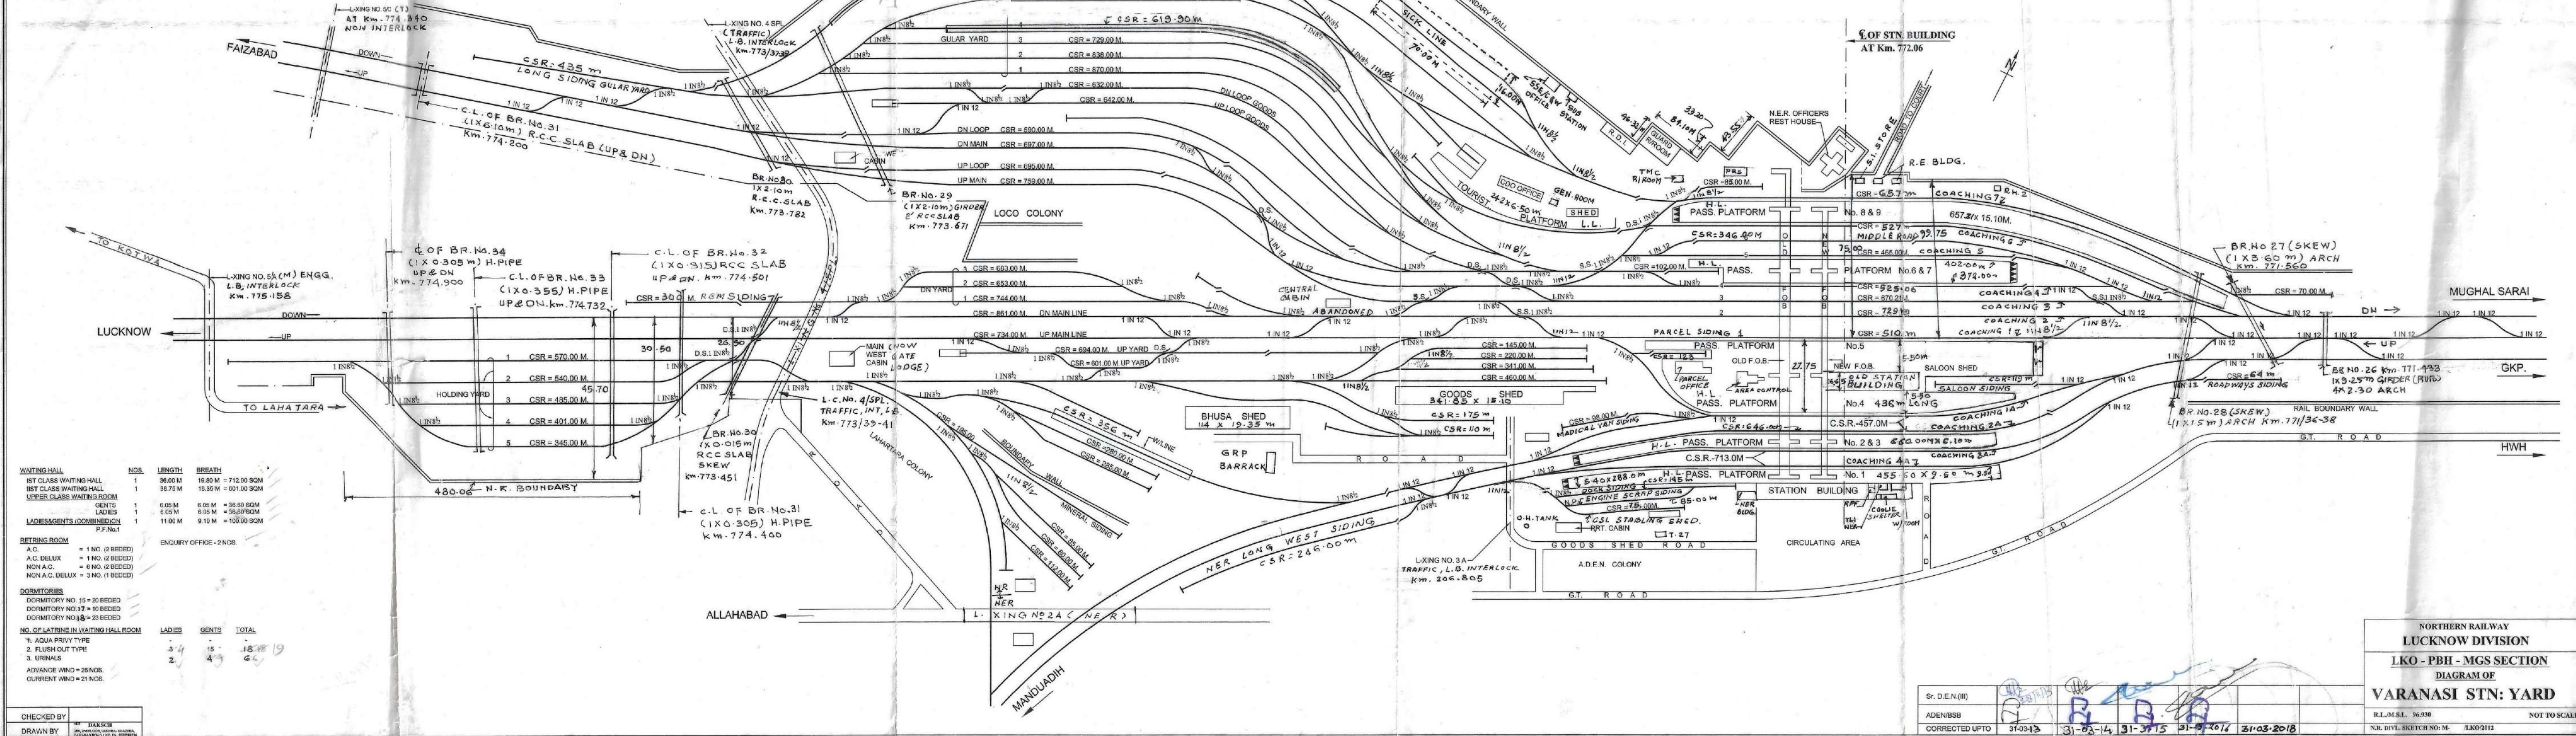

NORTHERN RAILWAY
LUCKNOW DIVISION
LKO - PBH - MGS SECTION
DIAGRAM OF
VARANASI STN: YARD

R.L.M.S.L. 96.930
NOT TO SCALE

N.R. DIVL. SKETCH NO: M- /LKO/2012


CORRECTED UP TO 31-03-2013

S. No.	DESCRIPTION	REMARKS	S. No.	DESCRIPTION	AREA (Sq.m.)
1	LAVATORIES	LAV LADIES NIL GENTS NIL P/F No. TAPS H.P. 1 3 2 NIL	1	AREA OF PLATFORM SHELTER	NIL NIL
2	NO OF WATER TAPS/HAND PUMPS ON EACH PLATFORM		2	TOTAL AREA OF PLATFORM PLATFORM NO. 1 PLATFORM NO. 2	2935.33 1892.98
3	SOURCE OF WATER SUPPLY	BORE WELL 1	3	AREA OF WAITING ROOM I - UPPER CLASS WAITING ROOM II - AREA OF WAITING ROOM a - LADIES b - GENTS	NIL NIL NIL 32.90
4	YEAR OF CONSTRUCTION OF STATION BUILDING		4	CIRCULATING AREA	185.87
5	BOOKING OFFICE NO. OF WINDOWS	ADV. RES. 1 P/F No. 1 14			
6	NO. OF SEATS	CURRENT RES. P/F No. 2 4			
7	WHETHER ENQUIRY OFFICE PROVIDED OR NOT	NIL			

ADEN/BSB

SR-DEN-III

REF.	FENCING	KUTCHA PUCCA	----
ROAD	METALLED UNMETALLED	=====	=====

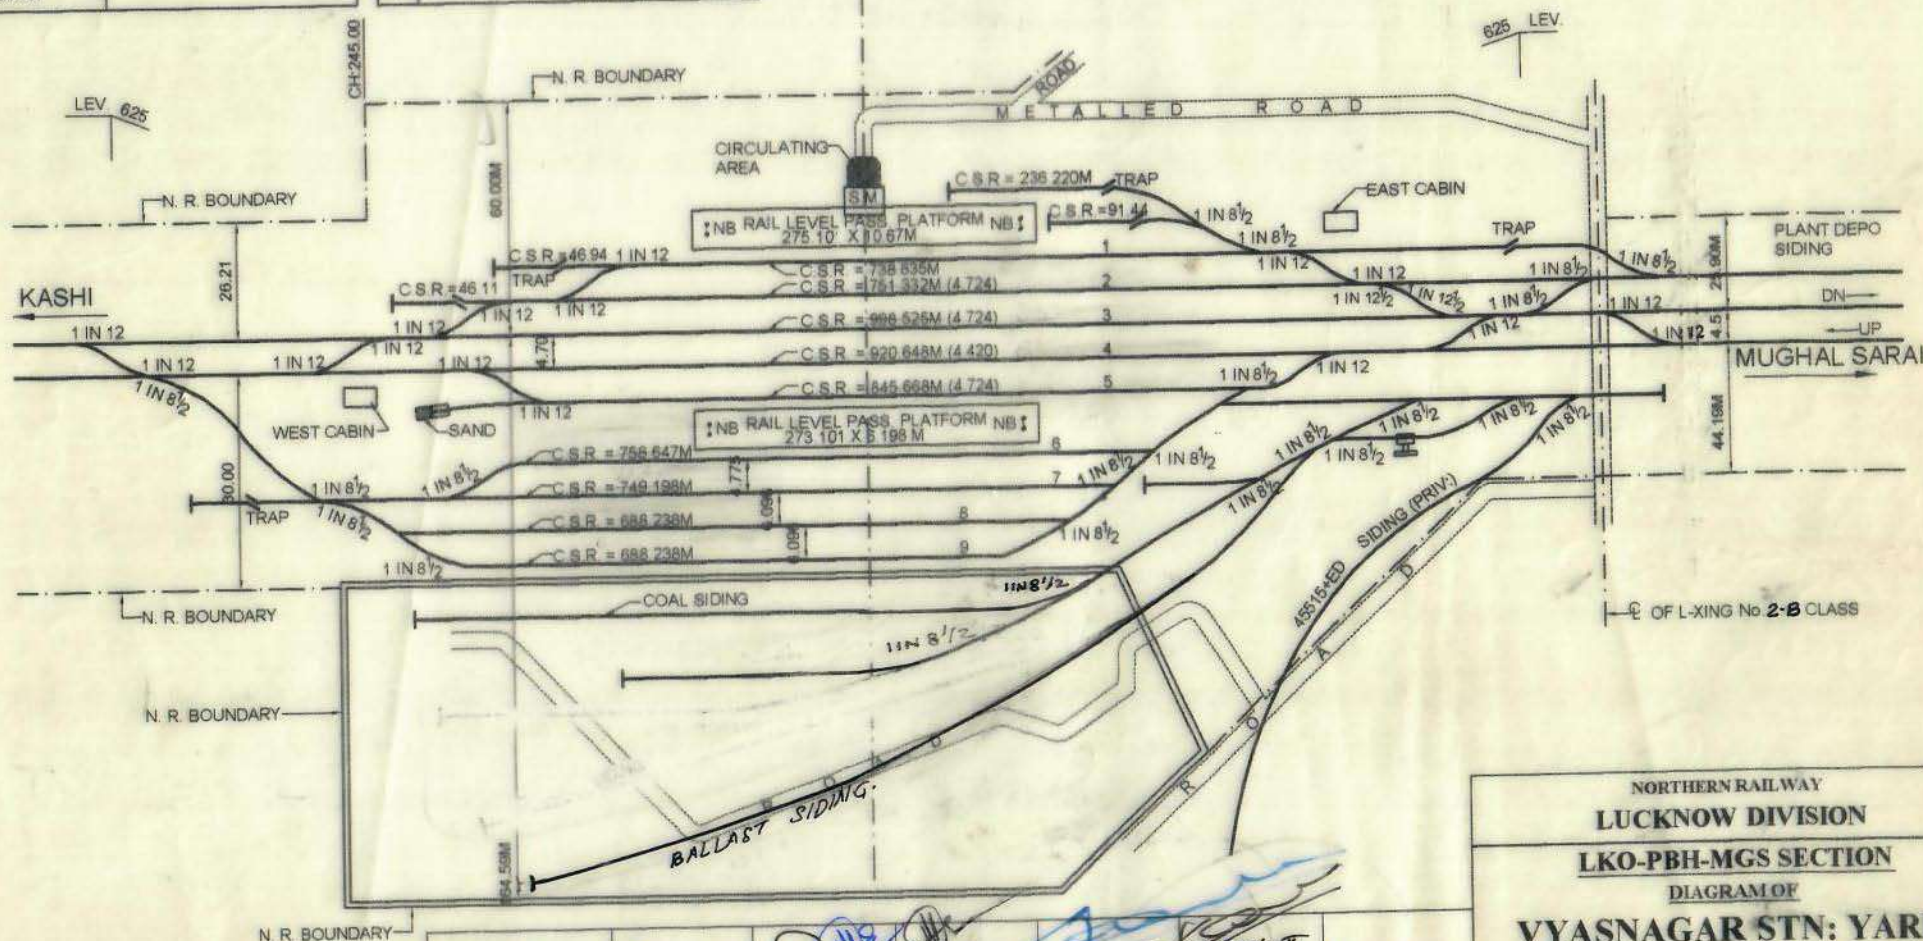E. OF VYASNAGAR STN. BLDG.
AT KM. 761.380NORTHERN RAILWAY
LUCKNOW DIVISION

LKO-PBH-MGS SECTION

DIAGRAM OF

VYASNAGAR STN: YARD

R.L./M.S.L.

NOT TO SCALE

N.R. DIVL. SKETCH NO: M185/LKO/2012

CHECKED BY	DAKSCH
DRAWN BY	DAKSCH

DEN (III)

ADEN/BSB

CORRECTED UP TO

31-03-12

31-8-2013


31-03-2014

31-8-2015

31-8-2016

186

NORTHERN RAILWAY	
LUCKNOW DIVISION	
<u>ALD-JNH-JNU SECTION</u>	
<u>DIAGRAM OF</u>	
WARIGAON ST: YARD	
NEWADA	
R.L./M.S.L.	NOT TO SCALE
N.R. D.R.M. L.K.O. SKETCH NO.	GROUP

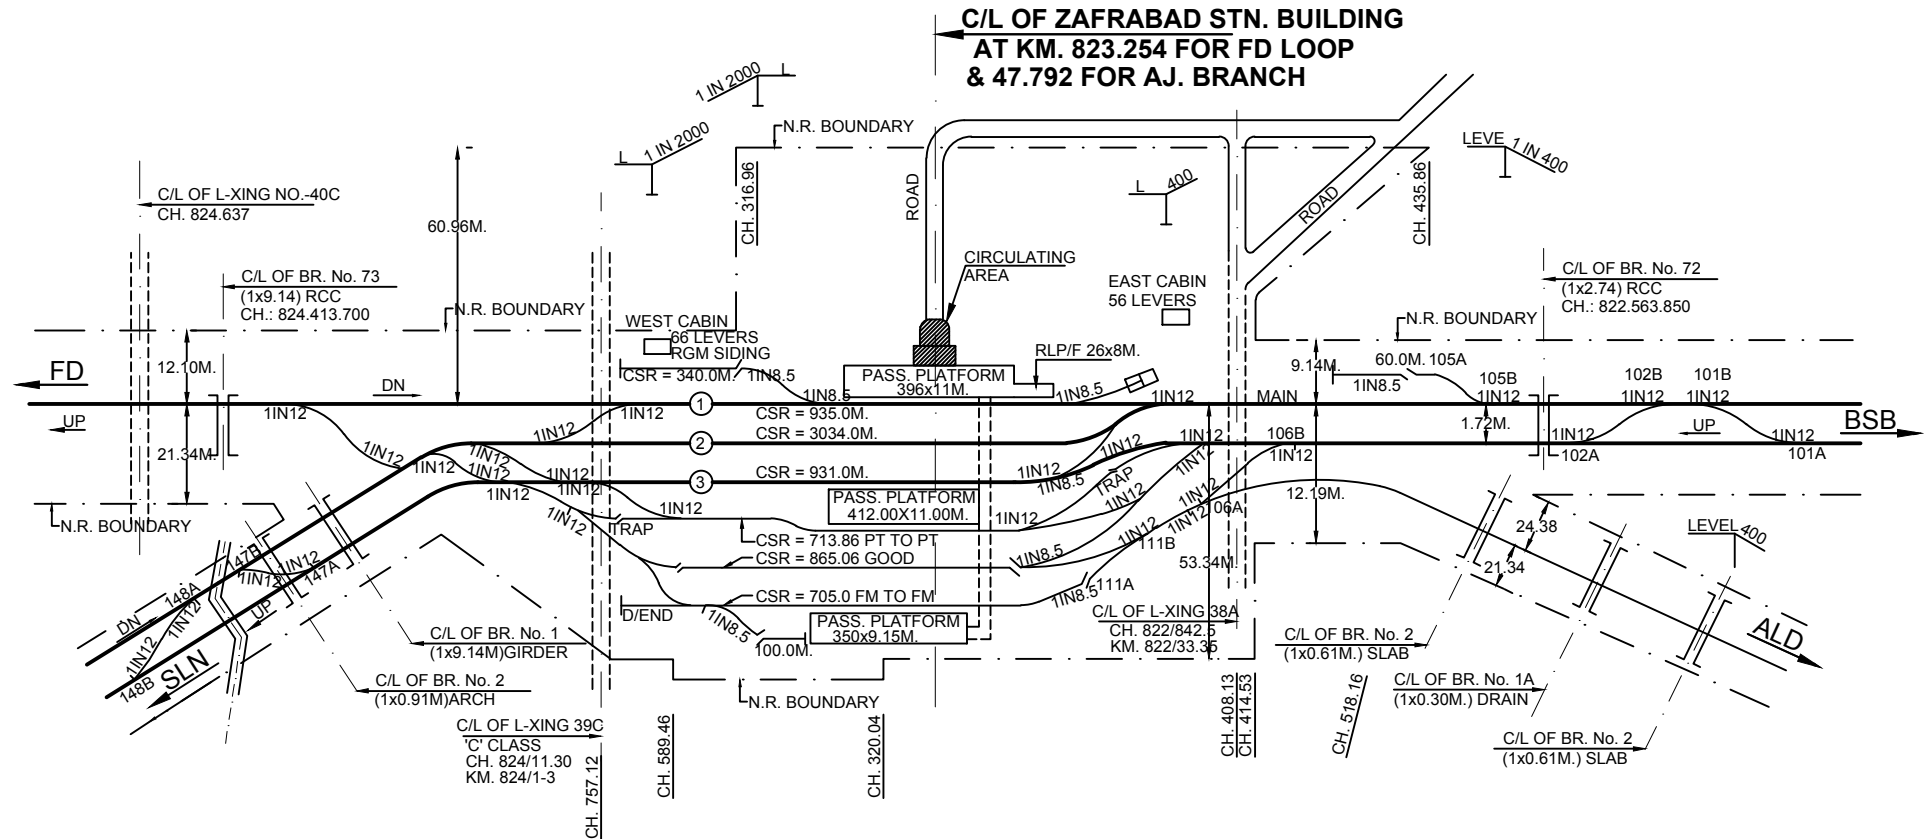

CHECKED BY	
DRAWN BY	

Sr. DEN(IV)					
ADEN/SLN-II					
CORRECTED UPTO	18-02-2020				

NORTHERN RAILWAY LUCKNOW DIVISION	
LKO -SLN-ZBD SECTION	
DIAGRAM OF	
ZAFRABAD STN. YARD	
R.L./M.S.L. 81.15m	NOT TO SCALE
N.R. D.R.M. LKO. SKETCH NO. M-195/LKO-2012	